


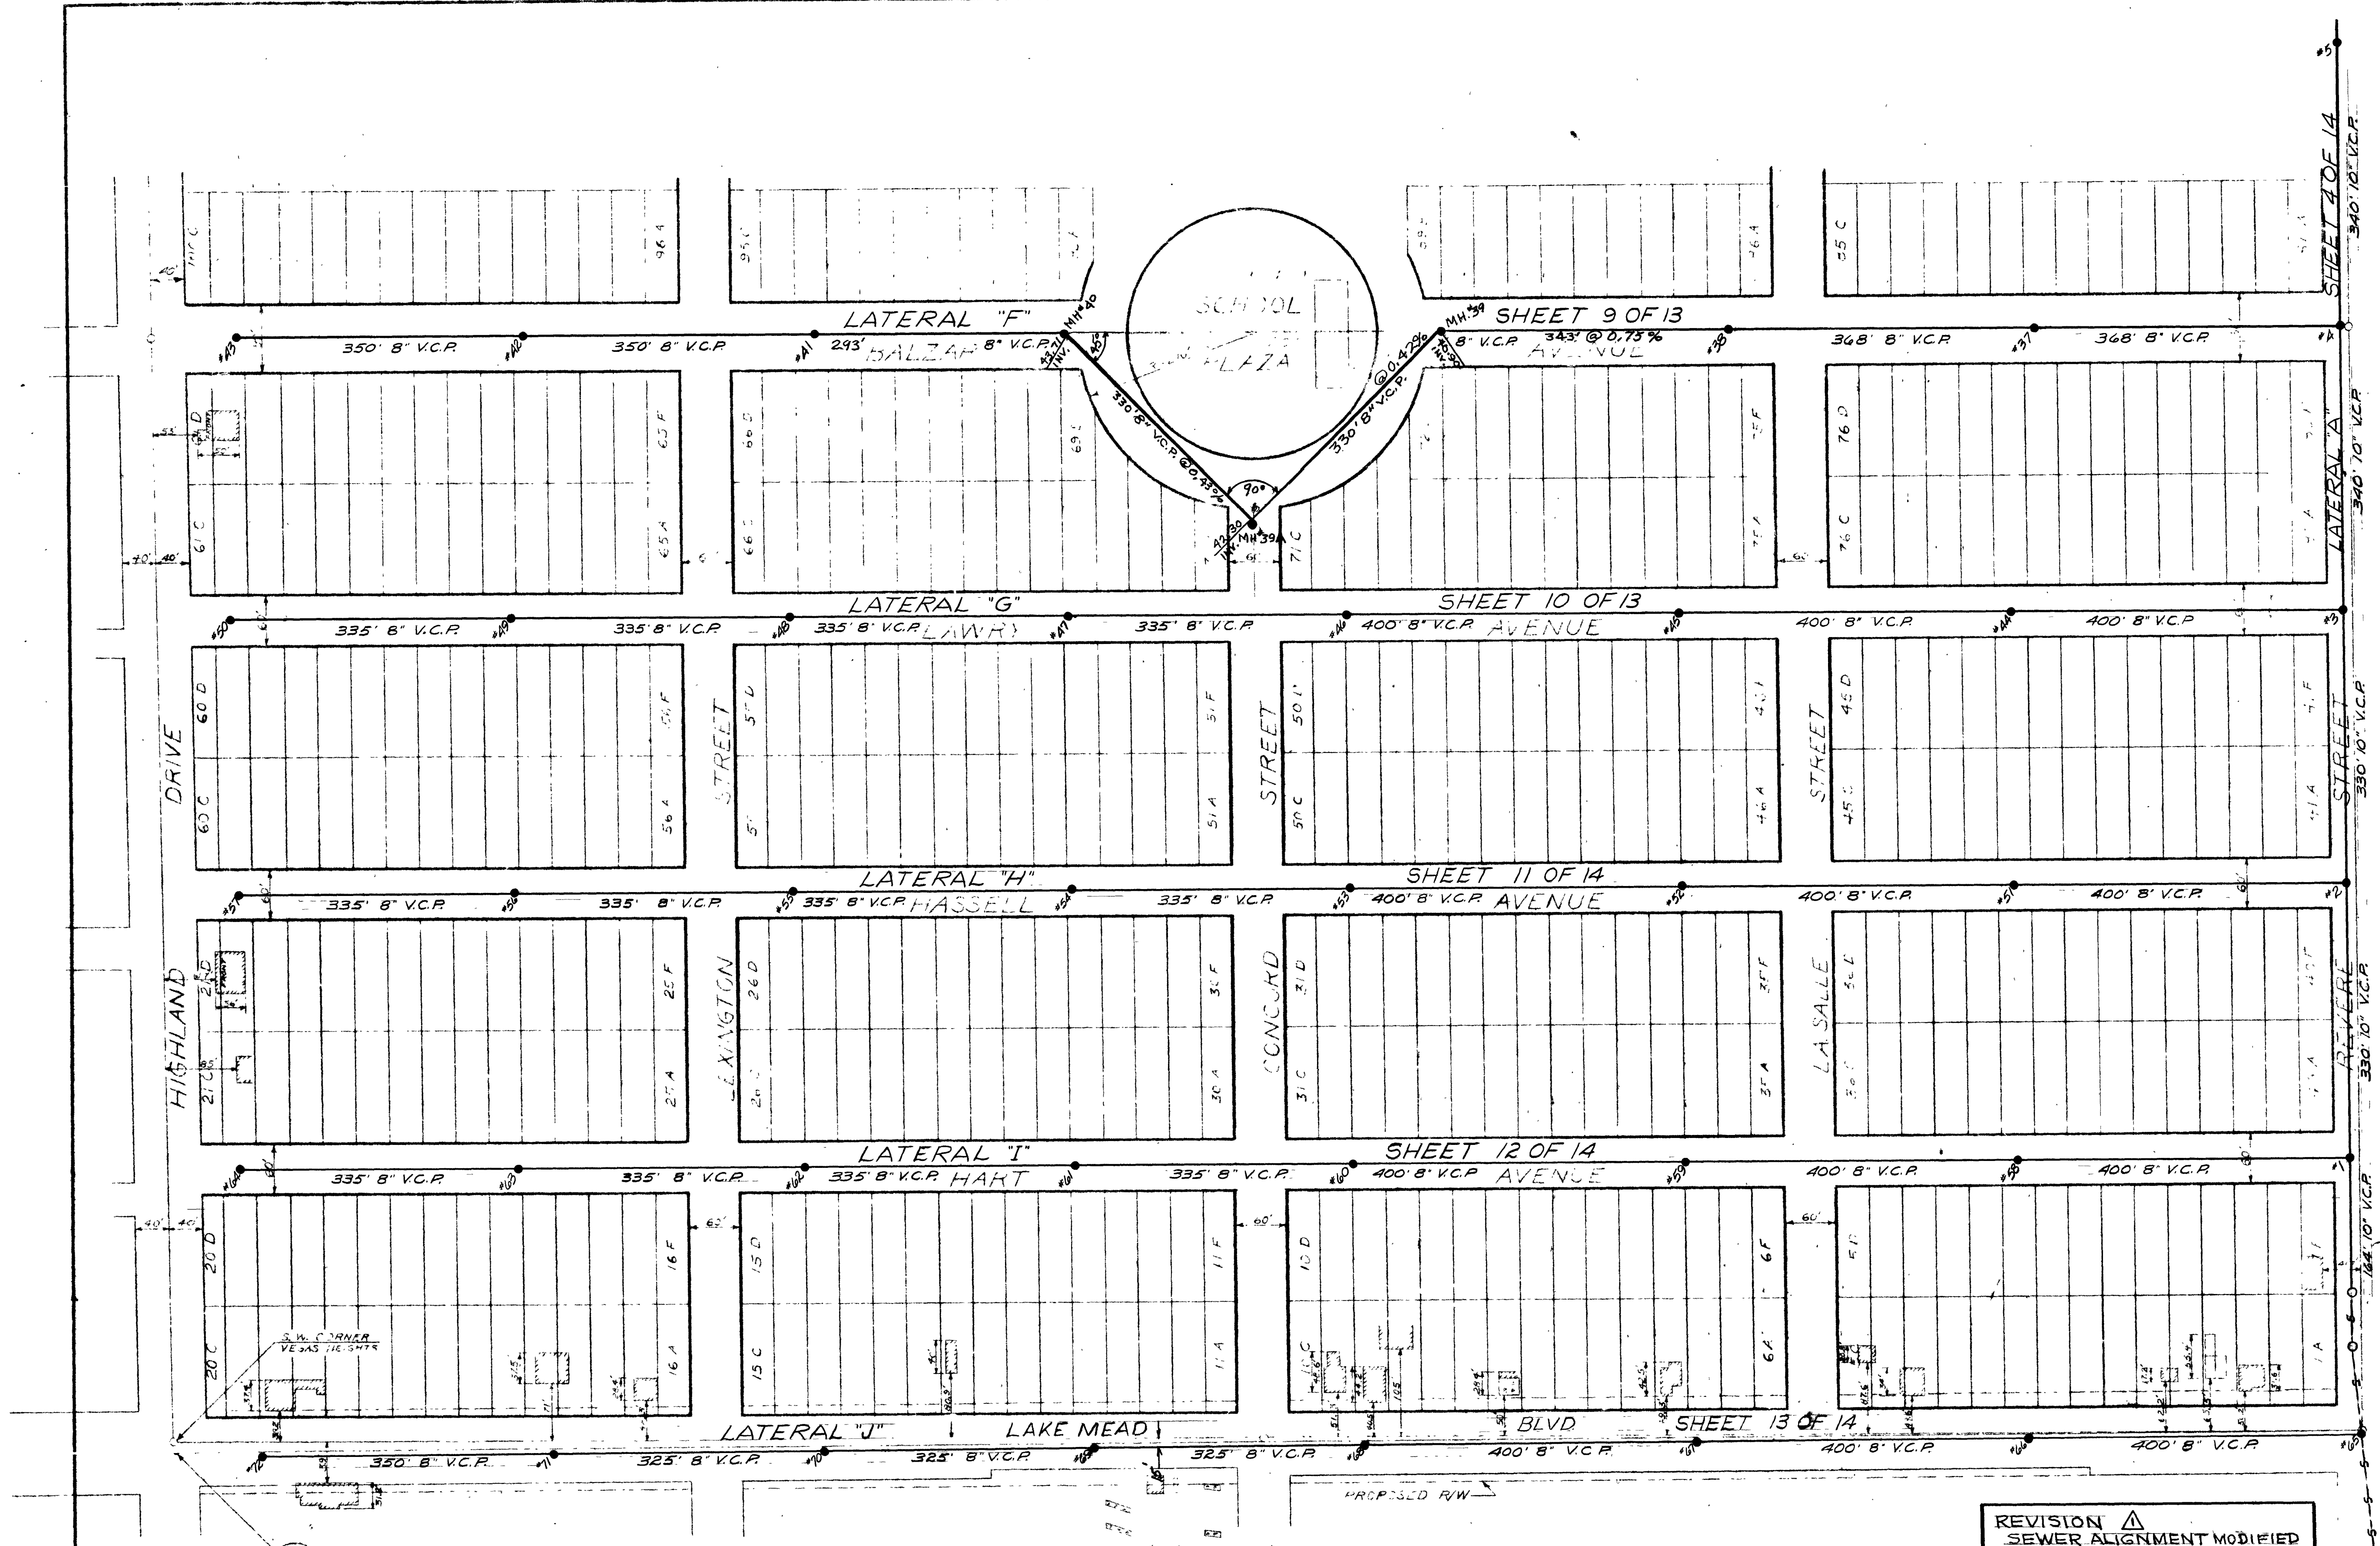

LEGEND:
[Symbol] - BUILDINGS FROM SURVEY DATA.
[Symbol] - BUILDINGS FROM AERIAL PHOTO.
NOTE:
EXISTING UTILITIES SHOWN
ON PLAN & PROFILE

APPROVED BY *R. A. Antone* 11-23-64
S.U.P.T. OF SANITATION DATE

REVISION
SEWER ALIGNMENT MODIFIED
TO REMAIN WITHIN EXISTING
RIGHT OF WAY.
APPROVED BY *B. H. Hines* 9/21/65
CITY ENGINEER DATE

CONTRACT
DRAWING
JUNE 7 1965
FEB 3 1965

RT	DIV	DATE
5	D.P.W.	7/1/65
5	ENG.	7/1/65
5	TL	7/1/65
5	RTW	7/1/65
5	SUB.	7/1/65
5	UTR.	7/1/65

S.A.D. 467 307-V81	
CITY OF LAS VEGAS NEVADA ENGINEERING DEPT.	
VEGAS HEIGHTS S.A.D. OVERALL SANITARY SEWER PLAN	
DES. DODD	DATE 11/18/64
ENR. W. D. FRIEDER	SC. NO.
C.D. [Signature]	PL. NO.
APPROVED BY CITY ENGR. [Signature]	DRAWING NO. 467
307-V81 UNIT 1 SHEET 2 OF 14 307-V81	

