




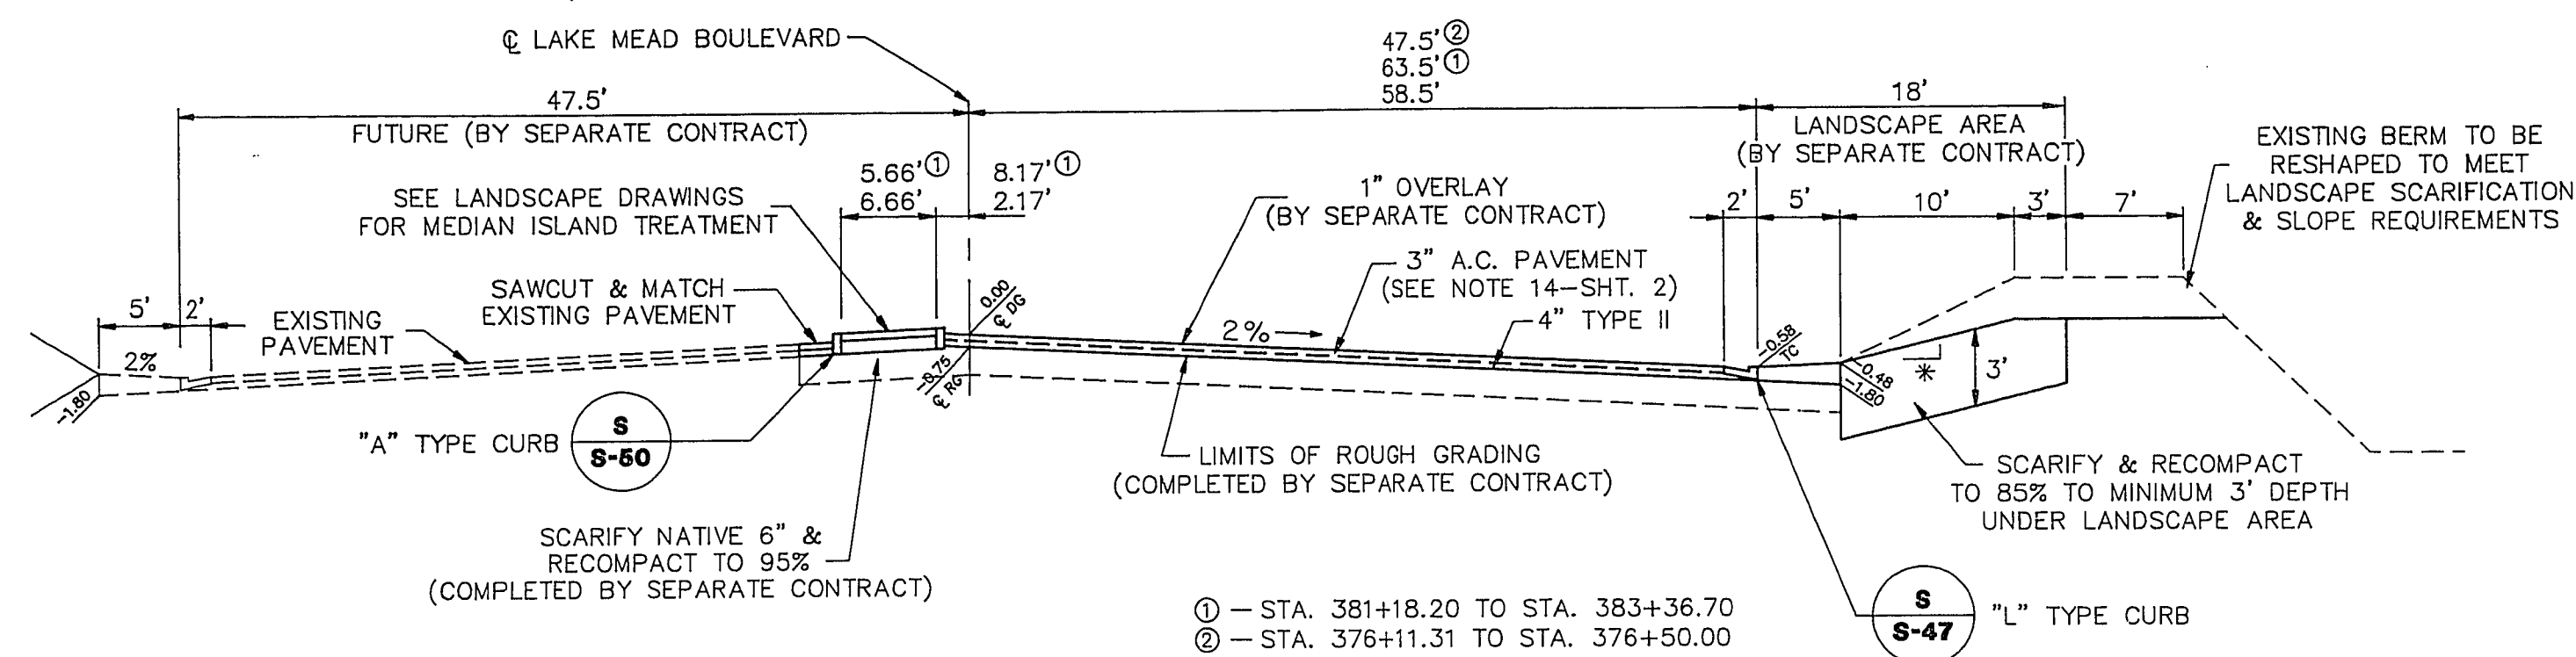


SECTION H
NO SCALE

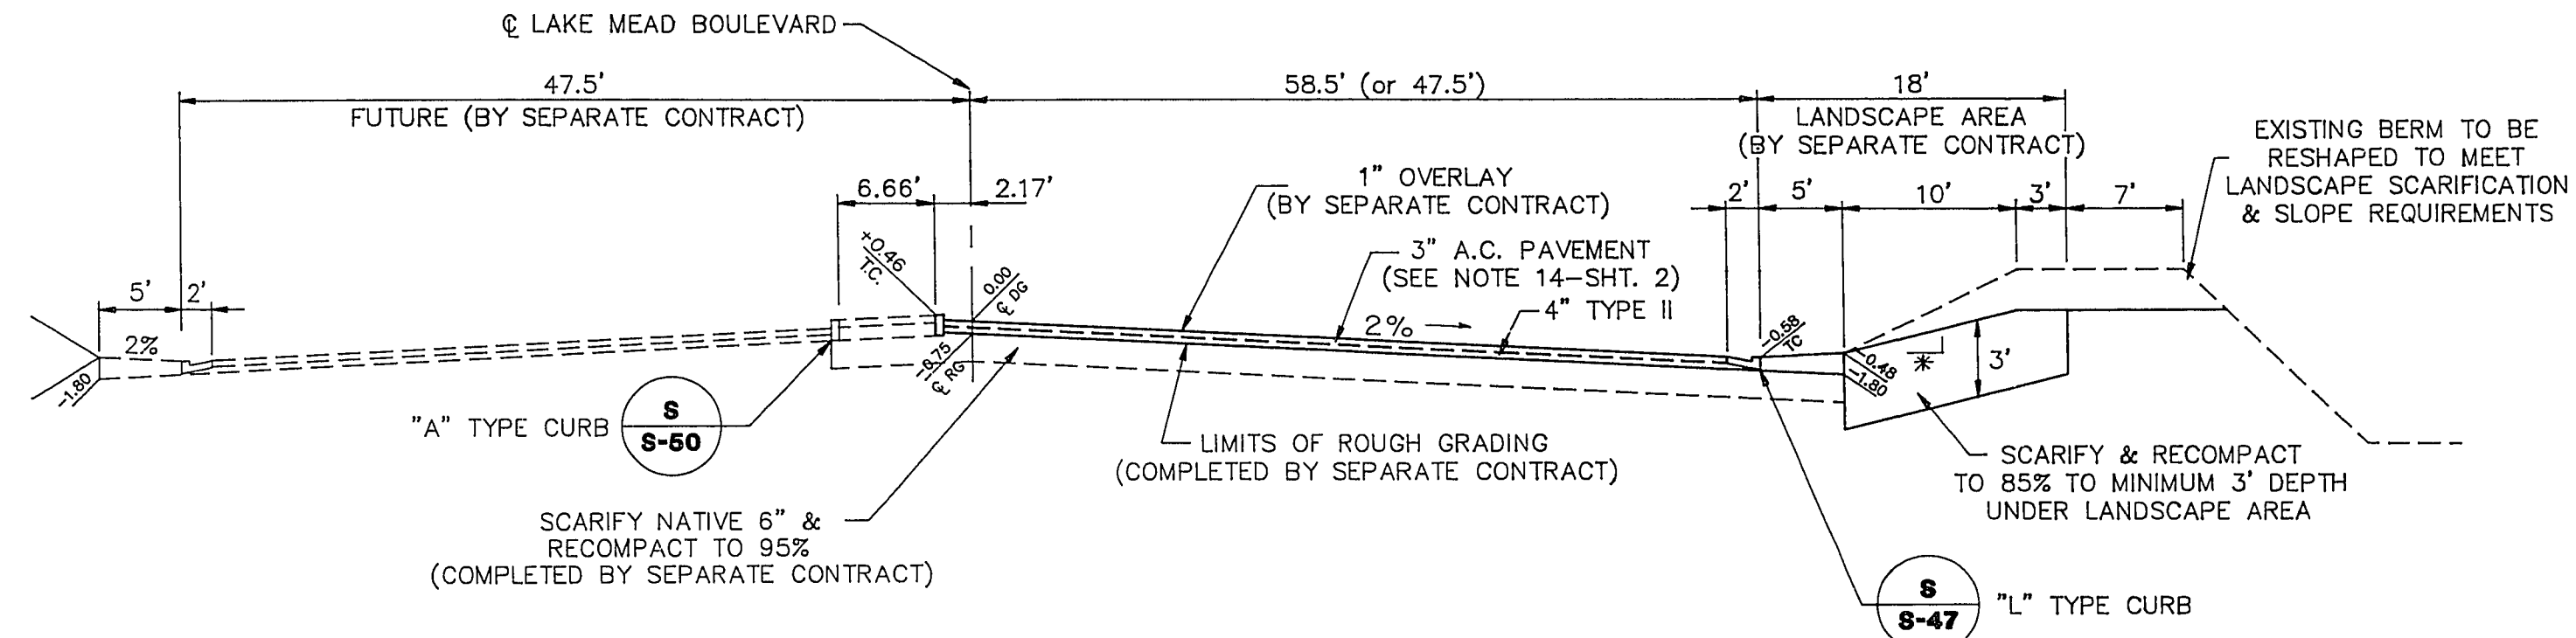


SECTION D
NO SCALE

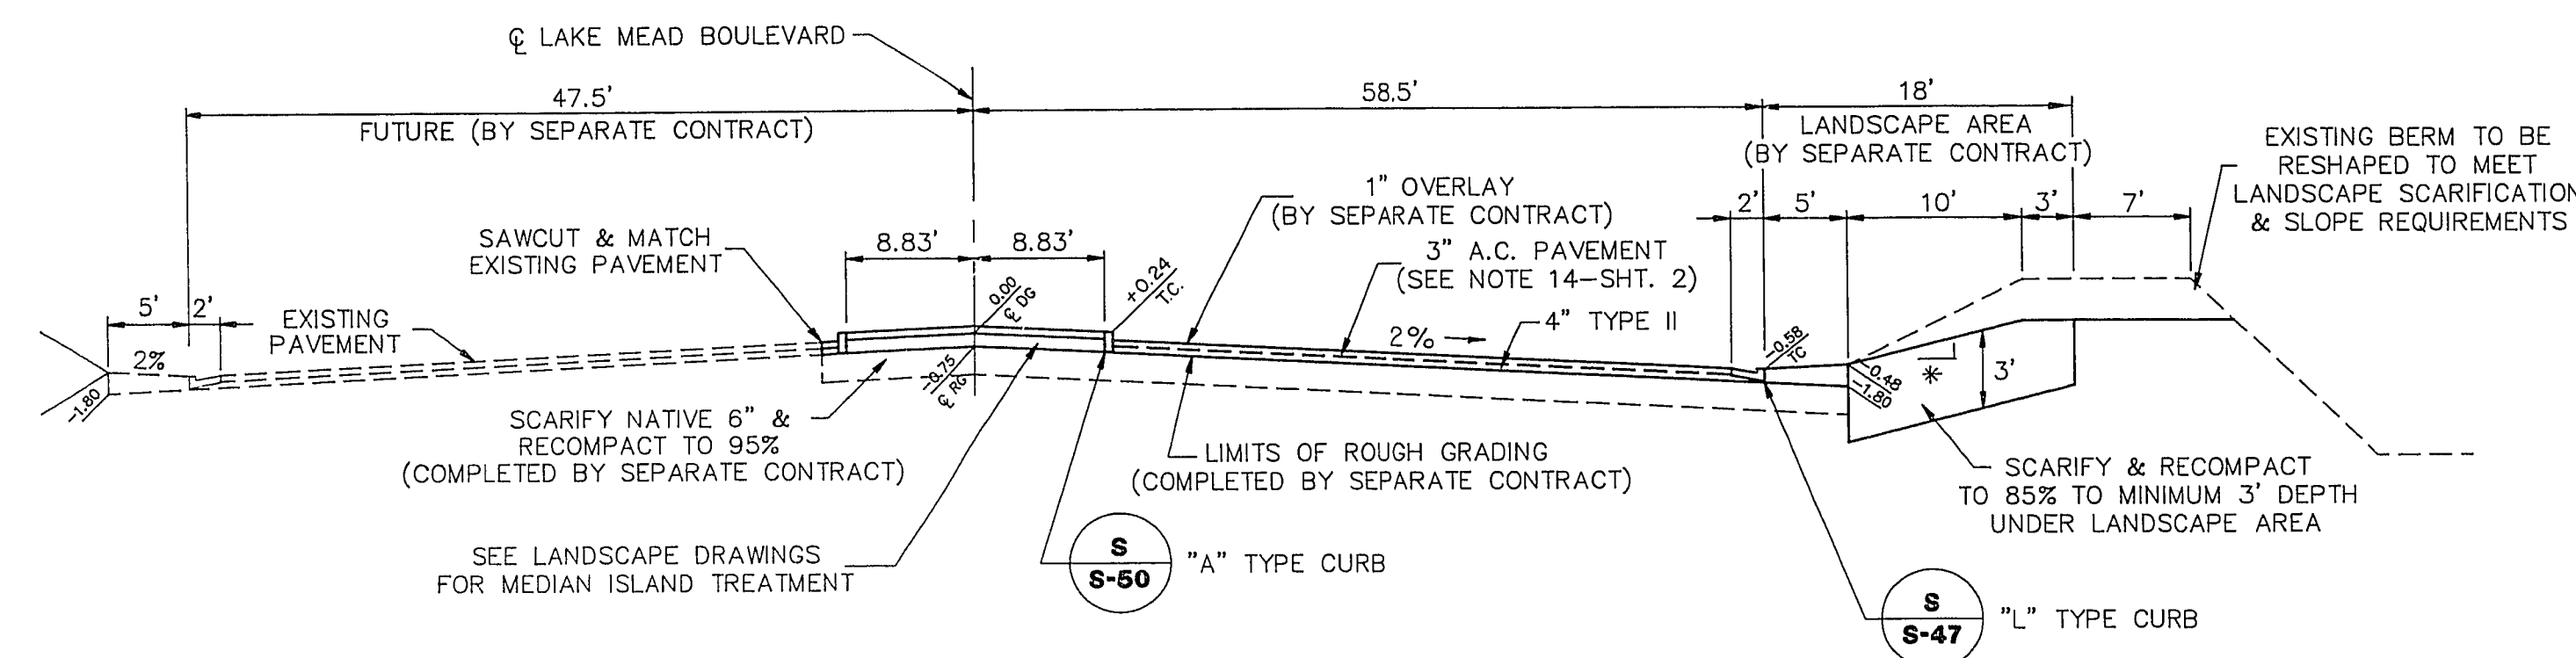


SECTION G
NO SCALE

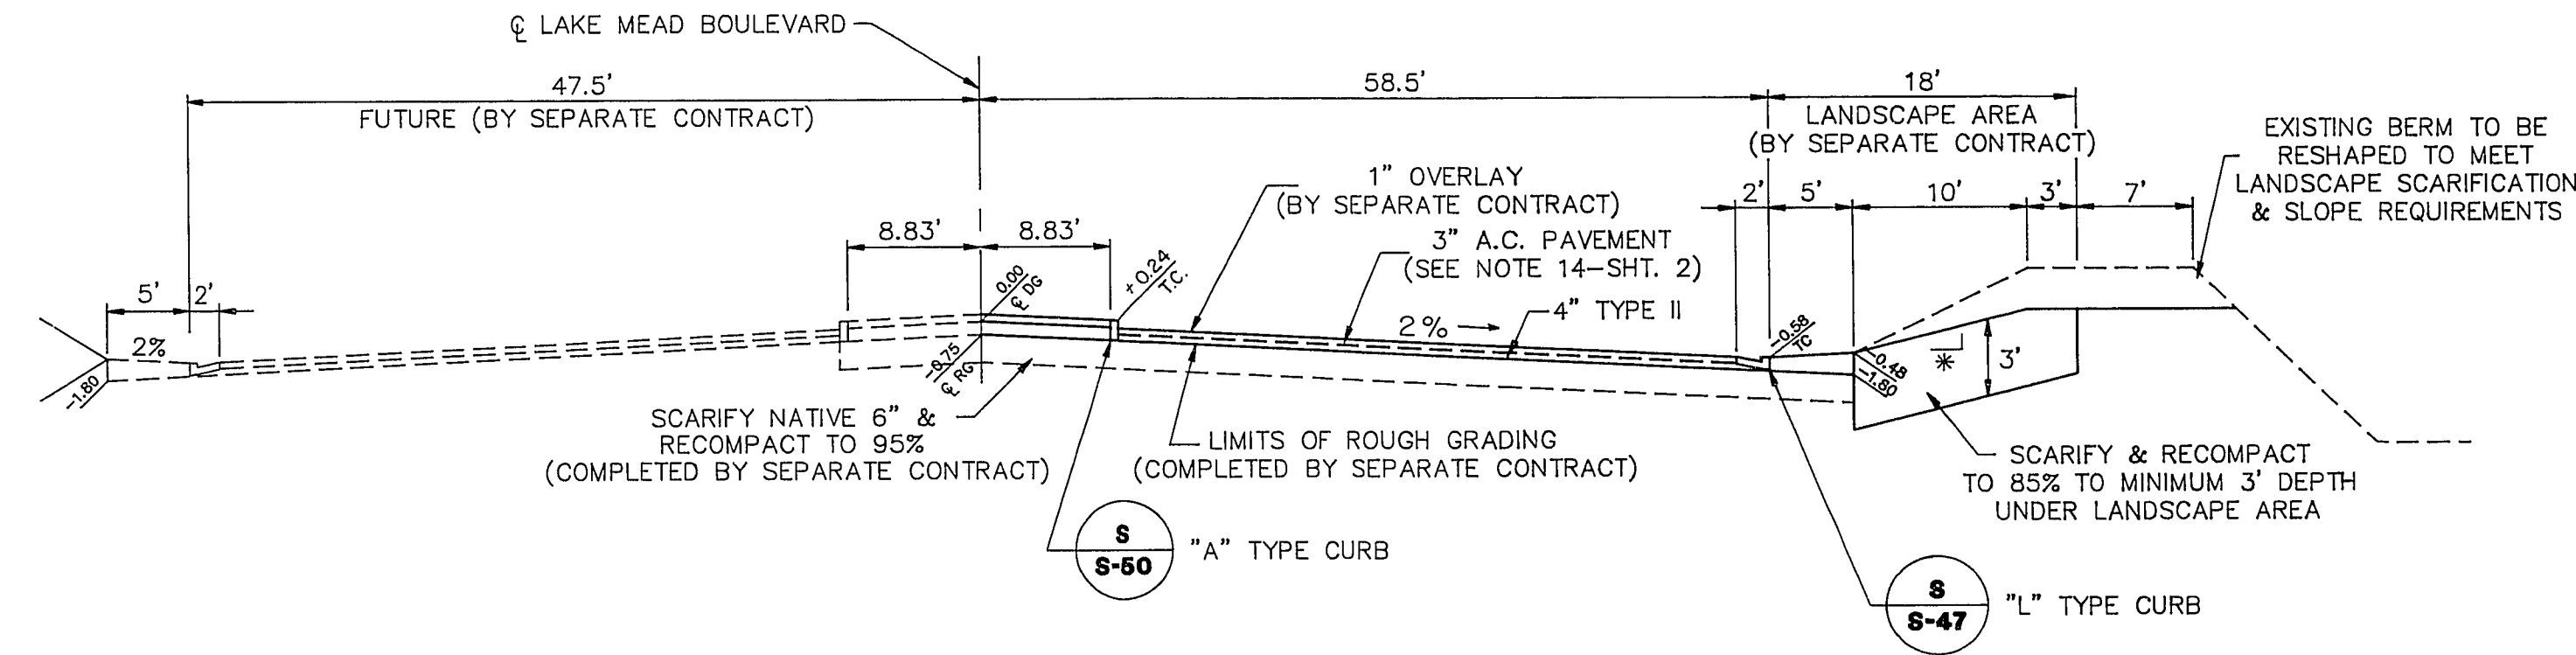


SECTION C
NO SCALE

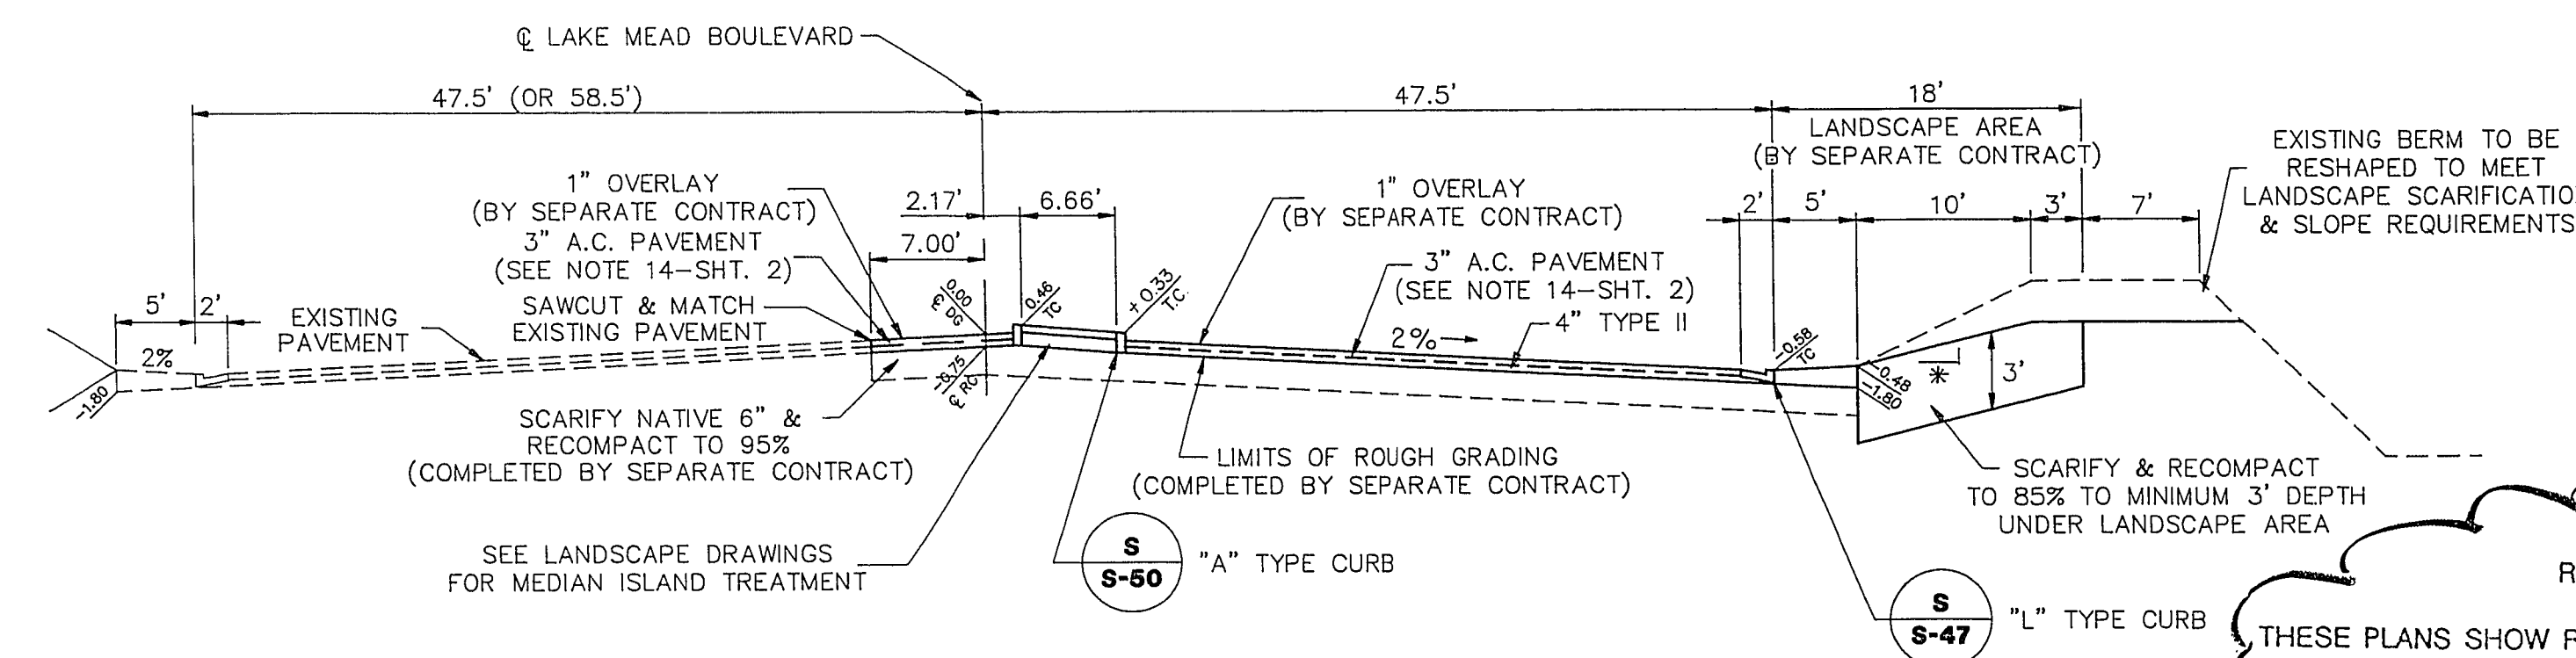


SECTION F
NO SCALE

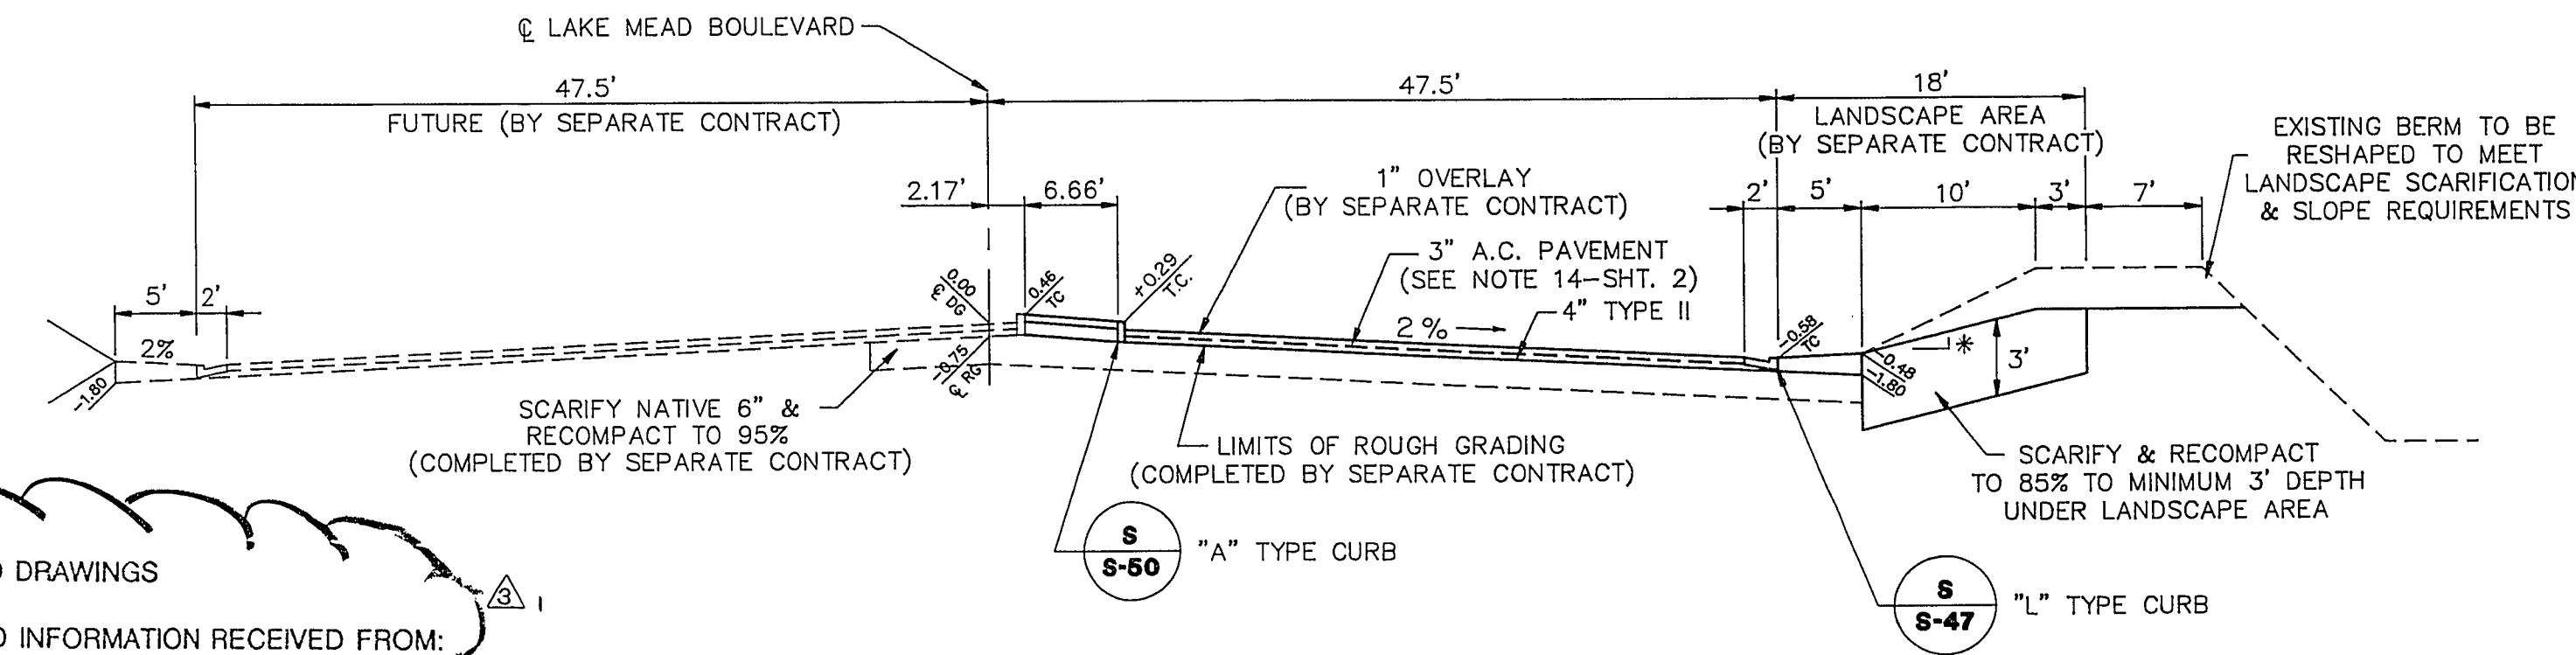

SECTION B
NO SCALE

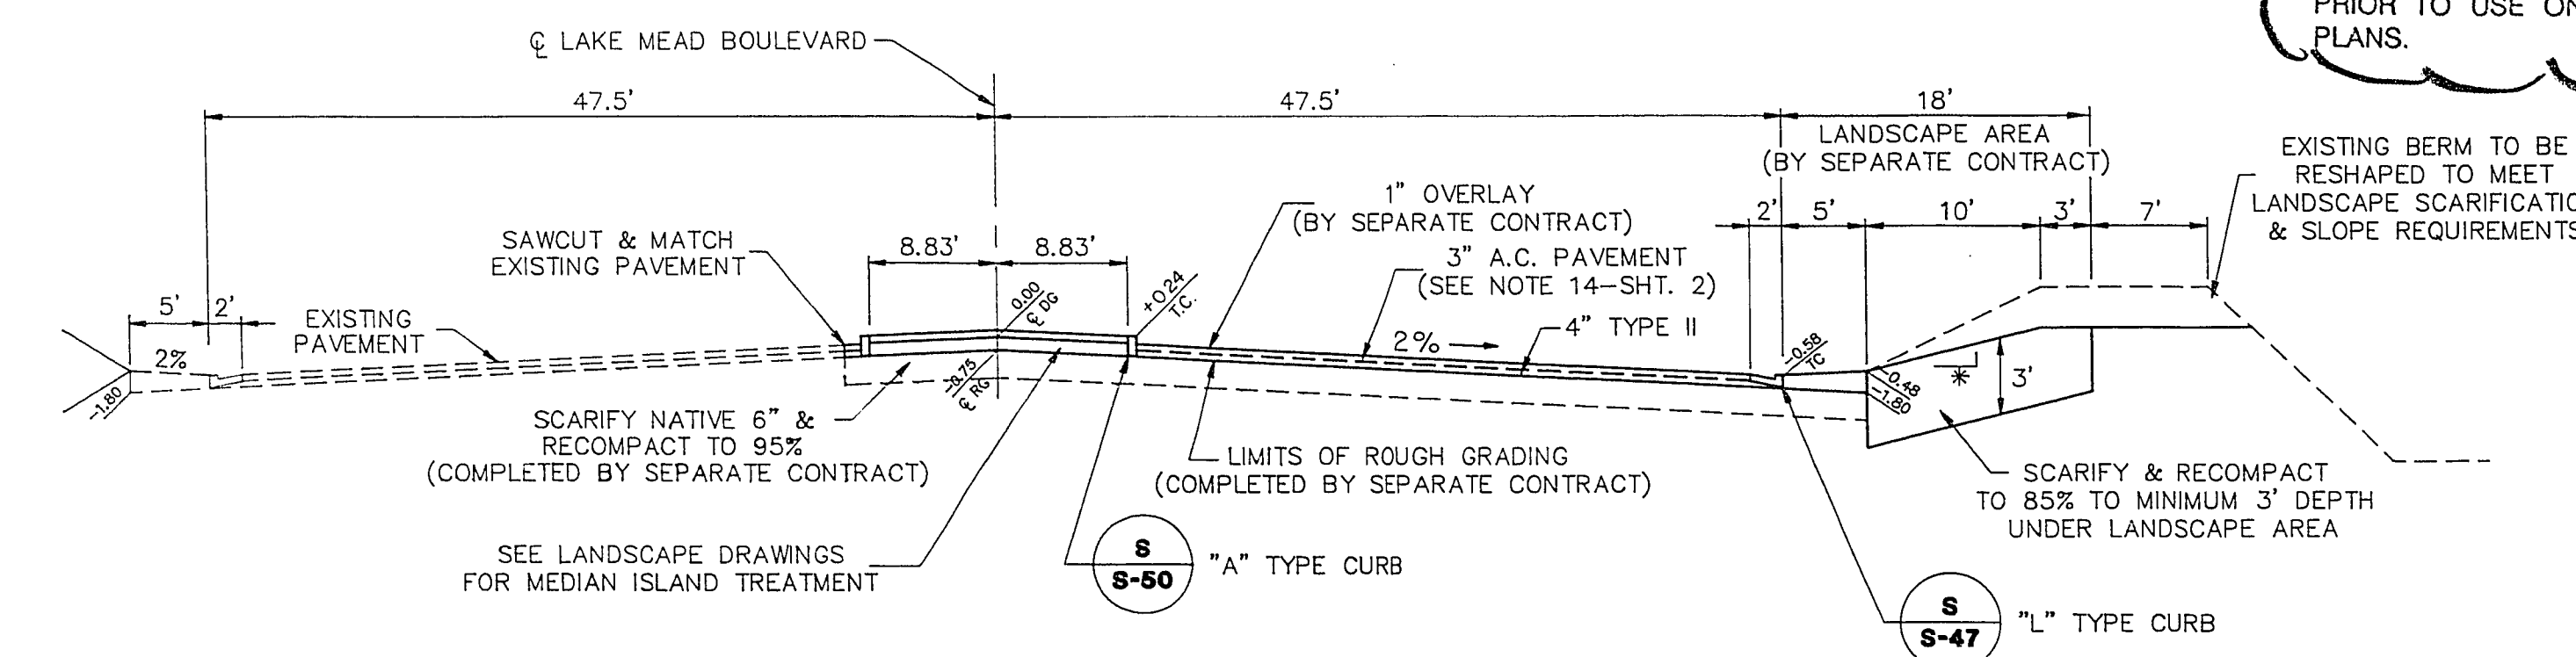

SECTION E
NO SCALE

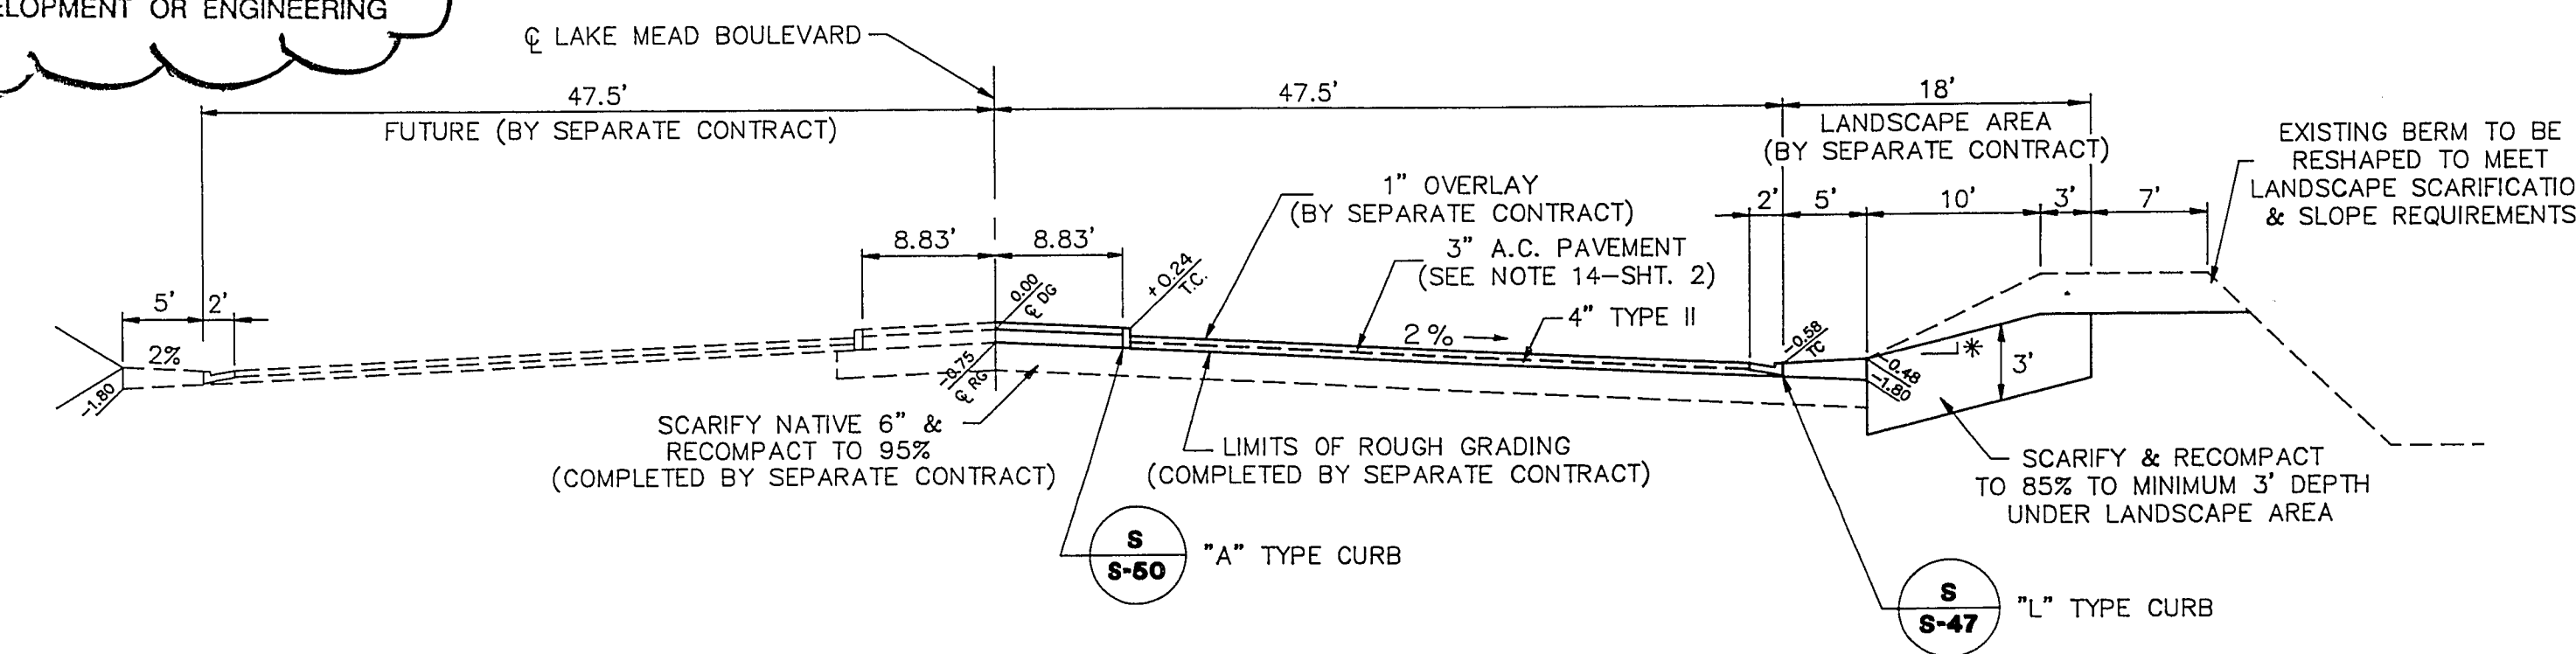

SECTION A
NO SCALE

RECORD DRAWINGS
THESE PLANS SHOW RECORD INFORMATION RECEIVED FROM:
CONTRACTOR: **SOUTHERN NEVADA PAVING/TAB**
DATE: **6-18-90**
THIS DATA MAY OR MAY NOT REFLECT THE ACTUAL FIELD LOCATIONS. ALL DATA SHOULD BE CONFIRMED PRIOR TO USE ON DEVELOPMENT OR ENGINEERING PLANS.

* STATION 299+67.23 TO STATION 312+90.99 10:1
STATION 312+90.99 TO STATION 349+50 5:1
STATION 349+50 TO STATION 359+50 3:1
STATION 359+50 TO STATION 371+77.7 5:1
STATION 371+77.7 TO STATION 379+00 3:1
STATION 379+00 TO STATION 382+25 5:1

REVISION	DATE	DESCRIPTION
1	8-7-89	ISSUE TO BID
2	8-19-89	RECORD DRAWING

RECOMMENDED BY: *Chris Wallace*
DESIGNED BY: *Chris Wallace*
CHECKED BY: *Chris Wallace*
DATE: 8-7-89
R.A.P. NO. 5071
1555 SOUTH RAINBOW BLVD. LAS VEGAS, NEVADA 89102

G.C. WALLACE, INC.
Engineering/Architecture

HOWARD HUGHES PROPERTIES
VILLAGE 1 NORTH LAKE MEAD BLVD.
STREET SECTIONS

SHEET
1-9
12x17 17 SHEETS

15-3-80 107-V1694