




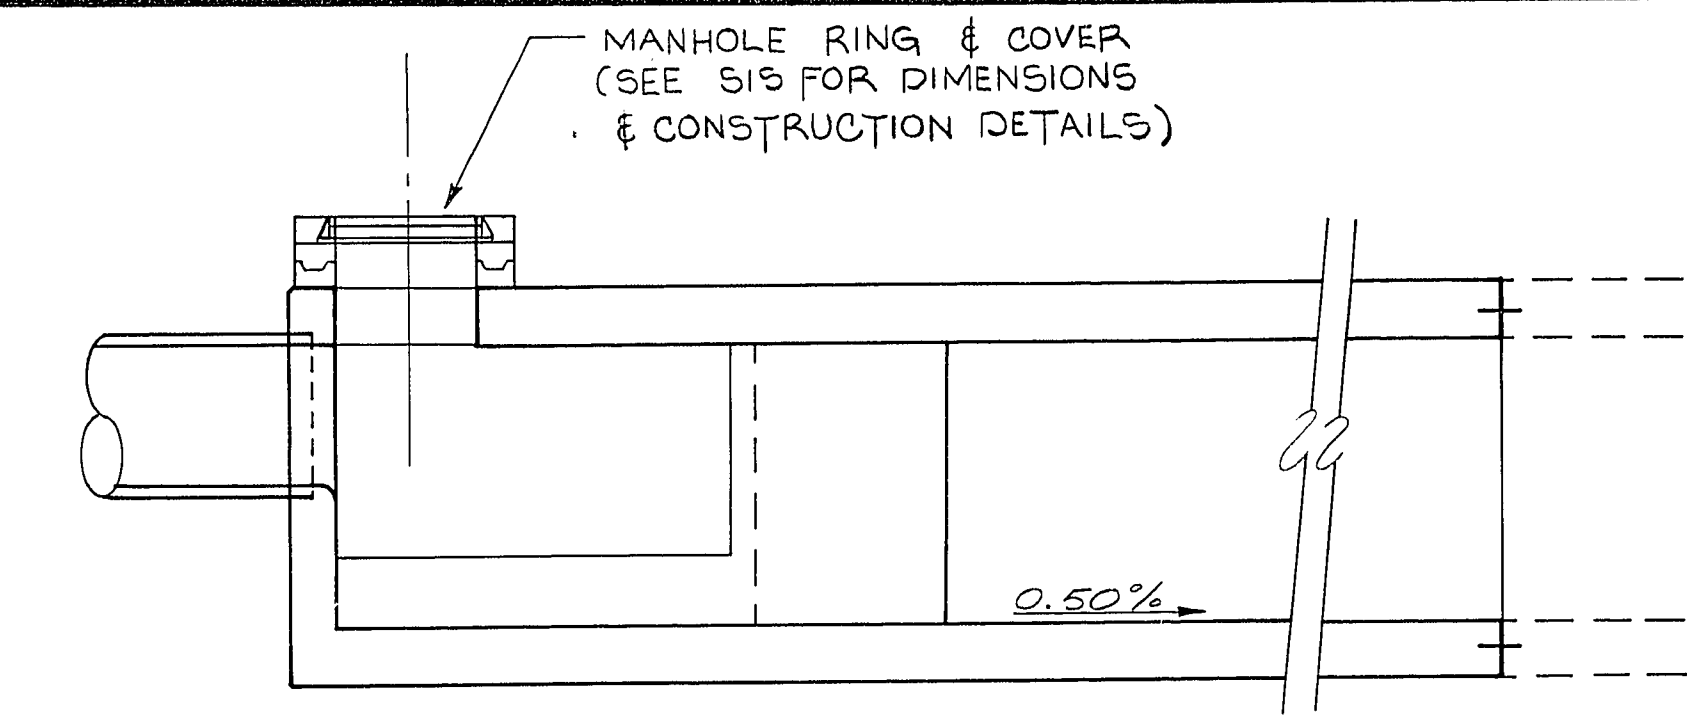


SECTION F

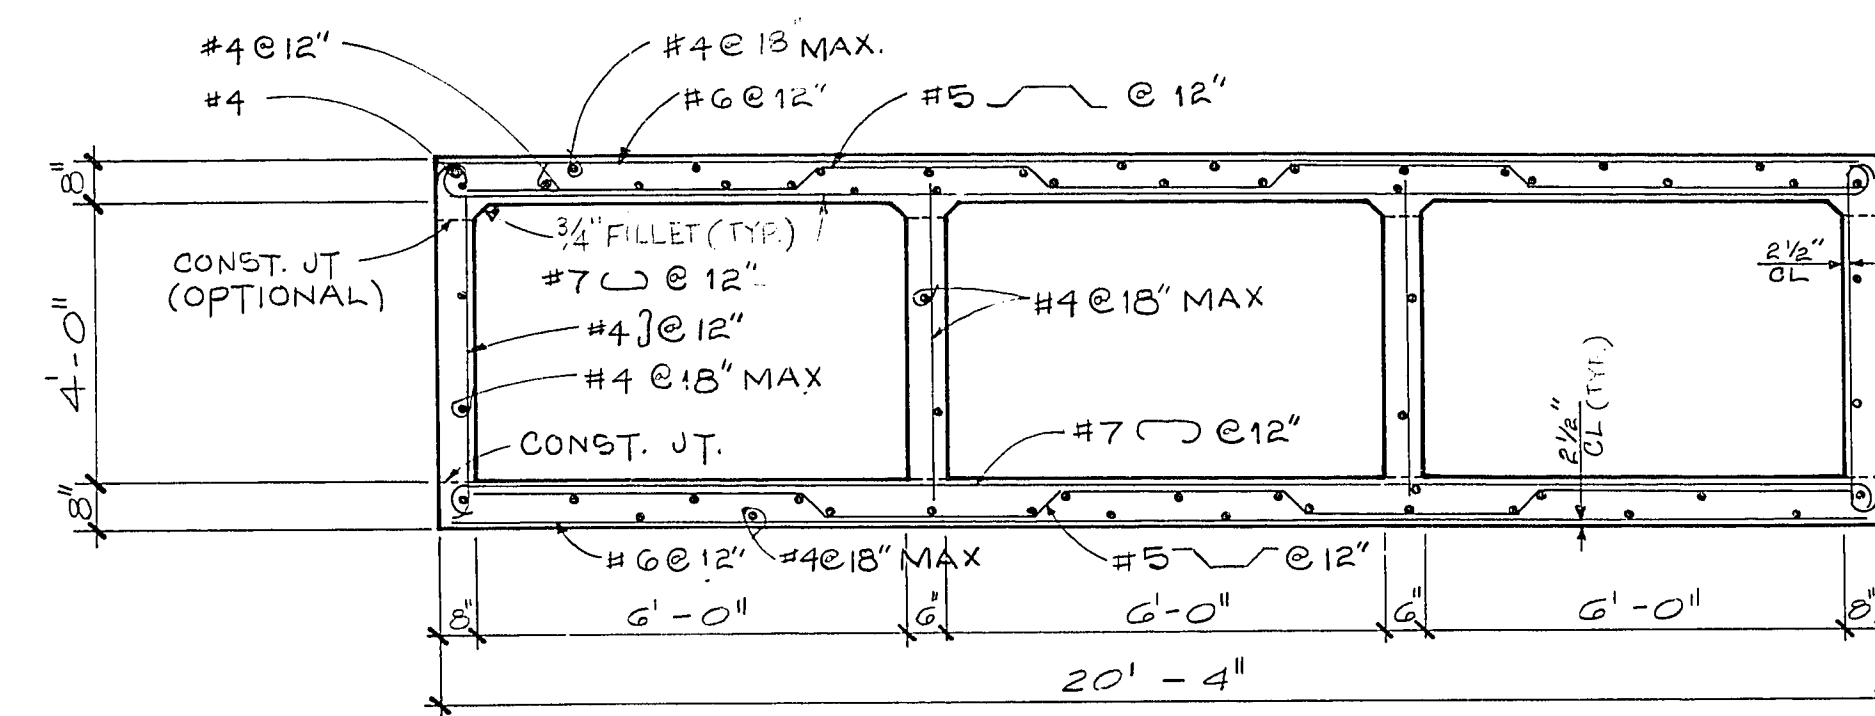


SECTION B

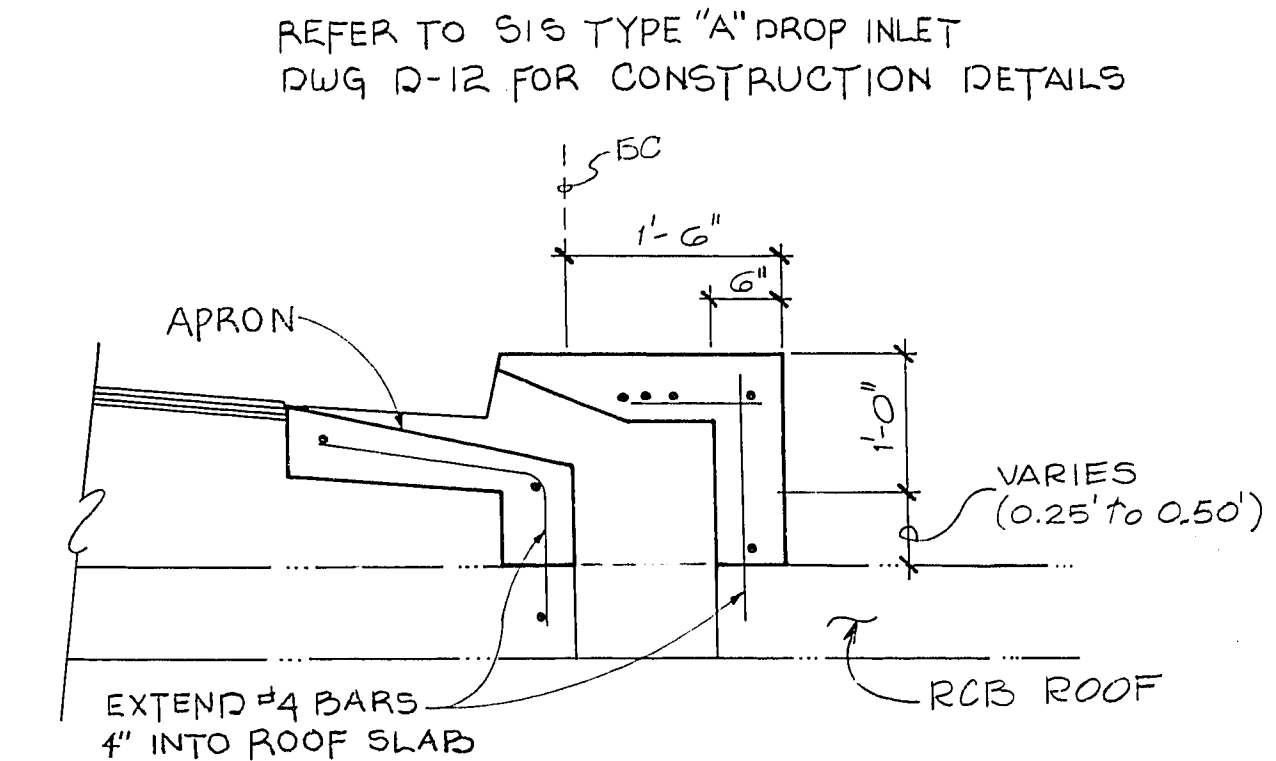


DETAIL - DROP INLET 1

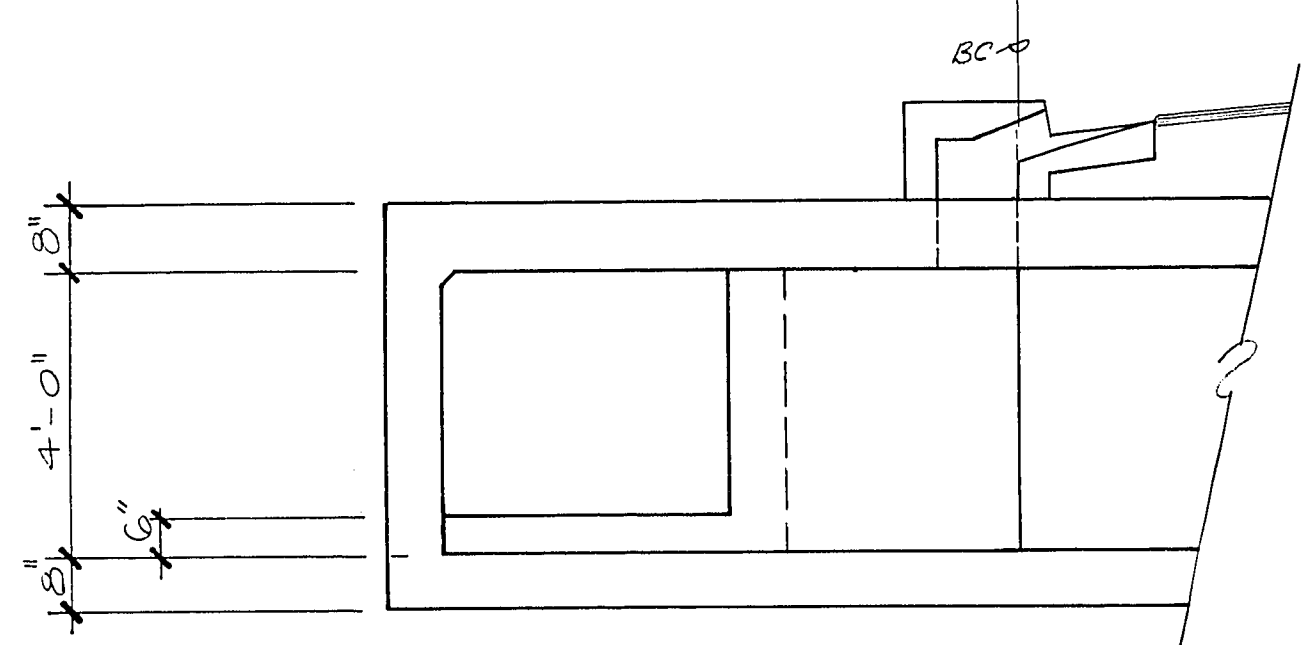


SECTION E

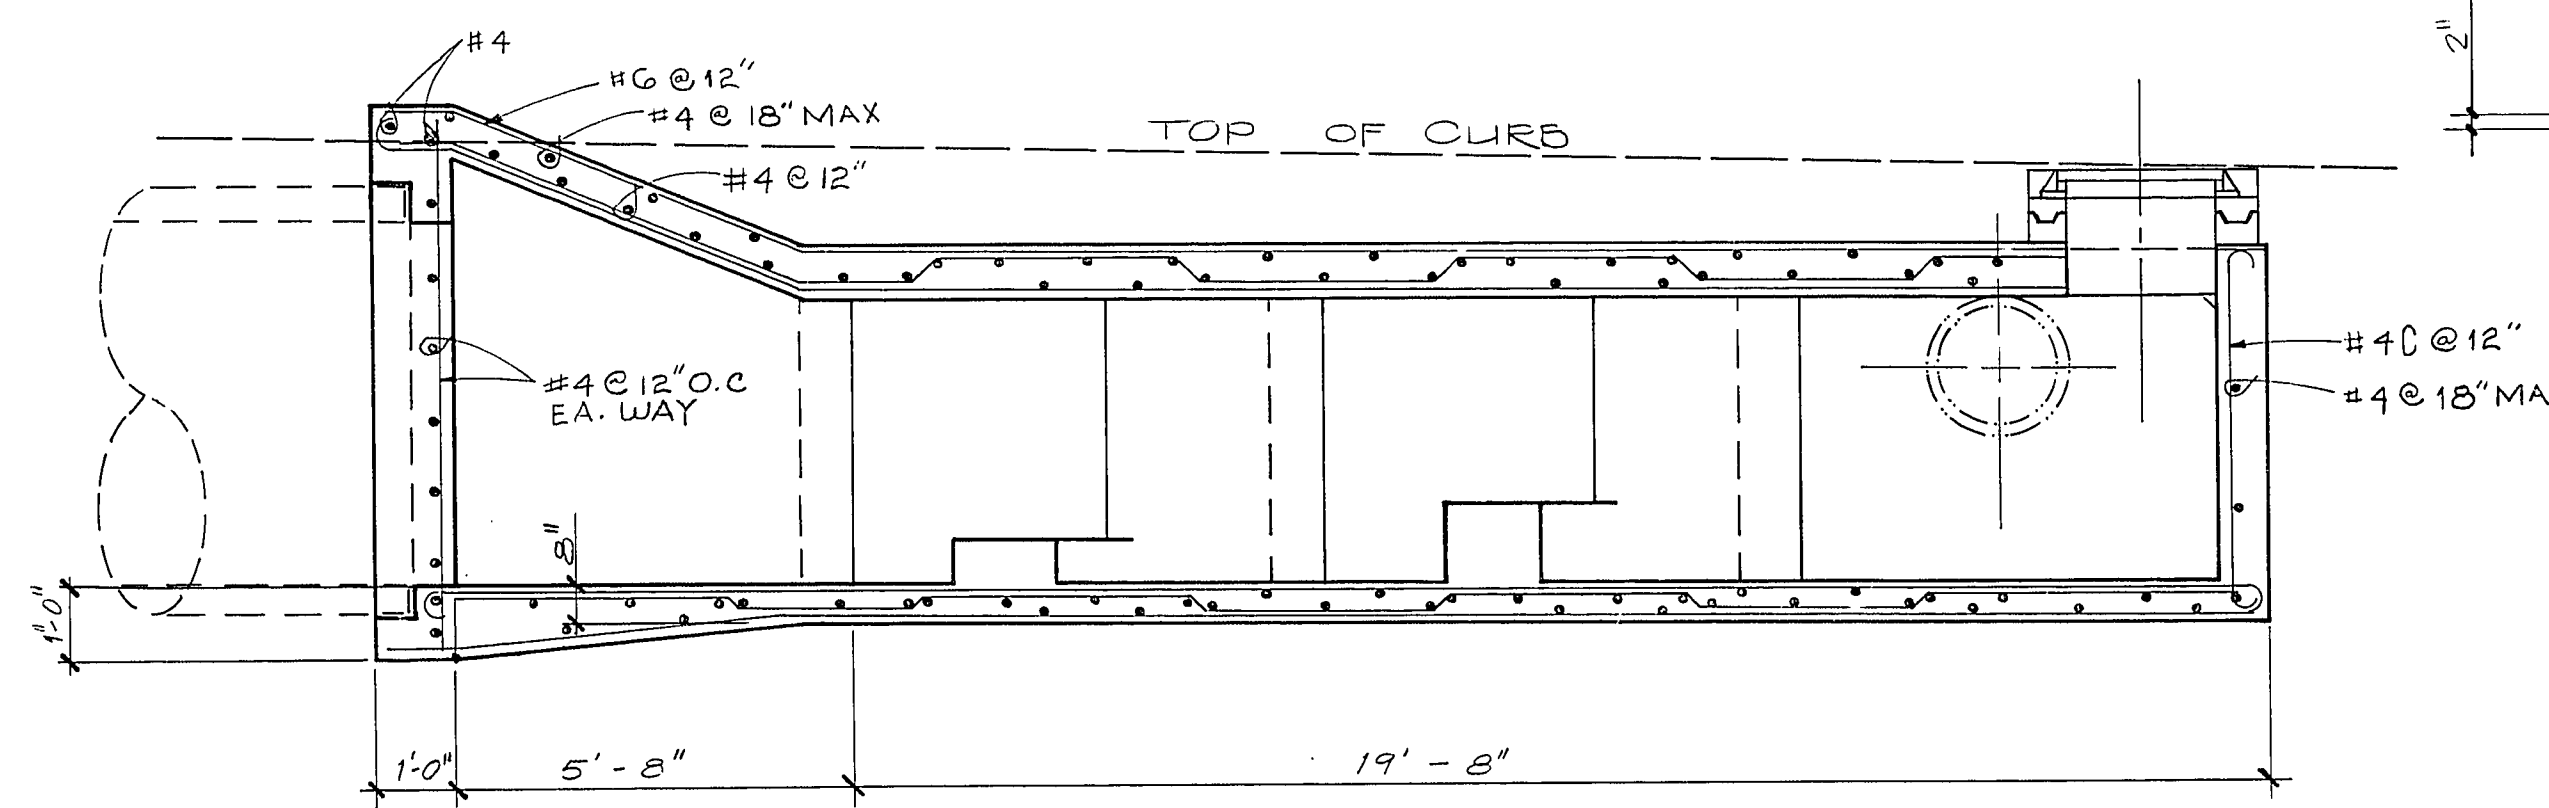


SECTION A

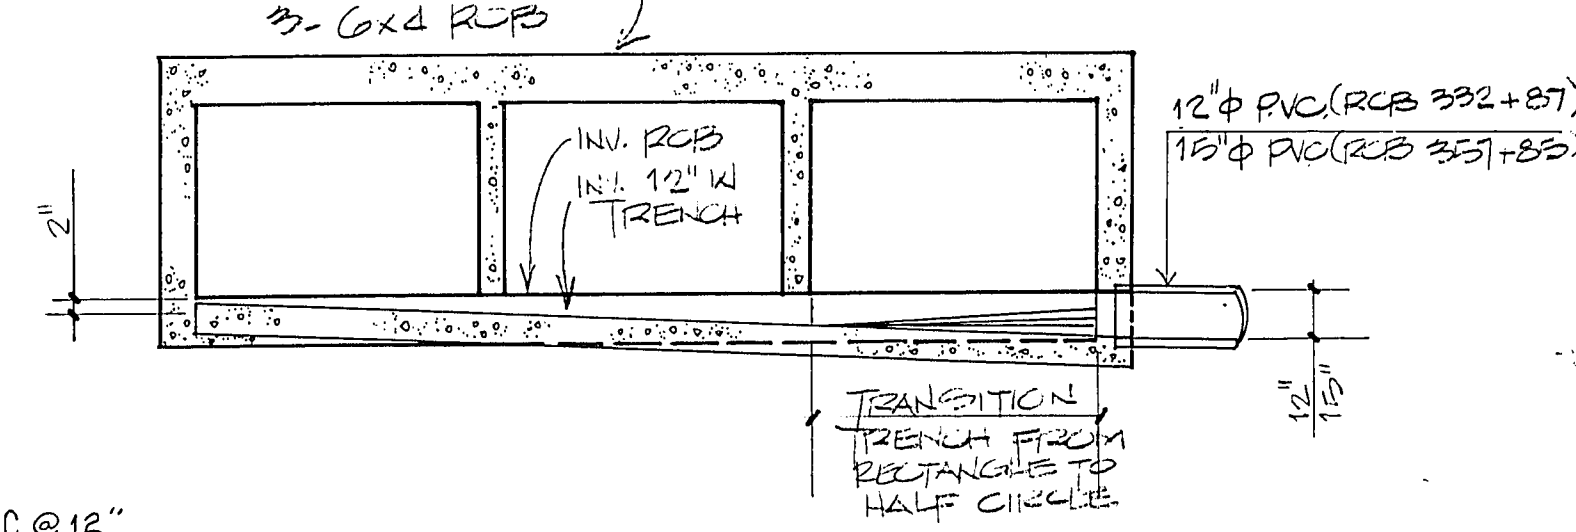


TRENCH-PROFILE 2

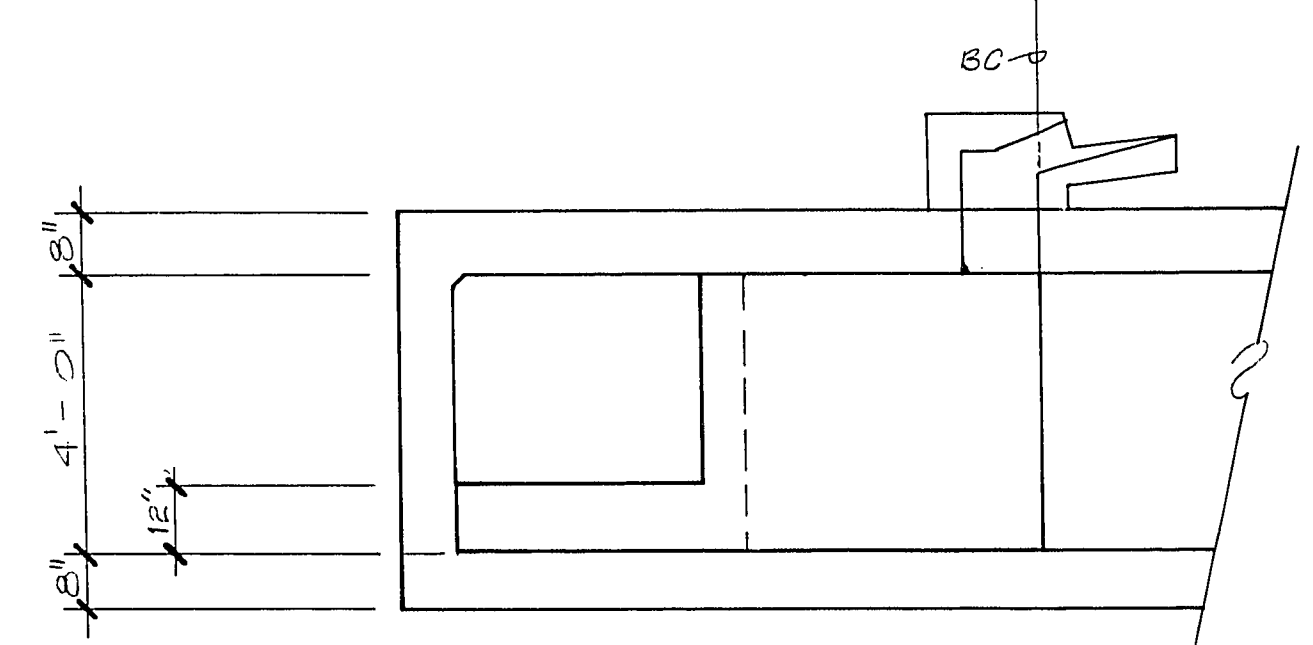

SECTION D

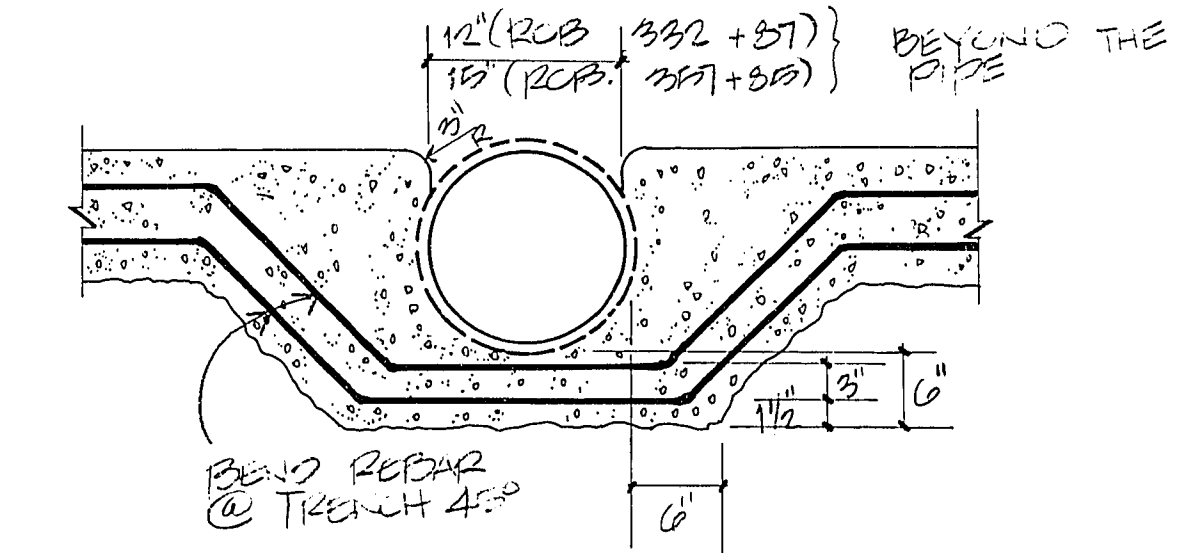


TRENCH-SECTION 3

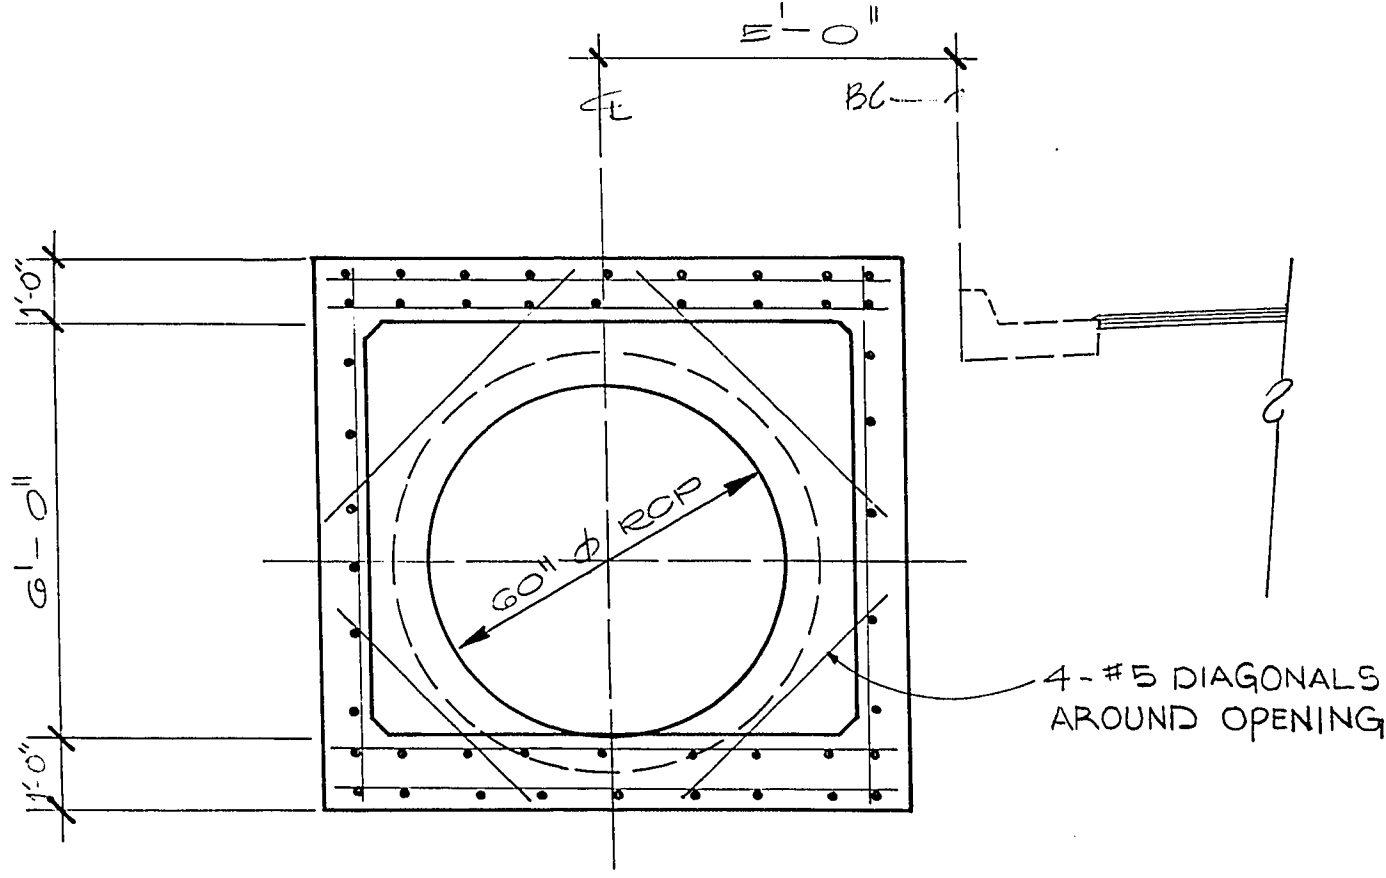


SECTION C

RECORD DRAWINGS
THESE PLANS SHOW RECORD INFORMATION RECEIVED FROM:
CONTRACTOR: SOUTHERN NEVADA PAVING/TAB
DATE: 6-18-90
THIS DATA MAY OR MAY NOT REFLECT THE ACTUAL FIELD LOCATIONS. ALL DATA SHOULD BE CONFIRMED PRIOR TO USE ON DEVELOPMENT OR ENGINEERING PLANS.

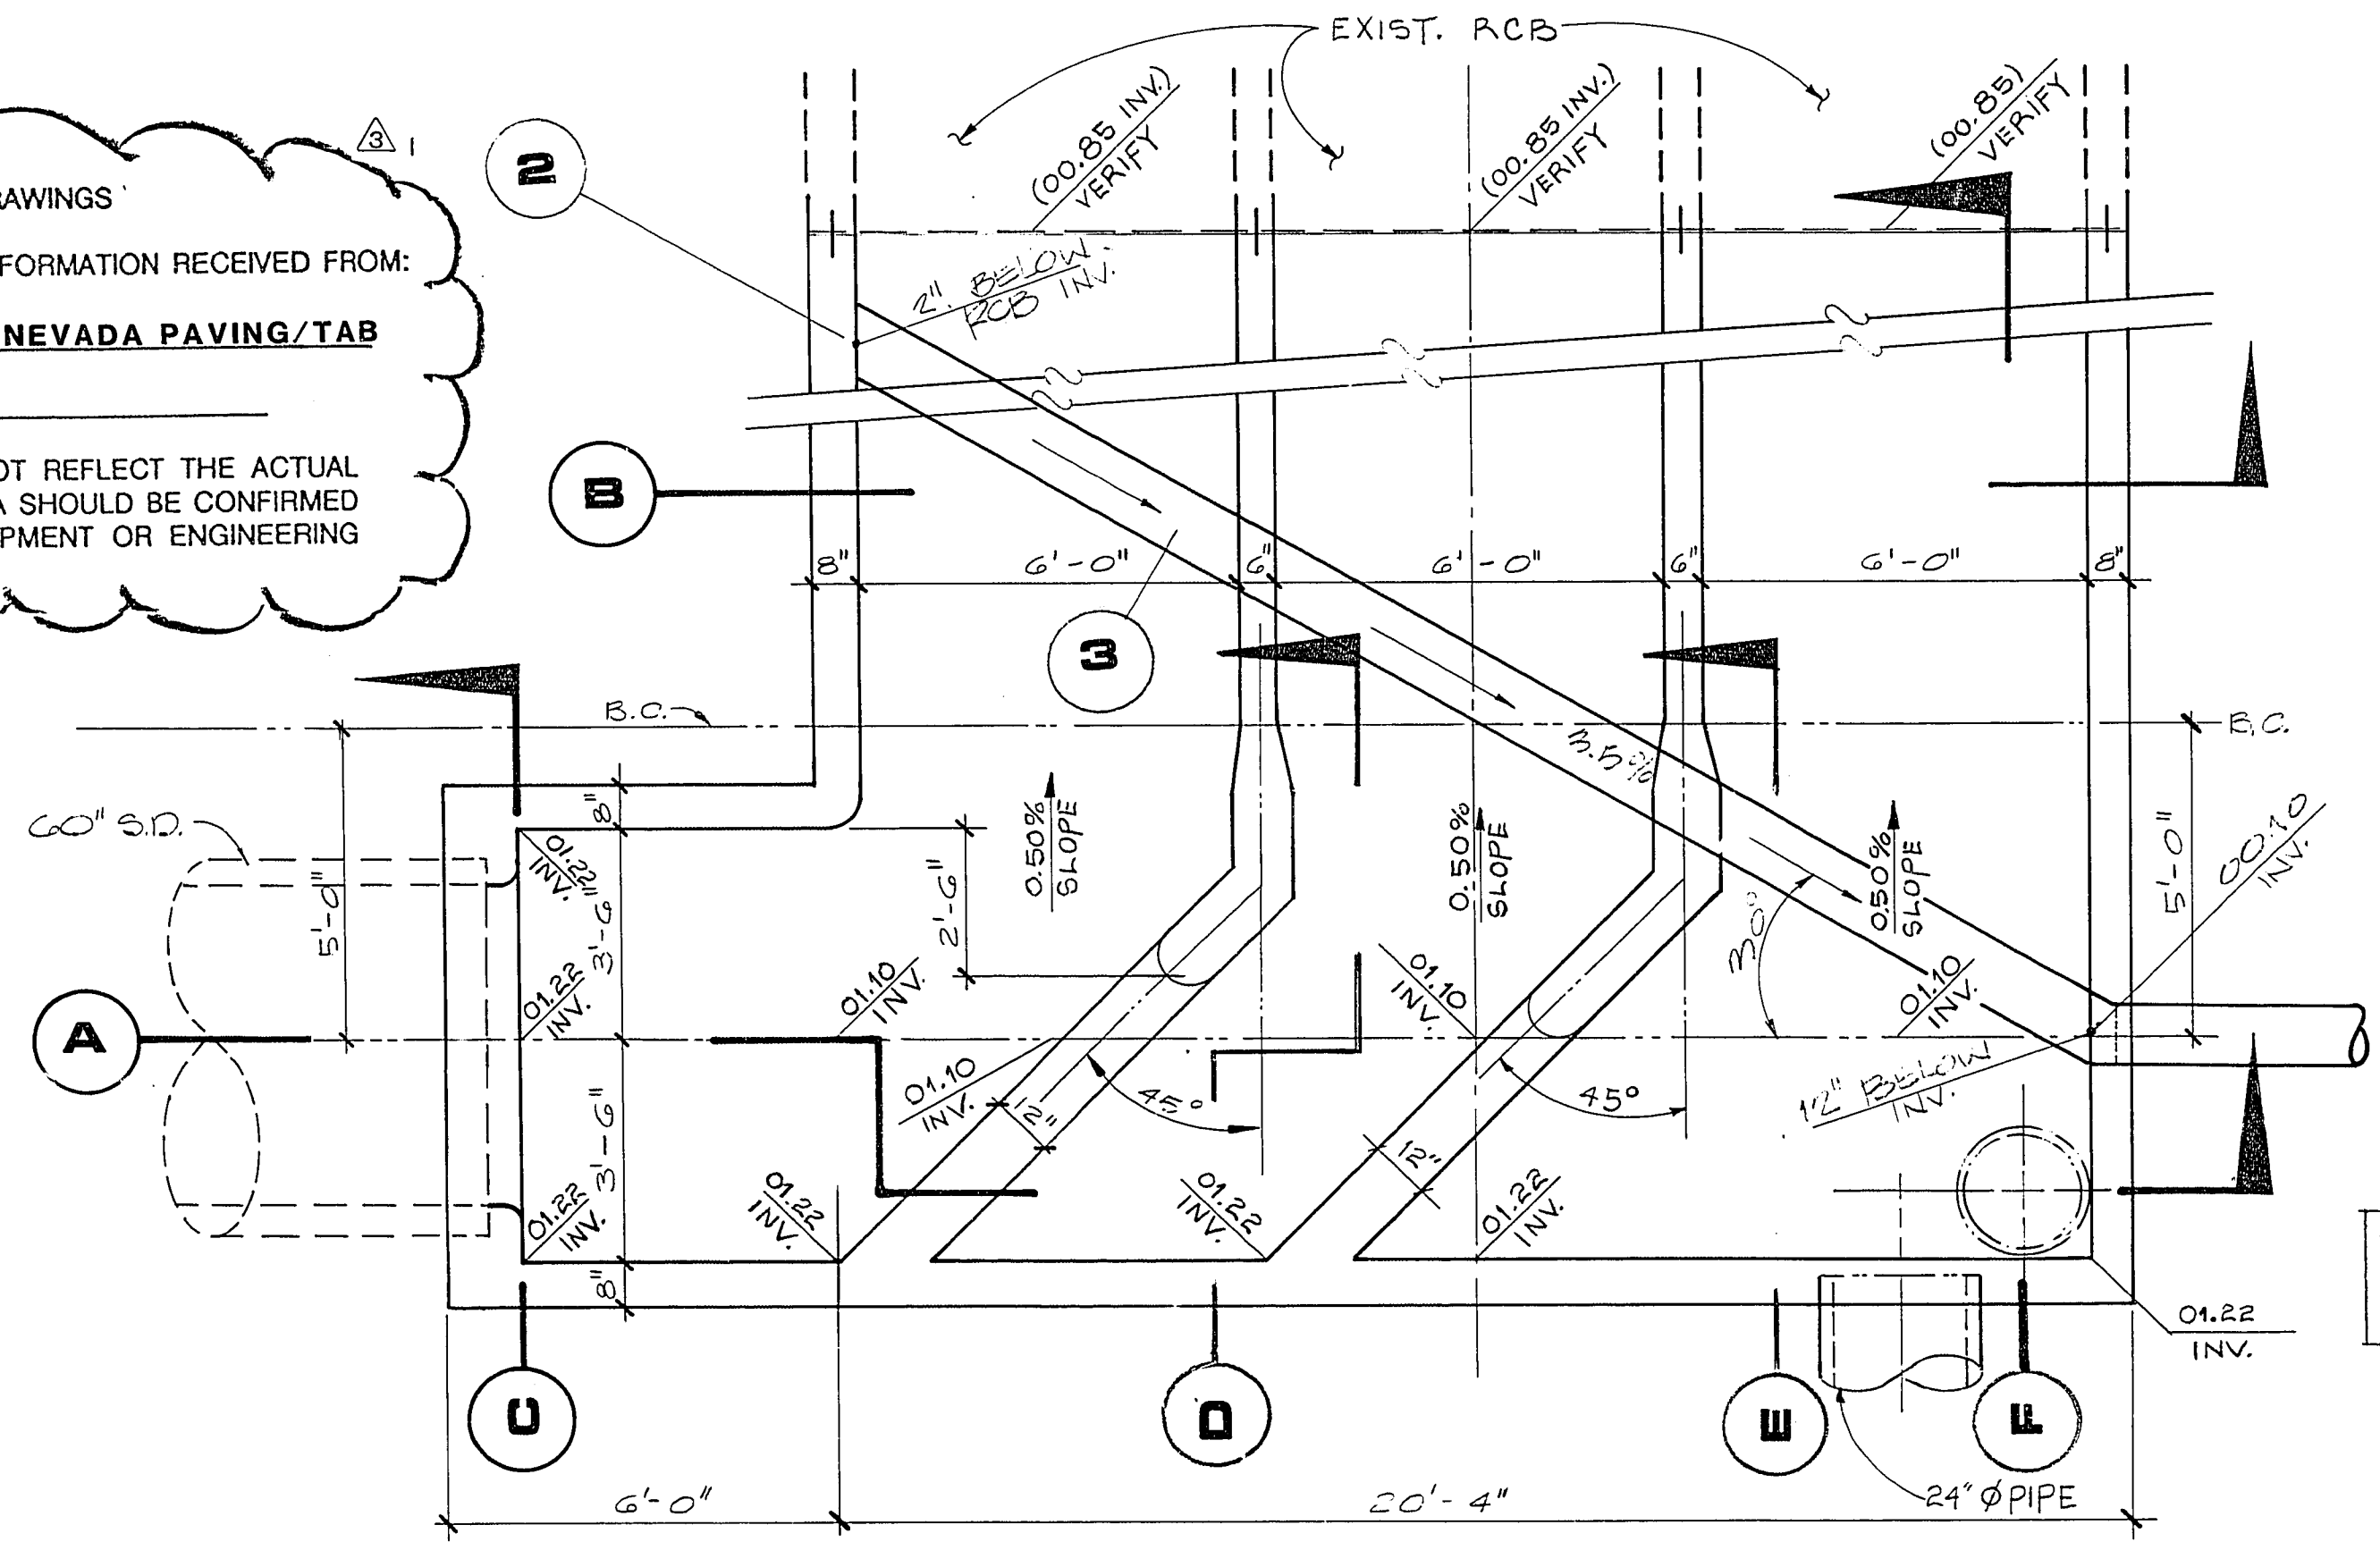

PLAN

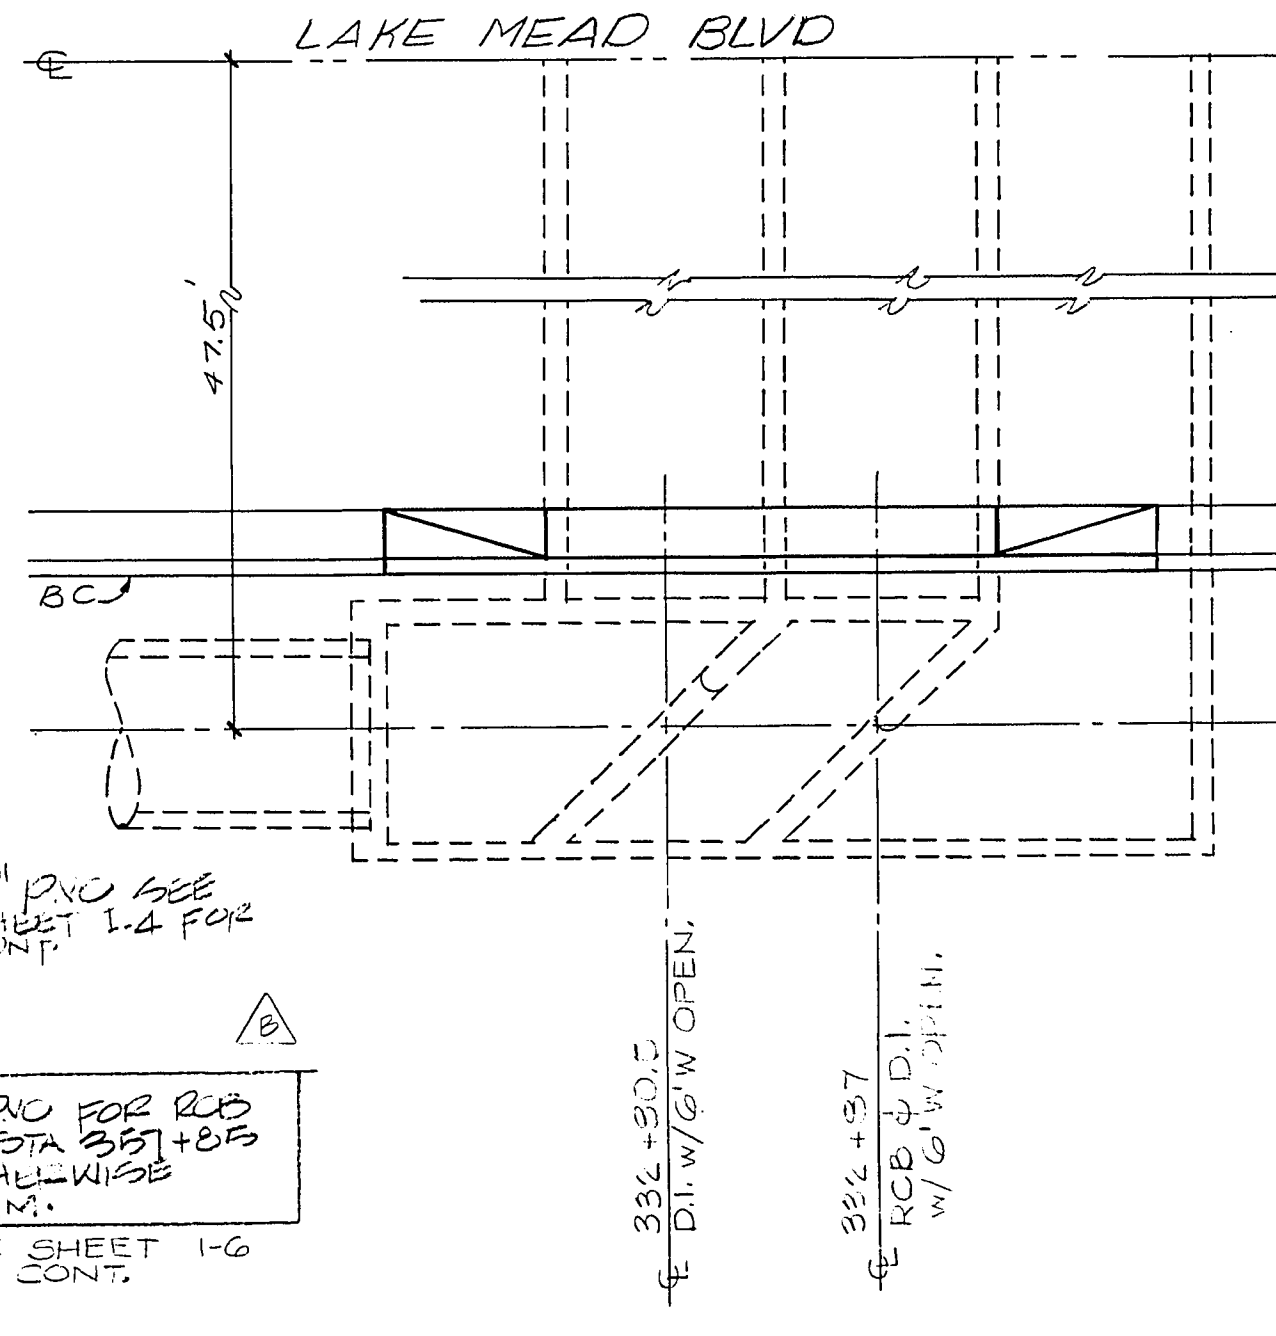

LOCATION PLAN

REV	DATE	DESCRIPTION
A	10/7/89	ISSUE TO BID
B	12/02/89	REVISE
C	11/18/90	RECORD DRAWING

NO. 501	NO. 502	NO. 503	NO. 504	NO. 505	NO. 506	NO. 507	NO. 508	NO. 509	NO. 510
---------	---------	---------	---------	---------	---------	---------	---------	---------	---------

NO. 511	NO. 512	NO. 513	NO. 514	NO. 515	NO. 516	NO. 517	NO. 518	NO. 519	NO. 520
---------	---------	---------	---------	---------	---------	---------	---------	---------	---------

NO. 521	NO. 522	NO. 523	NO. 524	NO. 525	NO. 526	NO. 527	NO. 528	NO. 529	NO. 530
---------	---------	---------	---------	---------	---------	---------	---------	---------	---------

NO. 531	NO. 532	NO. 533	NO. 534	NO. 535	NO. 536	NO. 537	NO. 538	NO. 539	NO. 540
---------	---------	---------	---------	---------	---------	---------	---------	---------	---------

NO. 541	NO. 542	NO. 543	NO. 544	NO. 545	NO. 546	NO. 547	NO. 548	NO. 549	NO. 550
---------	---------	---------	---------	---------	---------	---------	---------	---------	---------

NO. 551	NO. 552	NO. 553	NO. 554	NO. 555	NO. 556	NO. 557	NO. 558	NO. 559	NO. 560
---------	---------	---------	---------	---------	---------	---------	---------	---------	---------

NO. 561	NO. 562	NO. 563	NO. 564	NO. 565	NO. 566	NO. 567	NO. 568	NO. 569	NO. 570
---------	---------	---------	---------	---------	---------	---------	---------	---------	---------

NO. 571	NO. 572	NO. 573	NO. 574	NO. 575	NO. 576	NO. 577	NO. 578	NO. 579	NO. 580
---------	---------	---------	---------	---------	---------	---------	---------	---------	---------

NO. 581	NO. 582	NO. 583	NO. 584	NO. 585	NO. 586	NO. 587	NO. 588	NO. 589	NO. 590
---------	---------	---------	---------	---------	---------	---------	---------	---------	---------

NO. 591	NO. 592	NO. 593	NO. 594	NO. 595	NO. 596	NO. 597	NO. 598	NO. 599	NO. 600
---------	---------	---------	---------	---------	---------	---------	---------	---------	---------

NO. 601	NO. 602	NO. 603	NO. 604	NO. 605	NO. 606	NO. 607	NO. 608	NO. 609	NO. 610
---------	---------	---------	---------	---------	---------	---------	---------	---------	---------

NO. 611	NO. 612	NO. 613	NO. 614	NO. 615	NO. 616	NO. 617	NO. 618	NO. 619	NO. 620
---------	---------	---------	---------	---------	---------	---------	---------	---------	---------

NO. 621	NO. 622	NO. 623	NO. 624	NO. 625	NO. 626	NO. 627	NO. 628	NO. 629	NO. 630
---------	---------	---------	---------	---------	---------	---------	---------	---------	---------

NO. 631	NO. 632	NO. 633	NO. 634	NO. 635	NO. 636	NO. 637	NO. 638	NO. 639	NO. 640
---------	---------	---------	---------	---------	---------	---------	---------	---------	---------

NO. 641	NO. 642	NO. 643	NO. 644	NO. 645	NO. 646	NO. 647	NO. 648	NO. 649	NO. 650
---------	---------	---------	---------	---------	---------	---------	---------	---------	---------

NO. 651	NO. 652	NO. 653	NO. 654	NO. 655	NO. 656	NO. 657	NO. 658	NO. 659	NO. 660
---------	---------	---------	---------	---------	---------	---------	---------	---------	---------

NO. 661	NO. 662	NO. 663	NO. 664	NO. 665	NO. 666	NO. 667	NO. 668	NO. 669	NO. 670
---------	---------	---------	---------	---------	---------	---------	---------	---------	---------

NO. 671	NO. 672	NO. 673	NO. 674	NO. 675	NO. 676	NO. 677	NO. 678	NO. 679	NO. 680
---------	---------	---------	---------	---------	---------	---------	---------	---------	---------

NO. 681	NO. 682	NO. 683	NO. 684	NO. 685	NO. 686	NO. 687	NO. 688	NO. 689	NO. 690
---------	---------	---------	---------	---------	---------	---------	---------	---------	---------

NO. 691	NO. 692	NO. 693	NO. 694	NO. 695	NO. 696	NO. 697	NO. 698	NO. 699	NO. 700
---------	---------	---------	---------	---------	---------	---------	---------	---------	---------

NO. 701	NO. 702	NO. 703	NO. 704	NO. 705	NO. 706	NO. 707	NO. 708	NO. 709	NO. 710
---------	---------	---------	---------	---------	---------	---------	---------	---------	---------

NO. 711	NO. 712	NO. 713	NO. 714	NO. 715	NO. 716	NO. 717	NO. 718	NO. 719	NO. 720
---------	---------	---------	---------	---------	---------	---------	---------	---------	---------

NO. 721	NO. 722	NO. 723	NO. 724	NO. 725	NO. 726	NO. 727	NO. 728	NO. 729	NO. 730
---------	---------	---------	---------	---------	---------	---------	---------	---------	---------

NO. 731	NO. 732	NO. 733	NO. 734	NO. 735	NO. 736	NO. 737	NO. 738	NO. 739	NO. 740
---------	---------	---------	---------	---------	---------	---------	---------	---------	---------

NO. 741	NO. 742	NO. 743	NO. 744	NO. 745	NO. 746	NO. 747	NO. 748	NO. 749	NO. 750
---------	---------	---------	---------	---------	---------	---------	---------	---------	---------

NO. 751	NO. 752	NO. 753	NO. 754	NO. 755	NO. 756	NO. 757	NO. 758	NO. 759	NO. 760
---------	---------	---------	---------	---------	---------	---------	---------	---------	---------

NO. 761	NO. 762	NO. 763	NO. 764	NO. 765	NO. 766	NO. 767	NO. 768	NO. 769	NO. 770
---------	---------	---------	---------	---------	---------	---------	---------	---------	---------

NO. 771	NO. 772	NO. 773	NO. 774	NO. 775	NO. 776	NO. 777	NO. 778	NO. 779	NO. 780
---------	---------	---------	---------	---------	---------	---------	---------	---------	---------

NO. 781	NO. 782	NO. 783	NO. 784	NO. 785	NO. 786	NO. 787	NO. 788	NO. 789	NO. 790
---------	---------	---------	---------	---------	---------	---------	---------	---------	---------

NO. 791	NO. 792	NO. 793	NO. 794	NO. 795	NO. 796	NO. 797	NO. 798	NO. 799	NO. 800
---------	---------	---------	---------	---------	---------	---------	---------	---------	---------

NO. 801	NO. 802	NO. 803	NO. 804	NO. 805	NO. 806	NO. 807	NO. 808	NO. 809	NO. 810
---------	---------	---------	---------	---------	---------	---------	---------	---------	---------

NO. 811	NO. 812	NO. 813	NO. 814	NO. 815	NO. 816	NO. 817	NO. 818	NO. 819	NO. 820
---------	---------	---------	---------	---------	---------	---------	---------	---------	---------

NO. 821	NO. 822	NO. 823	NO. 824	NO. 825	NO. 826	NO. 827	NO. 828	NO. 829	NO. 830
---------	---------	---------	---------	---------	---------	---------	---------	---------	---------

NO. 831	NO. 832	NO. 833	NO. 834	NO. 835	NO. 836	NO. 837	NO. 838	NO. 839	NO. 840
---------	---------	---------	---------	---------	---------	---------	---------	---------	---------

NO. 841	NO. 842	NO. 843	NO. 844	NO. 845	NO. 846	NO. 847	NO. 848	NO. 849	NO. 850
---------	---------	---------	---------	---------	---------	---------	---------	---------	---------

NO. 851	NO. 852	NO. 853	NO. 854	NO. 855	NO. 856	NO. 857	NO. 858	NO. 859	NO. 860
---------	---------	---------	---------	---------	---------	---------	---------	---------	---------

NO. 861	NO. 862	NO. 863	NO. 864	NO. 865	NO. 866	NO. 867	NO. 868	NO. 869	NO. 870
---------	---------	---------	---------	---------	---------	---------	---------	---------	---------

NO. 871	NO. 872	NO. 873	NO. 874	NO. 875	NO. 876	NO. 877	NO. 878	NO. 879	NO. 880
---------	---------	---------	---------	---------	---------	---------	---------	---------	---------

NO. 881	NO. 882	NO. 883	NO. 884	NO. 885	NO. 886	NO. 887	NO. 888	NO. 889	NO. 890
---------	---------	---------	---------	---------	---------	---------	---------	---------	---------

NO. 891	NO. 892	NO. 893	NO. 894	NO. 895	NO. 896	NO. 897	NO. 898	NO. 899	NO. 900
---------	---------	---------	---------	---------	---------	---------	---------	---------	---------

NO. 901	NO. 902	NO. 903	NO. 904	NO. 905	NO. 906	NO. 907	NO. 908	NO. 909	NO. 910
---------	---------	---------	---------	---------	---------	---------	---------	---------	---------

NO. 911	NO. 912	NO. 913	NO. 914	NO. 915	NO. 916	NO. 917	NO. 918	NO. 919	NO. 920
---------	---------	---------	---------	---------	---------	---------	---------	---------	---------

NO. 921	NO. 922	NO. 923	NO. 924	NO. 925	NO. 926	NO. 927	NO. 928	NO. 929	NO. 930
---------	---------	---------	---------	---------	---------	---------	---------	---------	---------

NO. 931	NO. 932	NO. 933	NO. 934	NO. 935	NO. 936	NO. 937	NO. 938	NO. 939	NO. 940
---------	---------	---------	---------	---------	---------	---------	---------	---------	---------

NO. 941	NO. 942	NO. 943	NO. 944	NO. 945	NO. 946	NO. 947	NO. 948	NO. 949	NO. 950
---------	---------	---------	---------	---------	---------	---------	---------	---------	---------

NO. 951	NO. 952	NO. 953	NO. 954	NO. 955	NO. 956	NO. 957	NO. 958	NO. 959	NO. 960
---------	---------	---------	---------	---------	---------	---------	---------	---------	---------

NO. 961	NO. 962	NO. 963	NO. 964	NO. 965	NO. 966	NO. 967	NO. 968	NO. 969	NO. 970
---------	---------	---------	---------	---------	---------	---------	---------	---------	---------

NO. 971	NO. 972	NO. 973	NO. 974	NO. 975	NO. 976	NO. 977	NO. 978	NO. 979	NO. 980
---------	---------	---------	---------	---------	---------	---------	---------	---------	---------

NO. 981	NO. 982	NO. 983	NO. 984	NO. 985	NO. 986	NO. 987	NO. 988	NO. 989	NO. 990
---------	---------	---------	---------	---------	---------	---------	---------	---------	---------

NO. 991	NO. 992	NO. 993	NO. 994	NO. 995	NO. 996	NO. 997	NO. 998	NO. 999	NO. 1000
---------	---------	---------	---------	---------	---------	---------	---------	---------	----------

NO. 1001	NO. 1002	NO. 1003	NO. 1004	NO. 1005	NO. 1006	NO. 1007	NO. 1008	NO. 1009	NO. 1010
----------	----------	----------	----------	----------	----------	----------	----------	----------	----------

NO. 1011	NO. 1012	NO. 1013	NO. 1014	NO. 1015	NO. 1016	NO. 1017	NO. 1018	NO. 1019	NO. 1020
----------	----------	----------	----------	----------	----------	----------	----------	----------	----------

NO. 1021	NO. 1022	NO. 1023	NO. 1024	NO. 1025	NO. 1026	NO. 1027	NO. 1028	NO. 1029	NO. 1030
----------	----------	----------	----------	----------	----------	----------	----------	----------	----------

NO. 1031	NO. 1032	NO. 1033	NO. 1034	NO. 1035	NO. 1036	NO. 1037	NO. 1038	NO. 1039	NO. 1040
----------	----------	----------	----------	----------	----------	----------	----------	----------	----------

NO. 1041	NO. 1042	NO. 1043	NO. 1044	NO. 1045	NO. 1046	NO. 1047	NO. 1048	NO. 1049	NO. 1050
----------	----------	----------	----------	----------	----------	----------	----------	----------	----------

NO. 1051	NO. 1052	NO. 1053	NO. 1054	NO. 1055	NO. 1056	NO. 1057	NO. 1058	NO. 1059	NO. 1060
----------	----------	----------	----------	----------	----------	----------	----------	----------	----------

NO. 1061	NO. 1062	NO. 1063	NO. 1064	NO. 1065	NO. 1066	NO. 1067	NO. 1068	NO. 1069	NO. 1070
----------	----------	----------	----------	----------	----------	----------	----------	----------	----------

NO. 1071	NO. 1072	NO. 1073	NO. 1074	NO. 1075	NO. 1076	NO. 1077	NO. 1078	NO. 1079	NO. 1080
----------	----------	----------	----------	----------	----------	----------	----------	----------	----------

NO. 1081	NO. 1082	NO. 1083	NO. 1084	NO. 1085	NO. 1086	NO. 1087	NO. 1088	NO. 1089	NO. 1090
----------	----------	----------	----------	----------	----------	----------	----------	----------	----------

NO. 1091	NO. 1092	NO. 1093	NO. 1094	NO. 1095	NO. 1096	NO. 1097	NO. 1098	NO. 1099	NO. 1100
----------	----------	----------	----------	----------	----------	----------	----------	----------	----------

NO. 1101	NO. 1102	NO. 1103	NO. 1104	NO. 1105	NO. 1106	NO. 1107	NO. 1108	NO. 1109	NO. 1110
----------	----------	----------	----------	----------	----------	----------	----------	----------	----------

NO. 1111	NO. 1112	NO. 1113	NO. 1114	NO. 1115	NO. 1116	NO. 1117	NO. 1118	NO. 1119	NO. 1120
----------	----------	----------	----------	----------	----------	----------	----------	----------	----------

NO. 1121	NO. 1122	NO. 1123	NO. 1124	NO. 1125	NO. 1126	NO. 1127	NO. 1128	NO. 1129	NO. 1130
----------	----------	----------	----------	----------	----------	----------	----------	----------	----------

NO. 1131	NO. 1132	NO. 1133	NO. 1134	NO. 1135	NO. 1136	NO. 1137	NO. 1138	NO. 1139	NO. 1140
----------	----------	----------	----------	----------	----------	----------	----------	----------	----------

NO. 1141	NO. 1142	NO. 1143	NO. 1144	NO. 1145	NO. 1146	NO. 1147	NO. 1148	NO. 1149	NO. 1150
----------	----------	----------	----------	----------	----------	----------	----------	----------	----------

NO. 1151	NO. 1152	NO. 1153	NO. 1154	NO. 1155	NO. 1156	NO. 1157	NO. 1158	NO. 1159	NO. 1160
----------	----------	----------	----------	----------	----------	----------	----------	----------	----------

NO. 1161	NO. 1162	NO. 1163	NO. 1164	NO. 1165	NO. 1166	NO. 1167	NO. 1168	NO. 1169	NO. 1170
----------	----------	----------	----------	----------	----------	----------	----------	----------	----------

NO. 1171	NO. 1172	NO. 1173	NO. 1174	NO. 1175	NO. 1176	NO. 1177	NO. 1178	NO. 1179	NO. 1180
----------	----------	----------	----------	----------	----------	----------	----------	----------	----------

NO. 1181	NO. 1182	NO. 1183	NO. 1184	NO. 1185	NO. 1186	NO. 1187	NO. 1188	NO. 1189	NO. 1190
----------	----------	----------	----------	----------	----------	----------	----------	----------	----------

NO. 1191	NO. 1192	NO. 1193	NO. 1194	NO. 1195	NO. 1196	NO. 1197	NO. 1198	NO. 1199	NO. 1200
----------	----------	----------	----------	----------	----------	----------	----------	----------	----------

NO. 1201	NO. 1202	NO. 1203	NO. 1204	NO. 1205	NO. 1206	NO. 1207	NO. 1208	NO. 1209	NO. 1210
----------	----------	----------	----------	----------	----------	----------	----------	----------	----------

NO. 1211	NO. 1212	NO. 1213	NO. 1214	NO. 1215	NO. 1216	NO. 1217	NO. 1218	NO. 1219	NO. 1220
----------	----------	----------	----------	----------	----------	----------	----------	----------	----------

NO. 1221	NO. 1222	NO. 1223	NO. 1224	NO. 1225	NO. 1226	NO. 1227	NO. 1228	NO. 1229	NO. 1230
----------	----------	----------	----------	----------	----------	----------	----------	----------	----------

NO. 1231	NO. 1232	NO. 1233	NO. 1234	NO. 1235	NO. 1236	NO. 1237	NO. 1238	NO. 1239	NO. 1240
----------	----------	----------	----------	----------	----------	----------	----------	----------	----------

NO. 1241	NO. 1242	NO. 1243	NO. 1244	NO. 1245	NO. 1246	NO. 1247	NO. 1248	NO. 1249	NO. 1250
----------	----------	----------	----------	----------	----------	----------	----------	----------	----------

NO. 1251	NO. 1252	NO. 1253	NO. 1254	NO. 1255	NO. 1256	NO. 1257	NO. 1258	NO. 1259	NO. 1260
----------	----------	----------	----------	----------	----------	----------	----------	----------	----------

NO. 1261	NO. 1262	NO. 1263	NO. 1264	NO. 1265	NO. 1266	NO. 1267	NO. 1268	NO. 1269	NO. 1270
----------	----------	----------	----------	----------	----------	----------	----------	----------	----------

NO. 1271	NO. 1272	NO. 1273	NO. 1274	NO. 1275	NO. 1276	NO. 1277	NO. 1278	NO. 1279	NO. 1280
----------	----------	----------	----------	----------	----------	----------	----------	----------	----------

NO. 1281	NO. 1282	NO. 1283	NO. 1284	NO. 1285	NO. 1286	NO. 1287	NO. 1288	NO. 1289	NO. 1290
----------	----------	----------	----------	----------	----------	----------	----------	----------	----------

NO. 1291	NO. 1292	NO. 1293	NO. 1294	NO. 1295	NO. 1296	NO. 1297	NO. 1298	NO. 1299	NO. 1300
----------	----------	----------	----------	----------	----------	----------	----------	----------	----------

NO. 1301	NO. 1302	NO. 1303	NO. 1304	NO. 1305	NO. 1306	NO. 1307	NO. 1308	NO. 1309	NO. 1310
----------	----------	----------	----------	----------	----------	----------	----------	----------	----------

NO. 1311	NO. 1312	NO. 1313	NO. 1314	NO. 1315	NO. 1316	NO. 1317	NO. 1318	NO. 1319	NO. 1320
----------	----------	----------	----------	----------	----------	----------	----------	----------	----------

NO. 1321	NO. 1322	NO. 1323	NO. 1324	NO. 1325	NO. 1326	NO. 1327	NO. 1328	NO. 1329	NO. 1330
----------	----------	----------	----------	----------	----------	----------	----------	----------	----------

NO. 1331	NO. 1332	NO. 1333	NO. 1334	NO. 1335	NO. 1336	NO. 1337	NO. 1338	NO. 1339	NO. 1340
----------	----------	----------	----------	----------	----------	----------	----------	----------	----------

NO. 1341	NO. 1342	NO. 1343	NO. 1344	NO. 1345	NO. 1346	NO. 1347	NO. 1348	NO. 1349	NO. 1350
----------	----------	----------	----------	----------	----------	----------	----------	----------	----------

NO. 1351	NO. 1352	NO. 1353	NO. 1354	NO. 1355	NO. 1356	NO. 1357	NO. 1358	NO. 1359	NO. 1360
----------	----------	----------	----------	----------	----------	----------	----------	----------	----------