



SUMMERLIN

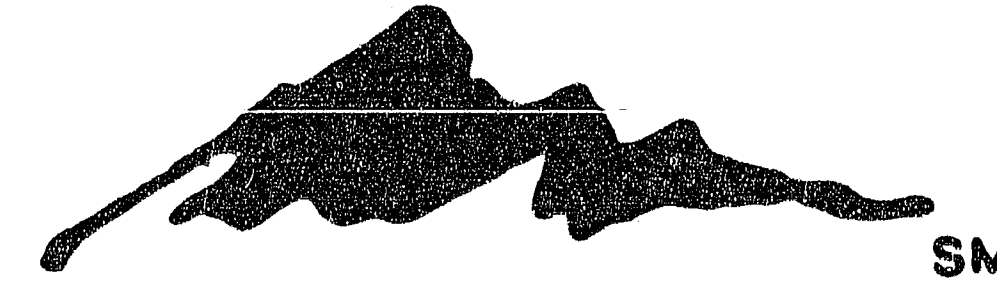

VILLAGE 1 NORTH LAKE MEAD BLVD.

STORM DRAIN, CURB & GUTTER, AND PAVEMENT

Howard Hughes Properties

 **G.C. WALLACE, INC.**
Engineering/Architecture
1555 SOUTH RAINBOW BLVD./LAS VEGAS, NEVADA 89102

RECORD DRAWINGS
THESE PLANS SHOW RECORD INFORMATION RECEIVED FROM:
CONTRACTOR: SOUTHERN NEVADA PAVING/TAR
DATE: 9-18-99
THIS DATA MAY OR MAY NOT REFLECT THE ACTUAL
FIELD LOCATIONS. ALL DATA SHOULD BE CONFIRMED
PRIOR TO USE ON DEVELOPMENT OR ENGINEERING
PLANS.

SHEET 1 OF 17

RECORD DRAWING
DATE: 8/12/89
ISSUE TO BID: 8/17/89
SUBMITAL SET: 7/28/89

Location: Las Vegas, Nevada

JOB NO. 820.314

VILLAGE 1 NORTH LAKE MEAD BLVD.

SUMMERLIN



VILLAGE 1 NORTH LAKE MEAD BLVD.

STORM DRAIN, CURB & GUTTER, AND PAVEMENT

Howard Hughes Properties

