



JOB NO. 620.314

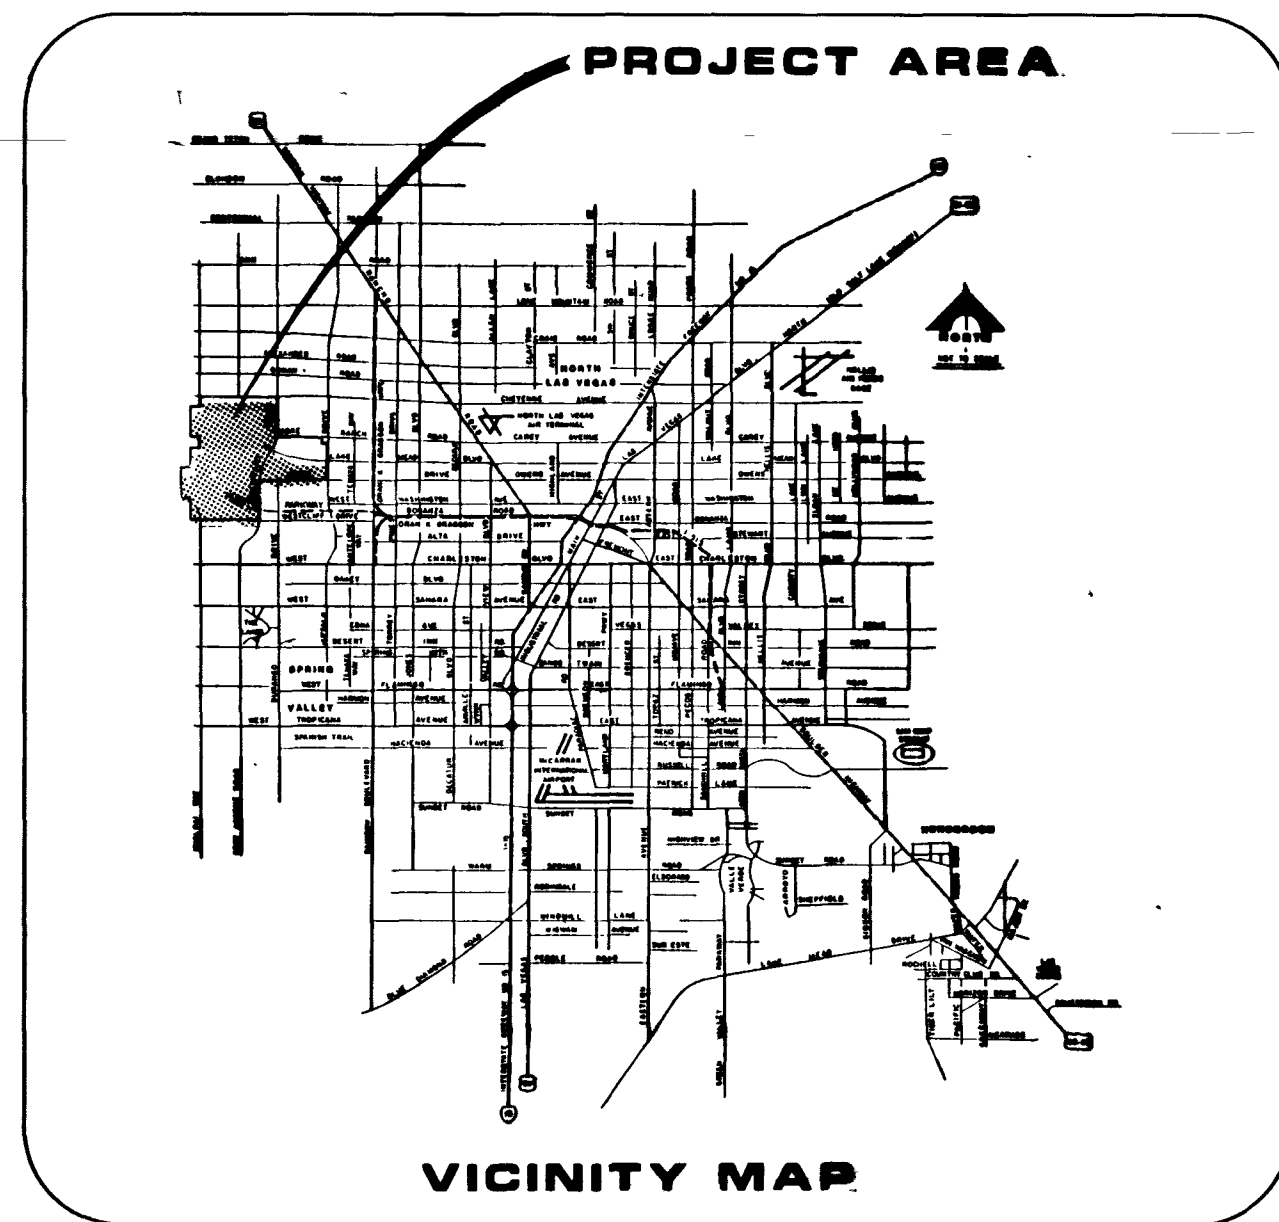

VICINITY MAP

8/84 DIETRICH POST 65326

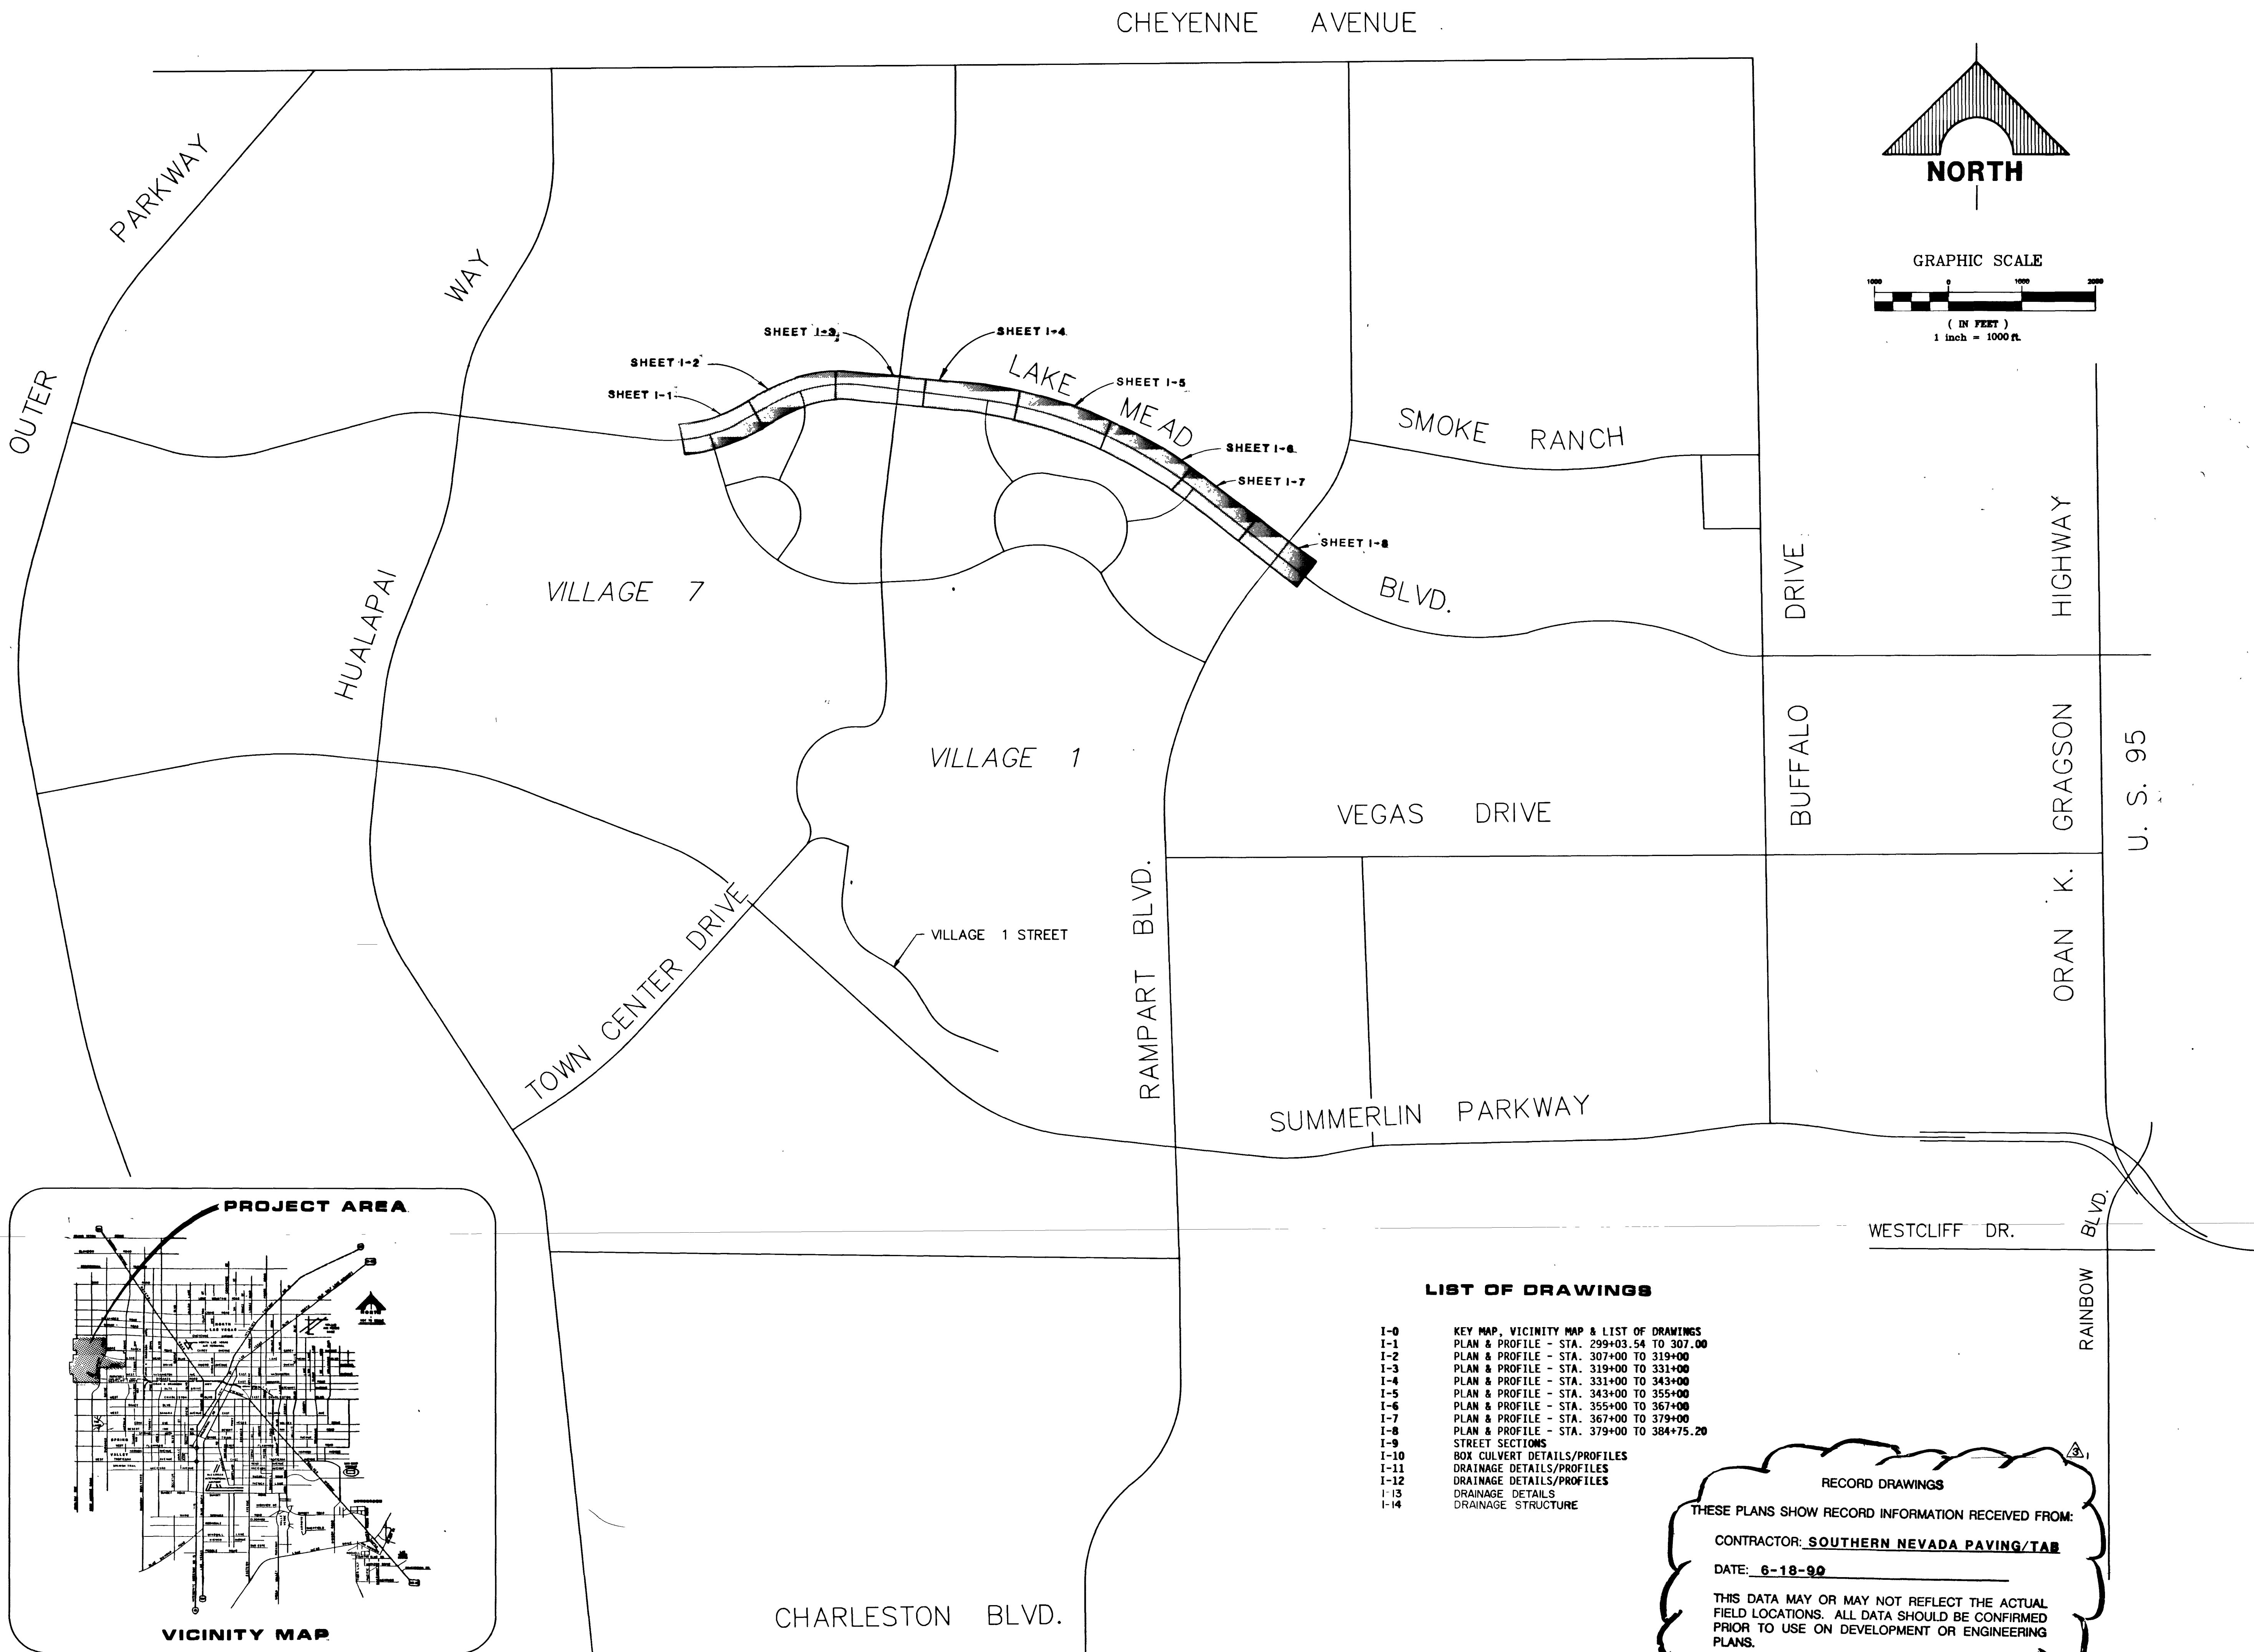

LIST OF DRAWINGS

- I-0 KEY MAP, VICINITY MAP & LIST OF DRAWINGS
- I-1 PLAN & PROFILE - STA. 299+03.54 TO 307.00
- I-2 PLAN & PROFILE - STA. 307+00 TO 319+00
- I-3 PLAN & PROFILE - STA. 319+00 TO 331+00
- I-4 PLAN & PROFILE - STA. 331+00 TO 343+00
- I-5 PLAN & PROFILE - STA. 343+00 TO 355+00
- I-6 PLAN & PROFILE - STA. 355+00 TO 367+00
- I-7 PLAN & PROFILE - STA. 367+00 TO 379+00
- I-8 PLAN & PROFILE - STA. 379+00 TO 384+75.20
- I-9 STREET SECTIONS
- I-10 BOX CULVERT DETAILS/PROFILES
- I-11 DRAINAGE DETAILS/PROFILES
- I-12 DRAINAGE DETAILS/PROFILES
- I-13 DRAINAGE DETAILS
- I-14 DRAINAGE STRUCTURE


RECORD DRAWINGS

THESE PLANS SHOW RECORD INFORMATION RECEIVED FROM:

CONTRACTOR: SOUTHERN NEVADA PAVING/TAR

DATE: 6-18-90

THIS DATA MAY OR MAY NOT REFLECT THE ACTUAL FIELD LOCATIONS. ALL DATA SHOULD BE CONFIRMED PRIOR TO USE ON DEVELOPMENT OR ENGINEERING PLANS.

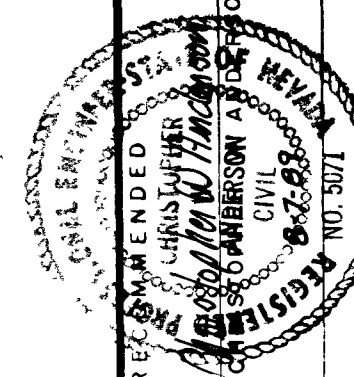

HOWARD HUGHES PROPERTIES
VILLAGE 1 NORTH - LAKE MEAD BLVD.
KEY MAP, VICINITY MAP
AND LIST OF DRAWINGS

SHEET
I-0

3 OF 17 SHEETS

1894

15-3-71

107-VI694

