


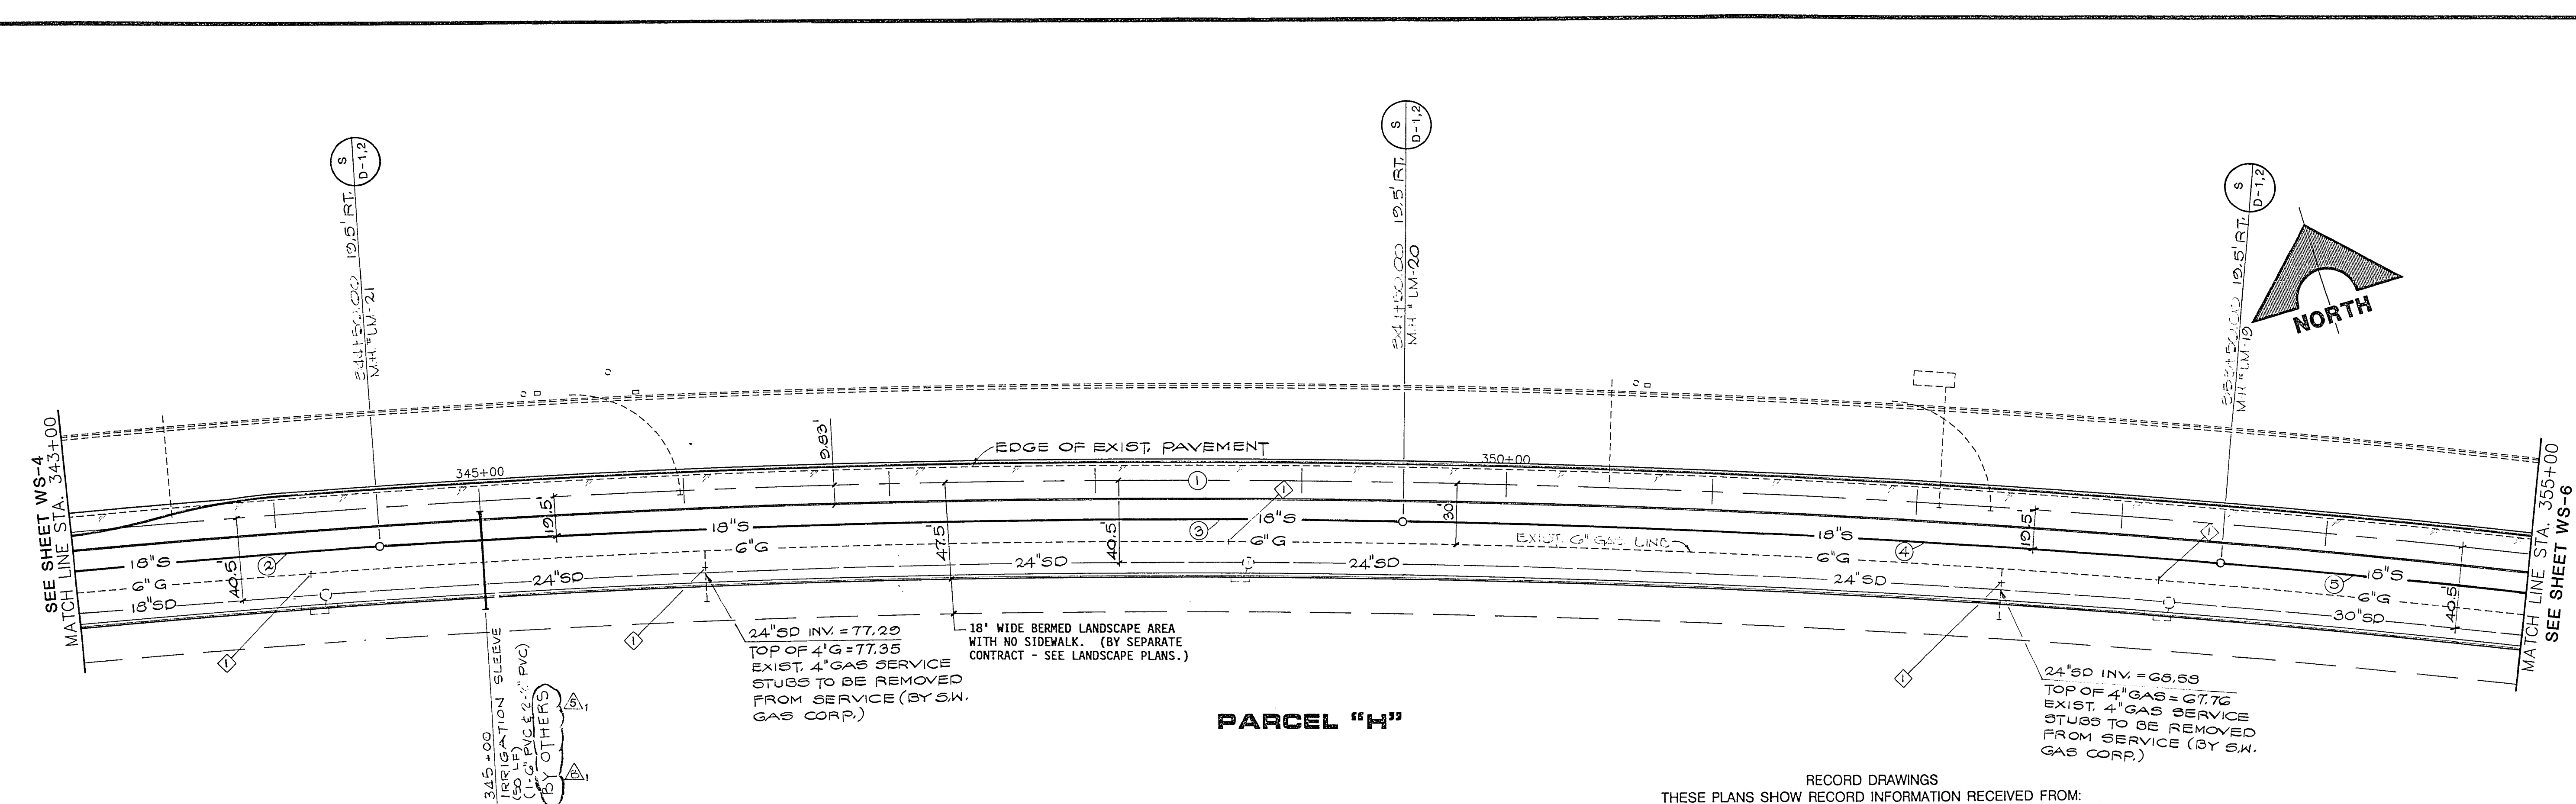

CURVE NO.	DELTA	RADIUS	LENGTH	TANGENT	DESCRIPTION
1	11°27'33"	6000.00'	1200.00'	602.01'	CENTERLINE
2	01°25'57"	5980.50'	149.51'	74.76'	SEWER MAIN
3	04°46'29"	5980.50'	498.38'	249.33'	SEWER MAIN
4	03°49'11"	5980.50'	398.70'	199.42'	SEWER MAIN
5	01°25'57"	5980.50'	149.51'	74.76'	SEWER MAIN



LAKE MEAD BLVD.

SCALE: HORIZ.-1"=40'
VERT.-1"=10'

RECORD DRAWINGS
THESE PLANS SHOW RECORD INFORMATION RECEIVED FROM:

CONTRACTOR WESTERN STATES DATE 5/15/90

NOTE: THESE PLANS ARE FOR THE PURPOSE OF ROADWAY IMPROVEMENTS AND UTILITIES (PAVEMENT WITH BASE CURB AND GUTTER, STORM DRAIN, WATER, SEWER, ETC.). ALL ROADWAY AND LANDSCAPE AREAS HAVE BEEN PREVIOUSLY ROUGH GRADED. ANY LIMITS OF ROUGH GRADING SHOWN ARE FOR REFERENCE ONLY. FOR SCOPE AND LIMITS OF ROUGH GRADING, SEE "VILLAGE 1 NORTH - ROUGH GRADING" PACKAGE. FOR FINISH GRADING OF LANDSCAPE AREAS AND SIDEWALK LOCATIONS, SEE LANDSCAPE PACKAGE BY GLANVILLE ASSOCIATES.

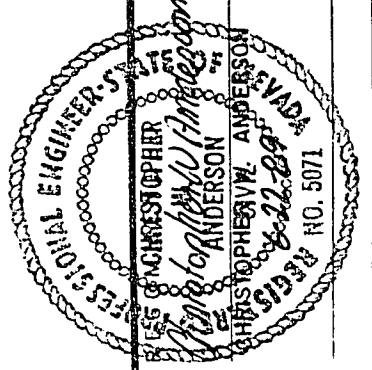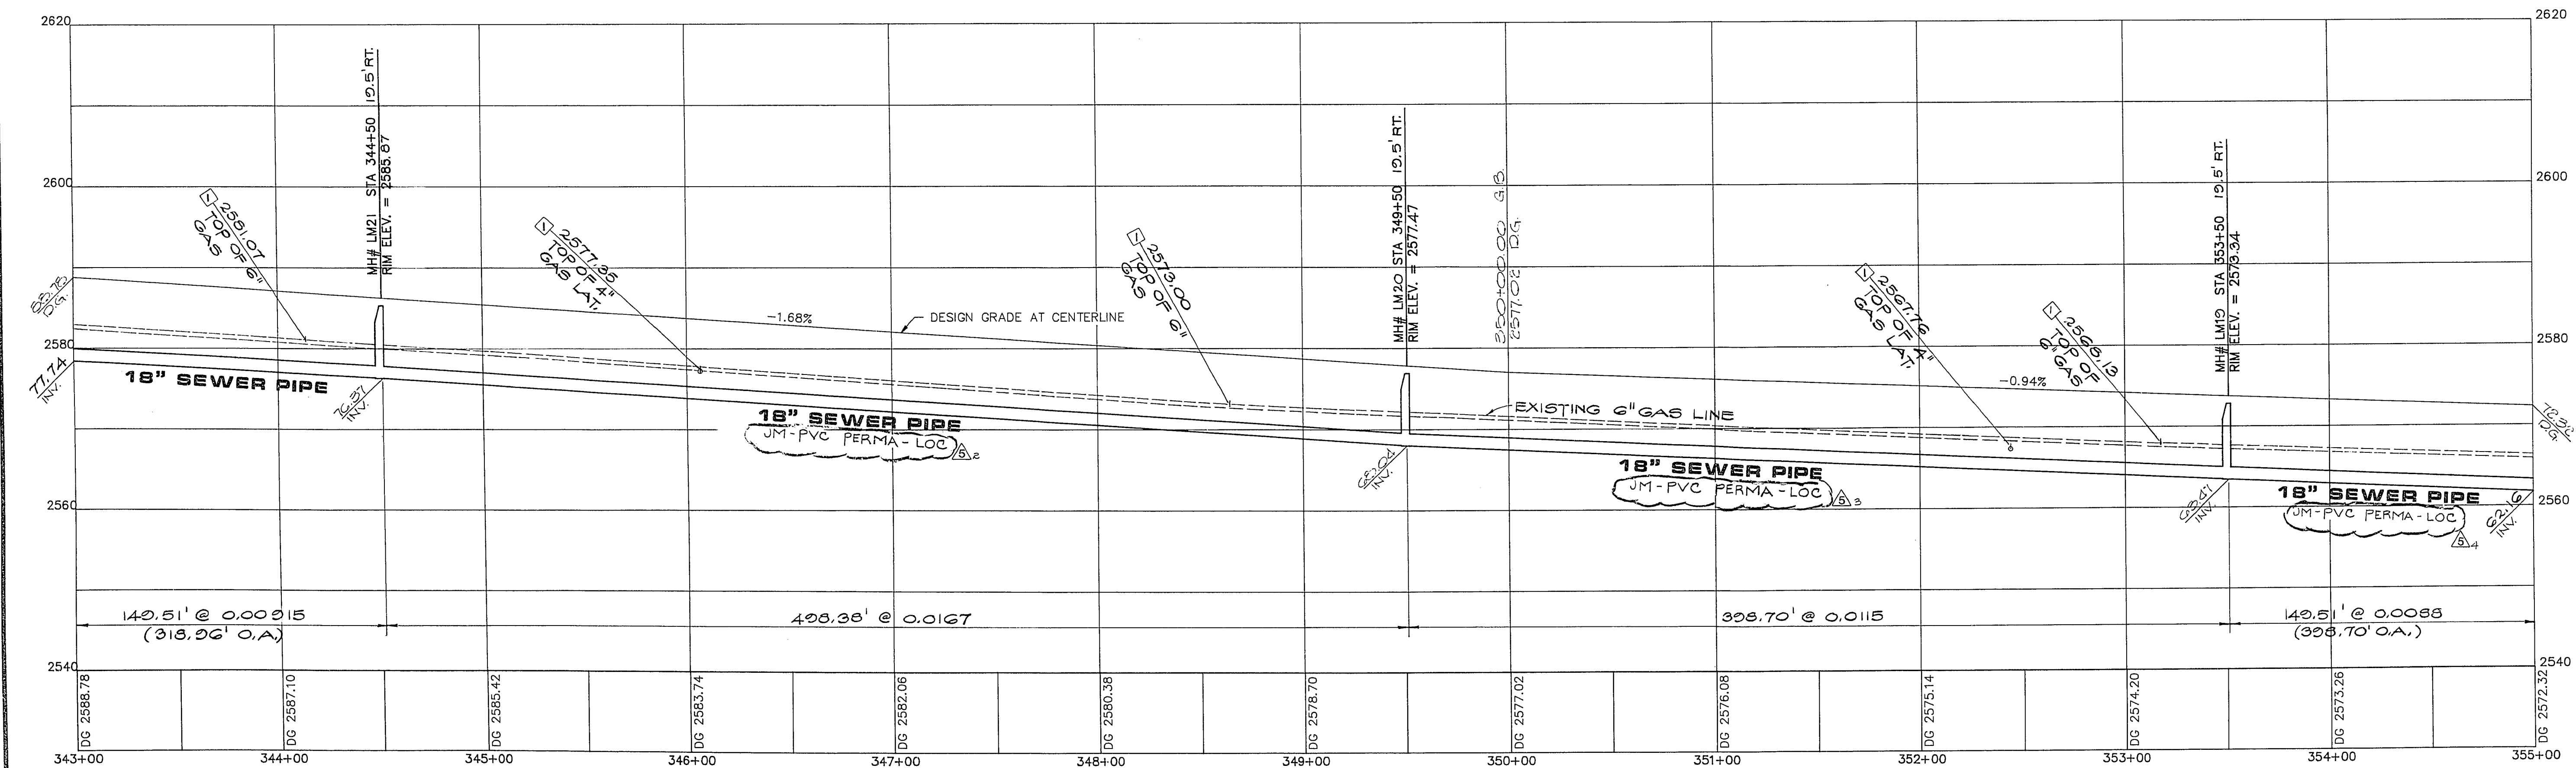

REV	DATE	DESCRIPTION
A	6/22/89	ISSUE TO BID WATER/SEWER
B	7/23/89	ADDENDUM #2
C	7/20/89	ISSUE FOR CONSTRUCTION
D	5/15/90	CHANGE ORDER #0
E		RECORD DRAWINGS

G.C. WALLACE, INC.
Engineering/Architecture
1515 SOUTH RAINBOW BLVD. LAS VEGAS, NEVADA 89102

HOWARD HUGHES PROPERTIES
VILLAGE 1 NORTH LAKE MEAD BLVD.
WATER AND SEWER PLAN & PROFILE
STA. 343+00 TO 355+00

SHEET 8
WS-8
OF 11 SHEETS

JOB NO. 620.314

307-1650

307-V650

307-1650