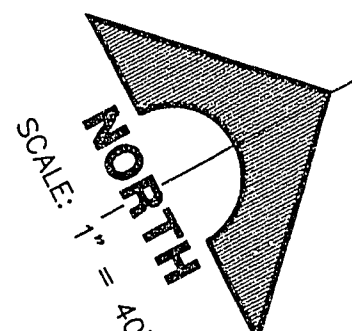



RECORD DRAWINGS

THESE PLANS SHOW RECORD INFORMATION RECEIVED FROM:

CONTRACTOR: ALLIED UNDERGROUND INC.

DATE: 6/20/90

DOUBLE SOLID YELLOW STRIPES (4") PER DETAIL
1, SHEET T-1 NOTE: ALL STRIPING IS TEMPORARY.
1" PAVEMENT OVERLAY TO BE ADDED TO ROAD SECTIONS
APPROXIMATELY ONE YEAR FROM COMPLETION. PERMANENT
STRIPING TO BE INSTALLED PER S.I.S. DETAIL S-90
AND S-91 AFTER OVERLAY.

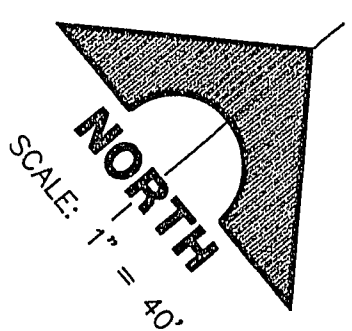

RECOMMENDED
WARRANT
Christopher W. Anderson
CHRISTOPHER W. ANDERSON
CIVIL
5071
R.P.E. NO. 9-41-89
DATE 9-41-89

555 SOUTH RAINBOW BLVD / LAS VEGAS, NEVADA 89102

G.C. WALLACE, INC.
Engineering/Architecture

HOWARD HUGHES PROPERTIES
VILLAGE 1 NORTH RAMPART BLVD.
STREET LIGHTS, STRIPING, & SIGNS
STA 184+19.92 TO 164+39.92

SHEET
T-1
OF 4 SHEETS