


CURVE DATA ○ INDICATES CURVE NUMBER

CURVE	RADIUS	LENGTH	TANGENT	DELTA	DESCRIPTION
1	300.00'	424.64'	256.68'	81°06'04"	CENTER LINE
2	200.00'	115.75'	59.55'	33°09'38"	CENTER LINE
3	200.00'	82.82'	42.01'	23°43'39"	CENTER LINE
4	310.00'	43.12'	21.60'	07°58'13"	CENTER LINE
5	320.50'	251.28'	132.50'	44°55'17"	SEWER LINE
7	279.50'	55.45'	27.81'	11°21'59"	WATER LINE
8	194.83'	184.23'	99.53'	54°10'44"	WATER LINE
9	150.00'	127.54'	67.91'	48°42'58"	WATER LINE
10	220.50'	91.31'	46.32'	23°43'39"	WATER LINE
11	322.00'	73.33'	36.82'	13°02'53"	WATER LINE

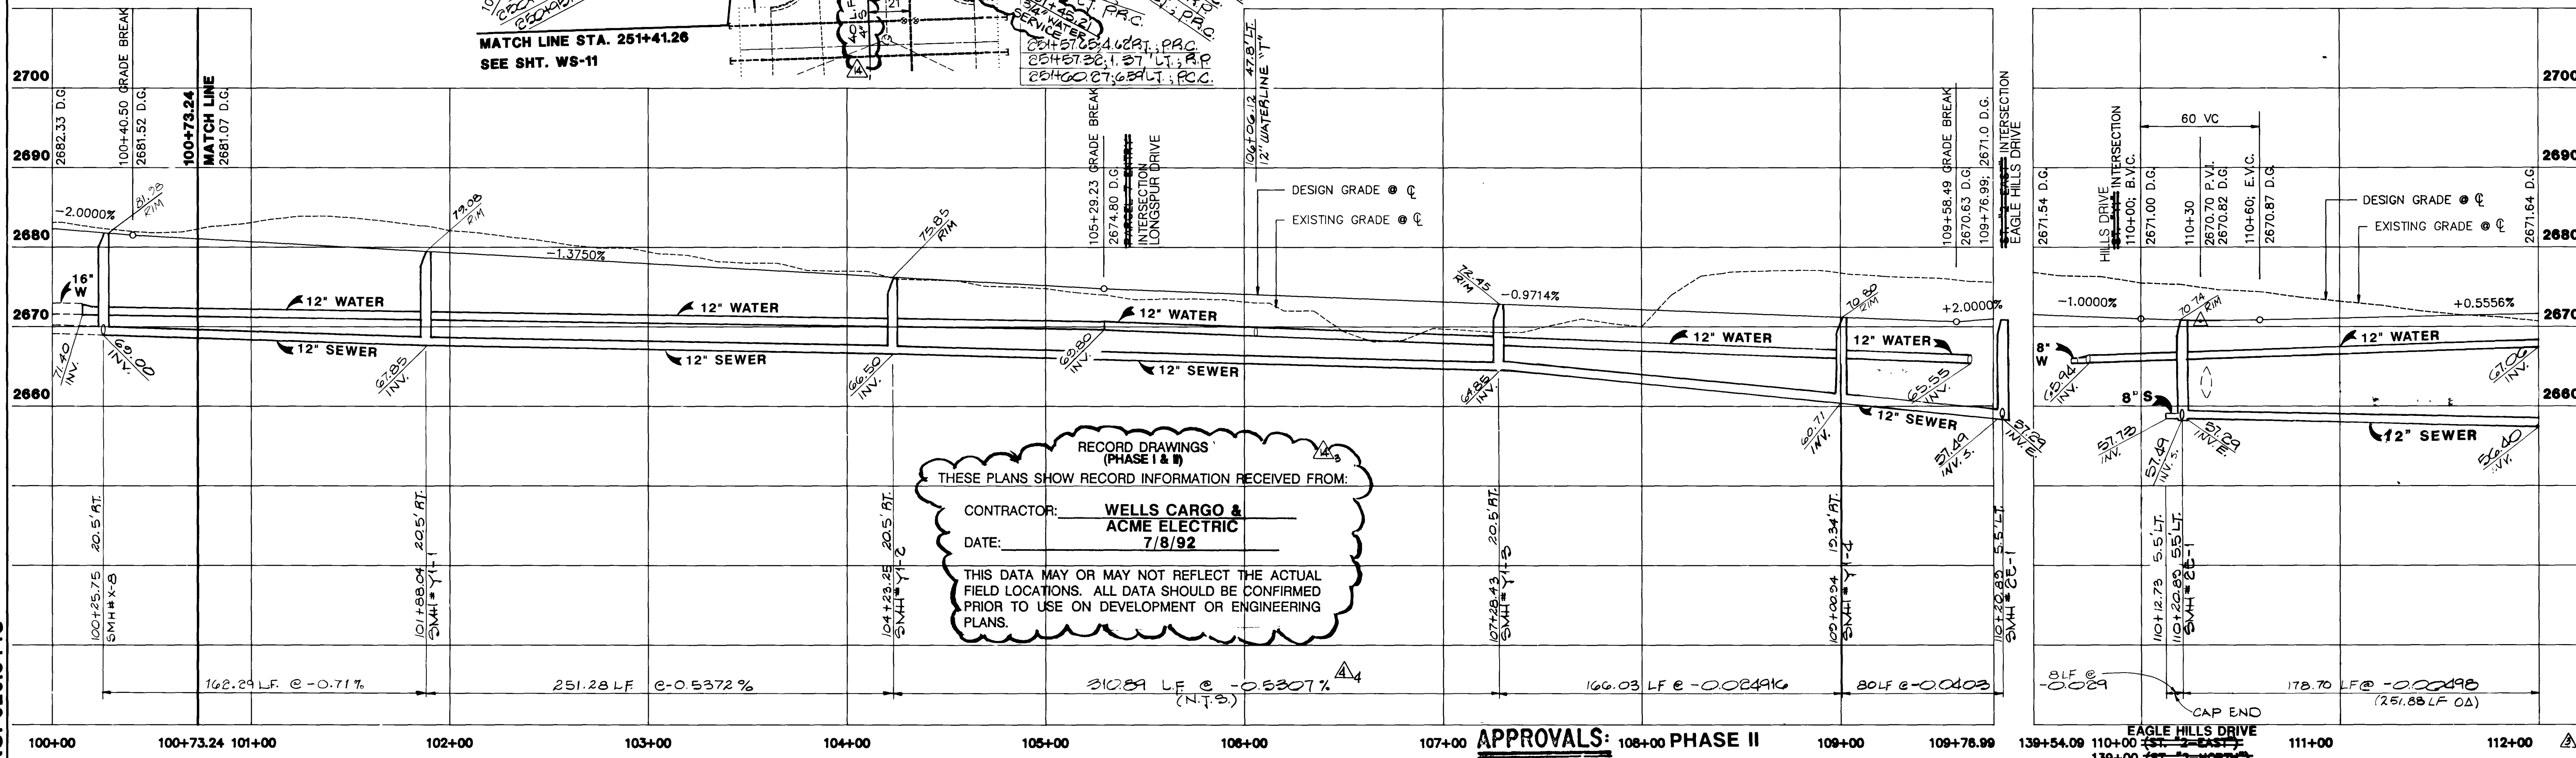

RECORD DRAWINGS (PHASE I & II)
 THESE PLANS SHOW RECORD INFORMATION RECEIVED FROM:
 CONTRACTOR: **WELLS CARGO & ACME ELECTRIC**
 DATE: **7/8/92**
 THIS DATA MAY OR MAY NOT REFLECT THE ACTUAL FIELD LOCATIONS. ALL DATA SHOULD BE CONFIRMED PRIOR TO USE ON DEVELOPMENT OR ENGINEERING PLANS.

APPROVALS: PHASE II
 7-08-91
 LAS VEGAS VALLEY WATER DISTRICT

REVISIONS

NO.	DATE	DESCRIPTION
1	7/8/92	ISSUED FOR PERMITS
2	7/15/92	REVISED PER COMMENTS
3	7/22/92	REVISED PER COMMENTS
4	7/29/92	REVISED PER COMMENTS
5	8/5/92	REVISED PER COMMENTS
6	8/12/92	REVISED PER COMMENTS
7	8/19/92	REVISED PER COMMENTS
8	8/26/92	REVISED PER COMMENTS
9	9/2/92	REVISED PER COMMENTS
10	9/9/92	REVISED PER COMMENTS
11	9/16/92	REVISED PER COMMENTS
12	9/23/92	REVISED PER COMMENTS
13	9/30/92	REVISED PER COMMENTS
14	10/7/92	REVISED PER COMMENTS
15	10/14/92	REVISED PER COMMENTS
16	10/21/92	REVISED PER COMMENTS
17	10/28/92	REVISED PER COMMENTS
18	11/4/92	REVISED PER COMMENTS
19	11/11/92	REVISED PER COMMENTS
20	11/18/92	REVISED PER COMMENTS
21	11/25/92	REVISED PER COMMENTS
22	12/2/92	REVISED PER COMMENTS
23	12/9/92	REVISED PER COMMENTS
24	12/16/92	REVISED PER COMMENTS
25	12/23/92	REVISED PER COMMENTS
26	12/30/92	REVISED PER COMMENTS
27	1/6/93	REVISED PER COMMENTS
28	1/13/93	REVISED PER COMMENTS
29	1/20/93	REVISED PER COMMENTS
30	1/27/93	REVISED PER COMMENTS
31	2/3/93	REVISED PER COMMENTS
32	2/10/93	REVISED PER COMMENTS
33	2/17/93	REVISED PER COMMENTS
34	2/24/93	REVISED PER COMMENTS
35	3/2/93	REVISED PER COMMENTS
36	3/9/93	REVISED PER COMMENTS
37	3/16/93	REVISED PER COMMENTS
38	3/23/93	REVISED PER COMMENTS
39	3/30/93	REVISED PER COMMENTS
40	4/6/93	REVISED PER COMMENTS
41	4/13/93	REVISED PER COMMENTS
42	4/20/93	REVISED PER COMMENTS
43	4/27/93	REVISED PER COMMENTS
44	5/4/93	REVISED PER COMMENTS
45	5/11/93	REVISED PER COMMENTS
46	5/18/93	REVISED PER COMMENTS
47	5/25/93	REVISED PER COMMENTS
48	6/1/93	REVISED PER COMMENTS
49	6/8/93	REVISED PER COMMENTS
276	10/14/97	REVISED PER COMMENTS
277	10/21/97	REVISED PER COMMENTS
278	10/28/97	REVISED PER COMMENTS
279	11/4/97	REVISED PER COMMENTS
280	11/11/97	REVISED PER COMMENTS
281	11/18/97	REVISED PER COMMENTS
282	11/25/	

