
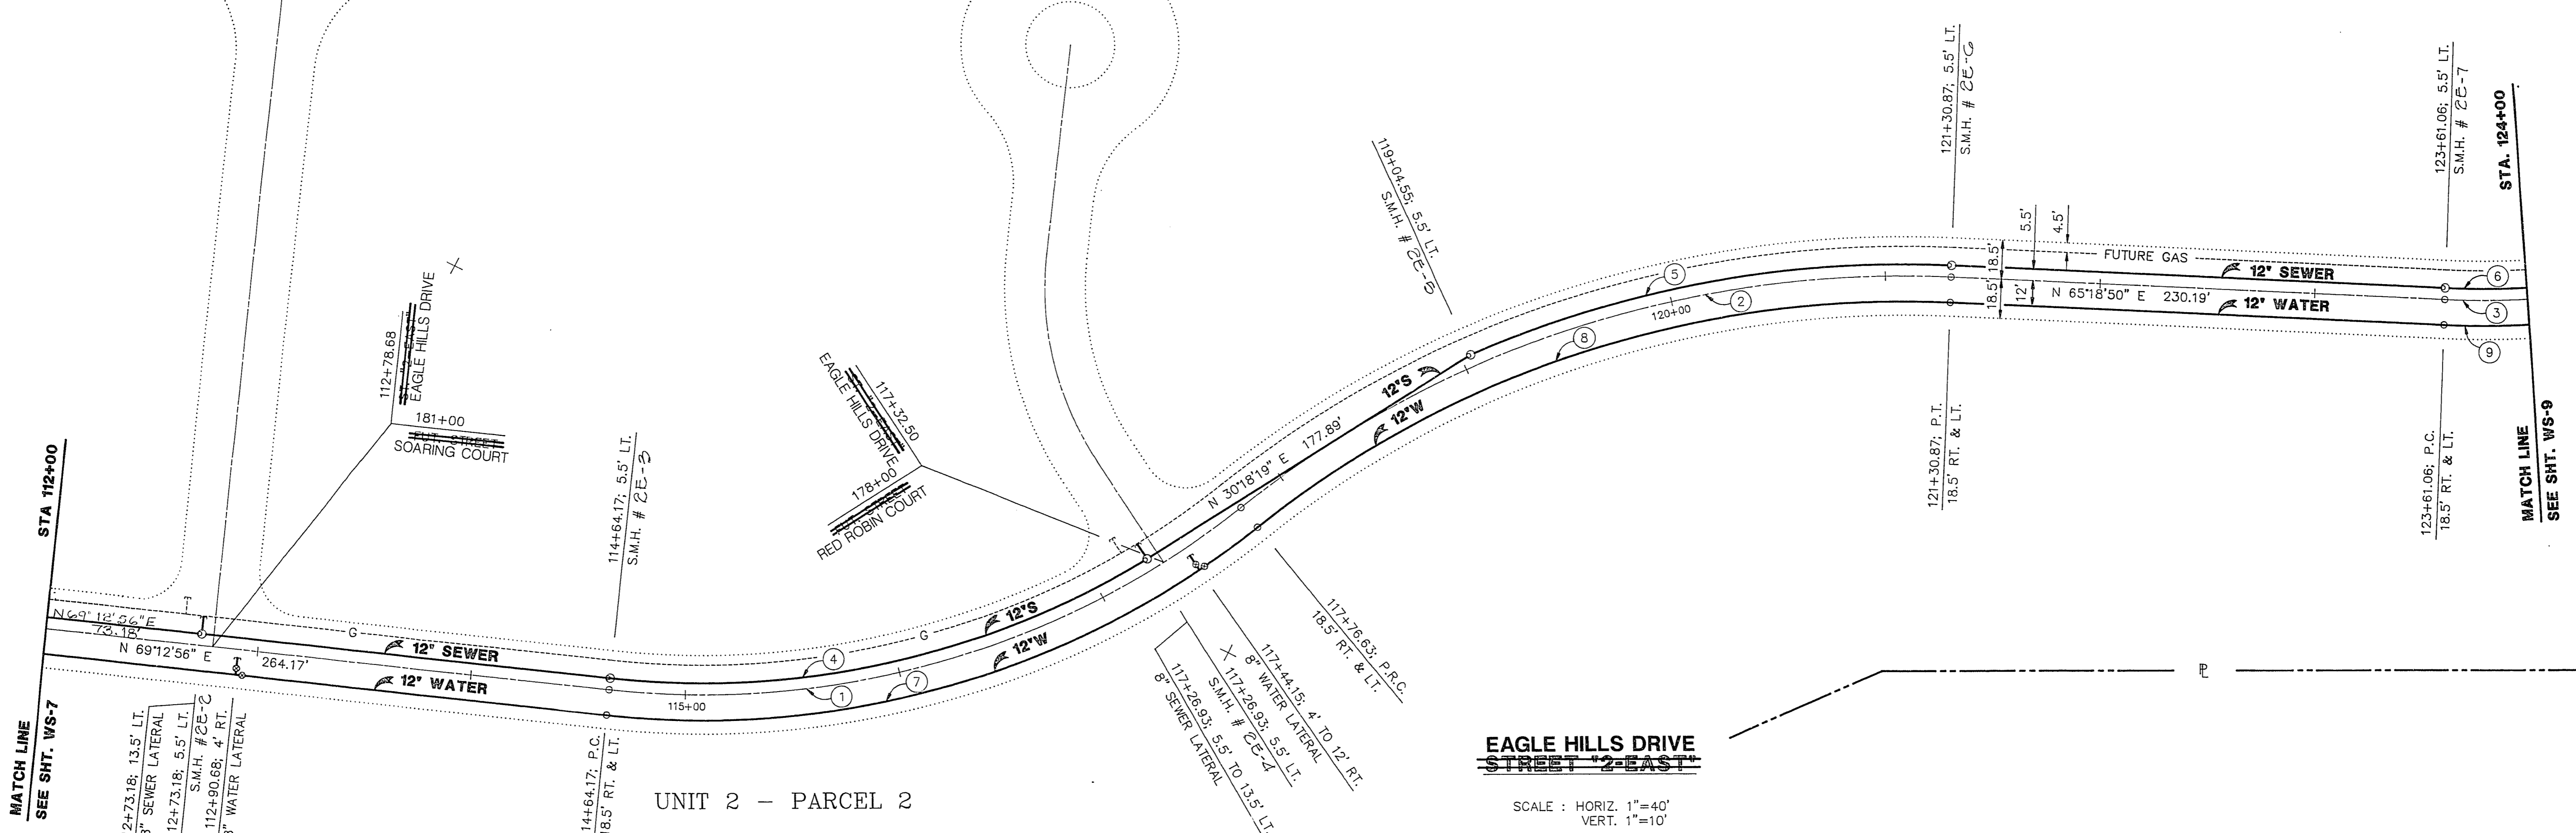


UNIT 2 - PARCEL 1

CURVE DATA INDICATES CURVE NUMBER

CURVE	RADIUS	LENGTH	TANGENT	DELTA	DESCRIPTION
1	395.00'	312.46'	164.92'	45°19'24"	CENTER LINE
2	490.00'	354.24'	185.26'	41°25'18"	CENTER LINE
3	385.00'	38.94'	19.48'	05°47'44"	CENTER LINE
4	389.50'	299.10'	134.55'	38°06'50"	SEWER LINE
5	495.50'	228.86'	116.51'	26°27'50"	SEWER LINE
6	379.50'	38.39'	19.21'	05°47'44"	SEWER LINE
7	407.00'	321.95'	169.93'	45°19'24"	WATER LINE
8	478.00'	345.57'	180.72'	41°25'18"	WATER LINE
9	397.00'	40.16'	20.10'	05°47'44"	WATER LINE

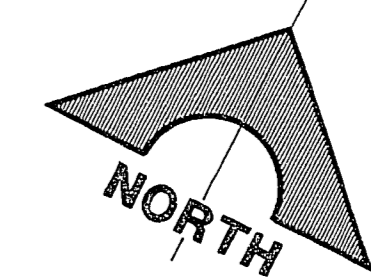


EAGLE HILLS DRIVE STREET 2-EAST

SCALE: HORIZ. 1"=40'
VERT. 1"=10'

UNIT 2 - PARCEL 2

RECORD DRAWINGS (PHASE I & II)
THESE PLANS SHOW RECORD INFORMATION RECEIVED FROM:
CONTRACTOR: **WELLS CARGO & ACME ELECTRIC**
DATE: **7/8/92**
THIS DATA MAY OR MAY NOT REFLECT THE ACTUAL FIELD LOCATIONS. ALL DATA SHOULD BE CONFIRMED PRIOR TO USE ON DEVELOPMENT OR ENGINEERING PLANS.

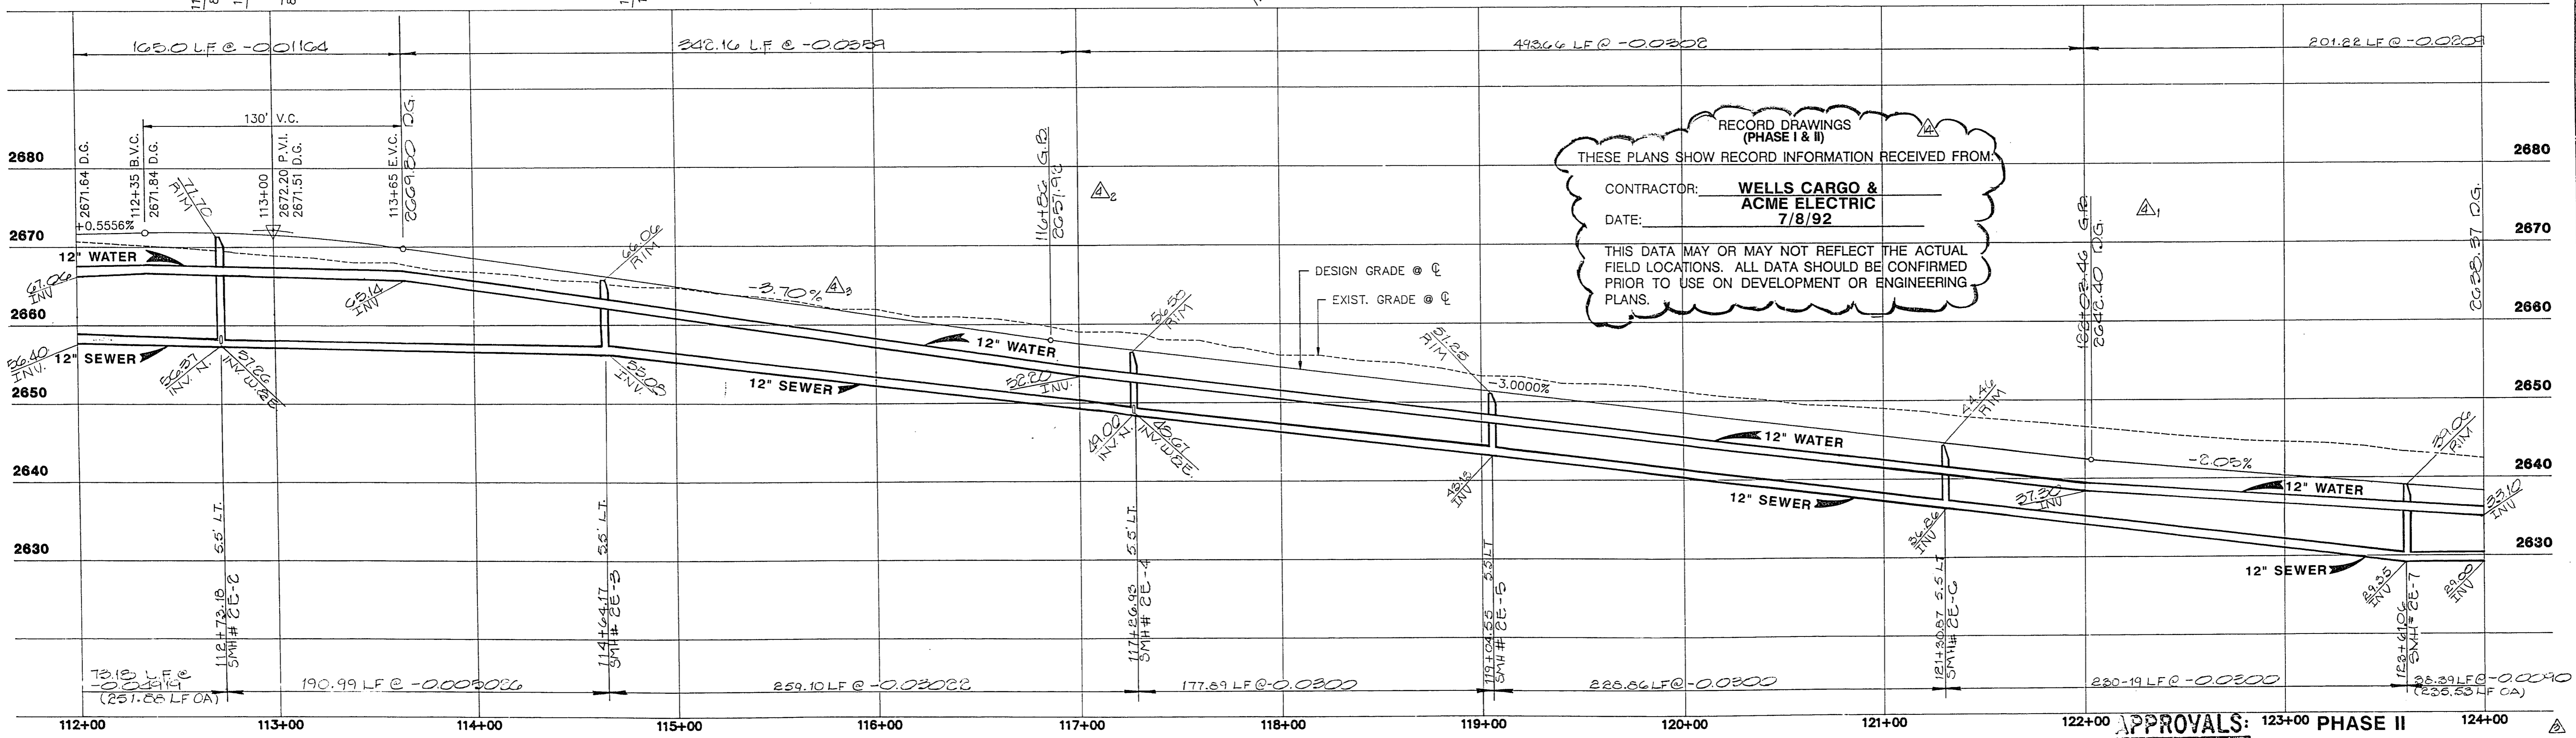

APPROVALS: 123+00 PHASE II

[Signature] 2-8-97
LAS VEGAS VALLEY WATER DISTRICT DATE

NO.	DATE	DESCRIPTION
1	7/8/92	RECORD DRAWINGS
2	7/15/91	REVISIONS/DIVID COMMENTS
3	6/10/91	REVISION / C.L.Y. COMMENTS
4	4/11/91	REVISED
5	4/11/91	REVISED

RECOMMENDED:
[Signature]
CHRISTOPHER W. ANDERSON
R.P.E. NO. 6541
DATE: 6-5-91

G. C. WALLACE, INC.
Engineering/Architecture
1855 SOUTH RAINBOW BLVD./LAS VEGAS, NEVADA 89102

HOWARD HUGHES PROPERTIES
SUMMERLIN - VILLAGE 1 SOUTH PHASE II
EAGLE HILLS DRIVE
PLAN & PROFILE
STA. 112+00 TO 124+00

SHEET
WS-8
SHT 28 OF 44

JOB NO. 620.3145

23-3-47 107-V1815