
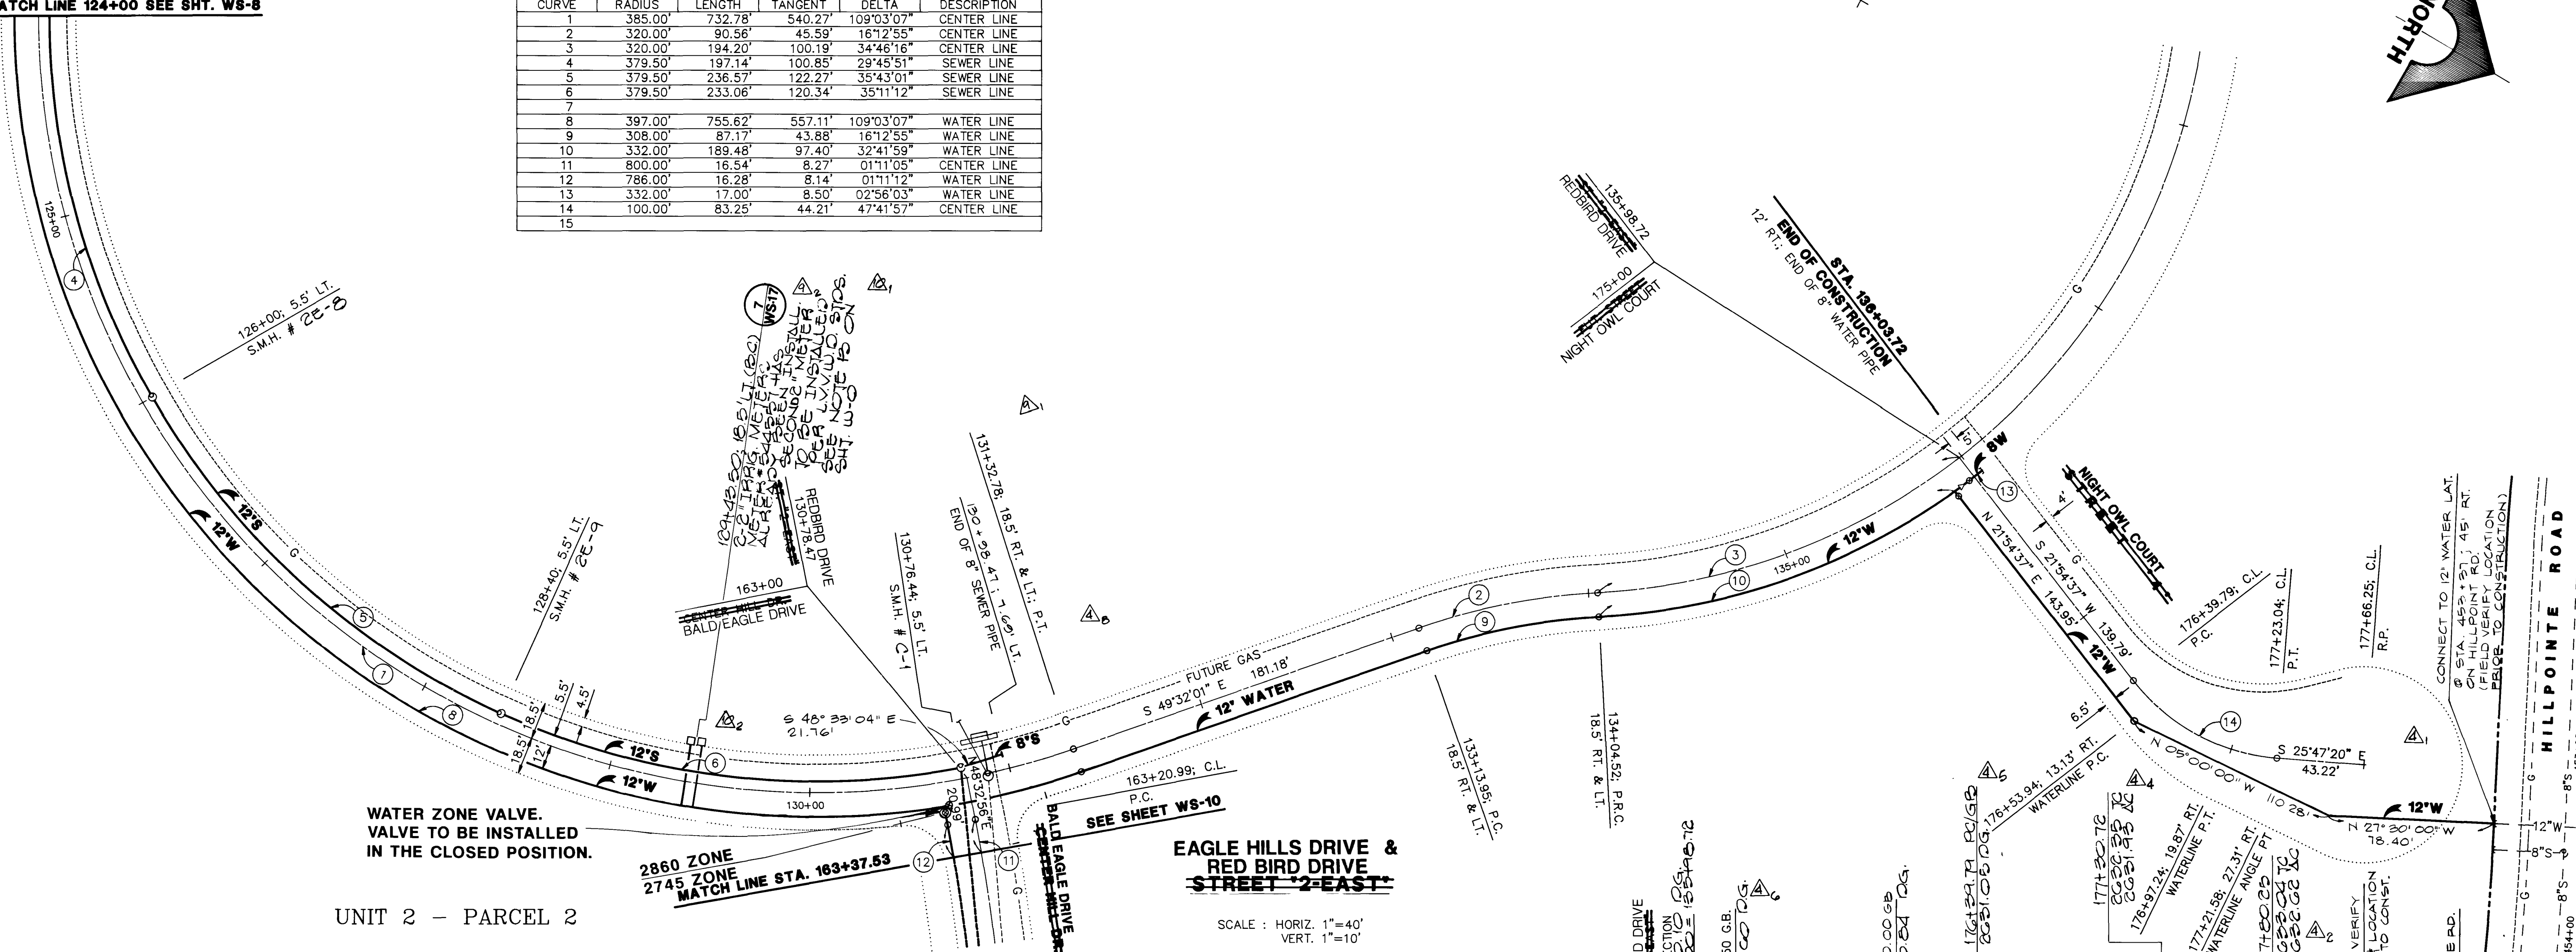


MATCH LINE 124+00 SEE SHT. WS-8

**CURVE DATA** ○ INDICATES CURVE NUMBER

CURVE	RADIUS	LENGTH	TANGENT	DELTA	DESCRIPTION
1	385.00'	732.78'	540.27'	109°03'07"	CENTER LINE
2	320.00'	90.56'	45.59'	16°12'55"	CENTER LINE
3	320.00'	194.20'	100.19'	34°48'16"	CENTER LINE
4	379.50'	197.14'	100.85'	29°43'51"	SEWER LINE
5	379.50'	236.57'	122.27'	35°43'01"	SEWER LINE
6	379.50'	233.06'	120.34'	35°11'12"	SEWER LINE
7					
8	397.00'	755.62'	557.11'	109°03'07"	WATER LINE
9	308.00'	87.17'	43.88'	16°12'55"	WATER LINE
10	332.00'	189.48'	97.40'	32°41'59"	WATER LINE
11	800.00'	16.54'	8.27'	01°11'05"	CENTER LINE
12	786.00'	16.28'	8.14'	01°11'12"	WATER LINE
13	332.00'	17.00'	8.50'	02°56'03"	WATER LINE
14	100.00'	83.25'	44.21'	47°41'57"	CENTER LINE
15					

UNIT 2 - PARCEL 1

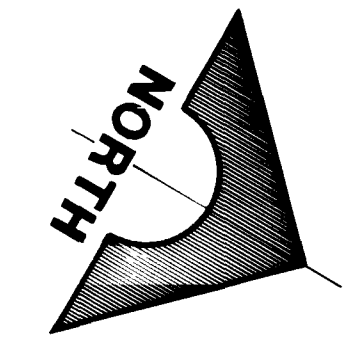


WATER ZONE VALVE.  
VALVE TO BE INSTALLED  
IN THE CLOSED POSITION.

2860 ZONE  
2745 ZONE  
MATCH LINE STA. 163+37.53

EAGLE HILLS DRIVE &  
RED BIRD DRIVE  
STREET-2-EAST

SCALE: HORIZ. 1"=40'  
VERT. 1"=10'

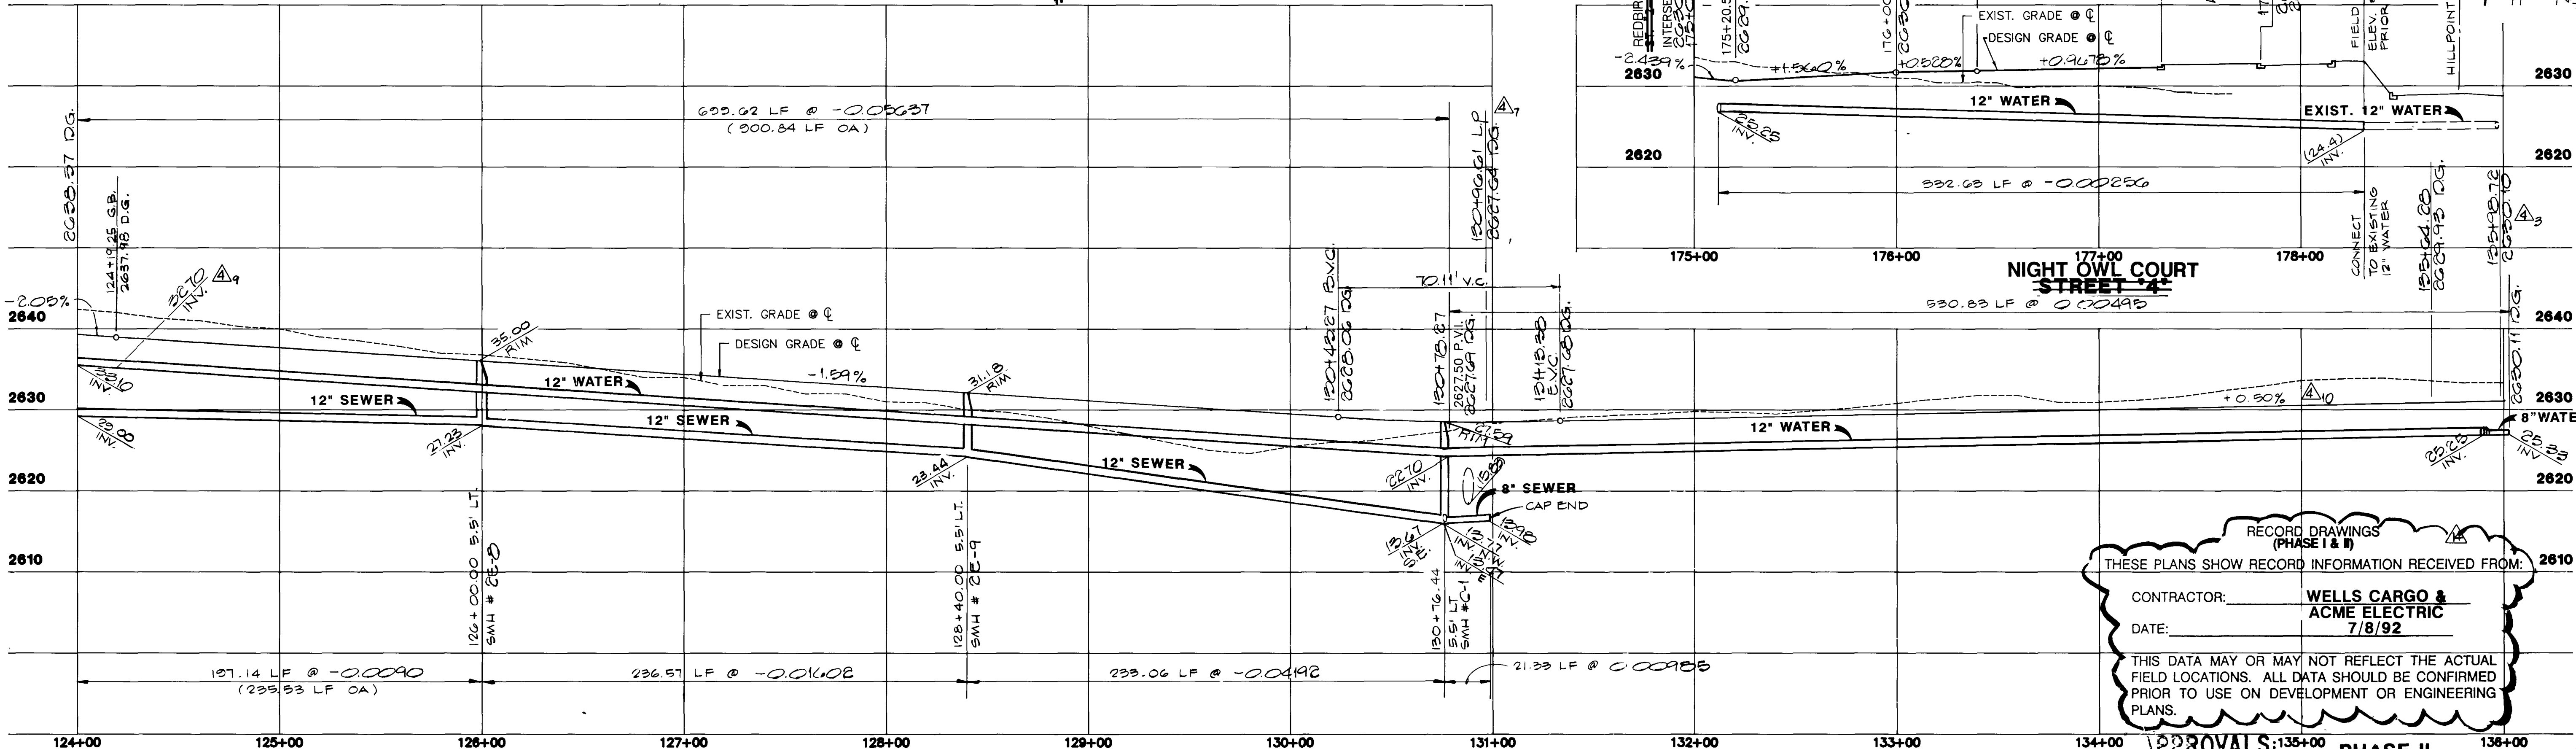

RECORD DRAWINGS  
(PHASE I & II)  
THESE PLANS SHOW RECORD INFORMATION RECEIVED FROM:  
CONTRACTOR: **WELLS CARGO & ACME ELECTRIC**  
DATE: **7/8/92**  
THIS DATA MAY OR MAY NOT REFLECT THE ACTUAL FIELD LOCATIONS. ALL DATA SHOULD BE CONFIRMED PRIOR TO USE ON DEVELOPMENT OR ENGINEERING PLANS.

APPROVALS: \_\_\_\_\_ PHASE II

LAS VEGAS VALLEY WATER DISTRICT DATE: **2-08-91**

**HOWARD HUGHES PROPERTIES**  
SUMMERLIN - VILLAGE 1 SOUTH PHASE II  
STREET-2-EAST, STA. 124+00 TO END &  
STREET-2-EAST, STREET-2-NIGHT OWL COURT & RED BIRD DRIVE  
PLAN & PROFILE

SHEET **WS-9**  
SHT 29 OF 44

REVISIONS:  
NO. DATE DESCRIPTION  
1 11/11/92 RECORD DRAWINGS  
2 11/11/92 RECORD DRAWINGS  
3 11/11/92 RECORD DRAWINGS  

RECOMMENDED  
G. C. WALLACE, INC.  
Engineering/Architecture  
1555 SOUTH RAINBOW BLVD., LAS VEGAS, NEVADA 89102

JOB NO. 620.3145

1939

23-3-46

107-V1815

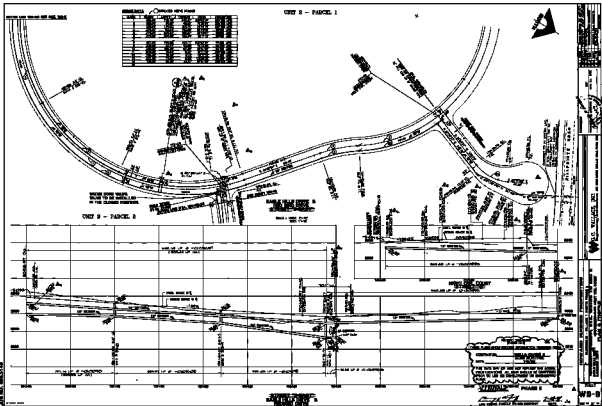

WVR

35-2-01