

PARCEL 14

PARCEL 1

PARCEL 14



PARCEL 15

PARCEL 11

PARCEL 9

VILLAGE CENTER DRIVE  
STREET 'X'  
VILLAGE CENTER CIRCLE  
SCALE: 1" = 40'

VILLAGE CENTER DRIVE  
STREET 'X'  
VILLAGE CENTER CIRCLE  
SCALE: 1" = 40'

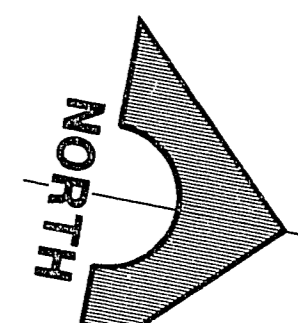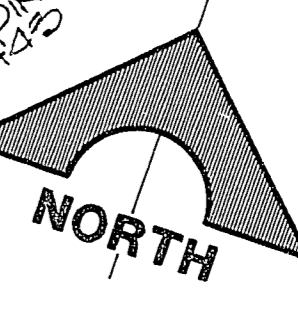

RECORD DRAWINGS  
(PHASE I & II)

THESE PLANS SHOW RECORD INFORMATION RECEIVED FROM:  
CONTRACTOR: **WELLS CARGO & ACME ELECTRIC**  
DATE: **7/8/92**

THIS DATA MAY OR MAY NOT REFLECT THE ACTUAL FIELD LOCATIONS. ALL DATA SHOULD BE CONFIRMED PRIOR TO USE ON DEVELOPMENT OR ENGINEERING PLANS.

REV.	DATE	DESCRIPTION
1	11/21/91	REVISION / C.L.V. COMMENTS
2	11/21/91	REVISION / C.L.V. COMMENTS
3	11/21/91	REVISION / C.L.V. COMMENTS
4	11/21/91	REVISION / C.L.V. COMMENTS
5	11/21/91	REVISION / C.L.V. COMMENTS
6	11/21/91	REVISION / C.L.V. COMMENTS
7	11/21/91	REVISION / C.L.V. COMMENTS
8	11/21/91	REVISION / C.L.V. COMMENTS
9	11/21/91	REVISION / C.L.V. COMMENTS
10	11/21/91	REVISION / C.L.V. COMMENTS

RECOMMENDED BY: *John P. Glendon*  
DATE: 5/1/91

G. C. WALLACE, INC.  
Engineering/Architecture  
1555 SOUTH RAINBOW BLVD/LAS VEGAS, NEVADA 89102

HOWARD HUGHES PROPERTIES  
SUMMERLIN - VILLAGE 1 SOUTH  
STREET 'X' VILLAGE CENTER CIRCLE  
STREET LIGHTS, STRIPING & SIGNS  
STA. 1490 TO STA. 25+00

SHEET  
**T-3**  
SHT 41 OF 44

23.3-60 107-V1815