
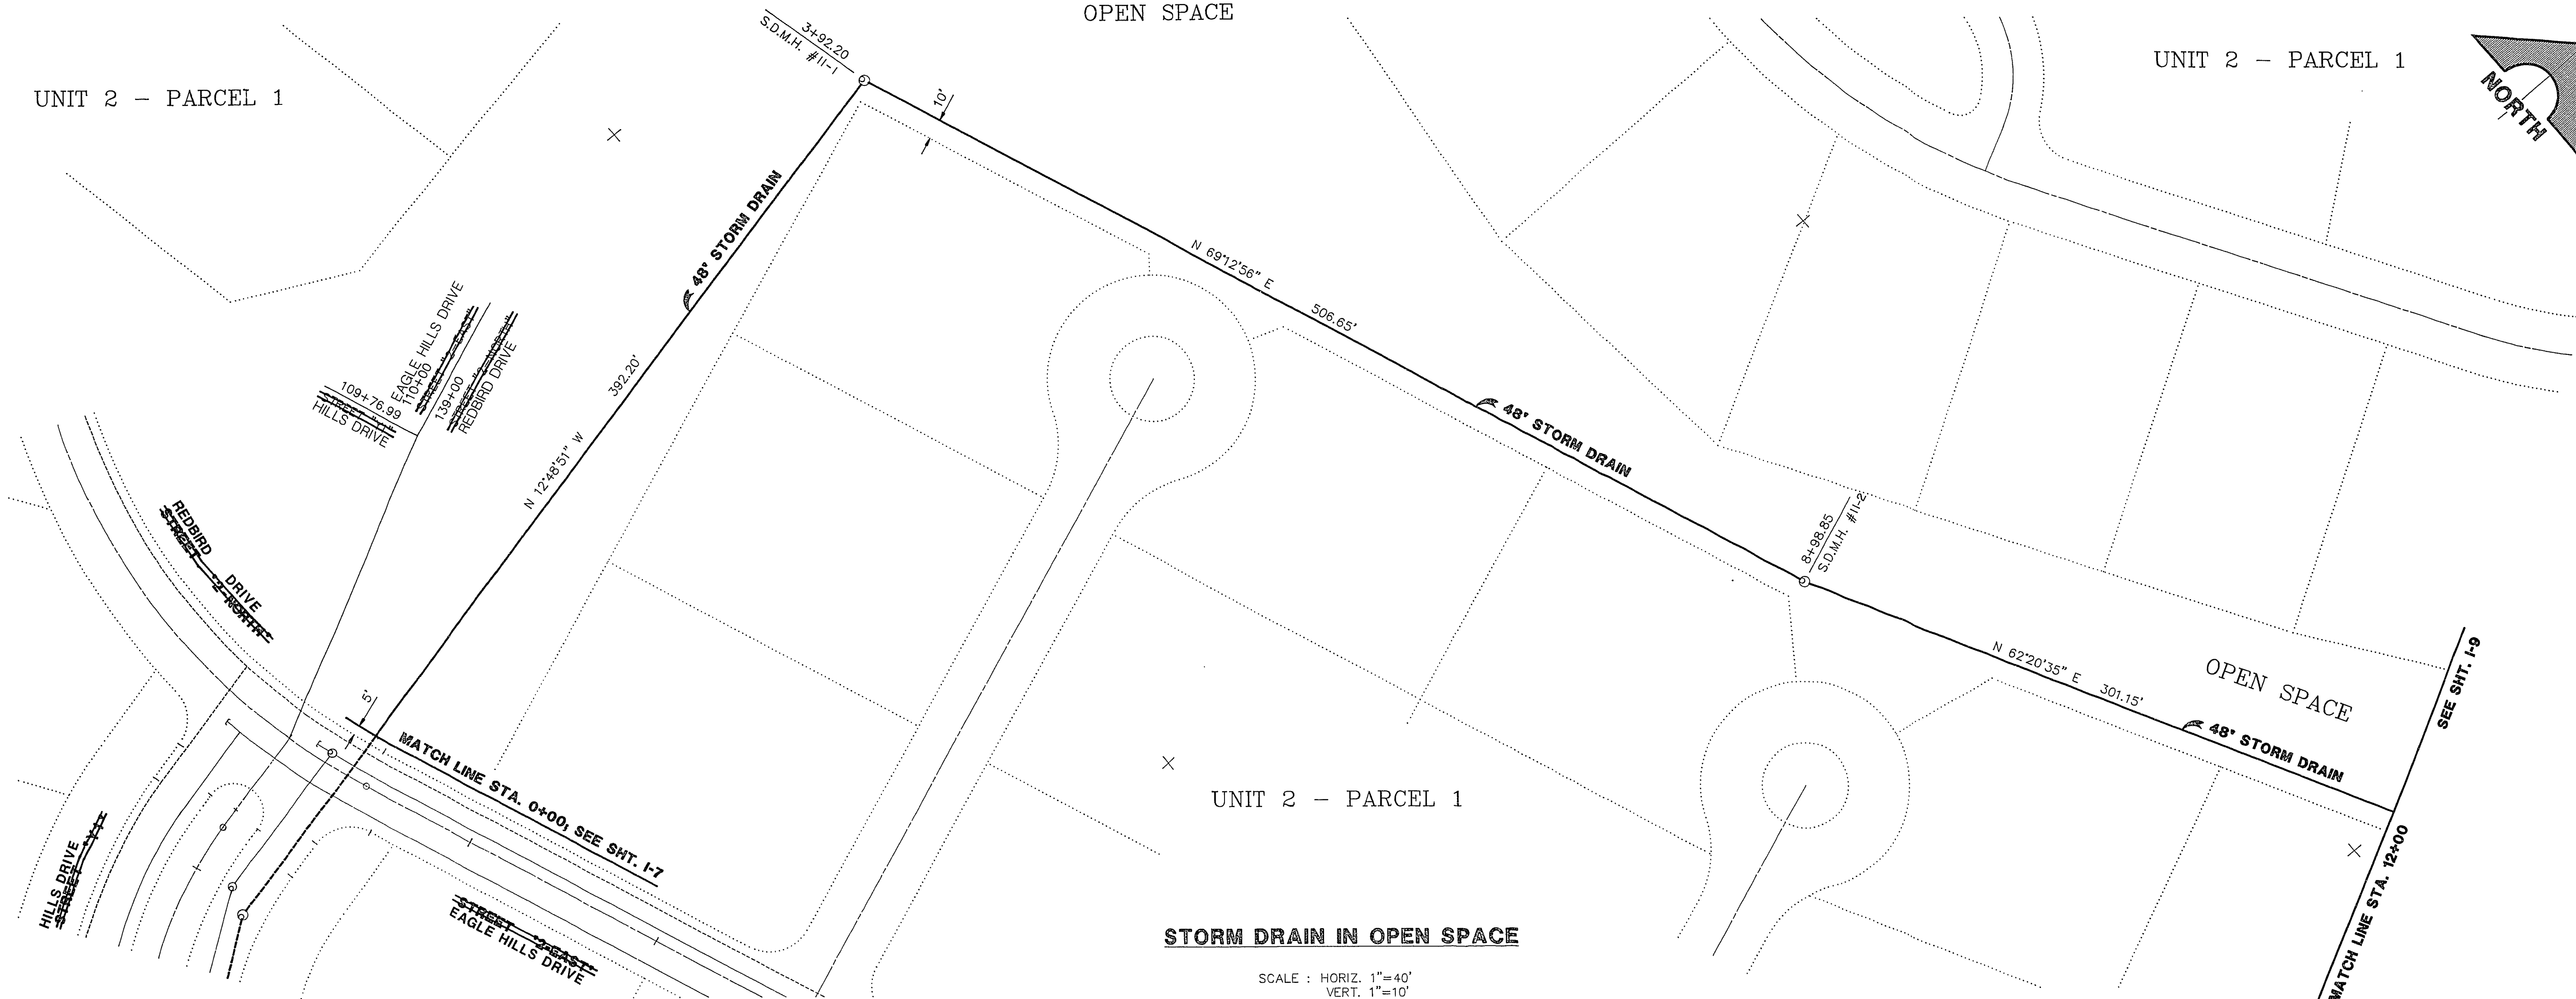



UNIT 2 - PARCEL 1

UNIT 2 - PARCEL 1

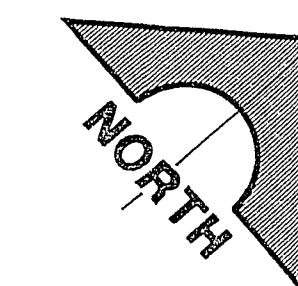

STORM DRAIN IN OPEN SPACE

SCALE : HORIZ. 1"=40'  
VERT. 1"=10'

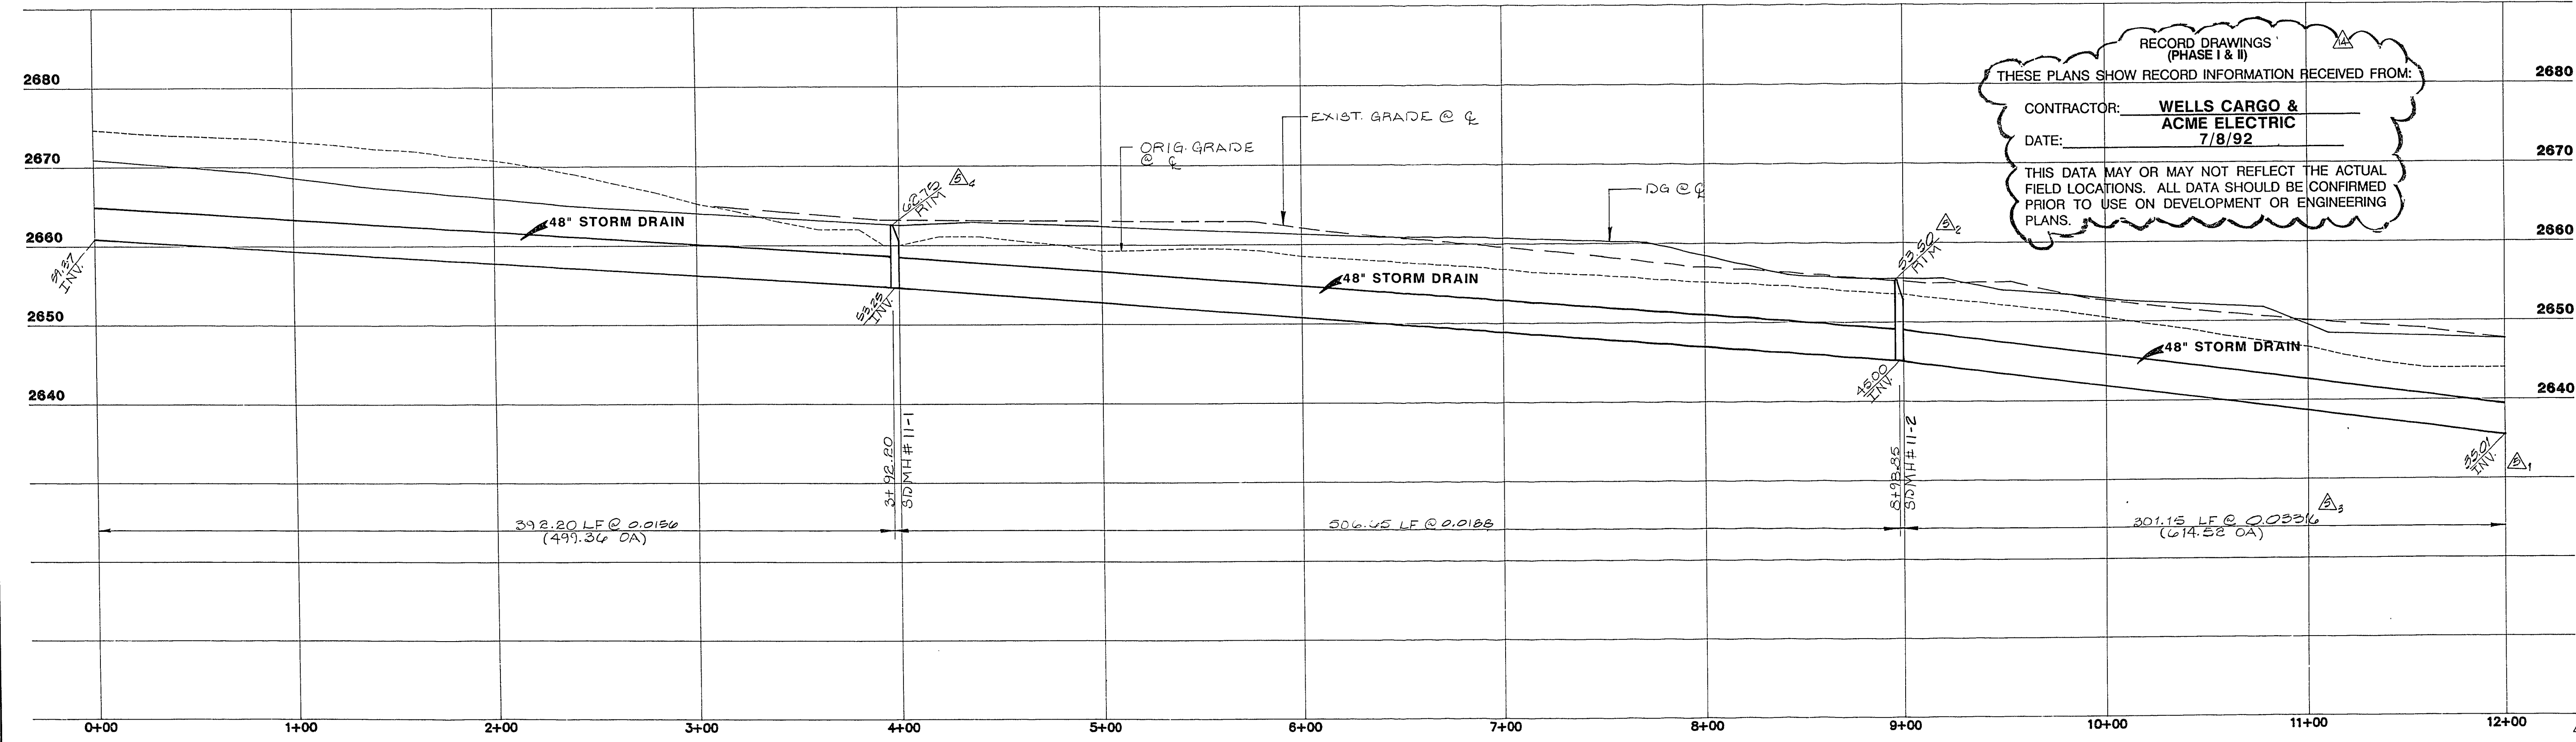

JOB NO. 620.314S

07 15208 02-07-91

REV	DATE	DESCRIPTION
1	7/8/92	RECORD DRAWINGS X/11/24/92
2	8/13/91	REVISIONS
3	6/6/91	REVISION / C.L.V. COMMENTS
4	4/17/91	REVISION

RECOMMENDED  
 CHRISTOPHER W. ANDERSON  
 R.P.E. NO. 5071  
 DATE

G.C. WALLACE, INC.  
 Engineering/Architecture  
 1555 SOUTH RAINBOW BLVD/LAS VEGAS, NEVADA 89102

HOWARD HUGHES PROPERTIES  
 SUMMERLIN - VILLAGE 1 SOUTH  
 STORM DRAIN IN OPEN SPACE  
 PLAN & PROFILE  
 BEGINNING TO STA. 12+00

SHEET  
 11 OF 44

23-3-3) 107-V1815