
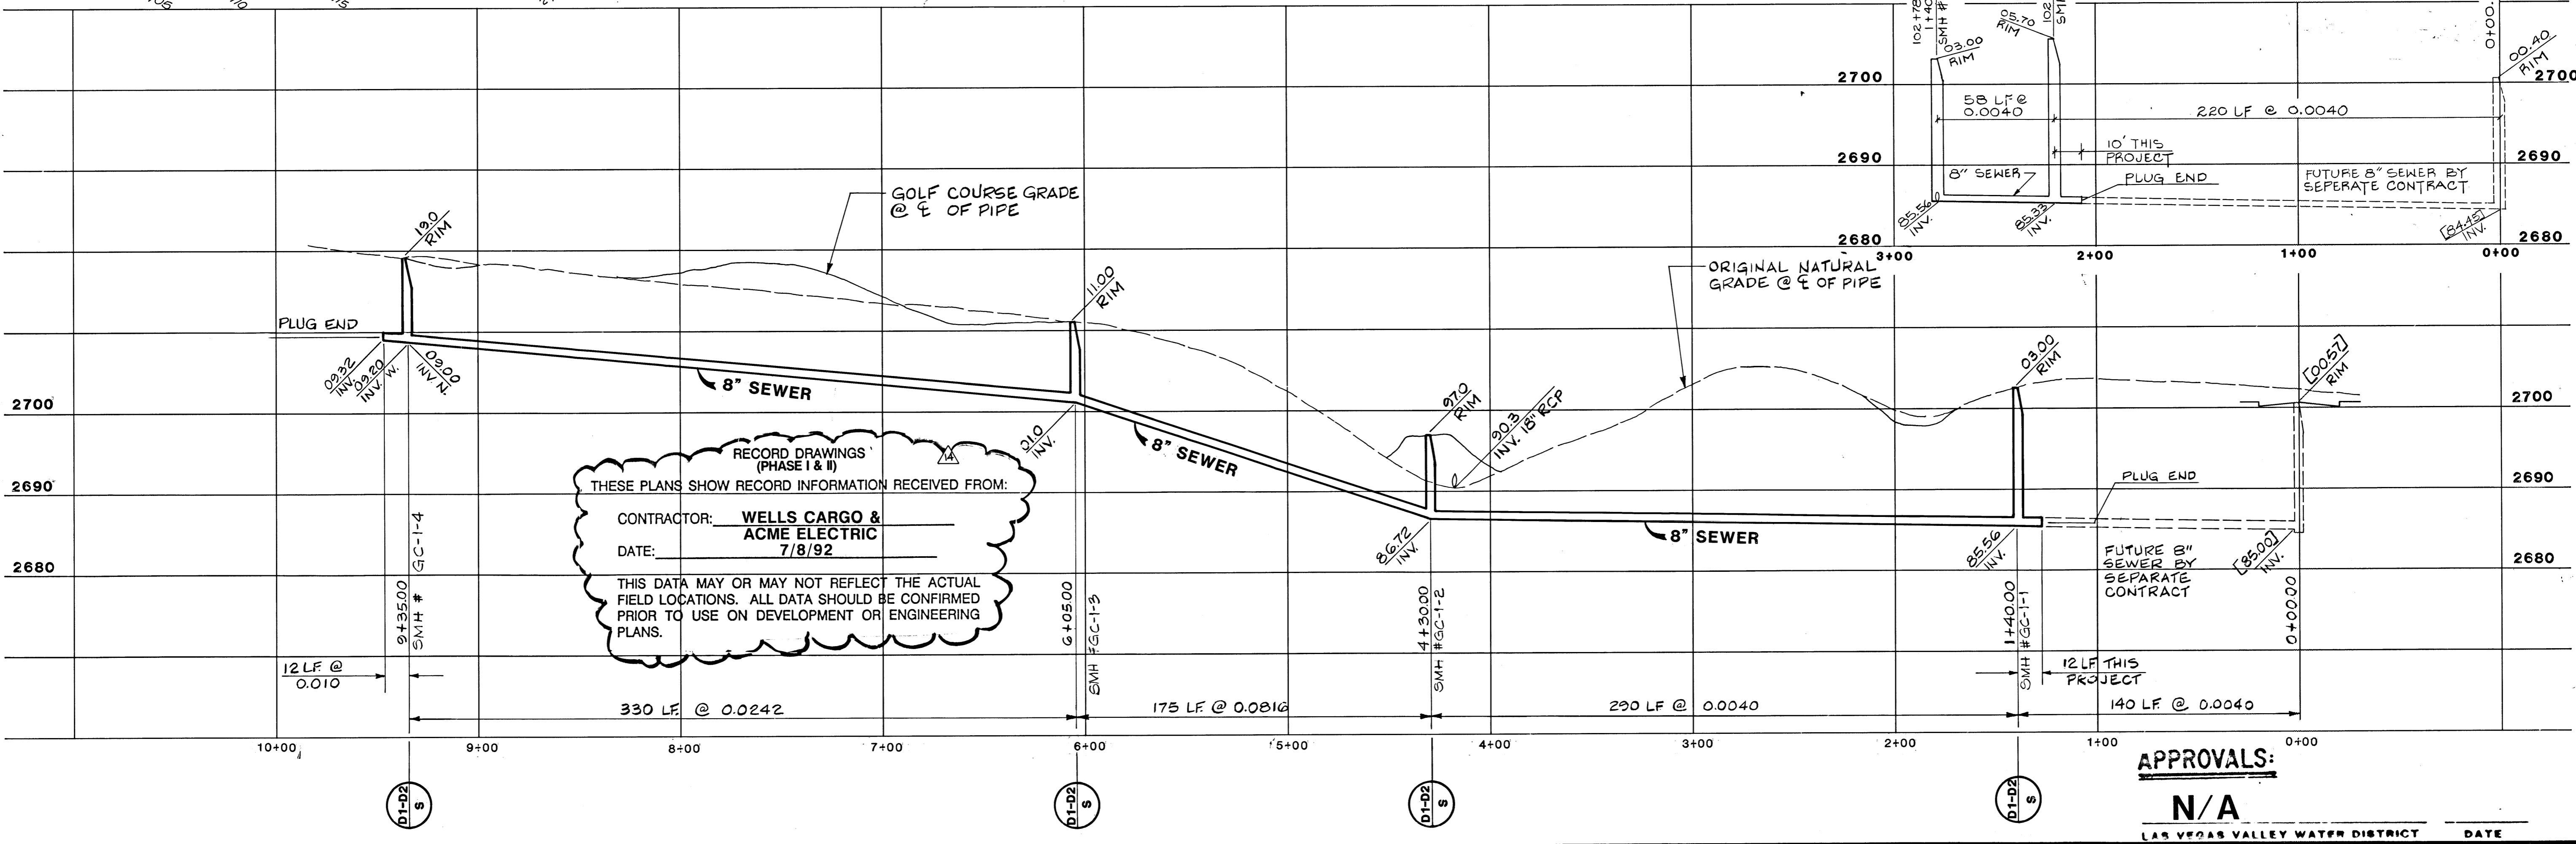
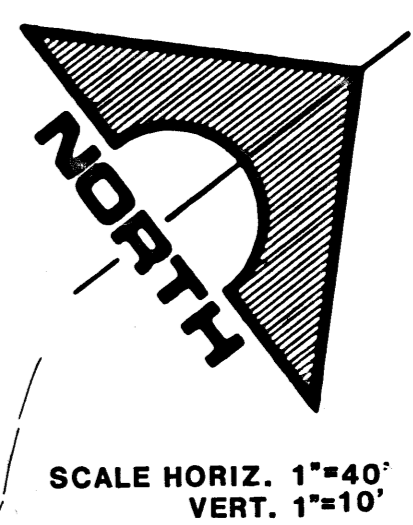


JOB NO. 620.3145

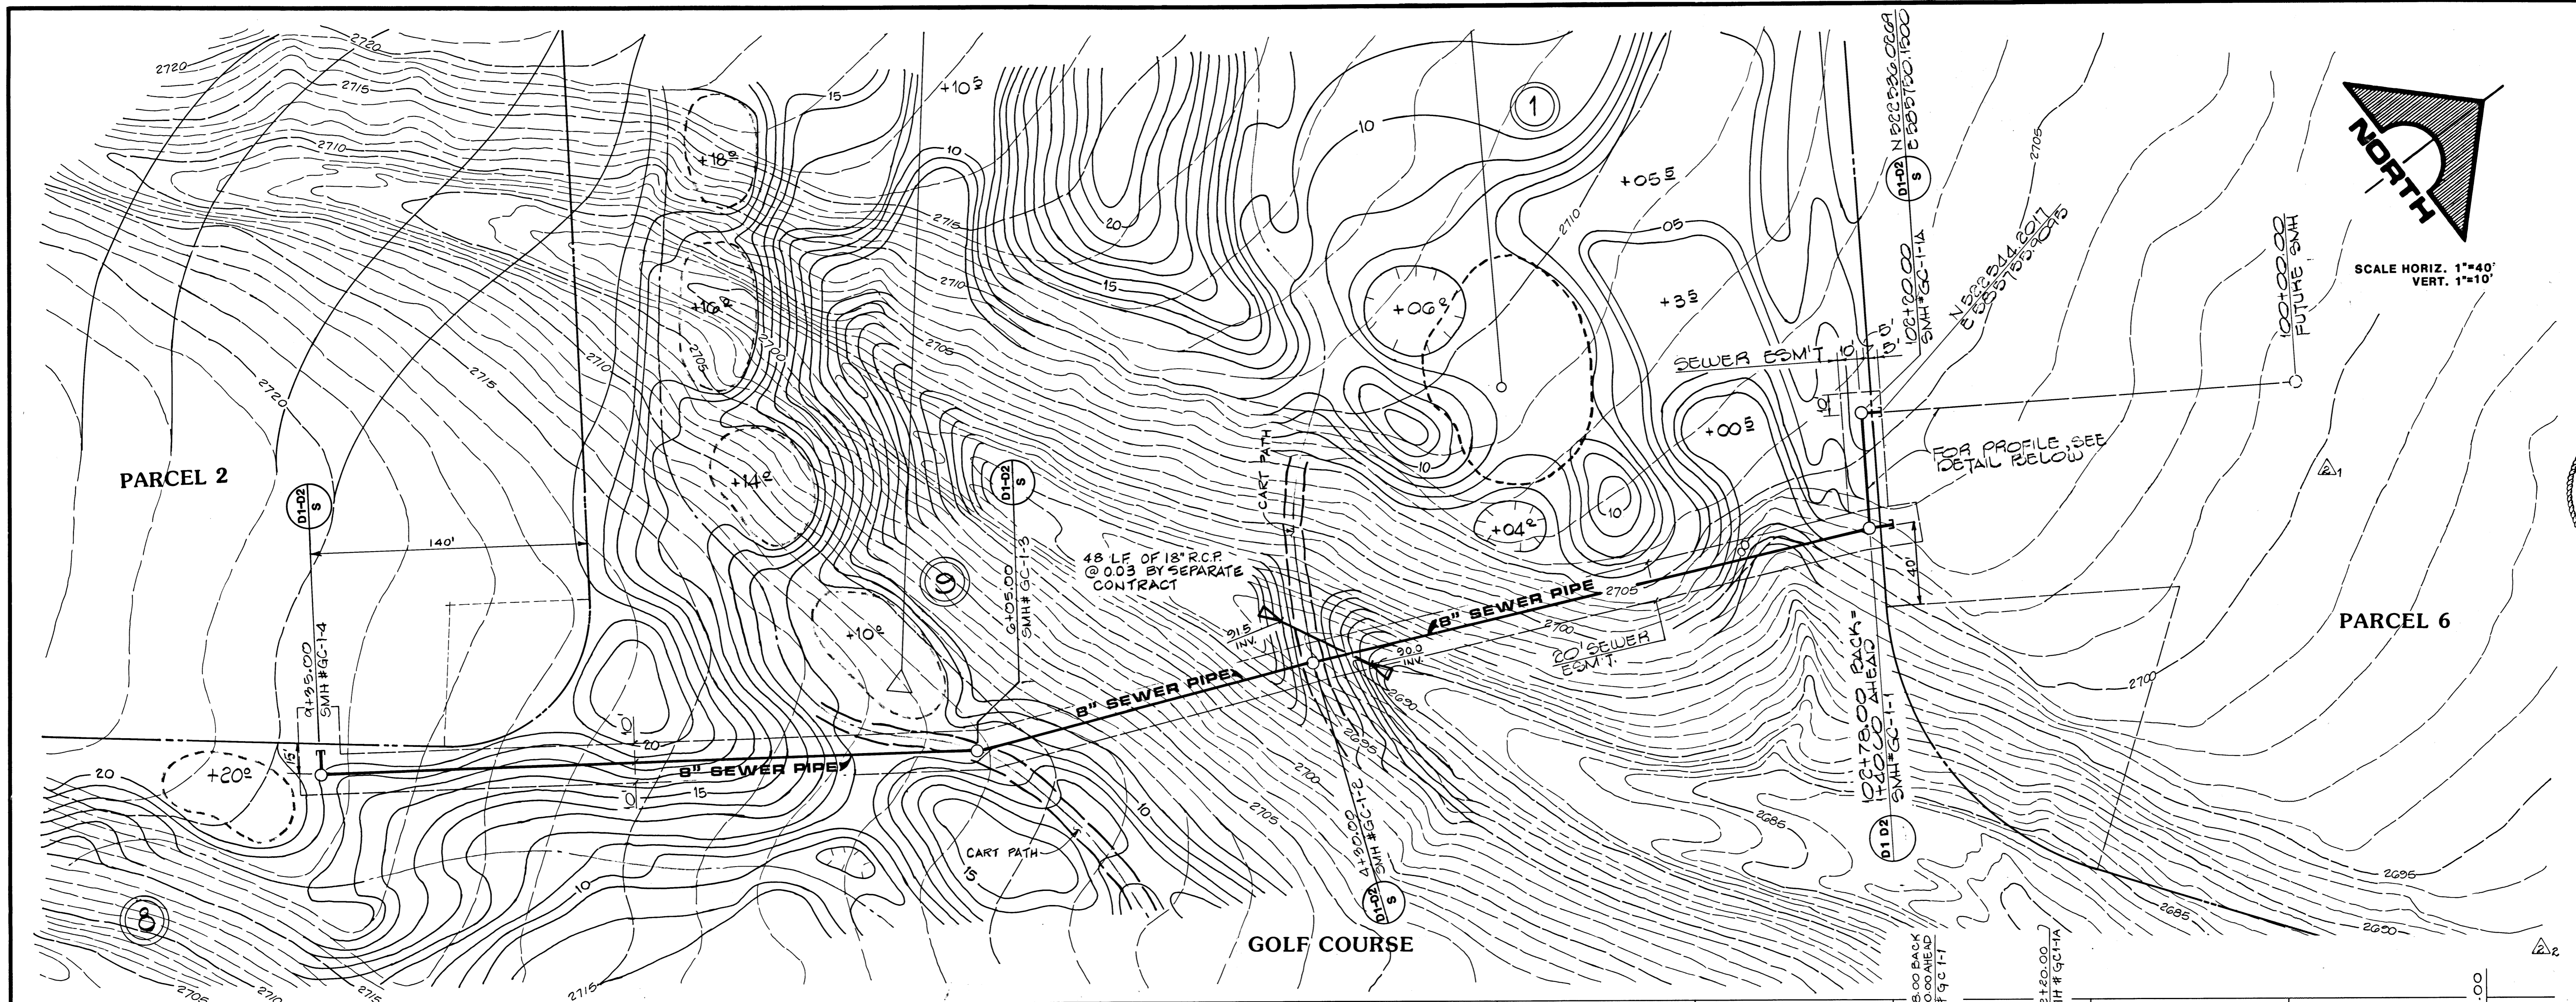

RECORD DRAWINGS (PHASE I & II)
 THESE PLANS SHOW RECORD INFORMATION RECEIVED FROM:
 CONTRACTOR: **WELLS CARGO & ACME ELECTRIC**
 DATE: **7/8/92**
 THIS DATA MAY OR MAY NOT REFLECT THE ACTUAL FIELD LOCATIONS. ALL DATA SHOULD BE CONFIRMED PRIOR TO USE ON DEVELOPMENT OR ENGINEERING PLANS.

APPROVALS:
N/A

REV	DATE	DESCRIPTION
1	7/8/92	RECORD DRAWINGS
2	8/6/91	REVISION / C.L.V. COMMENTS
3	8/26/90	ADD SMH # GC-1-4
4	8/26/90	ADD SMH # GC-1-1A
5	8/26/90	ISSUE TO CONSTRUCT

RECOMMENDED BY:
G.C. WALLACE, INC.
 Engineering/Architecture
 1555 SOUTH RAINBOW BLVD., LAS VEGAS, NEVADA 89102

HOWARD HUGHES PROPERTIES
 SUMMERLIN VILLAGE 1 SOUTH
 SEWER SERVICE
 POD 2 TO POD 6

SHEET
WS-14
 SHT. 34 OF 44

23-3-53 107-VI-815