


SCALE HORIZ. 1" = 40'
VERT. 1" = 10'

① 5' OUTSIDE R
INSTALL 1-12"
GATE VALVE PER
L.V.W.D. STANDARDS

0+00 THIS SHEET
147+00, 41.5' LT.
SMH # R-15
(BY SEPARATE CONTRACT)

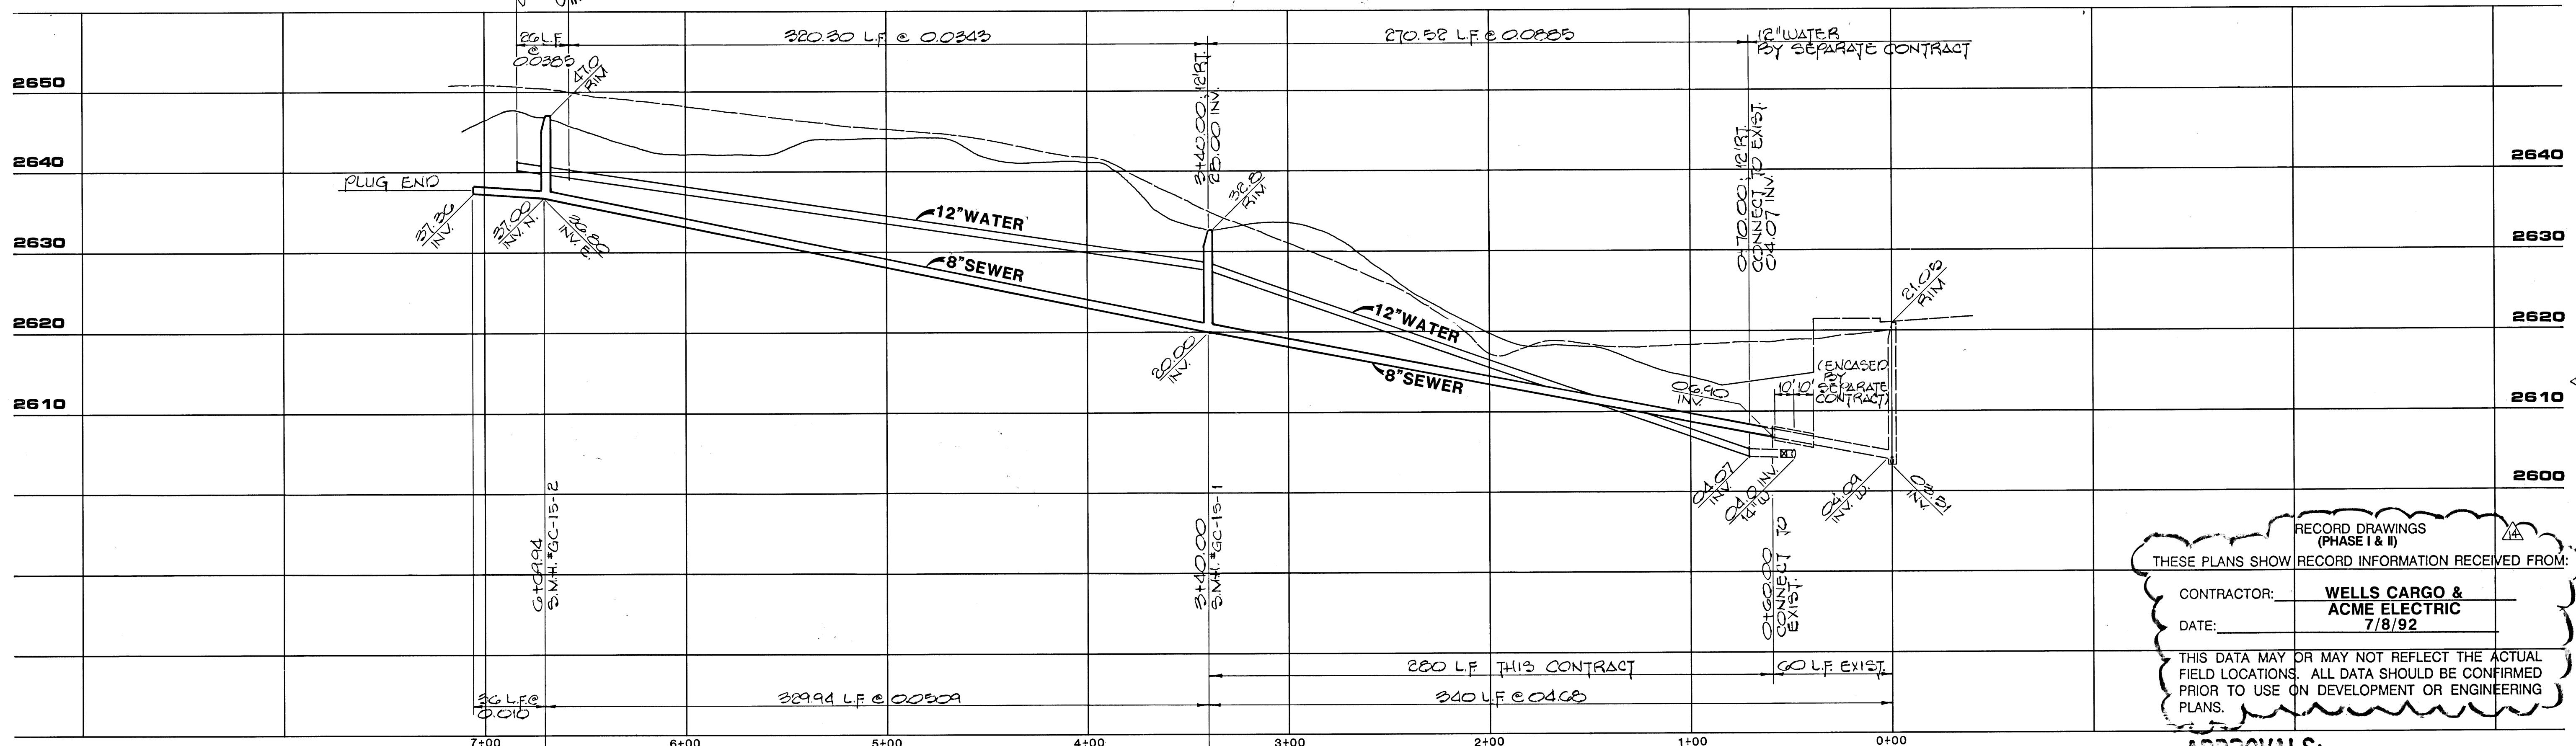

RECORD DRAWINGS
(PHASE I & II)
THESE PLANS SHOW RECORD INFORMATION RECEIVED FROM:
CONTRACTOR: **WELLS CARGO & ACME ELECTRIC**
DATE: **7/8/92**
THIS DATA MAY OR MAY NOT REFLECT THE ACTUAL FIELD LOCATIONS. ALL DATA SHOULD BE CONFIRMED PRIOR TO USE ON DEVELOPMENT OR ENGINEERING PLANS.

APPROVALS:
[Signature] **8-03-90**
LAS VEGAS VALLEY WATER DISTRICT DATE

REV	DATE	DESCRIPTION
1	7/8/92	RECORD DRAWINGS
2	8/16/91	REVISION / C.V. COMMENTS
3	8/10/92	ISSUE TO CONSTRUCT
4	8/10/92	PROJECT PHASE REVISION

RECOMMENDED BY: *[Signature]*
 G.C. WALLACE, INC.
 Engineering/Architecture
 1535 SOUTH RAINBOW BLVD., LAS VEGAS, NEVADA 89102

HOWARD HUGHES PROPERTIES
SUMMERLIN VILLAGE I SOUTH
SEWER POD 7 FROM RAMPART BLVD.
WATER & SEWER PLAN

SHEET
WS-15
 SHT. 35 OF 44

23-3-4 107-V1815