



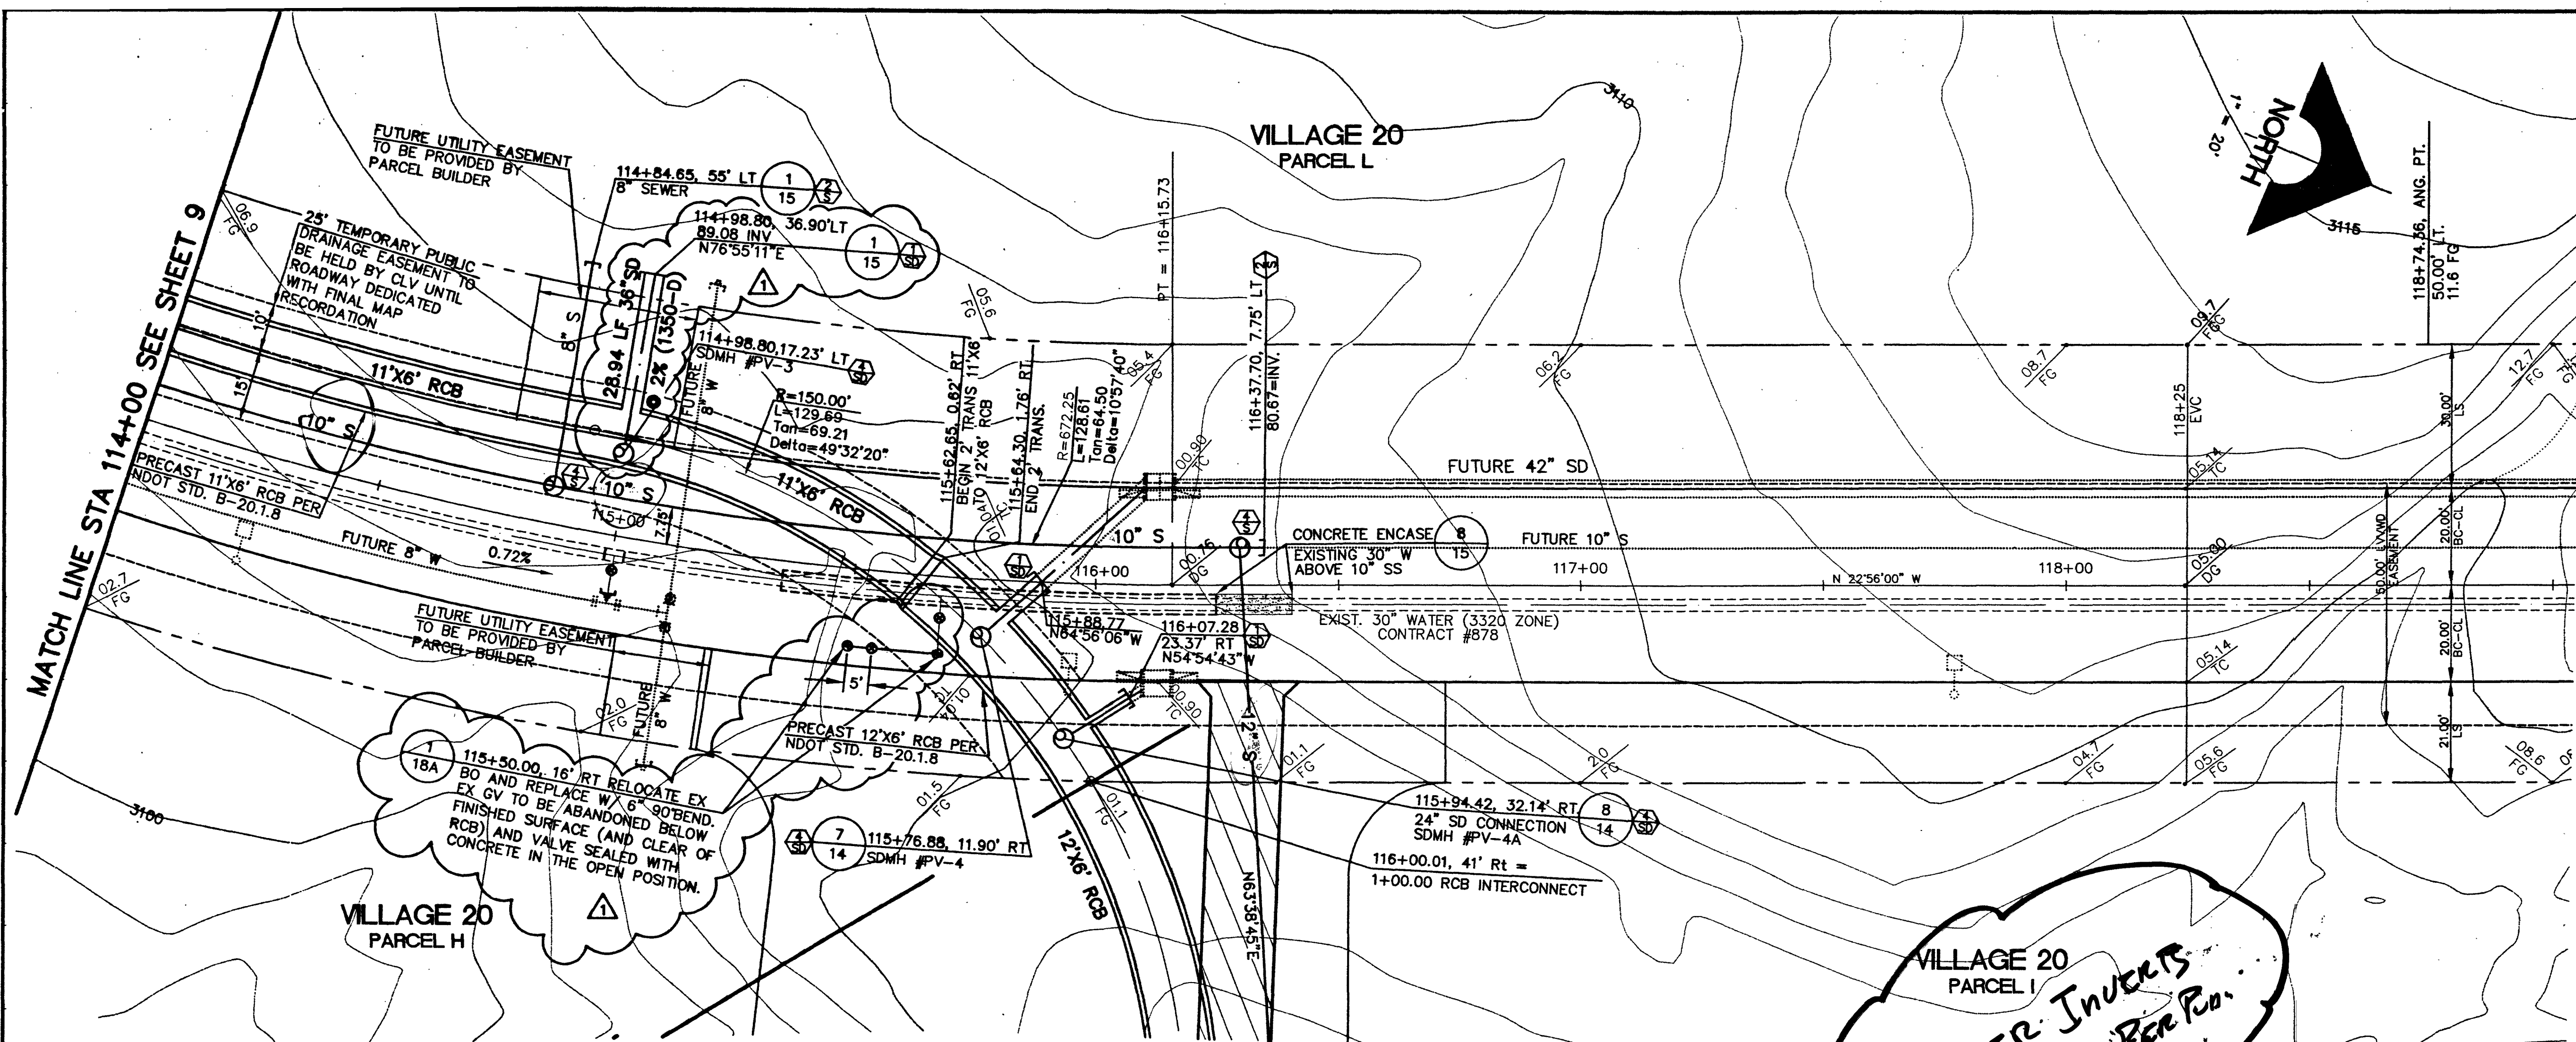

PARK VISTA DRIVE (PUBLIC)

SCALE: HORIZ. 1" = 20'
VERT. 1" = 5'

VILLAGE 20
PARCEL I
SEWER INVERTS
& LAYOUT PER PLAN
AS BUILT NOTE

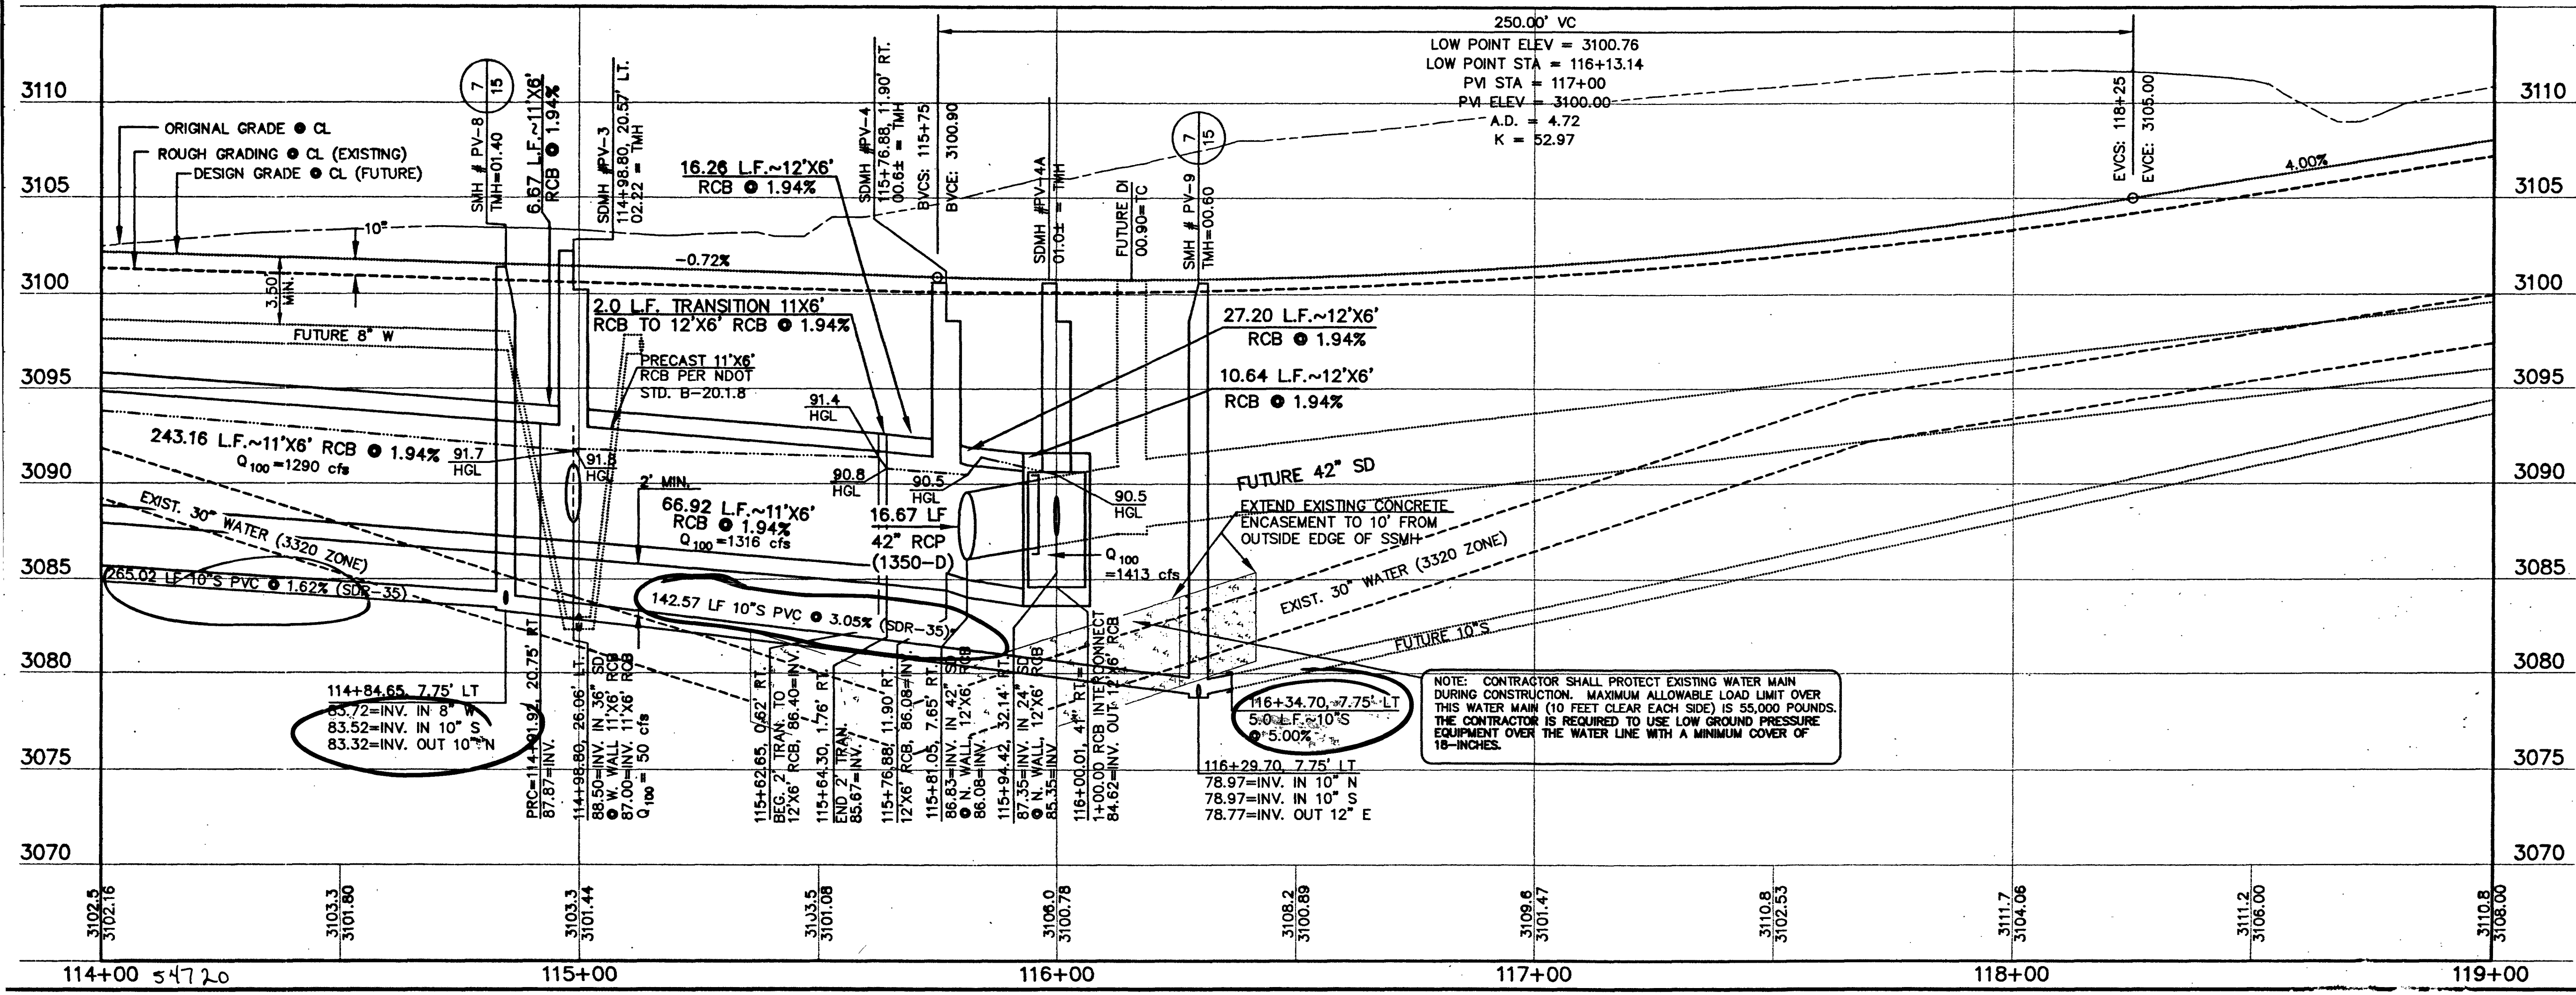

NOTE TO CONTRACTOR:
1. ALL EXISTING UTILITY CROSSINGS MUST BE VERIFIED PRIOR TO CONSTRUCTION OF ANY MAIN LINES OR LATERALS THAT MAY BE ADVERSELY EFFECTED. ANY DISCREPANCIES IN LOCATION AND/OR ELEVATION MUST BE PROVIDED TO THE ENGINEER FOR ACCEPTANCE PRIOR TO CONSTRUCTION.
2. TOPOGRAPHY SHOWN HEREIN REFLECTS ORIGINAL EXISTING TOPOGRAPHY. ACTUAL FIELD CONDITIONS INCLUDE SITE ROUGH GRADING.

- CONSTRUCTION NOTES**
- STORM DRAIN**
- 1. INSTALL TEMPORARY PLUG
 - 2. INSTALL TYPE "A" DROP INLET
 - 3. INSTALL MODIFIED TYPE "C" DROP INLET
 - 4. INSTALL TYPE 1 ACCESS STORM DRAIN MANHOLE
- SEWER**
- 1. INSTALL 48" DIA. SEWER MANHOLE
 - 2. INSTALL TEMPORARY PLUG WITH 3/4" "CDX" PLY. AND 30# FELT COVER
 - 3. INSTALL CONCRETE COLLAR
 - 4. INSTALL 60" DIA. DEEP SEWER MANHOLE
 - 5. INSTALL LOCKING COVER
- WATER**
- 1. PROTECT EXISTING WATER FACILITY IN PLACE


BASIS OF BEARING
NORTH 89°45'05" EAST BEING THE SOUTH LINE OF THE SOUTHWEST QUARTER (SW 1/4) OF SECTION 35, TOWNSHIP 20, RANGE 59 EAST, M.D.M., AS SHOWN BY MAP ON FILE IN FILE #1, PAGE 28 OF PARCEL MAPS IN THE CLARK COUNTY RECORDER'S OFFICE, CLARK COUNTY, NEVADA.

BENCHMARK
NDOT BRASS REFERENCE CAP, 50.00 FEET NORTH OF STATION 787+19.42 OF CHARLESTON BLVD. (NO. 01V09-34SSB8)
*3209.61 NAVD 1988 DATUM (978.351 M)
3207.61 SUMMERLIN DATUM
* THIS PROJECT BASED ON NAVD 1988 DATUM

NOTE
THIS SET OF DRAWINGS IS BASED UPON NAVD 88 DATUM. PREVIOUS DRAWINGS MAY BE BASED ON OTHER DATUM. CARE SHOULD BE EXERCISED WHEN UTILIZING THIS SET OF DRAWINGS.

Call before you Dig.
1-800-227-2600
CALL BEFORE YOU DO OVERHEAD
CALL 1-702-593-6111

NOTES

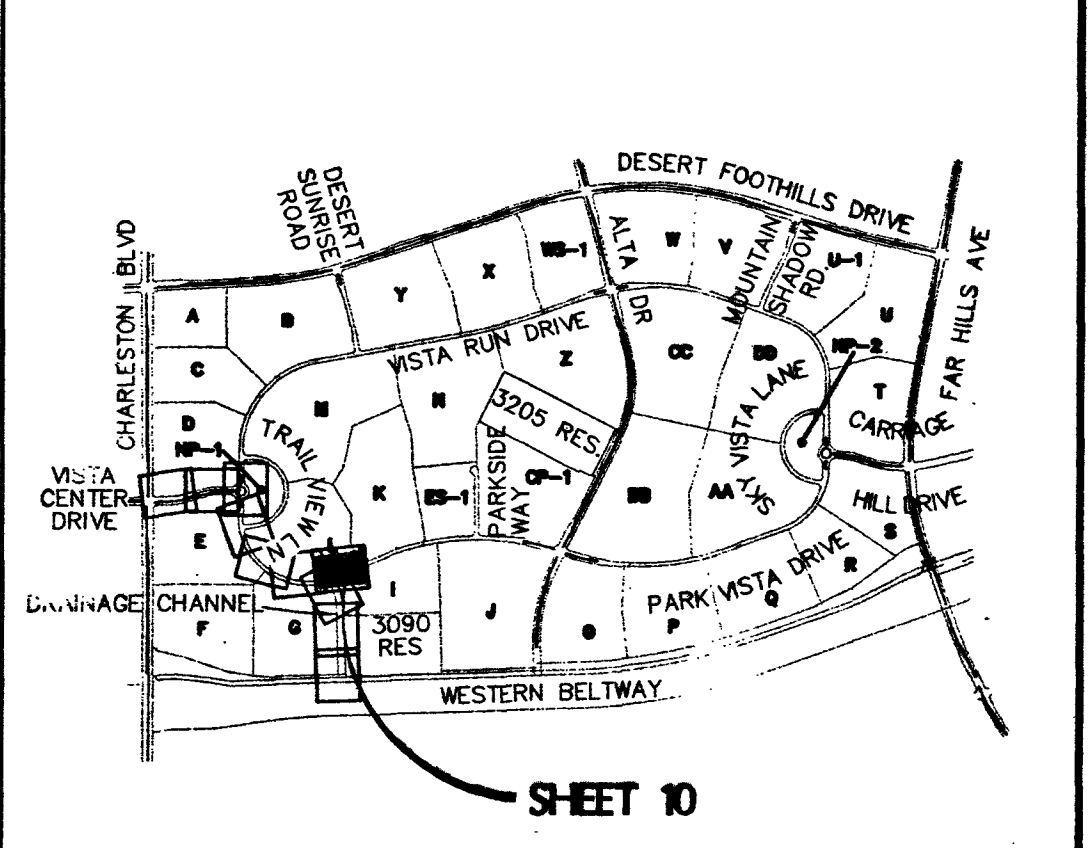

1051114 3/19/01
LAS VEGAS VALLEY WATER DISTRICT
DATE 5/17/01
SHEET C-10
10 OF 18 SHEETS

DESIGN: LHM
DRAWN: LHM
CHECK: BAH
ISSUE DATE: 5/17/01
PLOT DATE: 05-08-04-01
PLOT TIME: 15:55:01
Johannes
G.C. WALLACE, INC.
Engineering/Architecture
1555 SOUTH RAINBOW BLVD./LAS VEGAS, NEVADA 89146
TELEPHONE: (702) 864-2600 FAX: (702) 864-2299
FAX: (702) 864-2600
VILLAGE 20 UNIT 1 REGIONAL DRAINAGE IMPROVEMENTS
PARK VISTA DRIVE
PLAN & PROFILE
STA 114+00 TO 119+00
SHEET C-10
10 OF 18 SHEETS
JOB NO. 02000225