

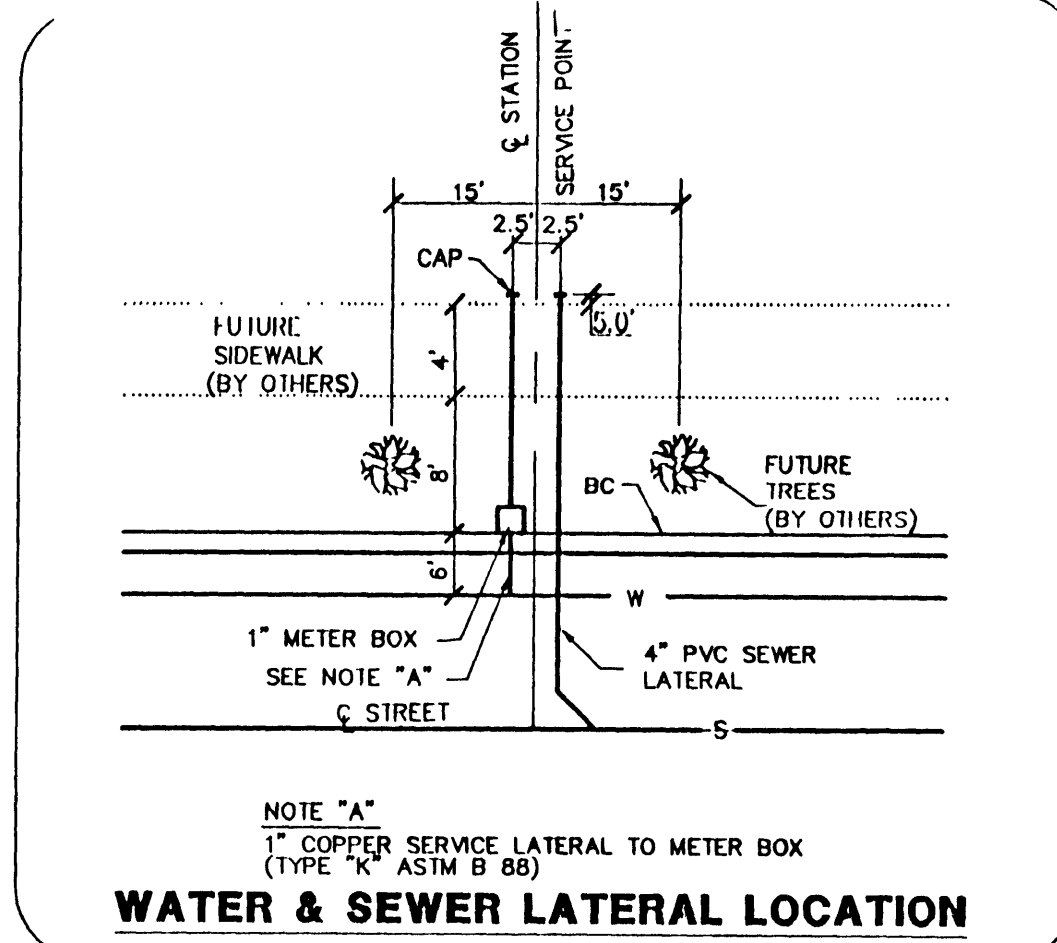
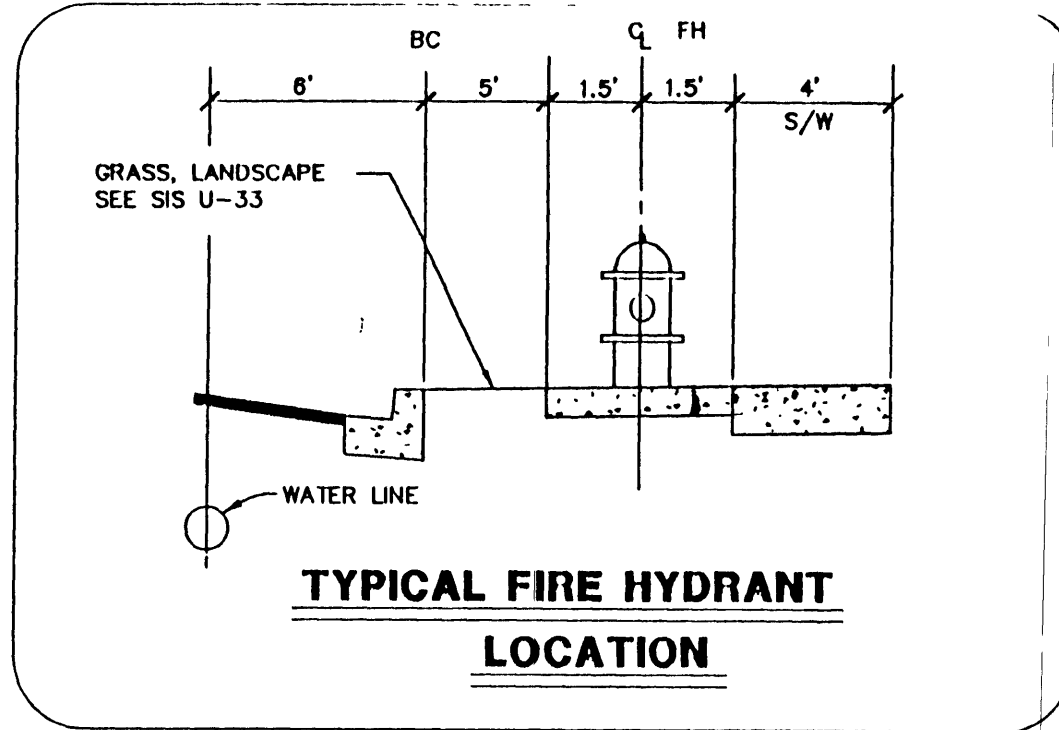
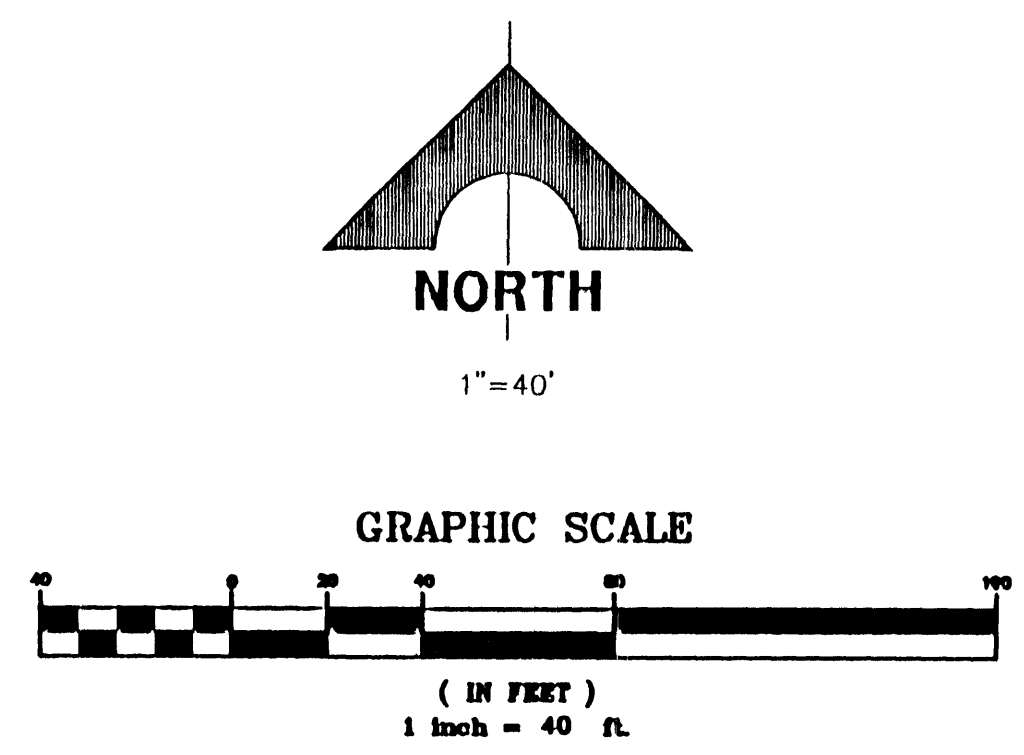


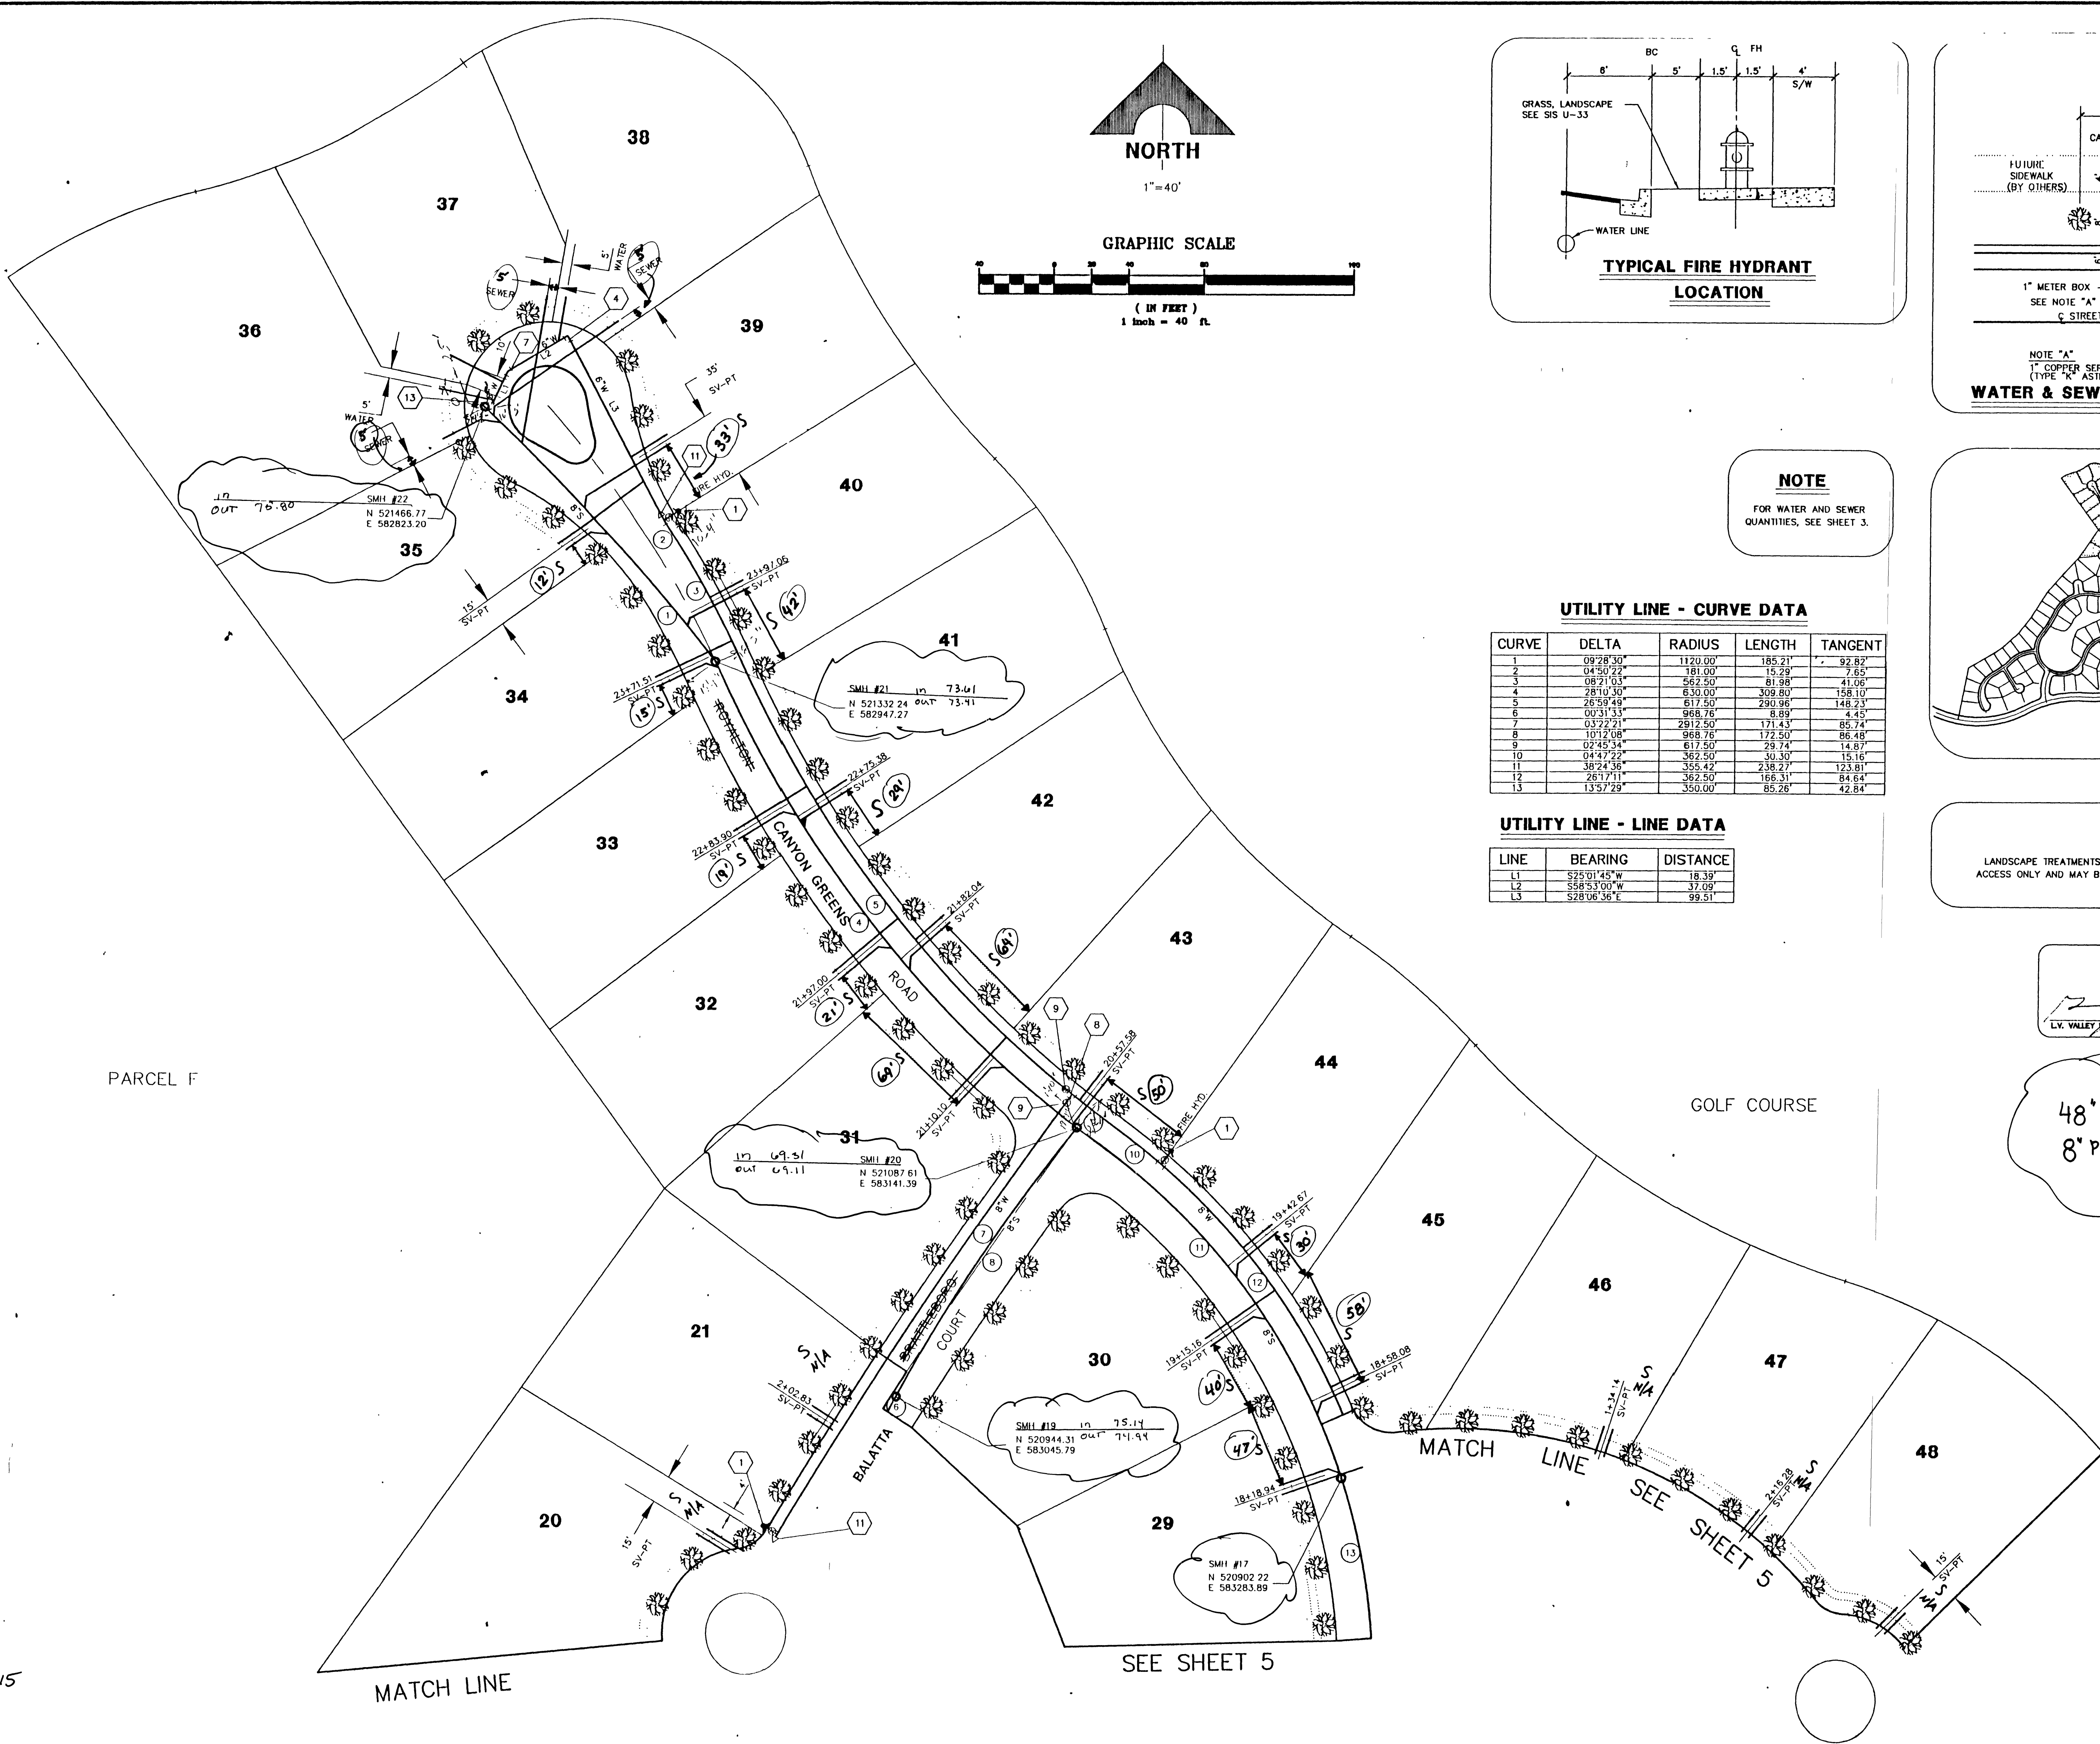


NOTE
FOR WATER AND SEWER QUANTITIES, SEE SHEET 3.

UTILITY LINE - CURVE DATA				
CURVE	DELTA	RADIUS	LENGTH	TANGENT
1	09°28'30"	1120.00'	185.21'	92.82'
2	04°50'22"	181.00'	15.29'	7.65'
3	08°31'03"	562.50'	81.98'	41.06'
4	28°10'30"	630.00'	309.80'	158.10'
5	26°59'49"	617.50'	290.96'	148.23'
6	00°31'53"	968.76'	8.89'	4.45'
7	03°22'21"	2912.50'	171.43'	85.74'
8	10°12'08"	968.76'	172.50'	86.48'
9	02°45'34"	617.50'	29.74'	14.87'
10	04°47'22"	362.50'	30.30'	15.16'
11	38°24'56"	355.42'	238.27'	123.81'
12	26°17'11"	362.50'	166.31'	84.64'
13	13°57'29"	350.00'	85.26'	42.84'


UTILITY LINE - LINE DATA		
LINE	BEARING	DISTANCE
L1	S25°01'45"W	18.39'
L2	S58°53'00"W	37.09'
L3	S28°06'36"E	99.51'

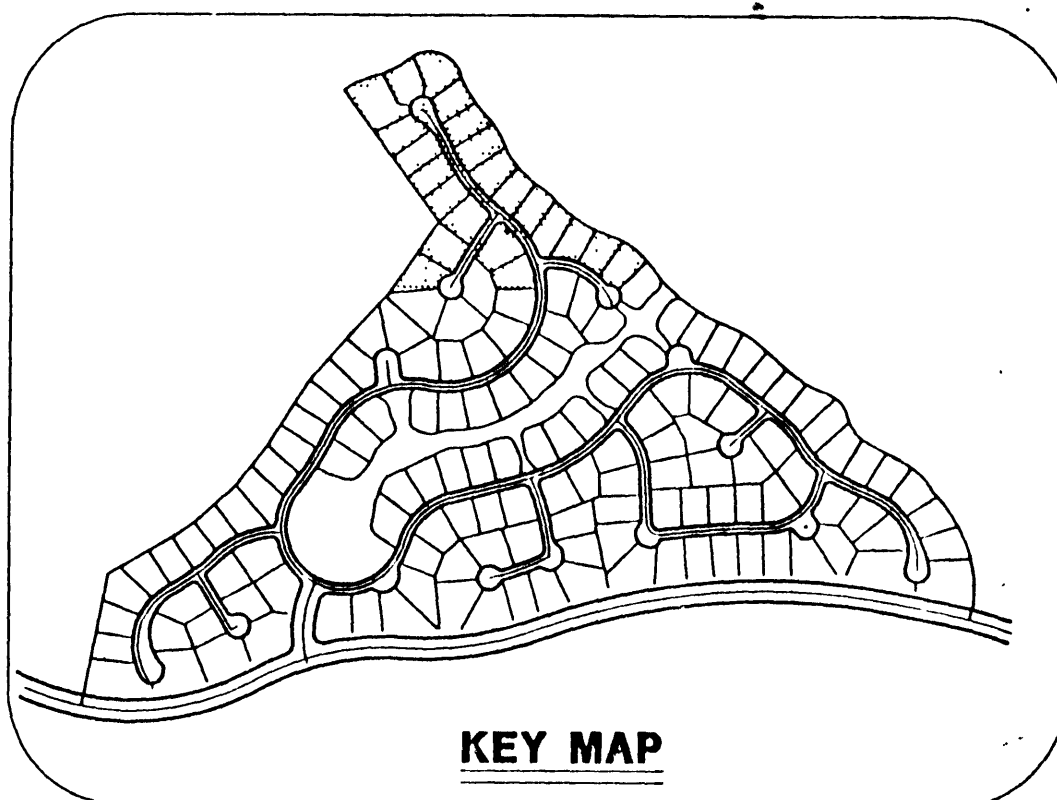

NOTE
LANDSCAPE TREATMENTS ARE SHOWN FOR DRIVEWAY & UTILITY ACCESS ONLY AND MAY BE REVISED BY THE LANDSCAPE ARCHITECT

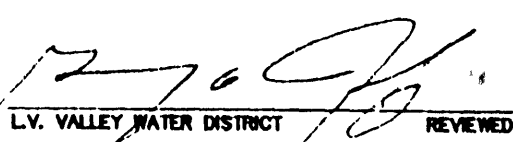APPROVALS
 3/15/96
L.V. VALLEY WATER DISTRICT REVIEWED BY DATE

48" SS MH's
8" PVC Mains

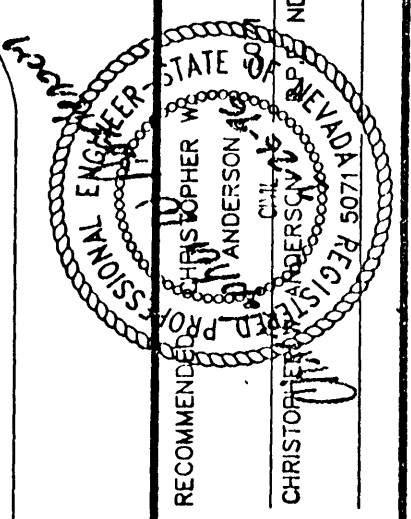

SUMMERLIN
VILLAGE 3 CUSTOM LOTS - PHASE 1
MASTER UTILITY PLAN 4
* SEWER AS-BUILT *