


SIGN SUMMARY

Inst. No.	Station	Loc.	Message	Sign No.	Panel Size	Post		Sign Area Sq. Ft.
						Type & Size	Length	
1.	94+00.00	Lt.	Speed Limit 35	R2-1	24" x 30"	2-1/2" Sq. Metal	10.50'	5.00
2.	94+00.00	Lt.	Speed Limit 35	R2-1	24" x 30"	2-1/2" Sq. Metal	10.50'	5.00
3.	96+60.28	Rt.	Yield	R1-2	36" x 36" x 36"	2-1/2" Sq. Metal	10.50'	3.90
4.	96+70.58	Rt.	Yield	R1-2	36" x 36" x 36"	2-1/2" Sq. Metal	10.50'	3.90
5.	DELETED							
6.	50+84.76	Rt.	Yield	R1-2	36" x 36" x 36"	2-1/2" Sq. Metal	10.50'	3.90
7.	50+99.19	Rt.	Yield	R1-2	36" x 36" x 36"	2-1/2" Sq. Metal	10.50'	3.90
8.	DELETED							
9.	99+67.00	Rt.	(Object Marker)	EOR	18" x 18"	2-1/2" Sq. Metal	7.00'	2.25
10.	98+82.28	Lt.	Yield	R1-2	36" x 36" x 36"	2-1/2" Sq. Metal	10.50'	3.90
11.	98+76.36	Lt.	Yield	R1-2	36" x 36" x 36"	2-1/2" Sq. Metal	10.50'	3.90
12.	DELETED							
13.	1+92.00	Rt.	(Object Marker)	EOR	18" x 18"	2-1/2" Sq. Metal	7.00'	2.25
14.	1+92.00	Rt.	(Object Marker)	EOR	18" x 18"	2-1/2" Sq. Metal	7.00'	2.25
15.	1+10.55	Lt.	Yield	R1-2	36" x 36" x 36"	2-1/2" Sq. Metal	10.50'	3.90
16.	1+02.97	Lt.	Yield	R1-2	36" x 36" x 36"	2-1/2" Sq. Metal	10.50'	3.90
17.	DELETED							
18.	97+08.51	Rt.	One Way	R6-1	36" x 12"	2-1/2" Sq. Metal	2.50'	3.00
19.	51+40.50	Rt.	One Way	R6-1	36" x 12"	2-1/2" Sq. Metal	2.50'	3.00
20.	98+36.25	Lt.	One Way	R6-1	36" x 12"	2-1/2" Sq. Metal	2.50'	3.00
21.	0+64.23	Lt.	One Way	R6-1	36" x 12"	2-1/2" Sq. Metal	2.50'	3.00
22.	48+50.00	Lt.	Speed Limit 35	R2-1	24" x 30"	2-1/2" Sq. Metal	10.50'	5.00
23.	48+50.00	Lt.	Speed Limit 35	R2-1	24" x 30"	2-1/2" Sq. Metal	10.50'	5.00
24.	45+40.00	Rt.	Yield Ahead (Symbol)	W3-2a	36" x 36"	2-1/2" Sq. Metal	10.50'	9.00
25.	45+40.00	Rt.	Yield Ahead (Symbol)	W3-2a	36" x 36"	2-1/2" Sq. Metal	10.50'	9.00
26.	DELETED							
27.	DELETED							
28.	DELETED							
29.	DELETED							
30.	34+70.00	Lt.	Yield Ahead (Symbol)	W3-2a	36" x 36"	2-1/2" Sq. Metal	10.50'	9.00
31.	34+70.00	Lt.	Yield Ahead (Symbol)	W3-2a	36" x 36"	2-1/2" Sq. Metal	10.50'	9.00
32.	33+00.00	Rt.	Speed Limit 35	R2-1	24" x 30"	2-1/2" Sq. Metal	10.50'	5.00
33.	33+00.00	Rt.	Speed Limit 35	R2-1	24" x 30"	2-1/2" Sq. Metal	10.50'	5.00
34.	29+82.22	Lt.	Yield	R1-2	36" x 36" x 36"	2-1/2" Sq. Metal	10.50'	3.90
35.	29+67.30	Lt.	Yield	R1-2	36" x 36" x 36"	2-1/2" Sq. Metal	10.50'	3.90
36.	DELETED							
37.	116+09.15	Lt.	Yield	R1-2	36" x 36" x 36"	2-1/2" Sq. Metal	10.50'	3.90
38.	115+85.17	Lt.	Yield	R1-2	36" x 36" x 36"	2-1/2" Sq. Metal	10.50'	3.90
39.	DELETED							
40.	24+98.00	Lt.	(Object Marker)	EOR	18" x 18"	2-1/2" Sq. Metal	7.00'	2.25
41.	24+98.00	Lt.	(Object Marker)	EOR	18" x 18"	2-1/2" Sq. Metal	7.00'	2.25
42.	26+58.96	Rt.	Yield	R1-2	36" x 36" x 36"	2-1/2" Sq. Metal	10.50'	3.90
43.	26+71.48	Rt.	Yield	R1-2	36" x 36" x 36"	2-1/2" Sq. Metal	10.50'	3.90
44.	DELETED							
45.	112+88.64	Rt.	Yield	R1-2	36" x 36" x 36"	2-1/2" Sq. Metal	10.50'	3.90
46.	112+93.40	Rt.	Yield	R1-2	36" x 36" x 36"	2-1/2" Sq. Metal	10.50'	3.90
47.	DELETED							
48.	29+22.31	Lt.	One Way	R6-1	36" x 12"	2-1/2" Sq. Metal	2.50'	3.00
49.	116+60.51	Lt.	One Way	R6-1	36" x 12"	2-1/2" Sq. Metal	2.50'	3.00
50.	27+26.65	Rt.	One Way	R6-1	36" x 12"	2-1/2" Sq. Metal	2.50'	3.00
51.	113+45.68	Rt.	One Way	R6-1	36" x 12"	2-1/2" Sq. Metal	2.50'	3.00
52.	117+20.00	Rt.	Lane Width Transition	W4-2	36" x 36"	2-1/2" Sq. Metal	10.50'	9.00
53.	117+20.00	Rt.	Lane Width Transition	W4-2	36" x 36"	2-1/2" Sq. Metal	10.50'	9.00
54.	121+00.00	Rt.	Speed Limit 35	R2-1	24" x 30"	2-1/2" Sq. Metal	10.50'	5.00
55.	121+00.00	Rt.	Speed Limit 35	R2-1	24" x 30"	2-1/2" Sq. Metal	10.50'	5.00
56.	428+50.00	Lt.	Yield Ahead (Symbol)	W3-2a	36" x 36"	2-1/2" Sq. Metal	10.50'	9.00
57.	428+50.00	Rt.	Yield Ahead (Symbol)	W3-2a	36" x 36"	2-1/2" Sq. Metal	10.50'	9.00
58.	DELETED							
59.	DELETED							
60.	94+00.00	Rt.	Right Lane Must Turn Right	R3-7	30" x 30"	2-1/2" Sq. Metal	10.50'	6.25
TOTAL								215.90 S.F.

EOR - END OF ROAD MARKER

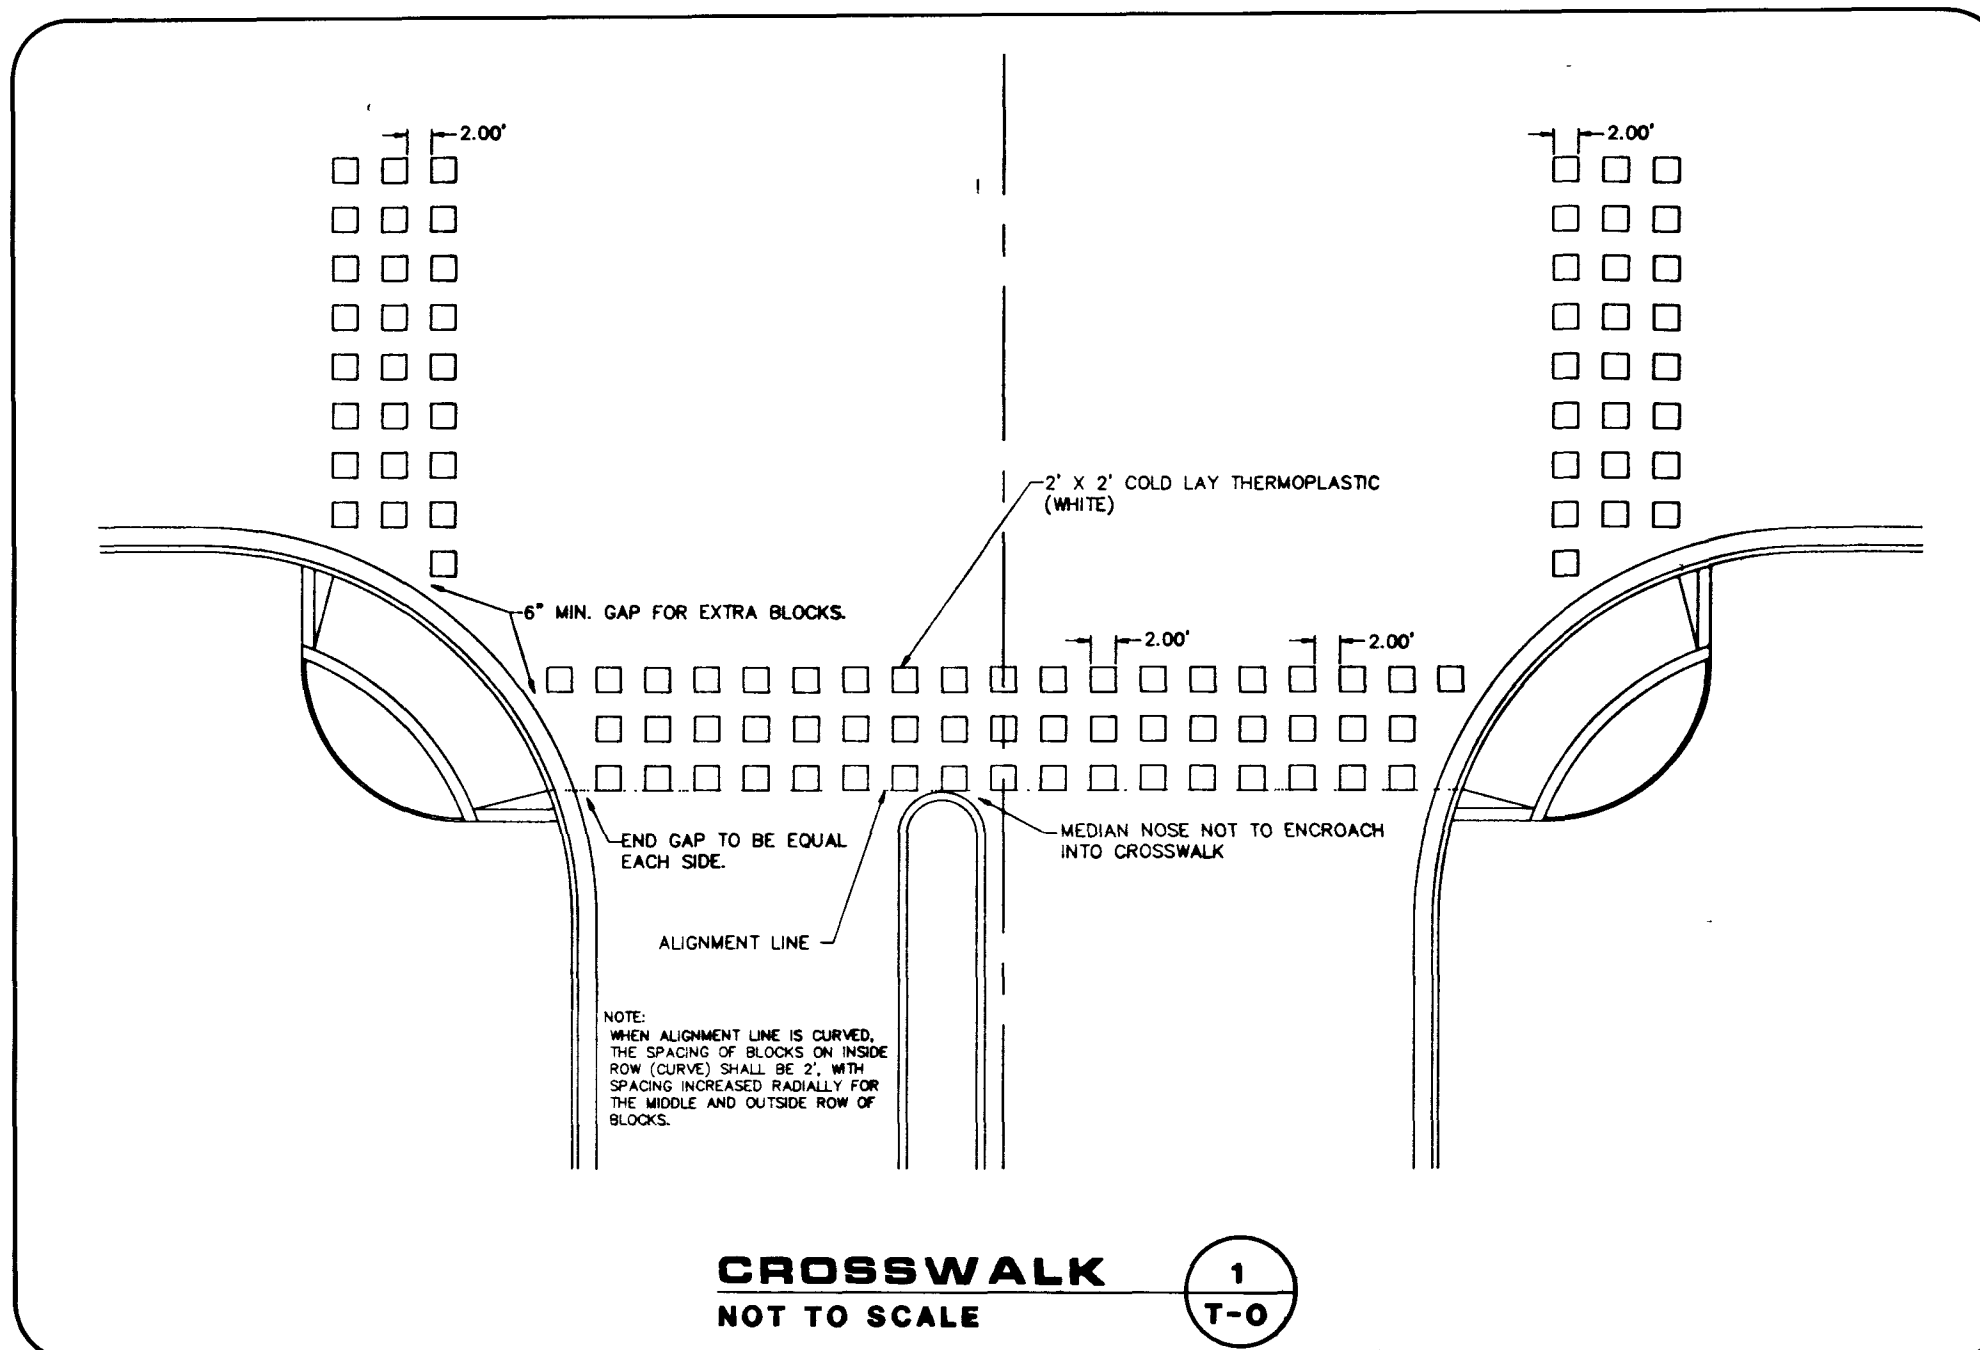


RECORD DRAWINGS

THESE PLANS SHOW RECORD INFORMATION RECEIVED FROM:

CONTRACTOR: **WELLS CARGO INC.**DATE: **6/19/90**

THIS DATA MAY OR MAY NOT REFLECT THE ACTUAL FIELD LOCATIONS. ALL DATA SHOULD BE CONFIRMED PRIOR TO USE ON DEVELOPMENT OR ENGINEERING PLANS.

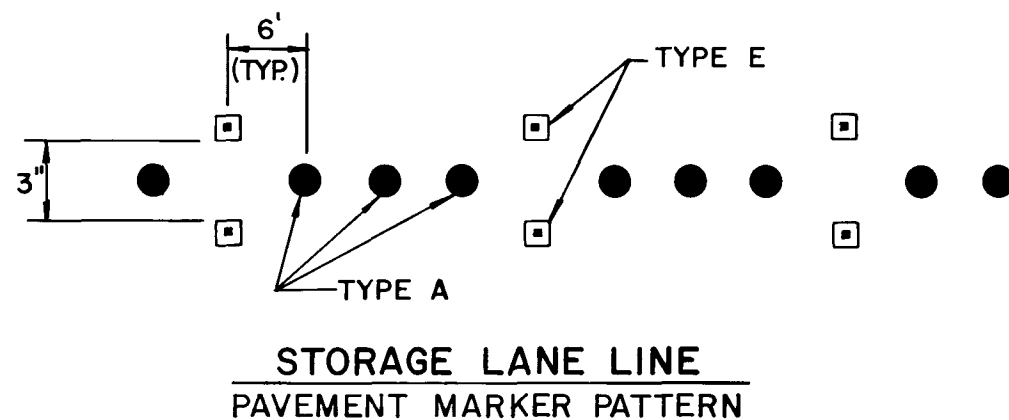


NOTE: THESE PLANS ARE FOR THE PURPOSE OF ROADWAY IMPROVEMENTS AND UTILITIES (PAVEMENT WITH BASE, CURB AND GUTTER, STORM DRAIN, WATER, SEWER, ETC.). ALL ROADWAY AND LANDSCAPE AREAS HAVE BEEN PREVIOUSLY ROUGH GRADED. ANY LIMITS OF ROUGH GRADING SHOWN ARE FOR REFERENCE ONLY. FOR SCOPE AND LIMITS OF ROUGH GRADING, SEE "TOWN CENTER DRIVE - ROUGH GRADING" PACKAGE. FOR FINISH GRADING OF LANDSCAPE AREAS, SEE LANDSCAPE PACKAGE BY SWA GROUP.

QUANTITIES

YIELD LINE (THERMOPLASTIC)	405 LF
4" SOLID YELLOW LINE (PAINTED)	112 LF
4" SOLID WHITE LINE (PAINTED)	846 LF
TYPE A NON-REFLECTIVE PAVEMENT MARKER	620 EA
TYPE D REFLECTIVE PAVEMENT MARKER	320 EA
TYPE E REFLECTIVE PAVEMENT MARKER	420 EA
THERMOPLASTIC PAVEMENT MARKING (YIELD)	19 EA
SIGNS	294 SF

GENERAL NOTES

- ALL SIGNS SHALL CONFORM TO THE REQUIREMENTS SET FORTH IN THE MANUAL OF UNIFORM TRAFFIC CONTROL DEVICES, 1978, AND STANDARD HIGHWAY SIGNS WITH NEVADA SUPPLEMENTS, AND SHALL BE MOUNTED ON SUMMERLIN'S STANDARD SIGN POSTS, (SIS DWG. RS-3).
- SIGN NUMBERS SHOWN ON SIGN SUMMARY ARE TAKEN FROM THE MANUAL ON UNIFORM TRAFFIC CONTROL DEVICES (1978) AND STANDARD HIGHWAY SIGNS-NEVADA SUPPLEMENT.
- FOR MOUNTING DETAILS NOT SHOWN SEE THE STATE OF NEVADA STANDARD PLANS FOR ROAD AND BRIDGE CONSTRUCTION (1988 REVISED).
- ALL CONSTRUCTION AND MATERIALS FOR THIS PROJECT SHALL BE IN ACCORDANCE WITH THE MOST RECENT EDITION OF THE STANDARD SPECIFICATIONS FOR ROAD AND BRIDGE CONSTRUCTION, NEVADA DEPARTMENT OF TRANSPORTATION.
- LOCATIONS OF EXISTING UTILITIES ARE NOT SHOWN. THE CONTRACTOR'S RESPONSIBILITY REGARDING UTILITIES SHALL BE AS REQUIRED IN SECTION 107.17 OF THE STANDARD SPECIFICATIONS.
- THE CONTRACTOR WILL NOT BE REQUIRED TO MAINTAIN PUBLIC TRAFFIC FOR THIS PROJECT.
- ALL SIGN LETTERING SHALL BE SERIES E MODIFIED UNLESS OTHERWISE NOTED.
- THE MOUNTING HEIGHT FOR ONE-WAY SIGNS SHALL BE 0.5' FROM FINISHED GRADE TO BOTTOM OF SIGN. ALL OTHER MOUNTING HEIGHTS WILL BE PER M.U.T.C.D.

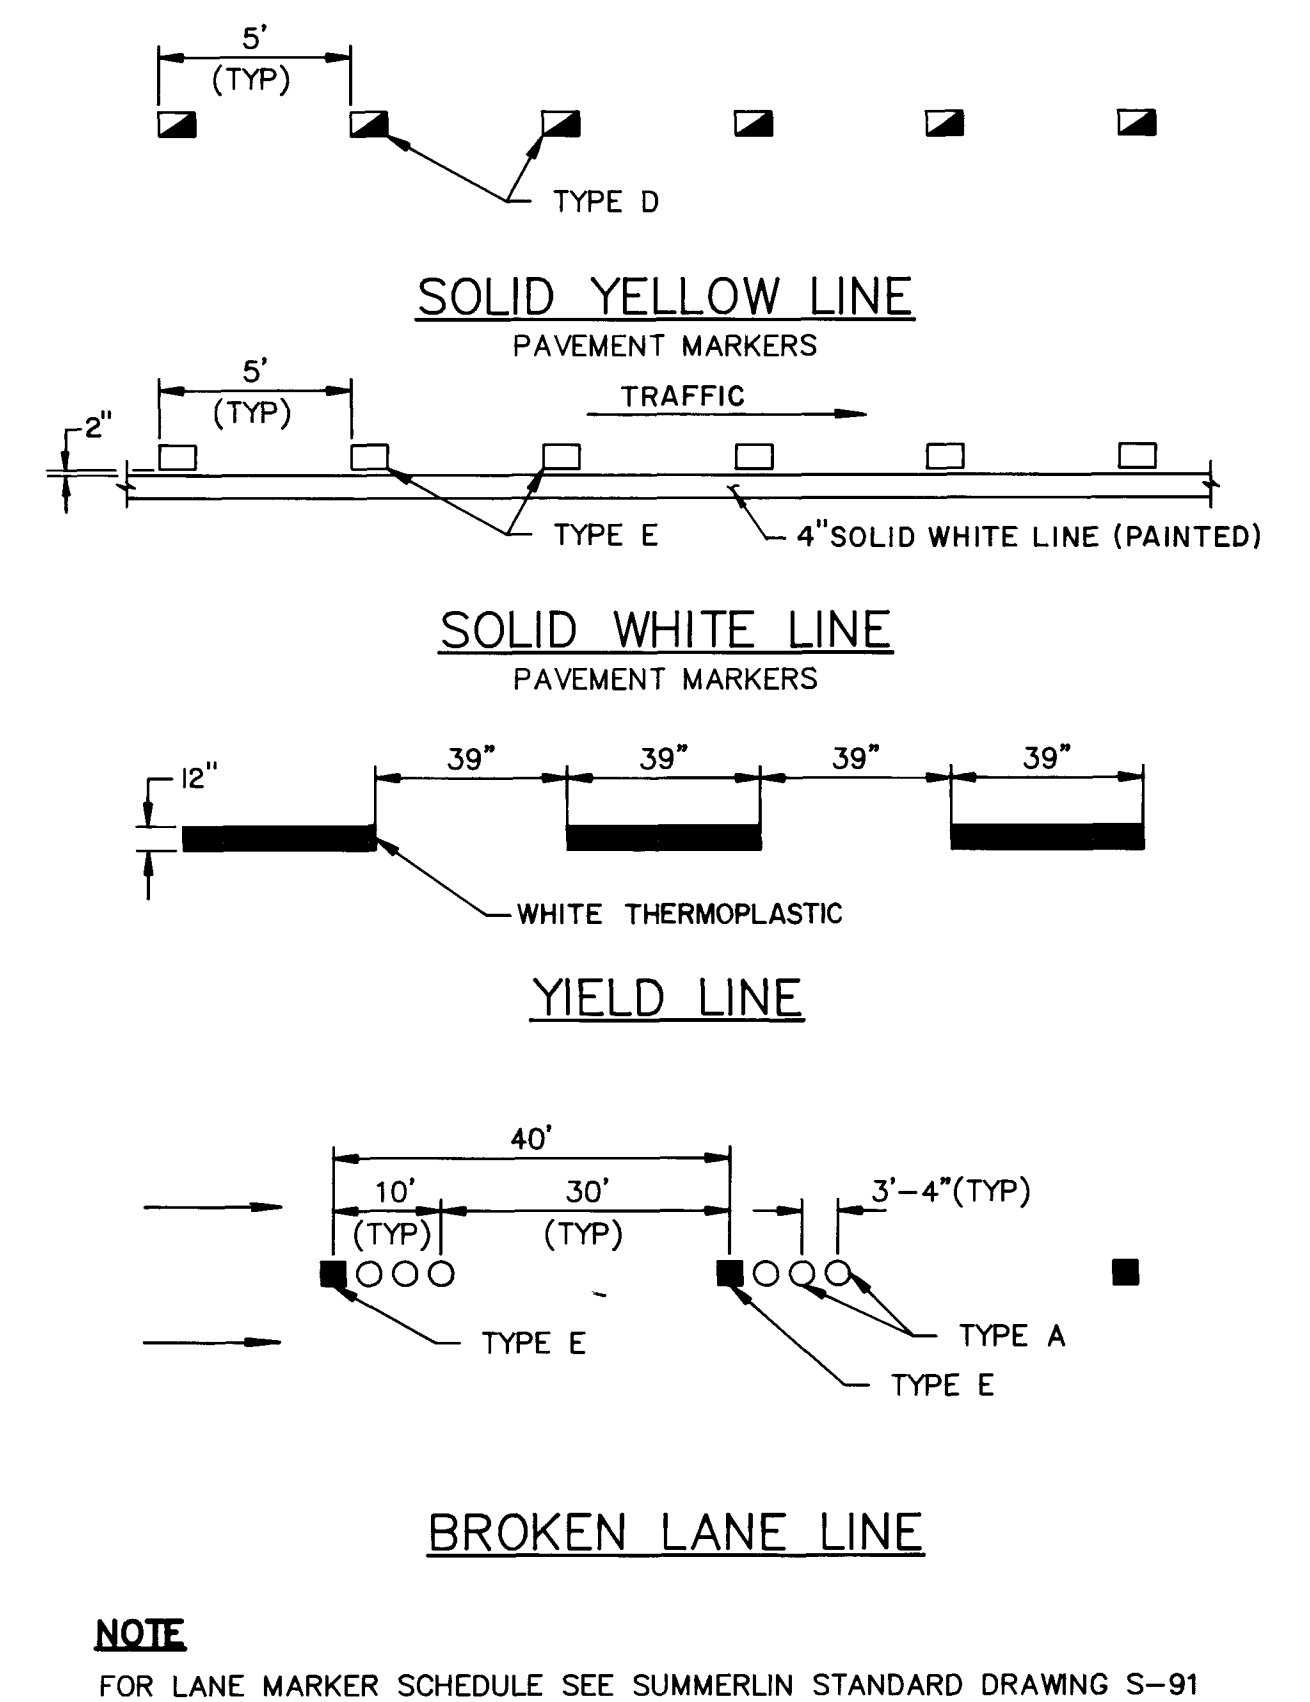

2/12/89

8/19/90 RECORD DRAWINGS
REV DATE DESCRIPTION
1 6/19/90 ISSUED FOR CONSTRUCTION
2 6/19/90 ISSUED FOR CONSTRUCTION
1555 SOUTH RAINBOW BLVD LAS VEGAS, NEVADA 89102

G.C. WALLACE, INC.
Engineering/Architecture

VILLAGE CENTER CIRCLE &
HOWARD HUGHES PROPERTIES
TOWN CENTER DRIVE PHASE II
SIGNING AND STRIPINGS
QUANTITIES, GENERAL NOTES
AND DETAILS

SHEET 32

T-O
OF 37 SHEETS

[illegible]

2. All the following are true of the transformation of DNA into a cell except:
a. The DNA must be in the form of a plasmid.
b. The DNA must be in the form of a linear fragment.
c. The DNA must be in the form of a circular fragment.
d. The DNA must be in the form of a linear fragment.
3. The transformation of DNA into a cell is a process in which:
a. The DNA is taken up by the cell.
b. The DNA is taken up by the cell and integrated into the host genome.
c. The DNA is taken up by the cell and integrated into the host genome.
d. The DNA is taken up by the cell and integrated into the host genome.
4. The transformation of DNA into a cell is a process in which:
a. The DNA is taken up by the cell.
b. The DNA is taken up by the cell and integrated into the host genome.
c. The DNA is taken up by the cell and integrated into the host genome.
d. The DNA is taken up by the cell and integrated into the host genome.
5. The transformation of DNA into a cell is a process in which:
a. The DNA is taken up by the cell.
b. The DNA is taken up by the cell and integrated into the host genome.
c. The DNA is taken up by the cell and integrated into the host genome.
d. The DNA is taken up by the cell and integrated into the host genome.

[illegible]

POPULATION

STAGE 1

STAGE 2

1998, 1999, 2000, 2679, 26