


JOB NO. 620.222

0/04 DIETRICH POST 00328

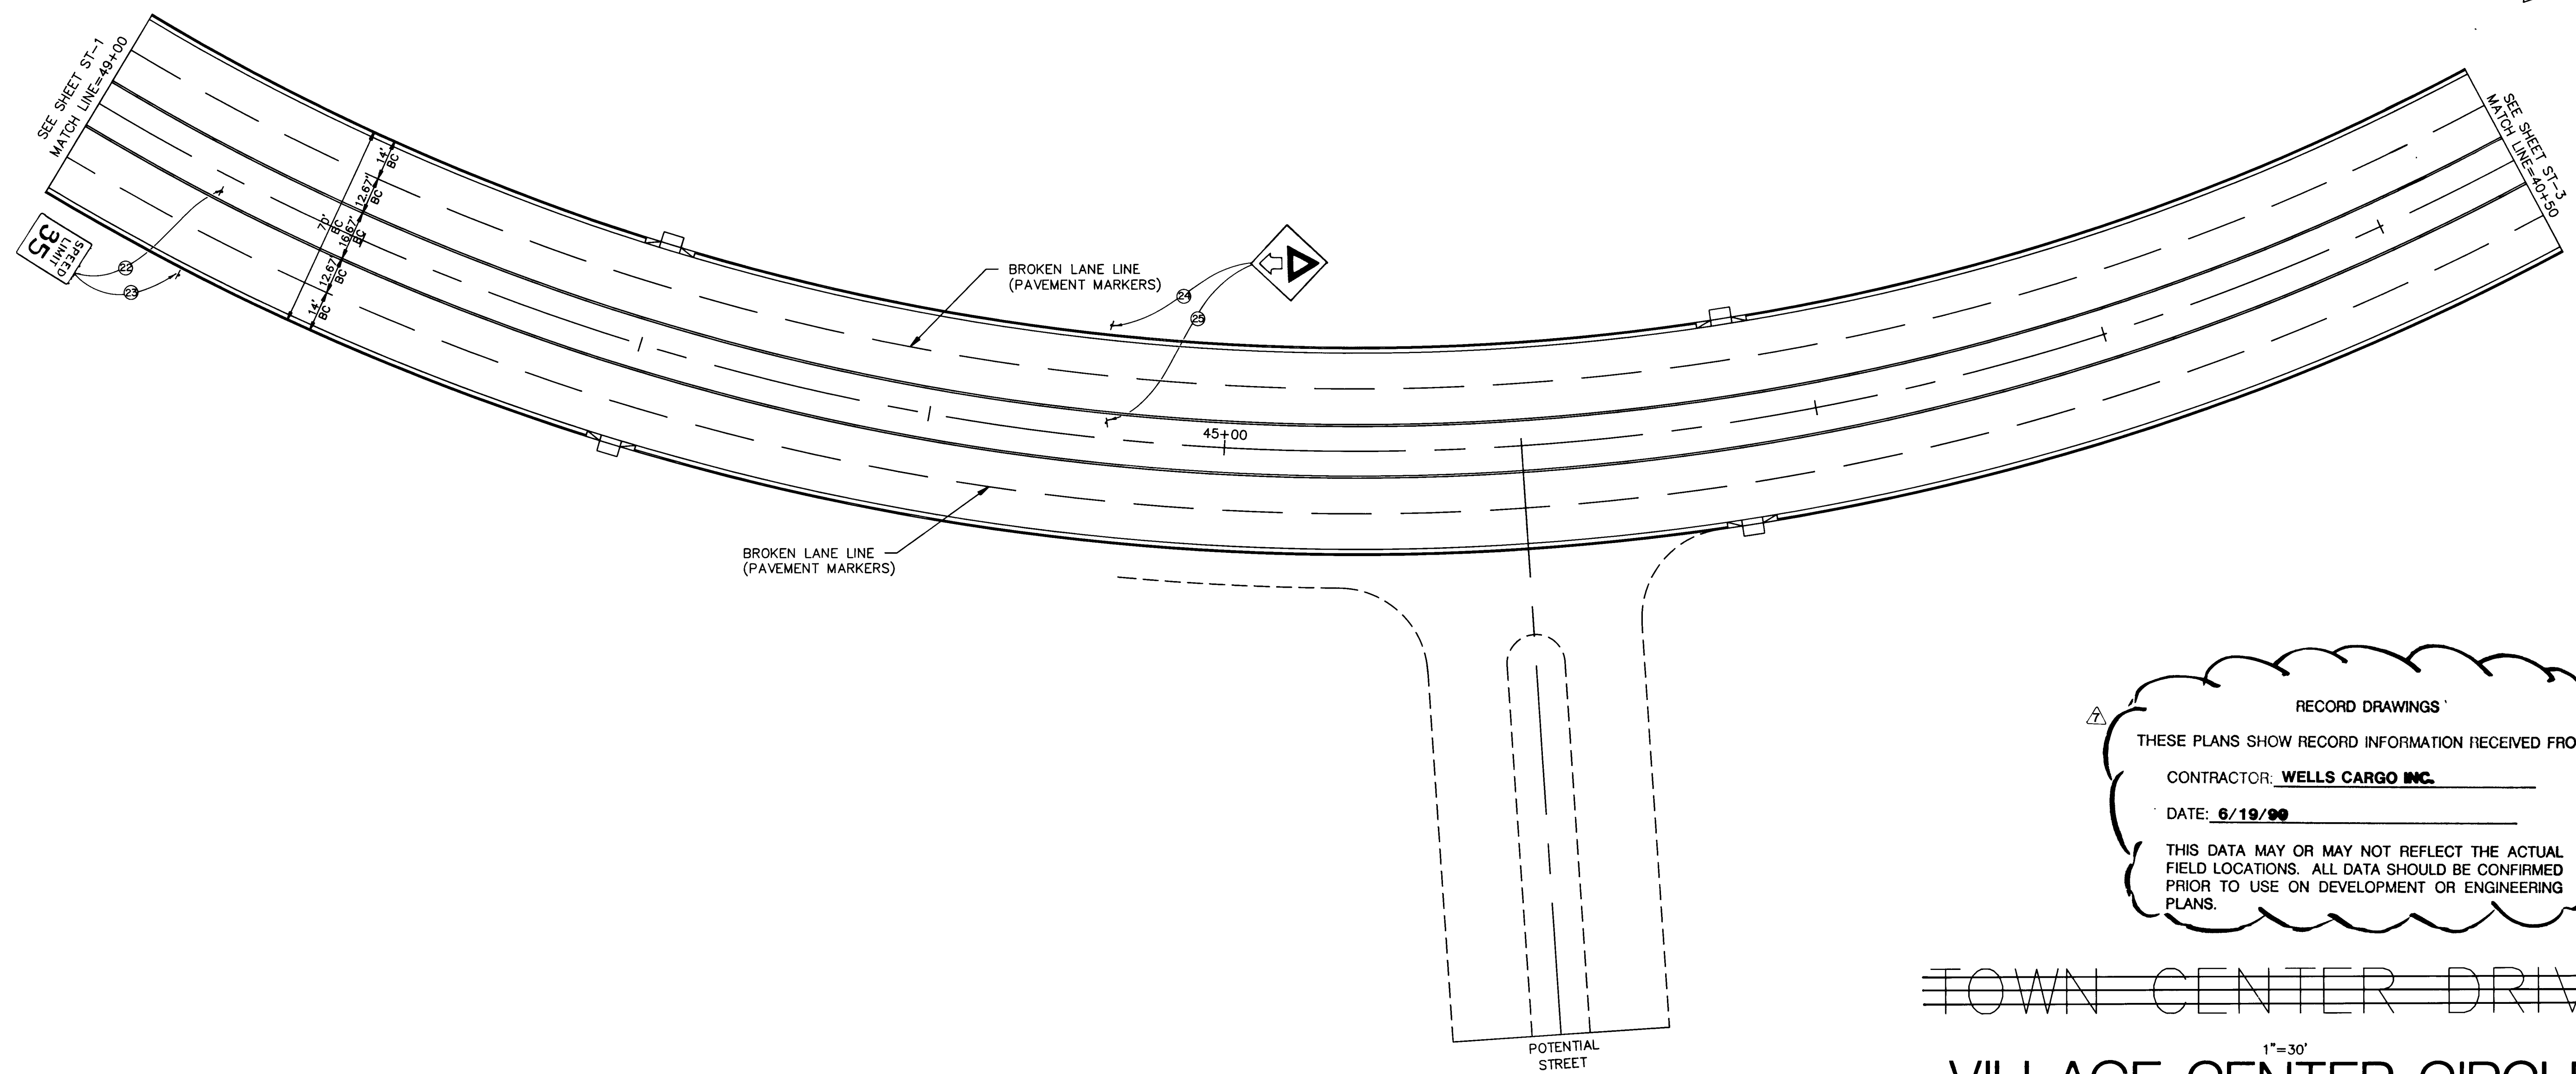

RECORD DRAWINGS
THESE PLANS SHOW RECORD INFORMATION RECEIVED FROM:
CONTRACTOR: **WELLS CARGO INC.**
DATE: **6/19/99**
THIS DATA MAY OR MAY NOT REFLECT THE ACTUAL FIELD LOCATIONS. ALL DATA SHOULD BE CONFIRMED PRIOR TO USE ON DEVELOPMENT OR ENGINEERING PLANS.

TOWN CENTER DRIVE
VILLAGE CENTER CIRCLE
1"=30'

NOTE: THESE PLANS ARE FOR THE PURPOSE OF ROADWAY IMPROVEMENTS AND UTILITIES (PAVEMENT WITH BASE, CURB AND GUTTER, STORM DRAIN, WATER, SEWER, ETC.). ALL ROADWAY AND LANDSCAPE AREAS HAVE BEEN PREVIOUSLY ROUGH GRADED. ANY LIMITS OF ROUGH GRADING SHOWN ARE FOR REFERENCE ONLY. FOR SCOPE AND LIMITS OF ROUGH GRADING, SEE "TOWN CENTER DRIVE - ROUGH GRADING" PACKAGE. FOR FINISH GRADING OF LANDSCAPE AREAS, SEE LANDSCAPE PACKAGE BY SWA GROUP.

2/12/89


REV	DATE	DESCRIPTION
1	2/12/89	ISSUED FOR BID
2	5/19/99	ISSUED FOR CONSTRUCTION
3	6/19/99	ISSUED FOR CONSTRUCTION
4	6/19/99	RECORD DRAWINGS

RECOMMENDED
6/19/99
G.C. WALLACE, INC.
1555 SOUTH RAINBOW BLVD / LAS VEGAS, NEVADA 89102

G.C. WALLACE, INC.
Engineering/Architecture

VILLAGE CENTER CIRCLE &
HOWARD HUGHES PROPERTIES
TOWN CENTER DRIVE PHASE II
SIGNING AND STRIPINGS
STA. 48+00 TO 40+50

SHEET 34
T-2
OF 37 SHEETS

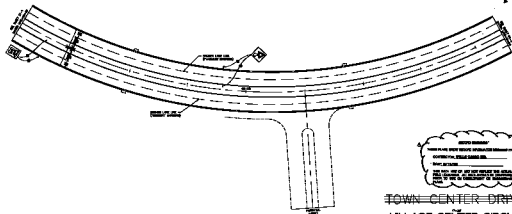

TOWN CENTER DRIVE
VILLAGE CENTER CIRCLE

