


JOB NO. 620.222

894 DIETRICH-POST 60228

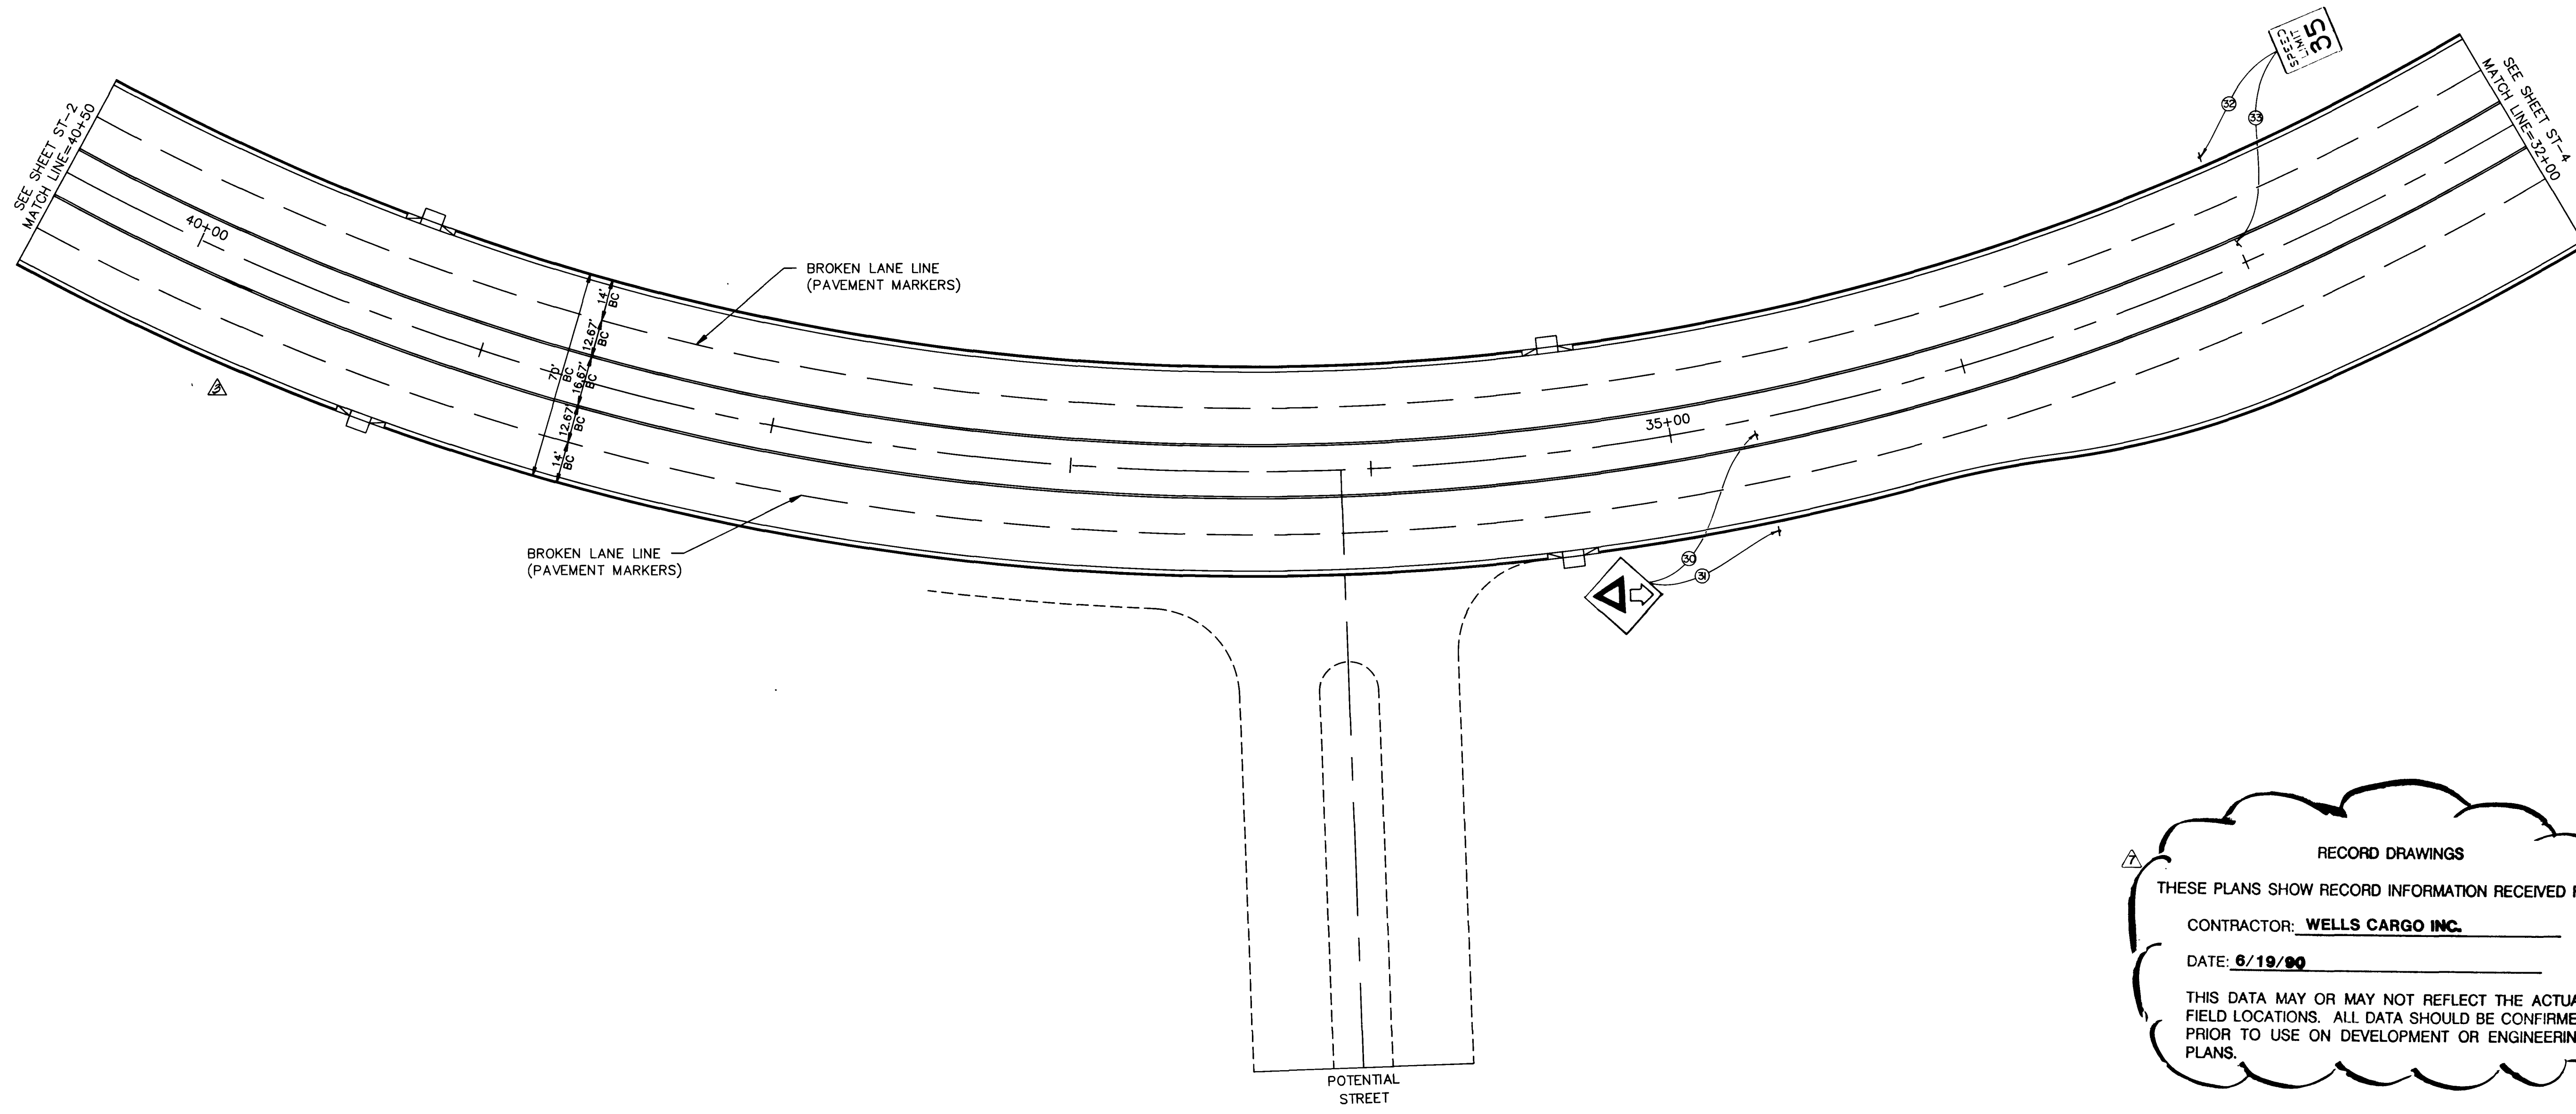

RECORD DRAWINGS

THESE PLANS SHOW RECORD INFORMATION RECEIVED FROM:
 CONTRACTOR: WELLS CARGO INC.
 DATE: 6/19/89

THIS DATA MAY OR MAY NOT REFLECT THE ACTUAL FIELD LOCATIONS. ALL DATA SHOULD BE CONFIRMED PRIOR TO USE ON DEVELOPMENT OR ENGINEERING PLANS.

TOWN CENTER DRIVE
 1"=30'
 VILLAGE CENTER CIRCLE

NOTE: THESE PLANS ARE FOR THE PURPOSE OF ROADWAY IMPROVEMENTS AND UTILITIES (PAVEMENT WITH BASE, CURB AND GUTTER, STORM DRAIN, WATER, SEWER, ETC.). ALL ROADWAY AND LANDSCAPE AREAS HAVE BEEN PREVIOUSLY ROUGH GRADED. ANY LIMITS OF ROUGH GRADING SHOWN ARE FOR REFERENCE ONLY. FOR SCOPE AND LIMITS OF ROUGH GRADING, SEE "TOWN CENTER DRIVE - ROUGH GRADING" PACKAGE. FOR FINISH GRADING OF LANDSCAPE AREAS, SEE LANDSCAPE PACKAGE BY SMA GROUP.

2/12/89

REV	DATE	DESCRIPTION
1	2/12/89	ISSUED FOR BID
2	4/12/89	ISSUED FOR CONSTRUCTION
3	5/12/89	ISSUED FOR CONSTRUCTION
4	5/12/89	ISSUED FOR CONSTRUCTION
RECOMMENDED
 DATE: 5/12/89
 DRAWN BY: [Signature]
 CHECKED BY: [Signature]
 CIVIL ENGINEER


1555 SOUTH RAINBOW BLVD. LAS VEGAS, NEVADA 89102

G.C. WALLACE, INC.
 Engineering/Architecture

VILLAGE CENTER CIRCLE &
 HOWARD HUGHES PROPERTIES
 TOWN CENTER DRIVE PHASE II
 SIGNING AND STRIPING
 STA. 40+50 TO 32+00

SHEET 35
T-3
 OF 37 SHEETS

11-371 107-V1624-2

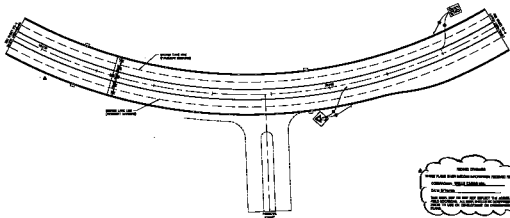

NOTES:
 1. THIS PLAN SHALL BE USED IN CONJUNCTION WITH THE
 CONTRACT DOCUMENTS.
 2. SEE SHEET T-3
 3. THIS PROJECT IS SUBJECT TO THE LOCAL
 ORDINANCES AND REGULATIONS IN EFFECT
 AT THE TIME OF THE SUBMITTAL OF THIS PLAN.

~~TOWN CENTER DRIVE~~
~~VILLAGE CENTER CIRCLE~~

DATE: _____
 DRAWN BY: _____
 CHECKED BY: _____
 PROJECT NO.: _____



W.A.C. ENGINEERS, INC.
 1000 W. 10th Street
 Oklahoma City, Oklahoma 73106
 Phone: (405) 233-1111
 Fax: (405) 233-1112
 www.wac-engineers.com

PROJECT NO. T-3
 SHEET NO. T-3

SHEET NO. T-3

15-4-11