


JOB NO. 620.882

SEE SHEET ST-4
MATCH LINE=17+00

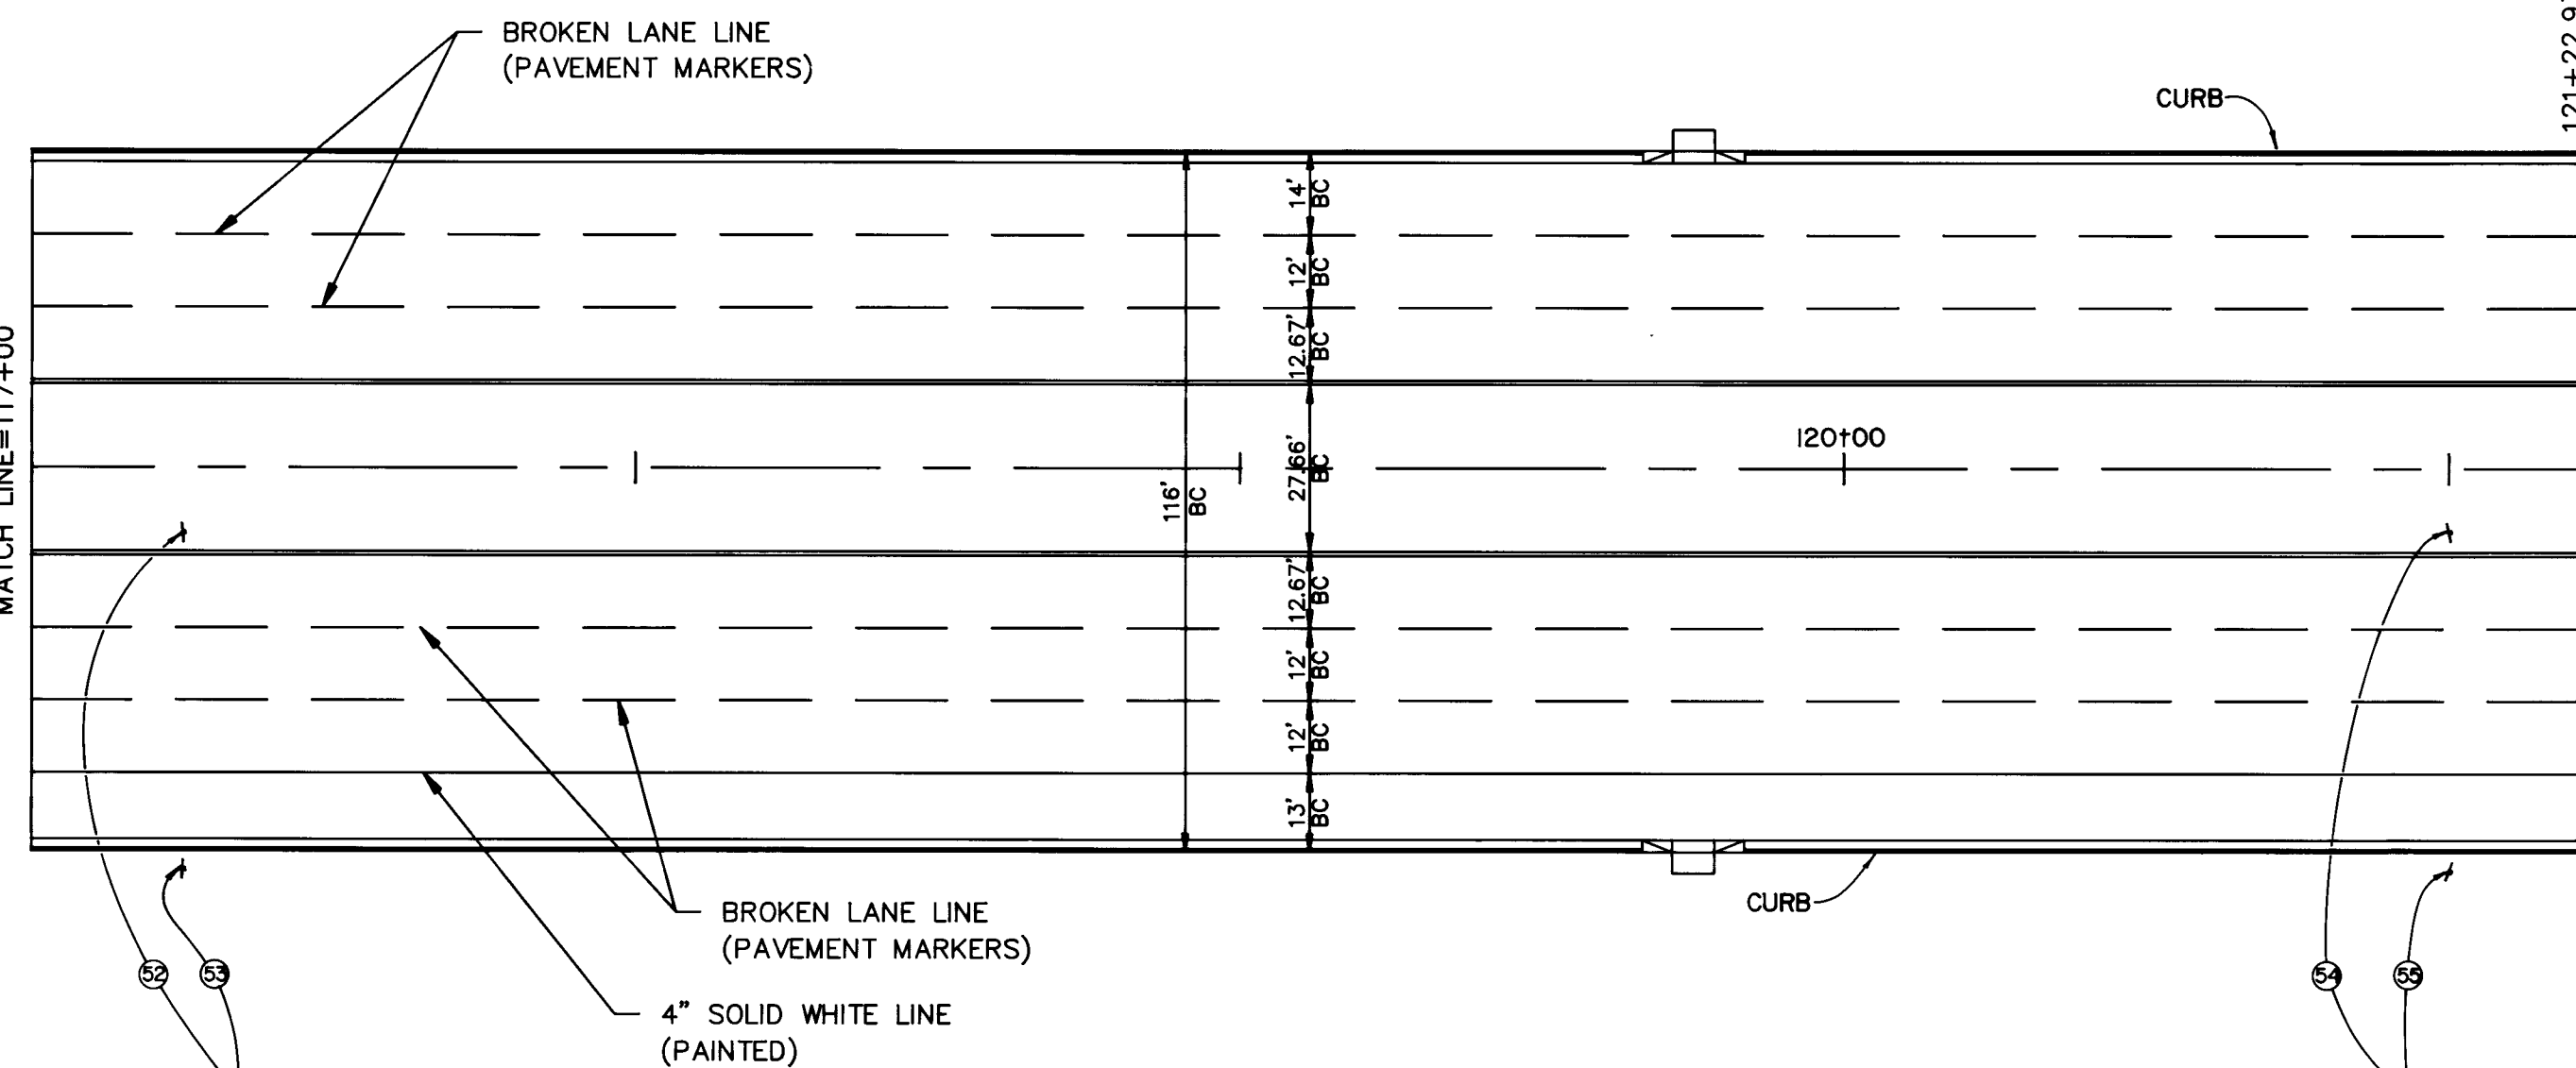

171+22.93
END CONSTRUCTION PHASE II
(SEE ON-SITE 'SUMMERLIN PARKWAY')

SPEED
35



RECORD DRAWINGS

THESE PLANS SHOW RECORD INFORMATION RECEIVED FROM:
 CONTRACTOR: WELLS CARGO INC.
 DATE: 6/19/90

THIS DATA MAY OR MAY NOT REFLECT THE ACTUAL FIELD LOCATIONS. ALL DATA SHOULD BE CONFIRMED PRIOR TO USE ON DEVELOPMENT OR ENGINEERING PLANS.

TOWN CENTER DRIVE

1"=30'

NOTE: THESE PLANS ARE FOR THE PURPOSE OF ROADWAY IMPROVEMENTS AND UTILITIES (PAVEMENT WITH BASE, CURB AND GUTTER, STORM DRAIN, WATER, SEWER, ETC.). ALL ROADWAY AND LANDSCAPE AREAS HAVE BEEN PREVIOUSLY ROUGH GRADED. ANY LIMITS OF ROUGH GRADING SHOWN ARE FOR REFERENCE ONLY. FOR SCOPE AND LIMITS OF ROUGH GRADING, SEE "TOWN CENTER DRIVE - ROUGH GRADING" PACKAGE. FOR FINISH GRADING OF LANDSCAPE AREAS, SEE LANDSCAPE PACKAGE BY SWA GROUP.

2/12/89

REV	DATE	DESCRIPTION
1	12/12/89	ISSUED FOR BID
2	2/12/90	ISSUED FOR CONSTRUCTION
3	4/12/90	ISSUED FOR RECORD DRAWINGS

PROJECT NO. 620.882
 SHEET NO. T-3
 OF 37 SHEETS

VILLAGE CENTER CIRCLE &
 HOWARD HUGHES PROPERTIES
 TOWN CENTER DRIVE PHASE II
 SIGNING AND STRIPINGS
 STA. 17+00 TO 181+88.93

G.C. WALLACE, INC.
 Engineering/Architecture
 1555 SOUTH RAINBOW BLVD. LAS VEGAS, NEVADA 89102

11-3-90 107-V1639-2

