


CHEYENNE AVENUE

OUTER PARKWAY

RECORD DRAWINGS  
THESE PLANS SHOW RECORD INFORMATION RECEIVED FROM:  
CONTRACTOR: WELLS CARGO INC.  
DATE: 8/18/88  
THIS DATA MAY OR MAY NOT REFLECT THE ACTUAL  
FIELD LOCATIONS. ALL DATA SHOULD BE CONFIRMED  
PRIOR TO USE ON DEVELOPMENT OR ENGINEERING  
PLANS.

DEL WEBB COMMUNITIES

DESERT SHORES

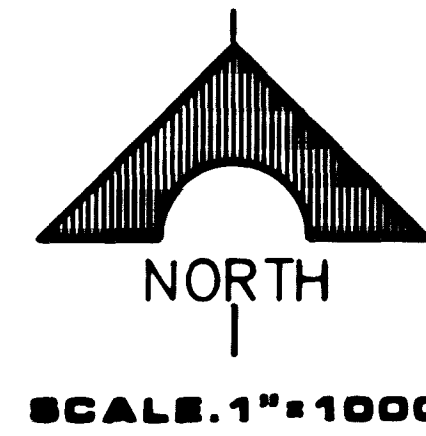

SMOKE RANCH ROAD

LUCE RES.

DRIVE

HIGHWAY

U. S. 95

GRAGSON

ORAN K.

RAINBOW BLVD.

WESTCLIFF DR.

SUMMERLIN PARKWAY

DURANGO DRIVE

ANGEL PARK

RAMPART BLVD.

NORTH ROUNDABOUT

VILLAGE CENTER CIRCLE

SOUTH ROUNDABOUT

HILLSHIRE DRIVE

VILLAGE 1 ROAD

LAKE MEAD

VILLAGE 1

VILLAGE 7

SHEET LAYOUT

TOWN CENTER DRIVE

HUALAPAI WAY

ANGEL PARK


**QUANTITIES**

|                                    |           |
|------------------------------------|-----------|
| ROADWAY FILL                       | 300 CY    |
| SCARIFY & RECOMPACT                | 43,800 SY |
| 4-1/2" ASPHALTIC CONCRETE PAVEMENT | 27,400 SY |
| 6" GRAVEL BASE                     | 27,400 SY |
| PRIME COAT, GRADE MC-70            | 27,400 SY |
| TACK COAT, GRADE SS-1H             | 27,400 SY |
| FOG SEAL, GRADE SS-1H OR CC5-1H    | 27,400 SY |
| 1" TYPE CURB & GUTTER              | 7,230 LF  |
| "A" TYPE CURB & GUTTER             | 210 LF    |
| ROLL TYPE ISLAND CURB & GUTTER     | 210 LF    |
| SPECIAL CURB & GUTTER              | 1,110 LF  |
| 10' CROSSWALK                      | 264 LF    |
| IRRIGATION SLEEVE                  | 180 LF    |
| INTERLOCKING PAVING BLOCKS         | 2,540 SY  |
| CONCRETE PEDESTRIAN MEDIAN BREAK   | 612 SF    |

NOTE: THESE PLANS ARE FOR THE PURPOSE OF ROADWAY IMPROVEMENTS AND UTILITIES (PAVEMENT WITH BASE, CURB AND GUTTER, STORM DRAIN, WATER, SEWER, ETC.). ALL ROADWAY AND LANDSCAPE AREAS HAVE BEEN PREVIOUSLY ROUGH GRADED. ANY LIMITS OF ROUGH GRADING SHOWN ARE FOR REFERENCE ONLY. FOR SCOPE AND LIMITS OF ROUGH GRADING, SEE "TOWN CENTER DRIVE - ROUGH GRADING" PACKAGE. FOR FINISH GRADING OF LANDSCAPE AREAS, SEE LANDSCAPE PACKAGE BY SMA GROUP.

**LIST OF DRAWINGS**

| SHEET | TITLE                                      |
|-------|--------------------------------------------|
| I-0   | KEY MAP, VICINITY MAP AND LIST OF DRAWINGS |
| I-1   | PLAN & PROFILE NORTH ROUNDABOUT            |
| I-2   | PLAN & PROFILE STA. 49+00 TO 40+50         |
| I-3   | PLAN & PROFILE STA. 40+50 TO 32+00         |
| I-4   | PLAN & PROFILE SOUTH ROUNDABOUT            |
| I-5   | PLAN & PROFILE STA. 117+00 TO 121+22.93    |
| I-6   | GEOMETRICS - NORTH ROUNDABOUT              |
| I-7   | GEOMETRICS - SOUTH ROUNDABOUT              |
| I-8   | TOP OF CURB PROFILES NORTH ROUNDABOUT      |
| I-9   | TOP OF CURB PROFILES SOUTH ROUNDABOUT      |
| I-10  | STREET SECTIONS                            |
| I-11  | SPECIAL DETAILS                            |
| I-12  | NORTH AND SOUTH ROUNDABOUT POINT DATA      |

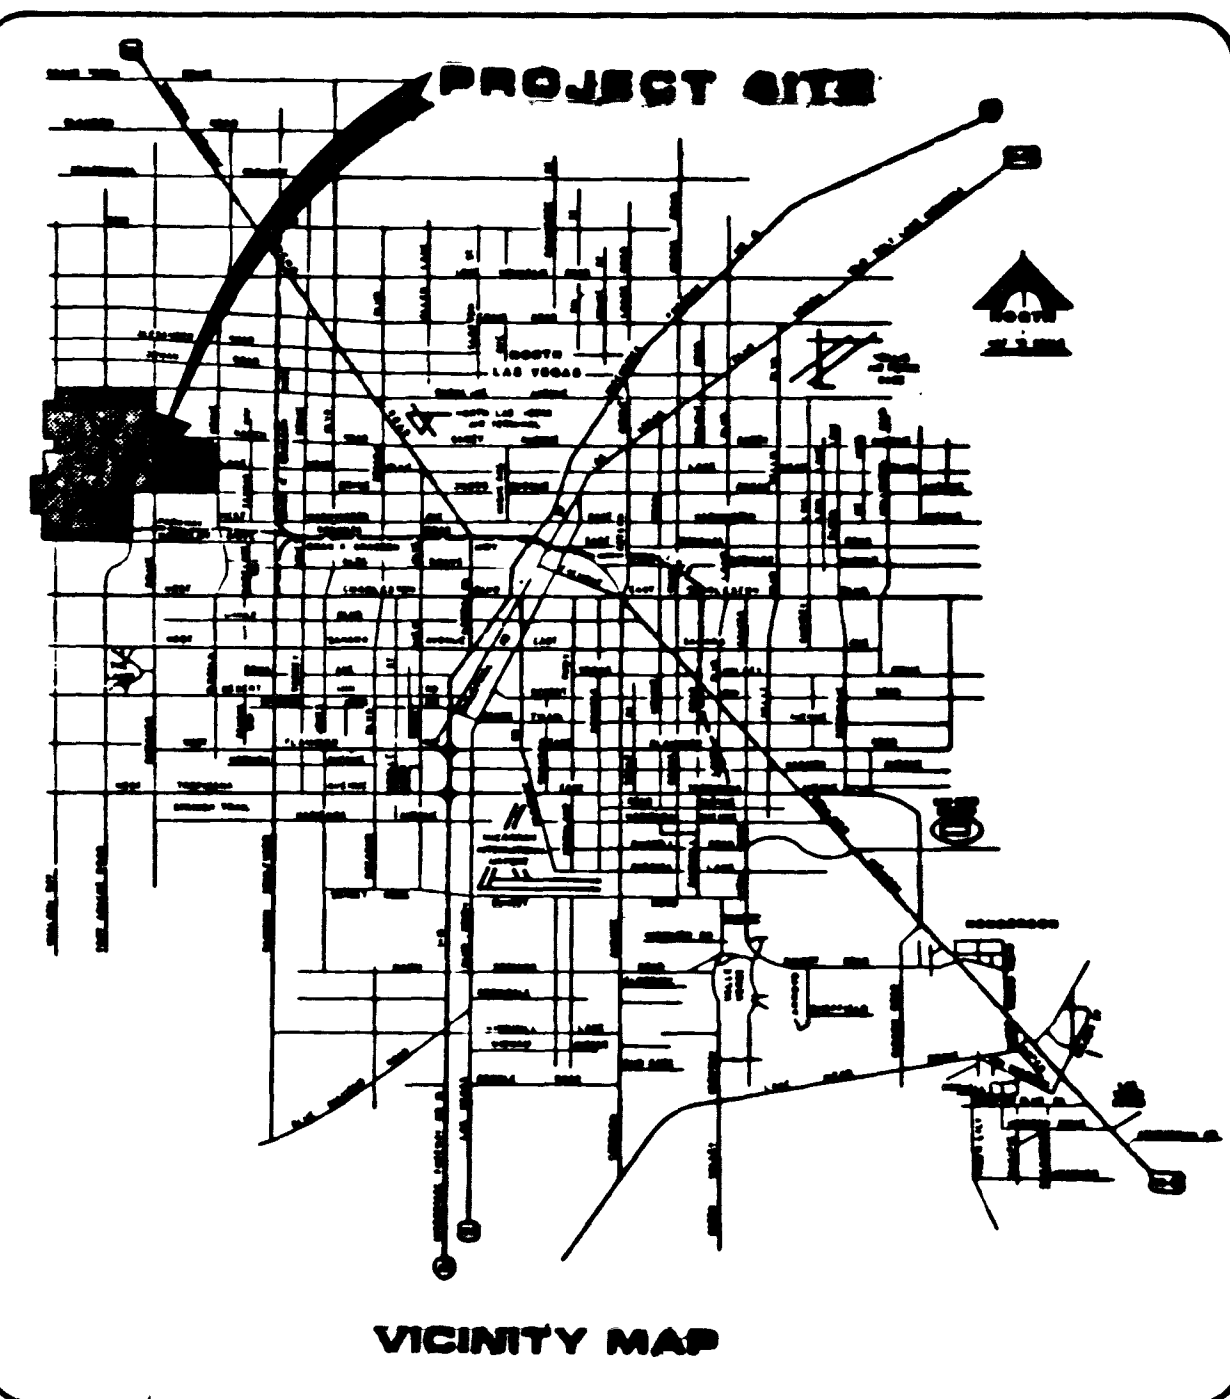

VICINITY MAP

| REV | DATE    | DESCRIPTION                 |
|-----|---------|-----------------------------|
| 1   | 8/18/88 | ISSUED FOR BID              |
| 2   | 8/18/88 | REVISED FOR CONSTRUCTION    |
| 3   | 8/18/88 | REVISED FOR RECORD DRAWINGS |

G.C. WALLACE, INC.  
Engineering/Architecture

VILLAGE CENTER CIRCLE &  
HOWARD HUGHES PROPERTIES  
TOWN CENTER DRIVE PHASE II  
KEY MAP, VICINITY MAP  
AND LIST OF DRAWINGS

SHEET 3  
I-0

2/12/89 OF 37 SHEETS

JOB NO. 820.282

BIM DIETRICH POST 65328

1977

11-5-46

107-V1034-2

CHEYENNE AVENUE

PARKWAY

OUTER

HUALAPAI WAY

SHEET LAYOUT

VILLAGE 7

DEL WEBB COMMUNITIES

SUN CITY

SUMMERLIN

LAKE MEAD

DESERT SHORES

SMOKE RANCH ROAD

DRIVE

HIGHWAY

BLVD.

VILLAGE 11

VILLAGE CENTER CIRCLE

VEGAS DRIVE

BUFFALO

GRASSON

U. S. 95

TOWN CENTER DRIVE

RAMPART BLVD.

ANGELO PARK

DURANGO DRIVE

SUMMERLIN PARKWAY

VERMONT BL.

MAISON

ANGEL PARK



SCALE 1" = 1/4 MILE

