


CURVE	RADIUS	LENGTH	TANGENT	DELTA
C1	861.00	655.63	344.63	43°37'45"
C2	834.33	858.58	471.86	58°57'38"
C3	828.00	850.00	468.95	58°57'38"
C4	817.67	841.42	462.24	58°57'38"
C5	781.00	813.98	447.17	58°57'38"
C6	500.00	41.88	21.02	08°00'25"
C7	300.00	85.92	43.28	16°24'34"
C8	873.00	105.69	52.91	06°56'12"
C10	5.00	7.74	4.88	88°39'02"
C11	5.00	7.74	4.88	88°39'02"

NOTE: THESE PLANS ARE FOR THE PURPOSE OF ROADWAY IMPROVEMENT AND UTILITIES (PAVEMENT WITH BASE, CURB AND GUTTER, STORM DRAIN, WATER, SEWER, ETC.). ALL ROADWAY AND LANDSCAPE AREAS HAVE BEEN PREVIOUSLY ROUGH GRADED. ANY LIMITS OF ROUGH GRADING SHOWN ARE FOR REFERENCE ONLY. FOR SCOPE AND LIMITS OF ROUGH GRADING, SEE "TOWN CENTER DRIVE - ROUGH GRADING" PACKAGE. FOR FINISH GRADING OF LANDSCAPE AREAS, SEE LANDSCAPE PACKAGE BY SWA GROUP.

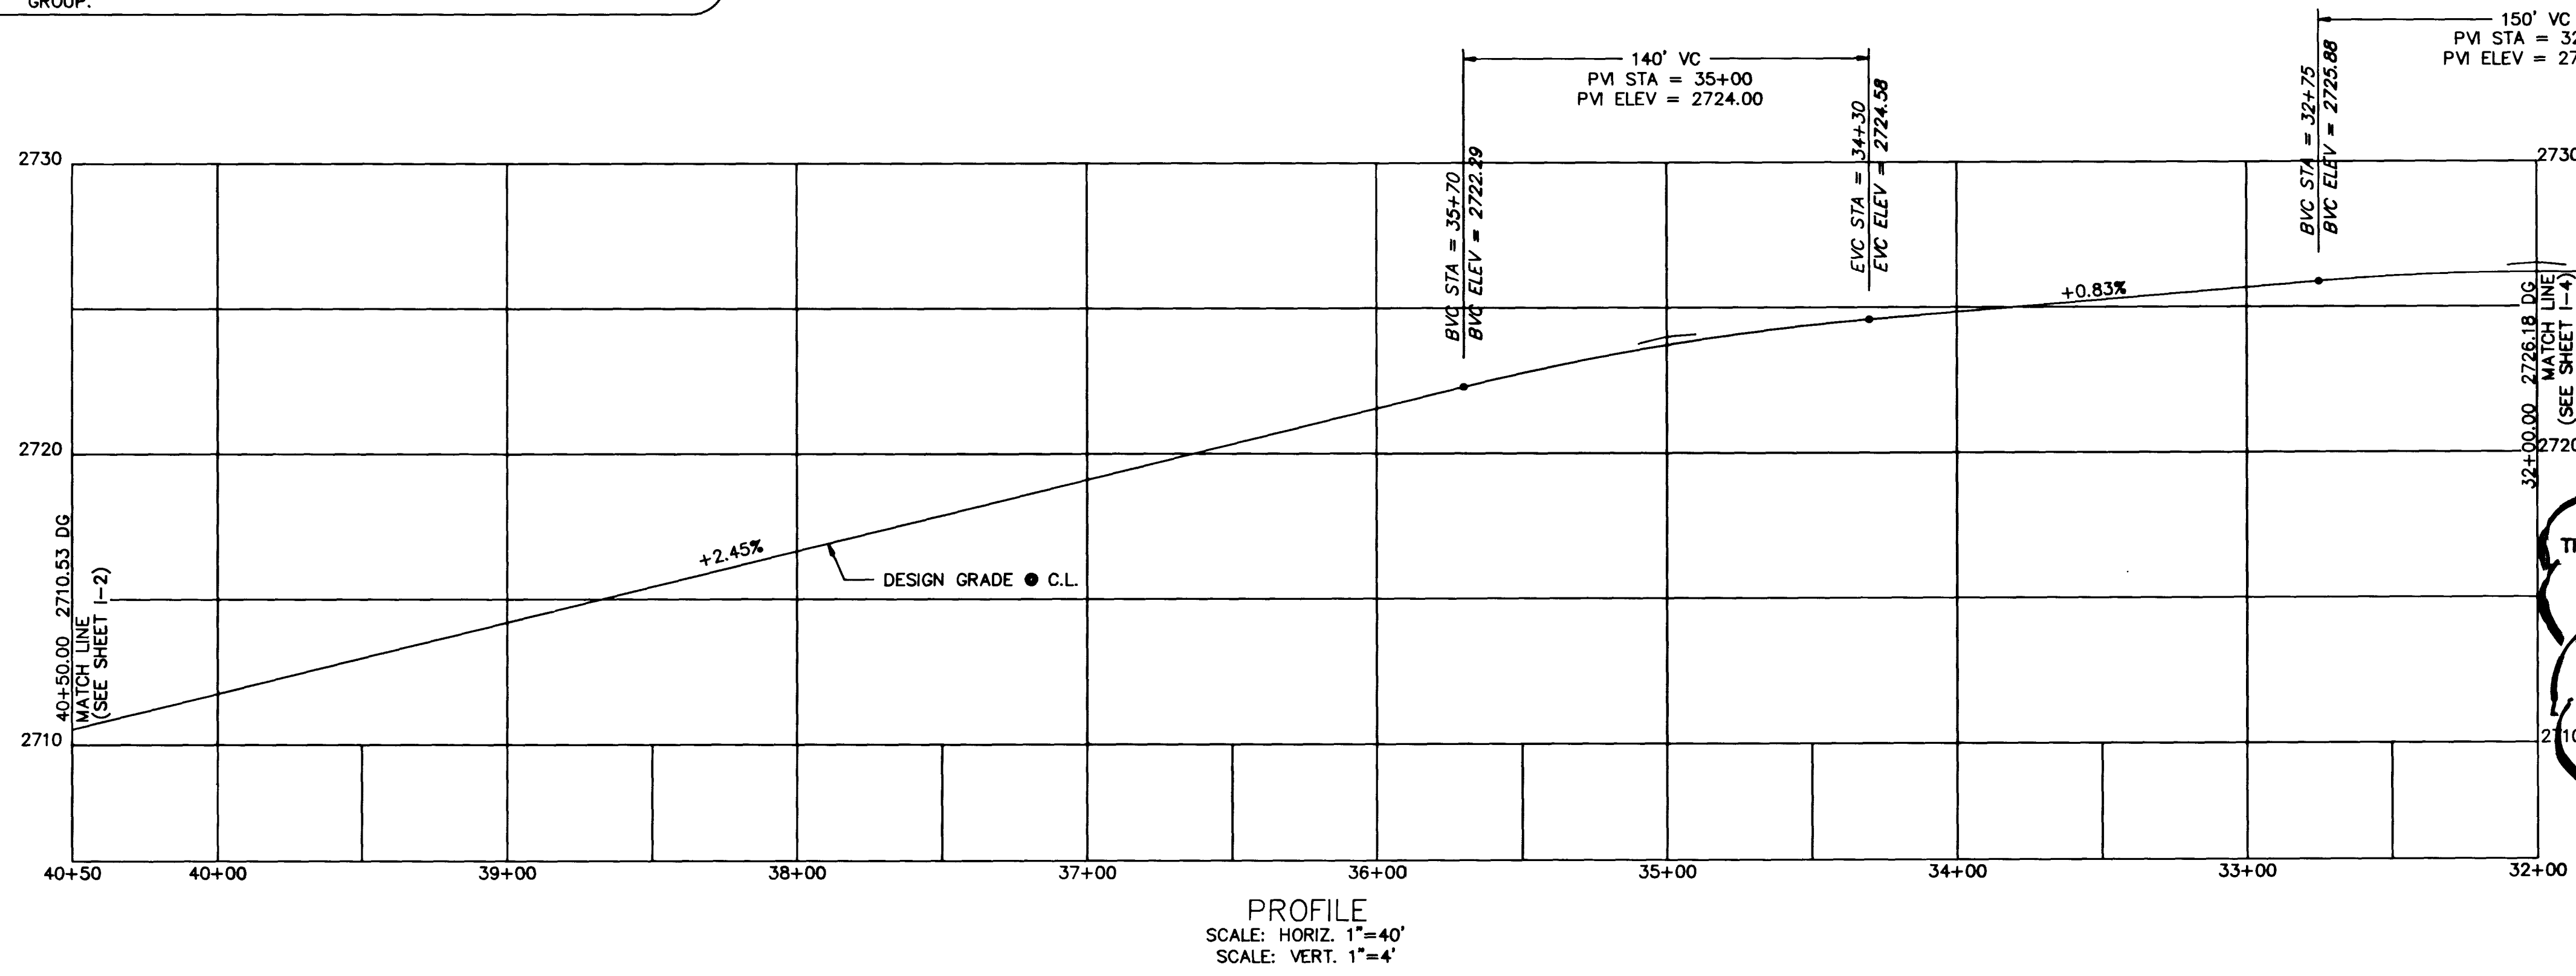

VILLAGE CENTER CIRCLE
TOWN CENTER DRIVE
1"=40'

RECORD DRAWINGS
THESE PLANS SHOW RECORD INFORMATION RECEIVED FROM:
CONTRACTOR: **WELLS CARGO INC.**
DATE: **6/18/89**
THIS DATA MAY OR MAY NOT REFLECT THE ACTUAL FIELD LOCATIONS. ALL DATA SHOULD BE CONFIRMED PRIOR TO USE ON DEVELOPMENT OR ENGINEERING PLANS.

REVISIONS

REV	DATE	DESCRIPTION
1	02/18/89	ISSUED FOR BID
2	07/18/89	REVISED FOR CONSTRUCTION
3	08/18/89	REVISED FOR RECORD DRAWINGS

DESIGNED BY: [Signature]
CHECKED BY: [Signature]
DATE: 08/18/89
SCALE: 1"=40'

STATE OF NEVADA
CIVIL

G.C. WALLACE, INC.
Engineering/Architecture
1555 SOUTH RAINBOW BLVD., LAS VEGAS, NEVADA 89102

VILLAGE CENTER CIRCLE & TOWN CENTER DRIVE PHASE II
PLAN & PROFILE
STA. 40+50 TO 32+00


SHEET 6
OF 27 SHEETS

2/12/89

JOB NO. 55000000


1974

11-349 107-V1639-2

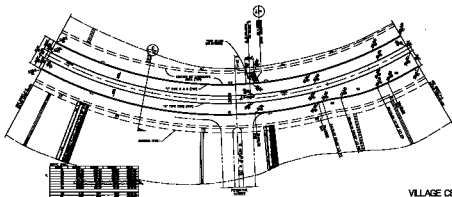

**VILLAGE CENTER CIRCLE
TOWN CENTER DRIVE**

NOTE: ALL DIMENSIONS ARE IN FEET AND INCHES. DIMENSIONS ARE GIVEN TO THE CENTERLINE OF THE ROAD UNLESS OTHERWISE NOTED. ALL DIMENSIONS ARE TO BE MAINTAINED THROUGHOUT THE PROJECT.

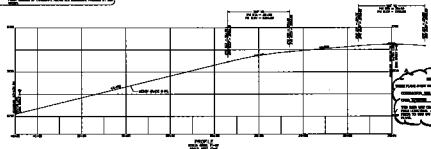

NOTE: THE PROFILE OF THE ROAD IS TO BE MAINTAINED THROUGHOUT THE PROJECT. ALL DIMENSIONS ARE TO BE MAINTAINED THROUGHOUT THE PROJECT.

PROJECT NO. 11-3-97
 DRAWING NO. 11-3-97-01
 DATE: 11-3-97
 SCALE: AS SHOWN
 DESIGNED BY: [Name]
 CHECKED BY: [Name]
 APPROVED BY: [Name]
 ENGINEER: [Name]
 CIVIL ENGINEER
 STATE OF TEXAS
 LICENSE NO. [Number]

11-3-97

11-3-97

11-3-97

11-3-97