



RECORD DRAWINGS
THESE PLANS SHOW RECORD INFORMATION RECEIVED FROM:
CONTRACTOR: WELLS CARGO INC.
DATE: 6/19/90
THIS DATA MAY OR MAY NOT REFLECT THE ACTUAL
FIELD LOCATIONS. ALL DATA SHOULD BE CONFIRMED
PRIOR TO USE ON DEVELOPMENT OR ENGINEERING
PLANS.

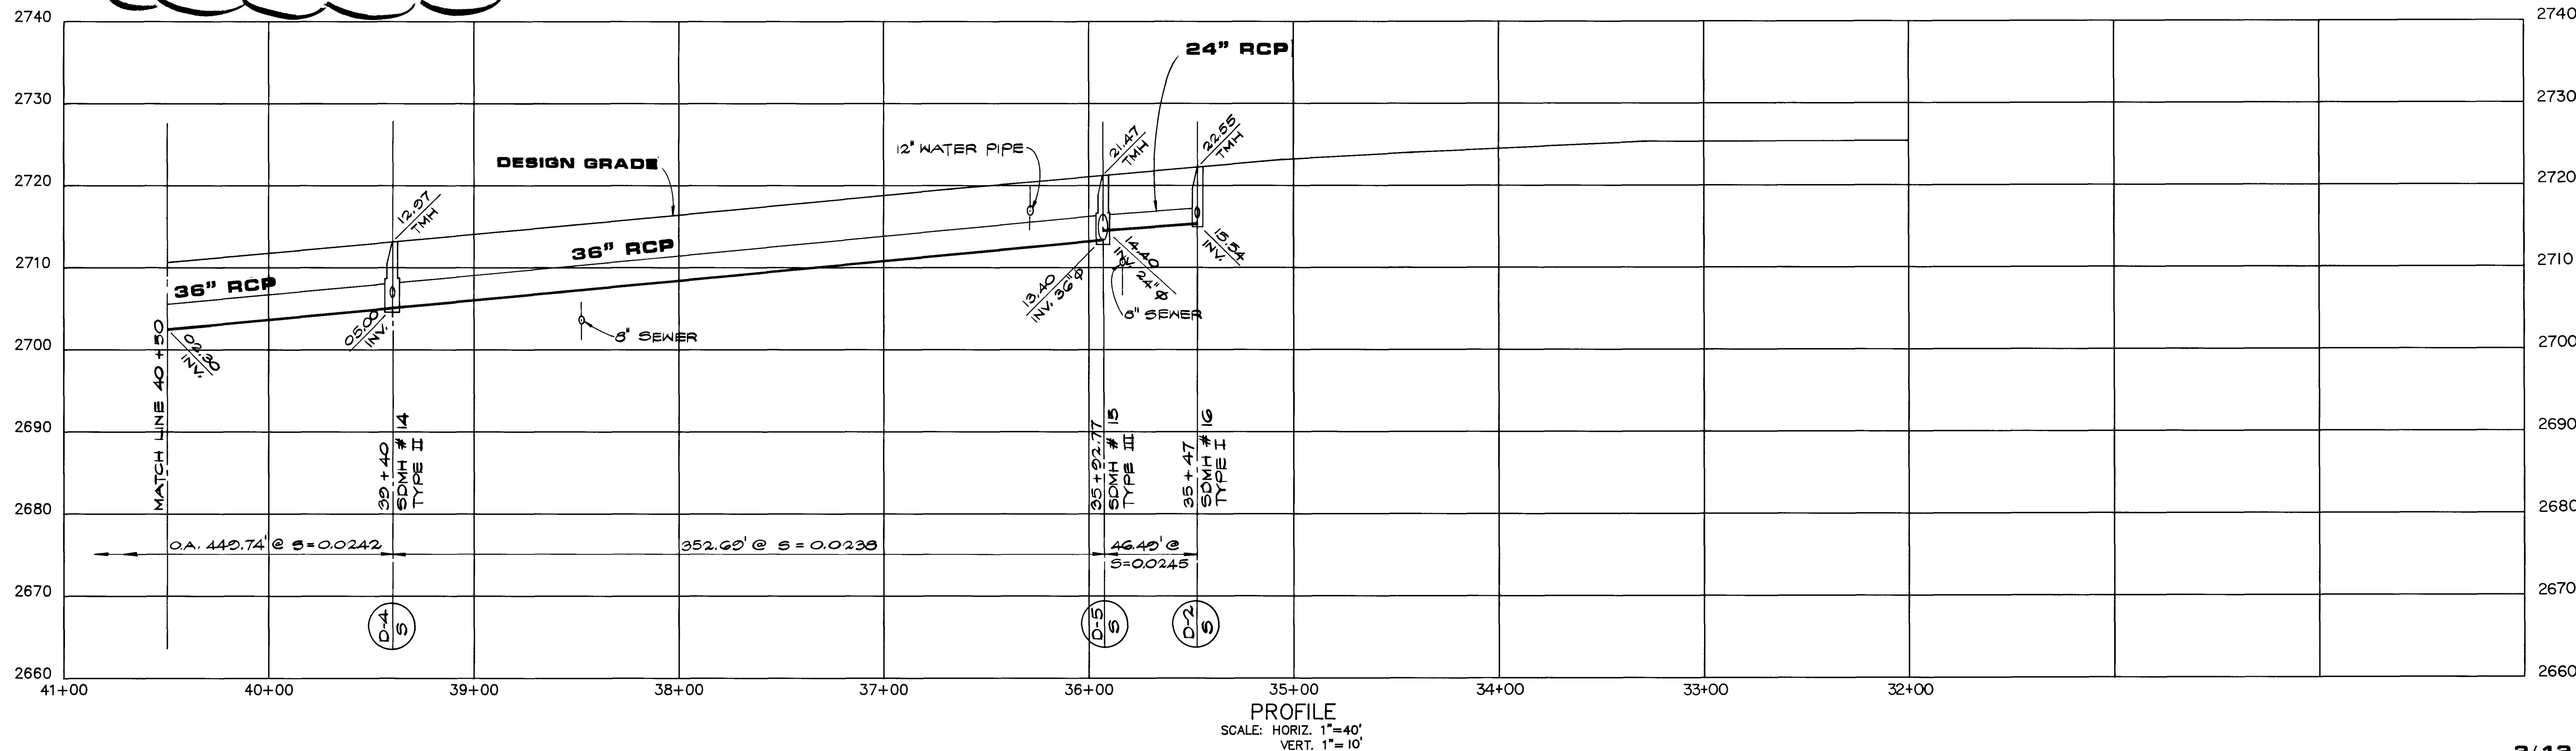

CURVE	RADIUS	LENGTH	TANGENT	DELTA
(1)	839.00'	111.73'	53.94'	07°37'48"
(2)	839.00'	352.70'	178.99'	24°05'10"
(3)	839.00'	46.48'	23.24'	03°10'28"
(4)	828.00'	850.00'	466.95'	58°57'38"

NOTE: THESE PLANS ARE FOR THE PURPOSE OF ROADWAY IMPROVEMENTS AND UTILITIES (PAVEMENT WITH BASE, CURB AND GUTTER, STORM DRAIN, WATER, SEWER, ETC.). ALL ROADWAY AND LANDSCAPE AREAS HAVE BEEN PREVIOUSLY ROUGH GRADED. ANY LIMITS OF ROUGH GRADING SHOWN ARE FOR REFERENCE ONLY. FOR SCOPE AND LIMITS OF ROUGH GRADING, SEE "TOWN CENTER DRIVE - ROUGH GRADING" PACKAGE. FOR FINISH GRADING OF LANDSCAPE AREAS, SEE LANDSCAPE PACKAGE BY SWA GROUP.

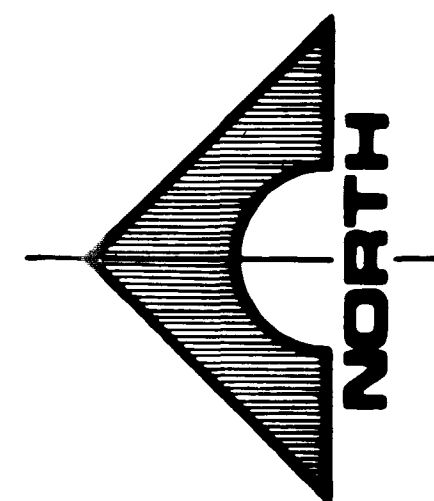

REV	DATE	DESCRIPTION
1	12/12/89	ISSUED FOR BID
2	01/11/90	ISSUED FOR CONSTRUCTION
3	06/19/90	RECORD DRAWINGS

1555 SOUTH RAINBOW BLVD. LAS VEGAS, NEVADA 89102

G.C. WALLACE, INC.
Engineering/Architecture

VILLAGE CENTER CIRCLE &
HOWARD HUGHES PROPERTIES
TOWN CENTER DRIVE PHASE II
STORM DRAIN PLAN & PROFILE
STA. 40+50.00 TO 32+00.00

SHEET 13
SD-3
OF 37 SHEETS

2/12/89

117-152 107-V1689-2

