

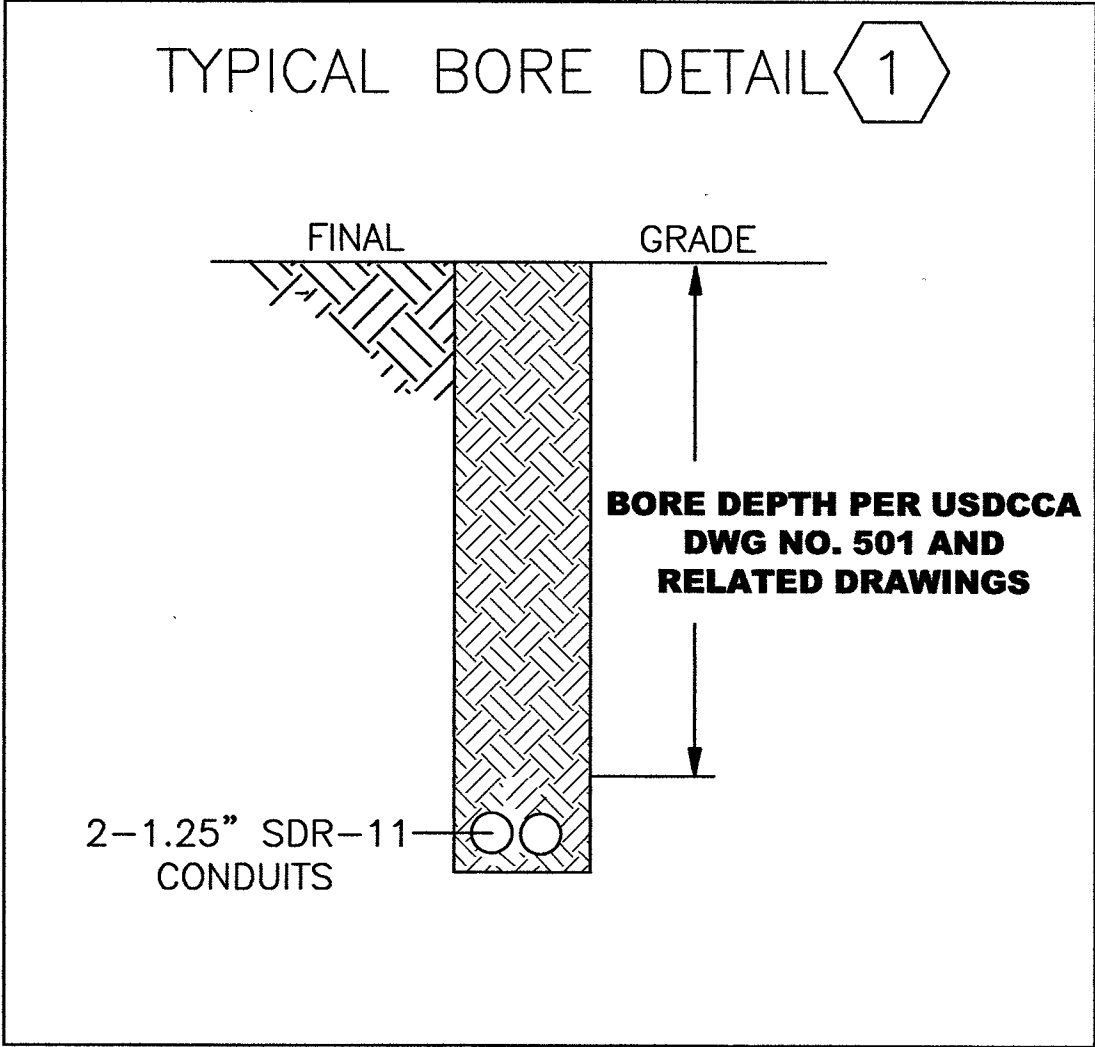
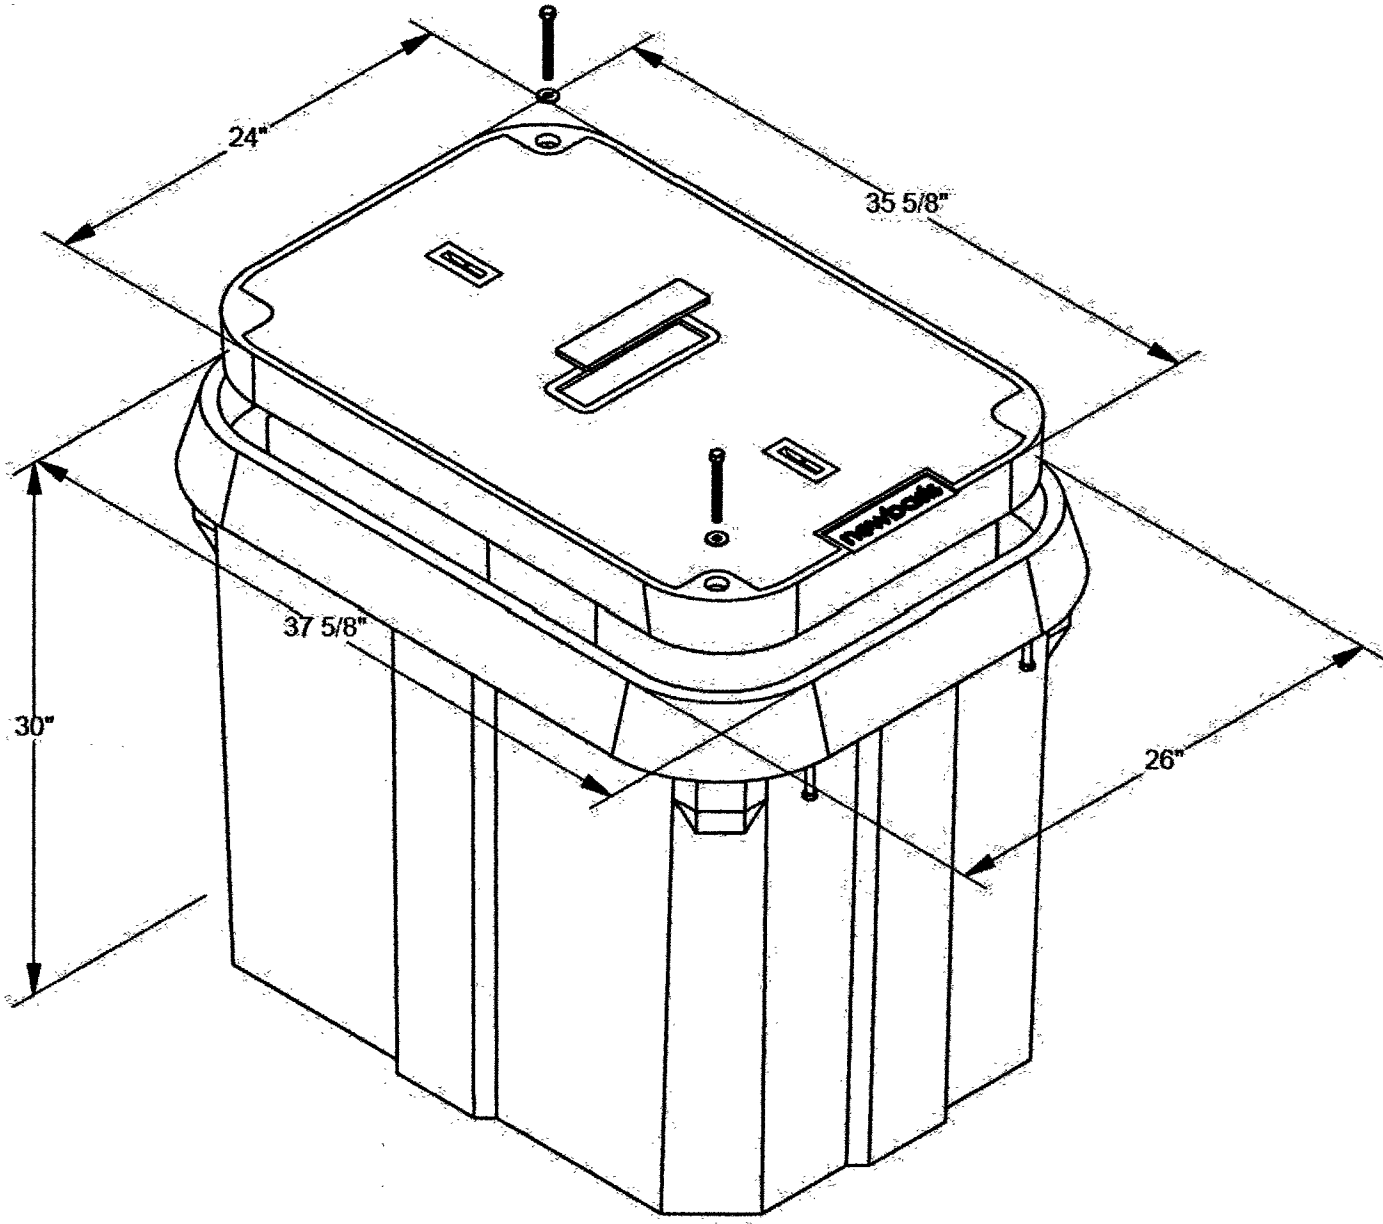
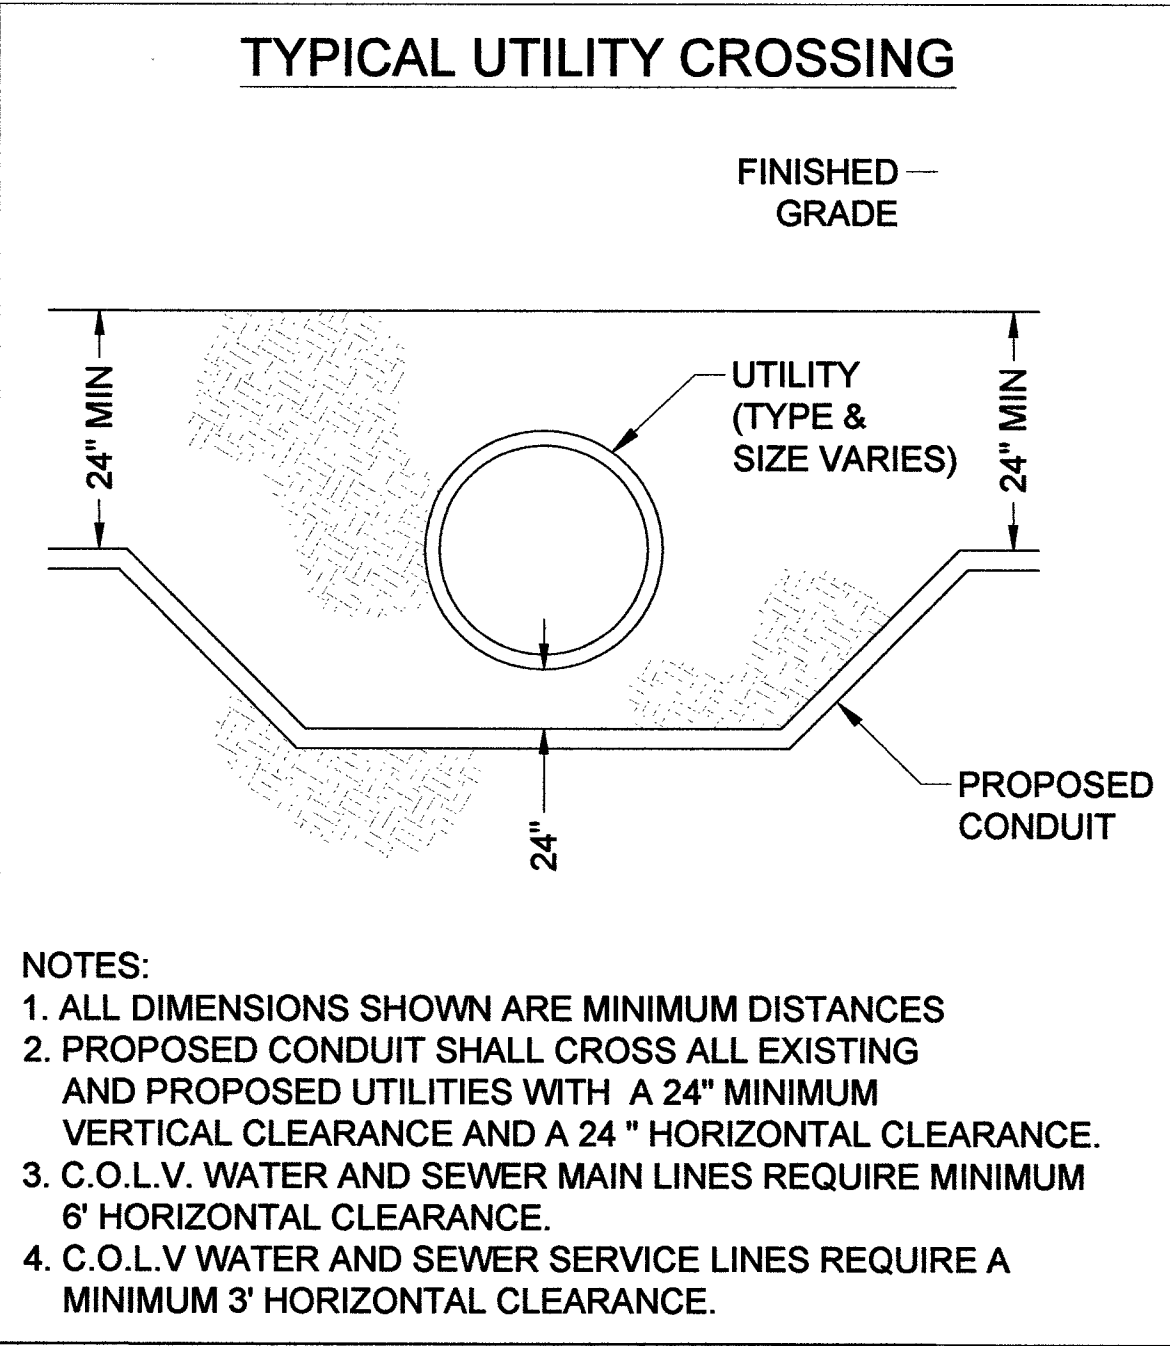


THIS PROJECT REQUIRES:		
DESCRIPTION	QUANTITY	UNITS
BORE (2) 1.25" SDR-11 CONDUITS	453	FT
TRENCH (2) 1.25" SDR-11 CONDUITS	47	FT
TRENCH (1) 4" SDR-11 CONDUIT	21	FT
TRENCH (1) 2" SDR-11 CONDUIT	0	FT
90° BEND	2	EA
45° BEND	2	EA
BORE PIT - 4'x4'	2	EA
17"x30"x18" HAND HOLE	2	EA
24"x36"x30" HAND HOLE	1	EA
30"x48"x30" HAND HOLE	2	EA


****NOTE****
ALL CONSTRUCTION AND MATERIAL SHALL BE IN ACCORDANCE WITH THE "UNIFORM STANDARD SPECIFICATIONS FOR PUBLIC WORKS CONSTRUCTION OFF-SITE IMPROVEMENTS, CLARK COUNTY AREA NEVADA", LATEST ISSUE; THE "UNIFORM STANDARD DRAWINGS FOR PUBLIC WORKS CONSTRUCTION, CLARK COUNTY AREA NEVADA", LATEST ISSUE; AND OTHER APPLICABLE APPROVED STANDARDS ISSUED BY THE CONTROLLING AGENCY; ALL LOCAL CITY CODES AND ORDINANCES APPLICABLE

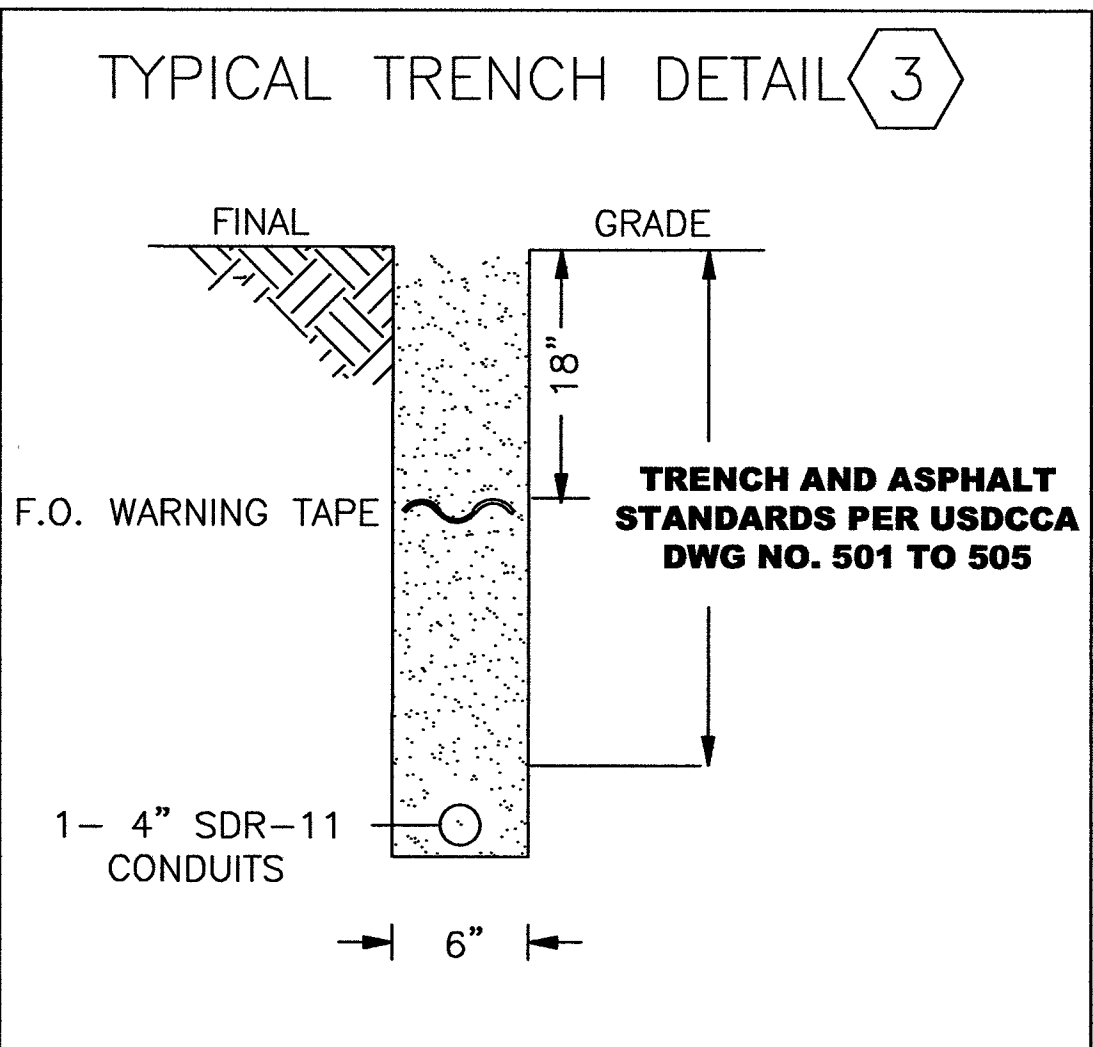


****NOTE****
DIRECTIONAL BORE DEPTH WITH +/- 10% VARIANCE

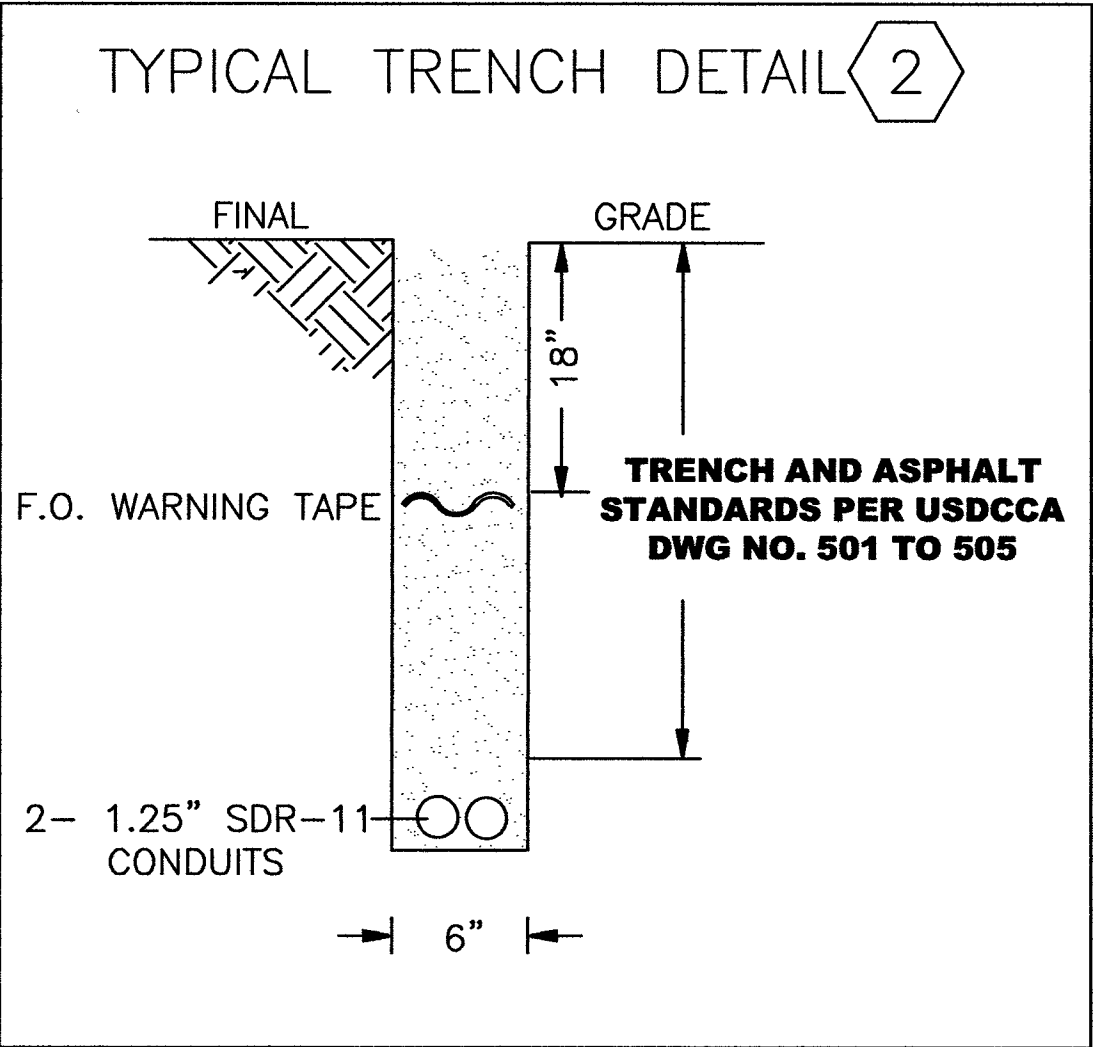

PCA243630-00006
 POLYMER CONCRETE ASSEMBLY
 24"x36"x30"

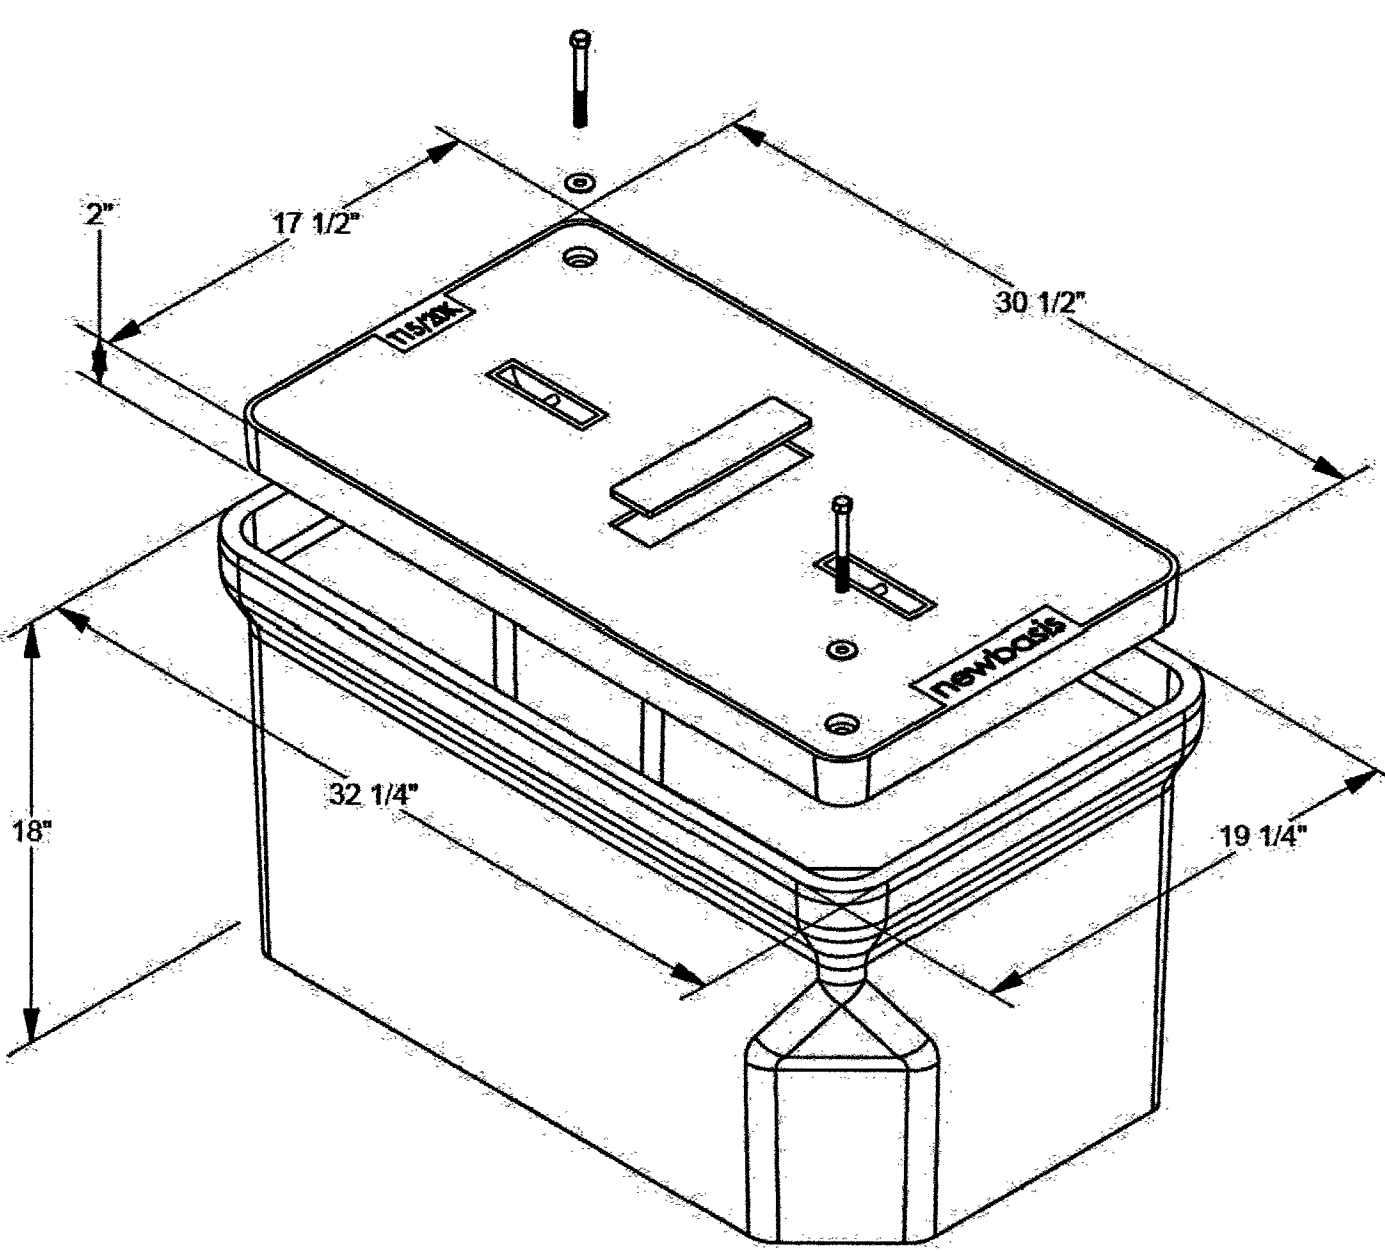

PCA173018-00006
 POLYMER CONCRETE ASSEMBLY
 17"x30"x18"

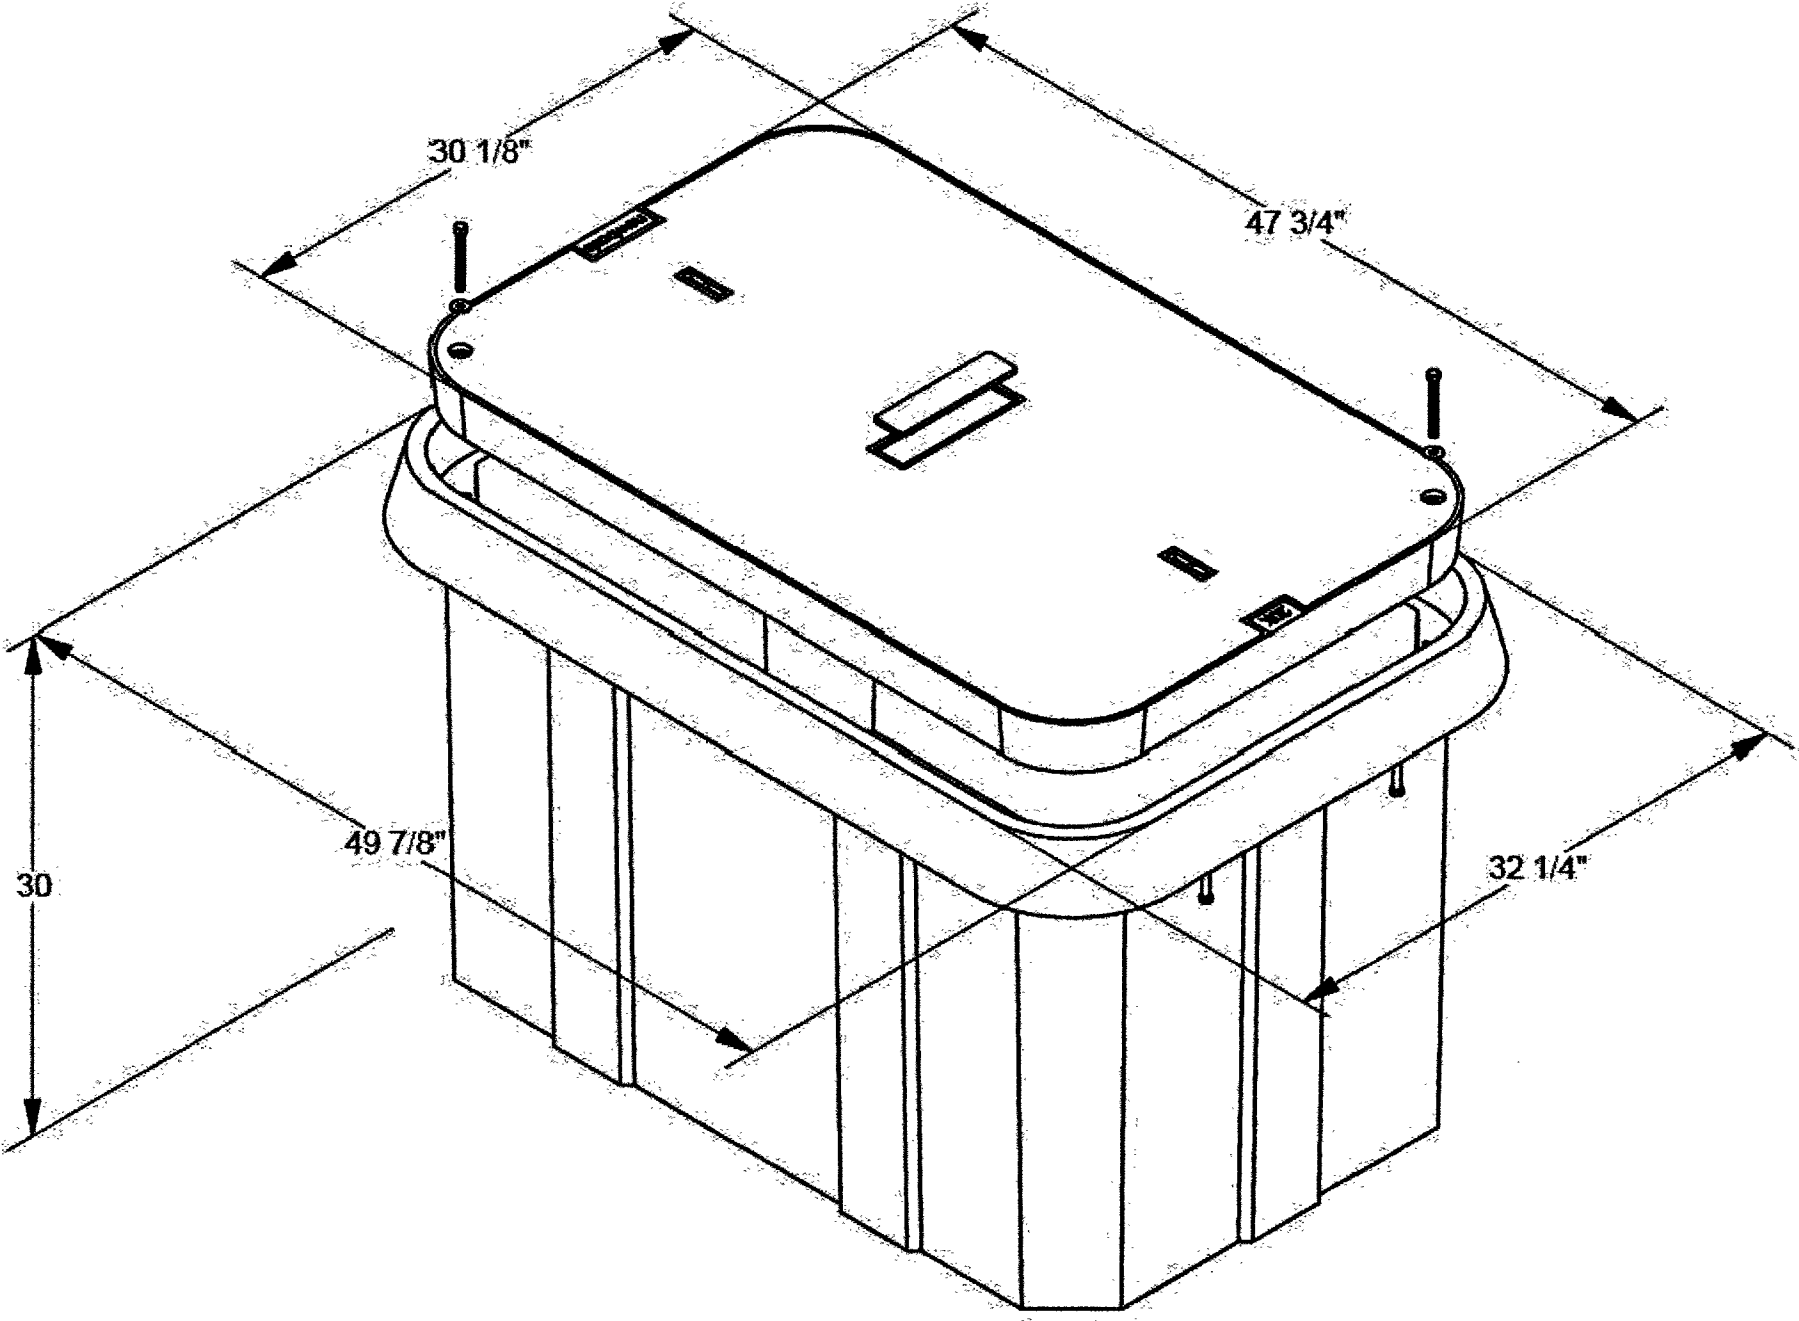



PCA304830-00012
 POLYMER CONCRETE ASSEMBLY
 30"x48"x30"




3	-	-	-	AS-BUILT
2	10/15/15	TT	MF	REVISION # 1
1	8/12/15	TT	MF/JA	ORIGINAL
NO.	DATE	ENG DESIGN	DRAFTING	COMMENT
PROJECT ENGINEER: RICHARD ALGERIA 602-576-0951				
ENGINEERING FIRM: TETRA TECH				
PROJECT NUMBER: 126-40-45353				
LOCATION: SUMMERLIN, NEVADA				
DRAWING NAME: 126-40-45353 - SUMMERLIN NEVADA - VEGAS.dwg				
CONFIDENTIAL/PROPRIETARY				




THIS SHEET REQUIRES:		
DESCRIPTION	QUANTITY	UNITS
BORE (2) 1.25" SDR-11 CONDUITS	102	FT
TRENCH (2) 1.25" SDR-11 CONDUITS	47	FT
TRENCH (1) 4" SDR-11 CONDUIT	8	FT
TRENCH (1) 2" SDR-11 CONDUIT		FT
90° BEND	2	EA
45° BEND		EA
BORE PIT - 4x4'	1	EA
17"x30"x18" HAND HOLE	1	EA
24"x36"x30" HAND HOLE		EA
30"x48"x30" HAND HOLE	1	EA

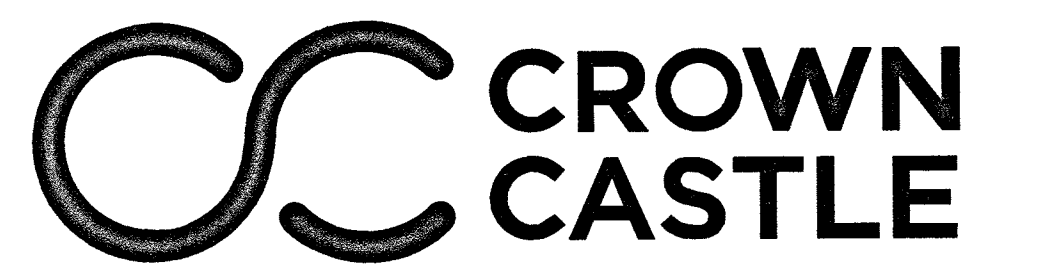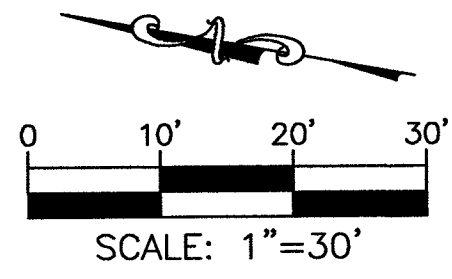


3	-	-	-	AS-BUILT
2	10/15/15	TT	MF	REVISION # 1
1	8/12/15	TT	MF/JA	ORIGINAL
NO.	DATE	ENG DESIGN	DRAFTING	COMMENT
PROJECT ENGINEER: RICHARD ALGERIA 602-576-0951				
ENGINEERING FIRM: TETRA TECH				
PROJECT NUMBER: 126-40-45353				
LOCATION: SUMMERLIN, NEVADA				
DRAWING NAME: 126-40-45353 - SUMMERLIN NEVADA - VEGAS.dwg				
CONFIDENTIAL/PROPRIETARY			SHEET: 3 OF 4	

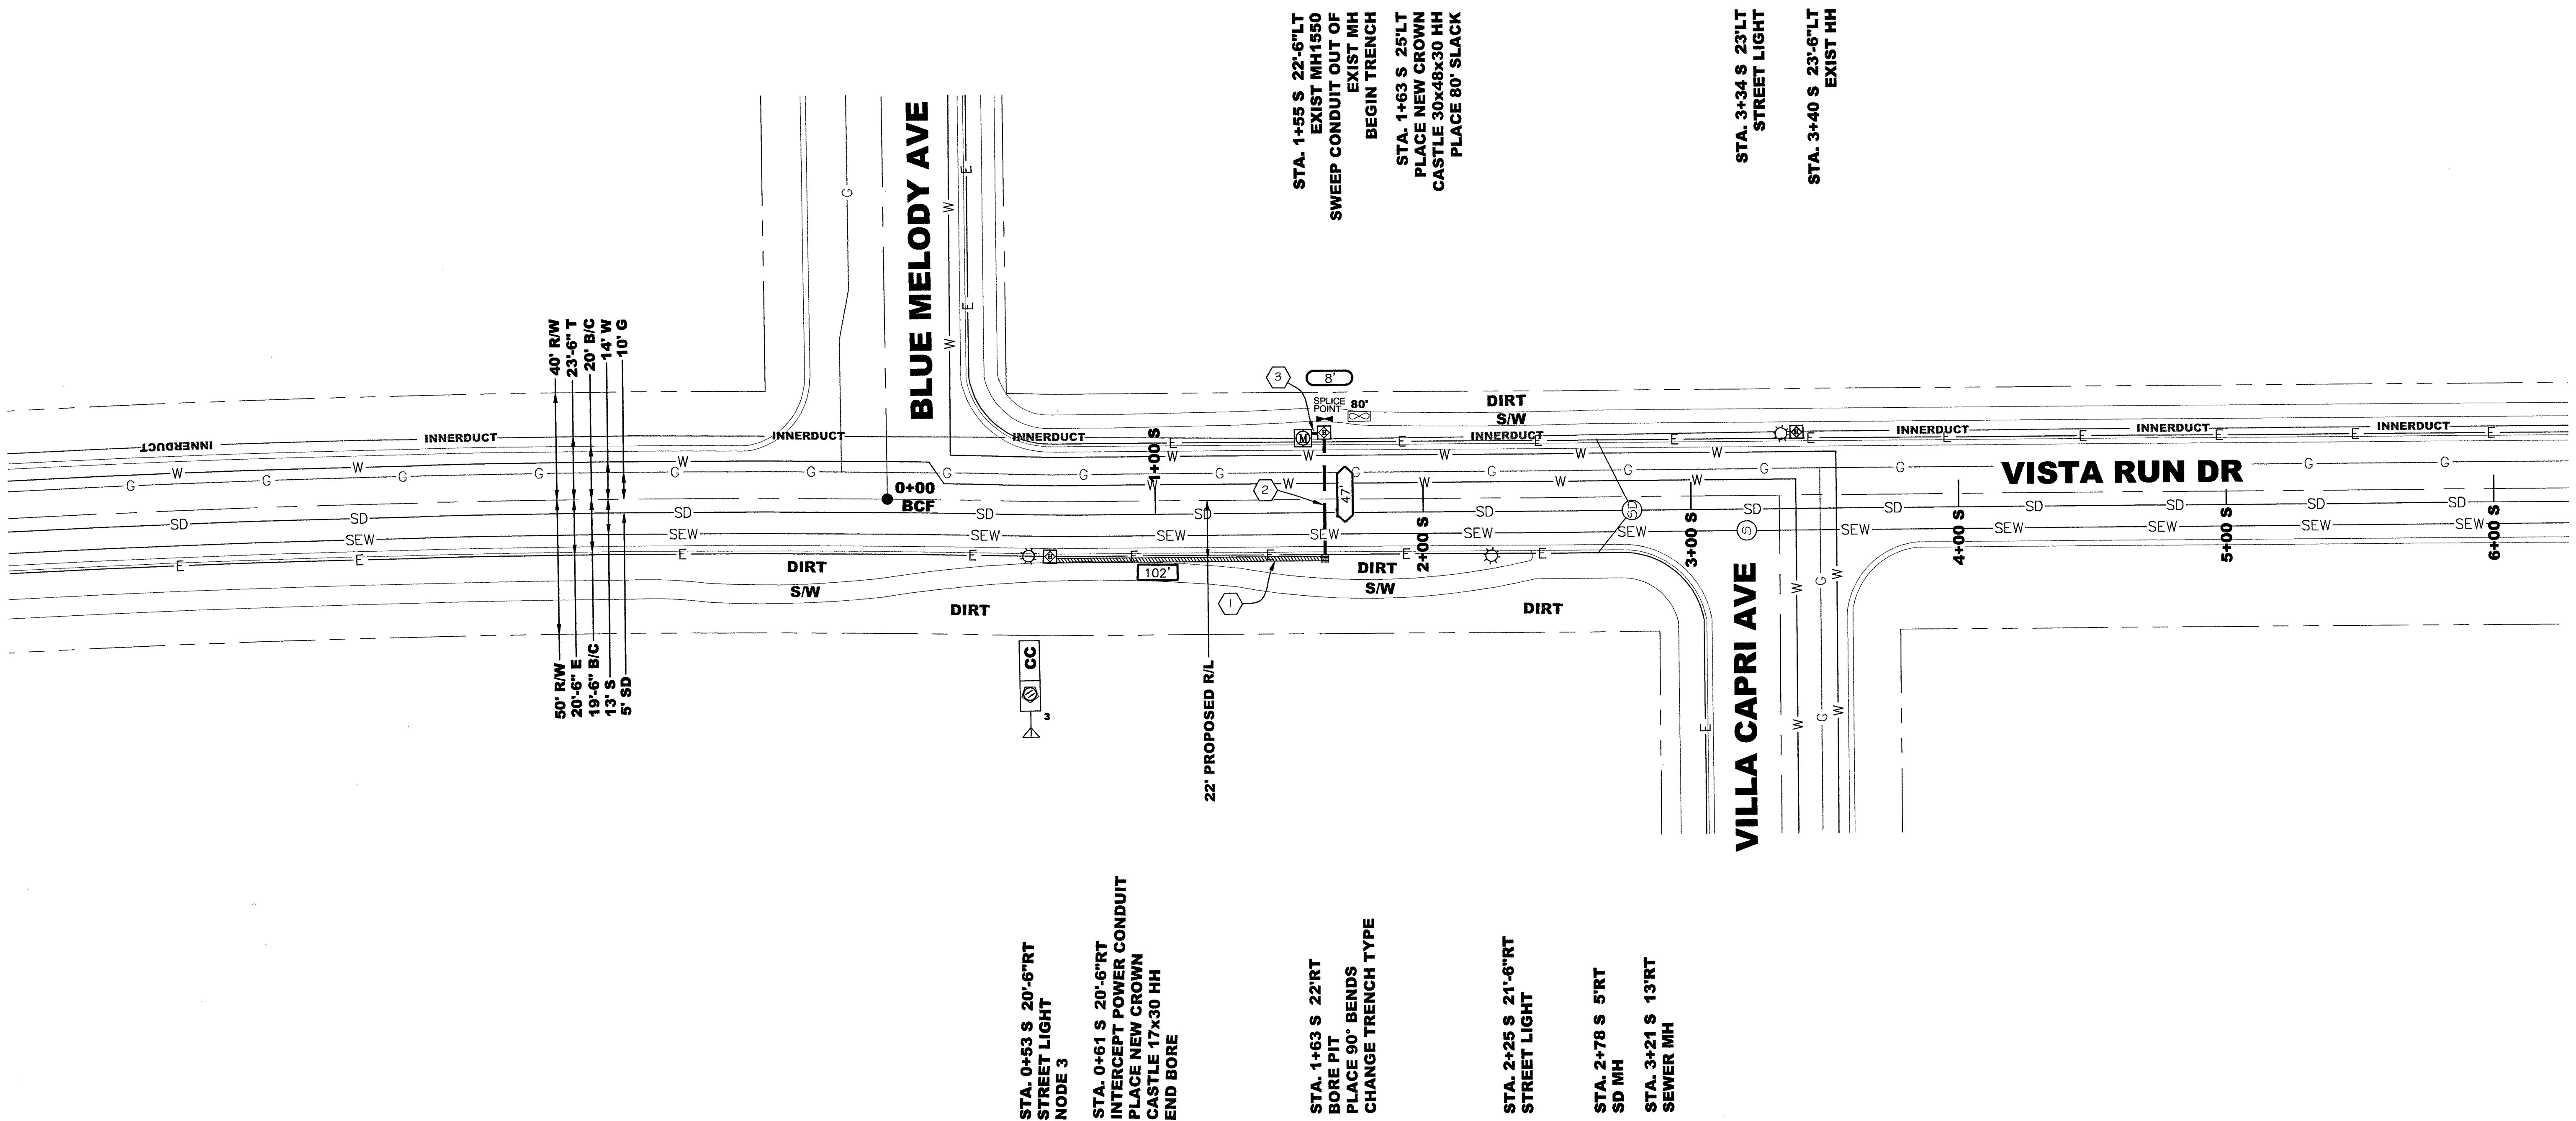

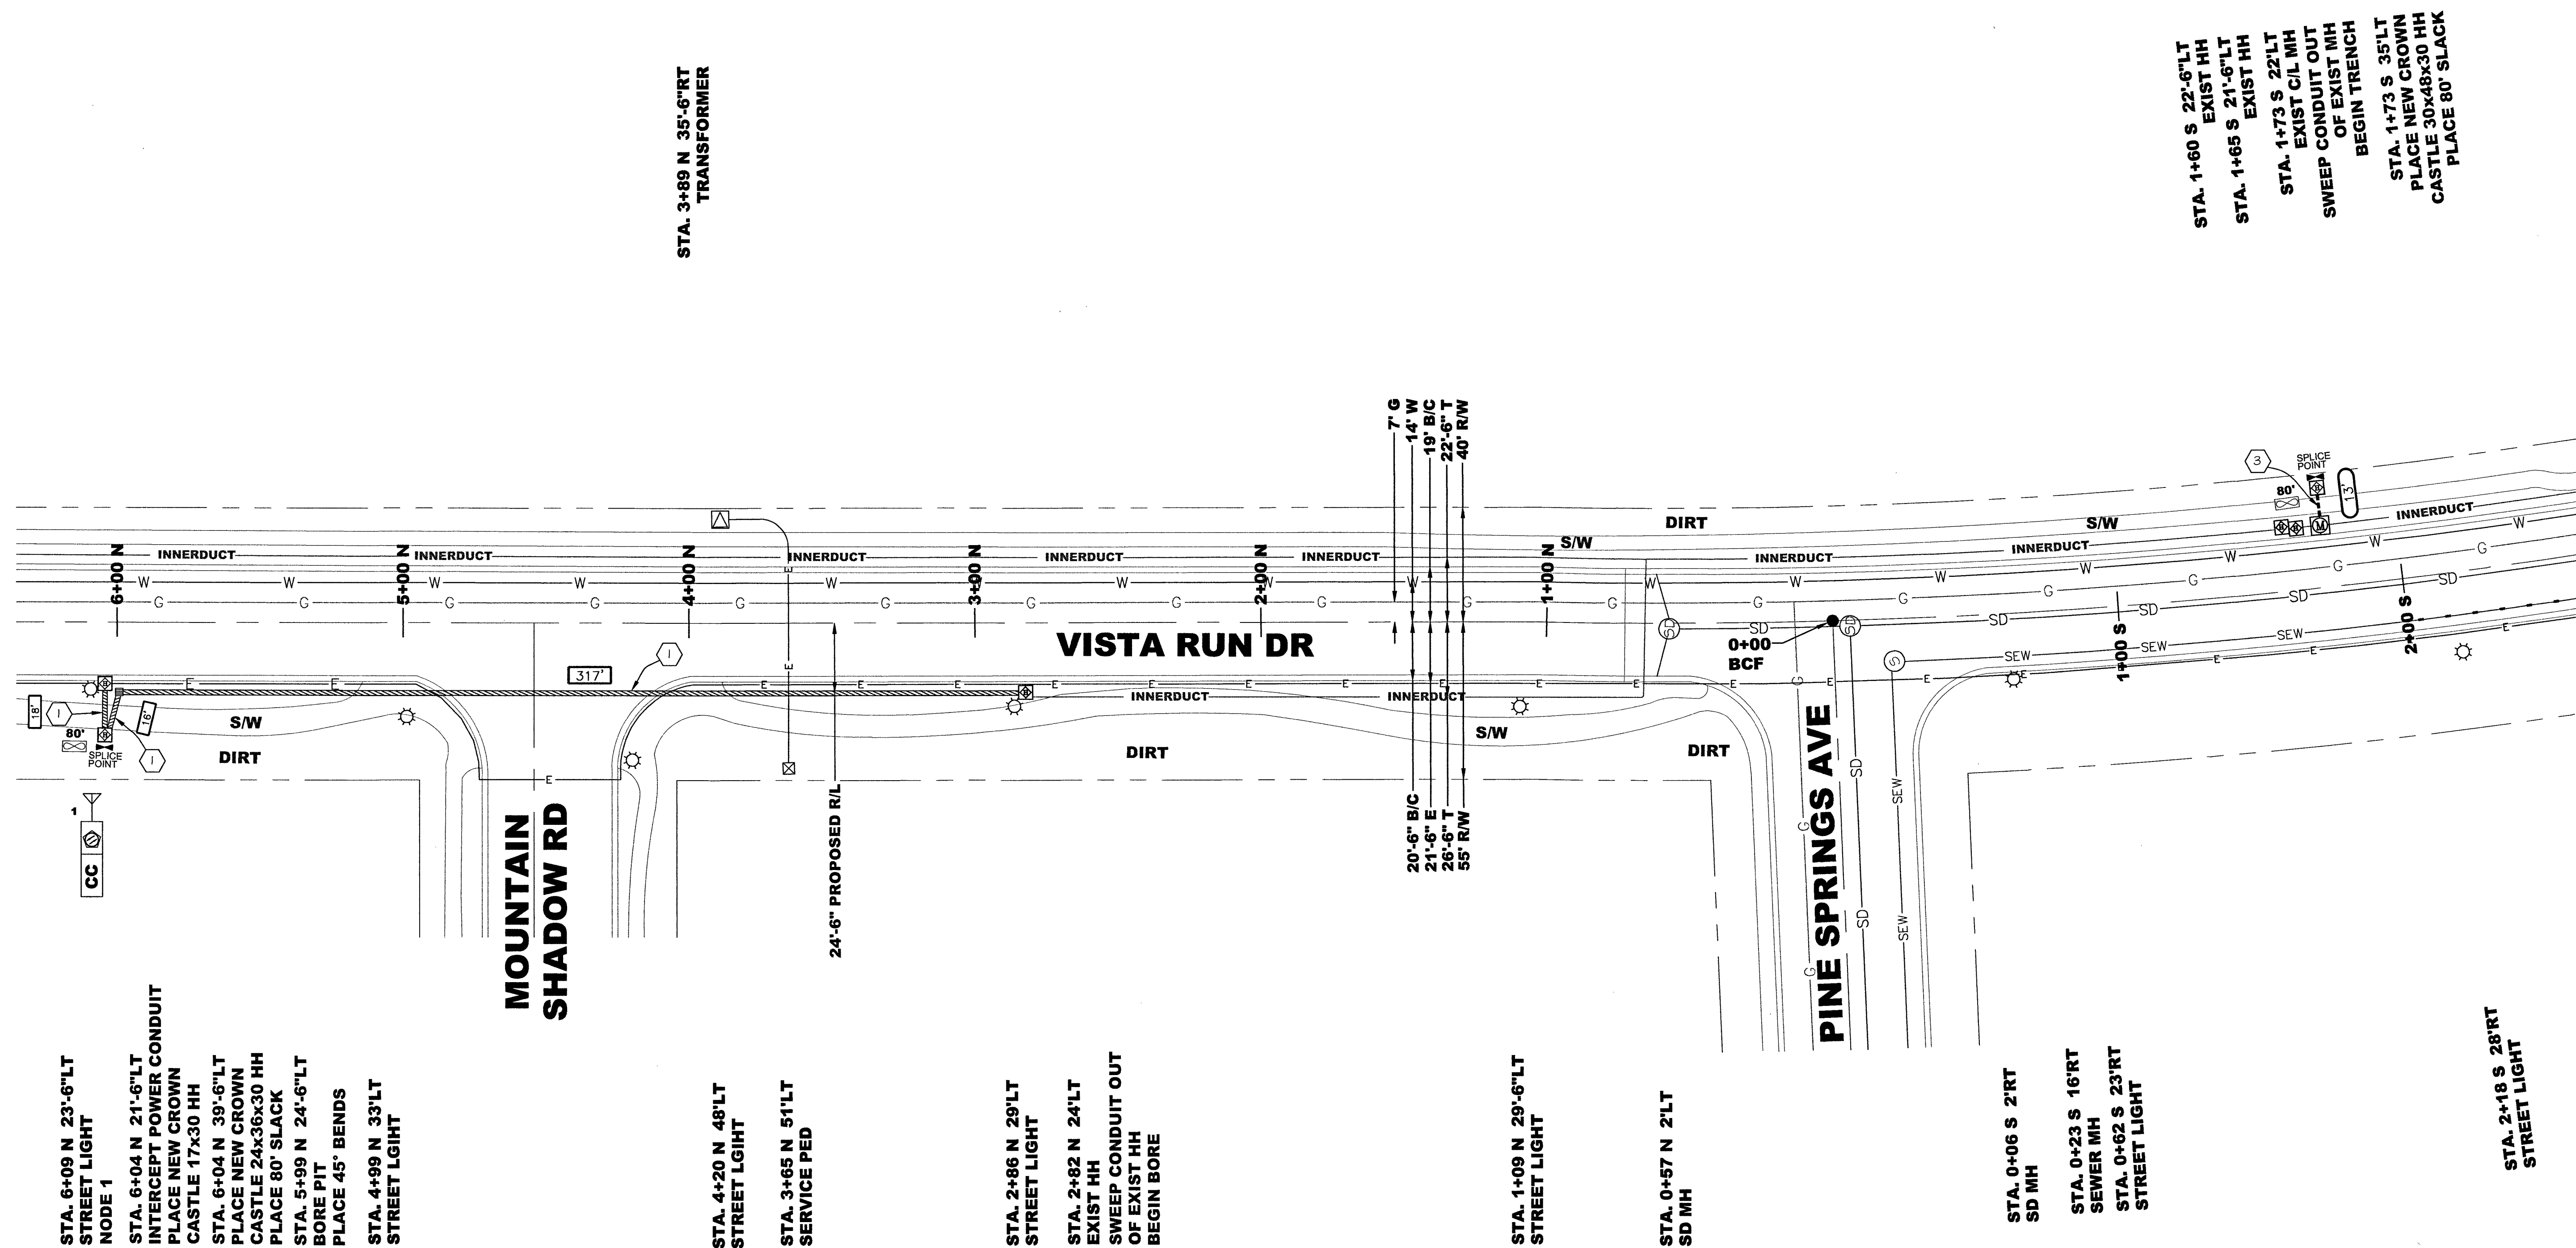

THIS SHEET REQUIRES:		
DESCRIPTION	QUANTITY	UNITS
BORE (2) 1.25" SDR-11 CONDUITS	351	FT
TRENCH (2) 1.25" SDR-11 CONDUITS		FT
TRENCH (1) 4" SDR-11 CONDUIT	13	FT
TRENCH (1) 2" SDR-11 CONDUIT		FT
90° BEND		EA
45° BEND	2	EA
BORE PIT - 4'x4'	1	EA
17"x30"x18" HAND HOLE	1	EA
24"x36"x30" HAND HOLE	1	EA
30"x48"x30" HAND HOLE	1	EA

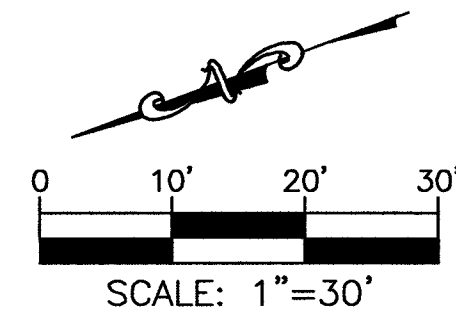

3	-	-	-	AS-BUILT
2	10/15/15	TT	MF	REVISION # 1
1	8/12/15	TT	MF/JA	ORIGINAL
NO.	DATE	ENG DESIGN	DRAFTING	COMMENT
PROJECT ENGINEER: RICHARD ALGERIA 602-576-0951				
ENGINEERING FIRM: TETRA TECH				
PROJECT NUMBER: 126-40-45353				
LOCATION: SUMMERLIN, NEVADA				
DRAWING NAME: 126-40-45353 - SUMMERLIN NEVADA - VEGAS.dwg				
CONFIDENTIAL/PROPRIETARY			SHEET: 4 OF 4	