
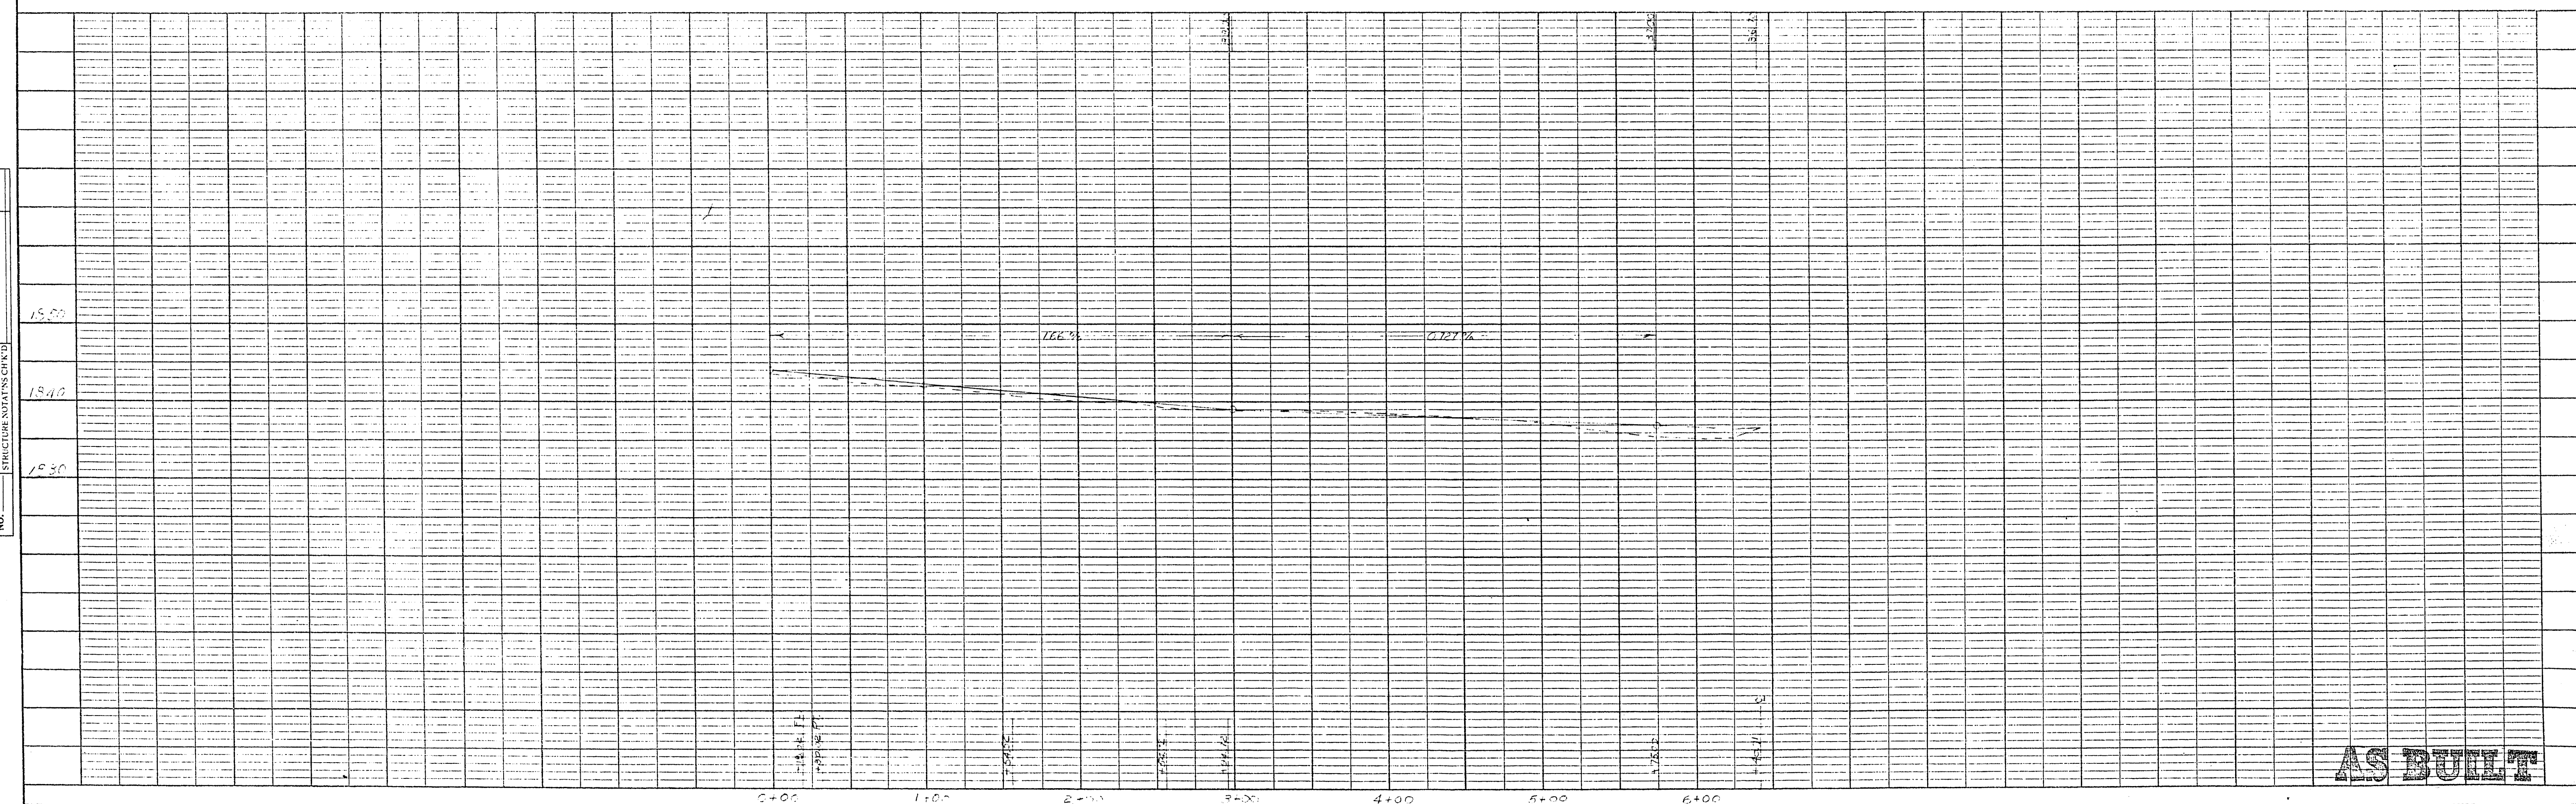
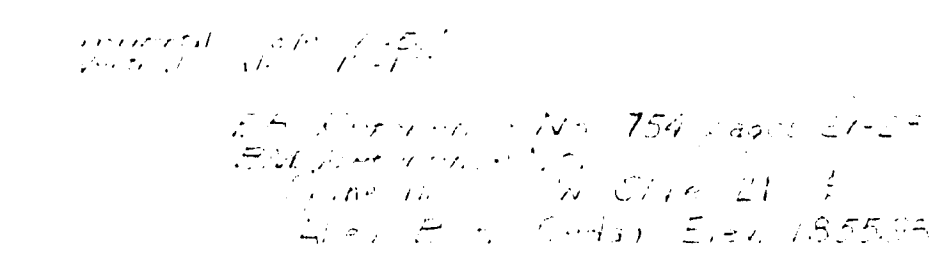


27-5-25

[illegible]

PROFILE NOTE BOOK	SURVEYED	BY	DATE
	PLOTTED		
	GRADES CHECKED		
	B. M. 2. NOTED		

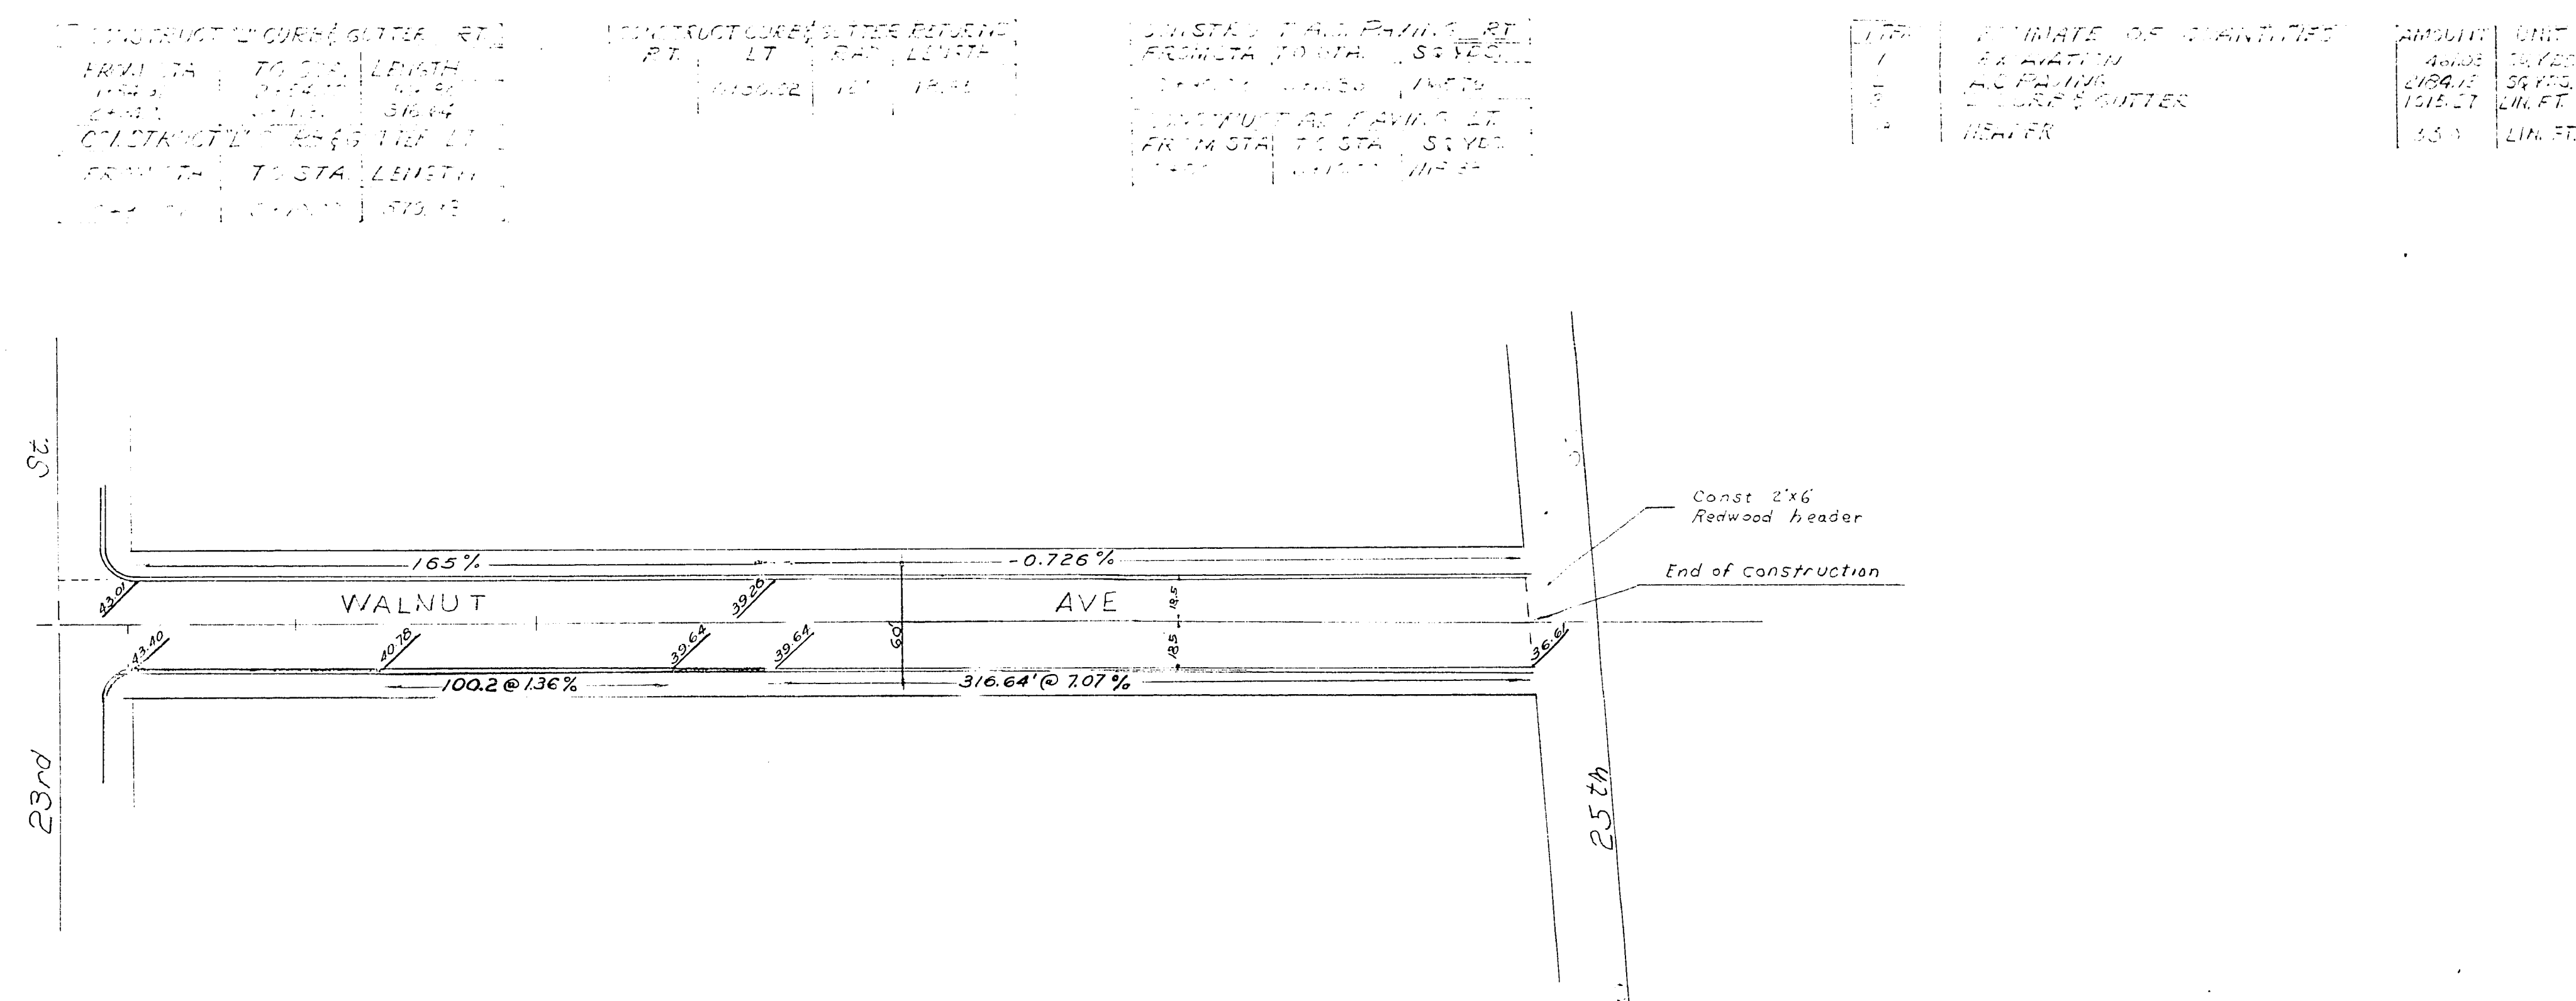

AS BUILT