

APPROVED BY: R. L. Austin 6-10-65
Supt. Sanitation DATE

REVISION  DUE TO CHANGE IN STREET DESIGN
SEWER DESIGN HAD TO BE ALTERED 3/14/66


APPROVED BY L. A. A. 3-22-66
SUPT. OF SANITATION DATE

APPROVED BY R. J. [Signature]
CITY ENGINEER, DATE

DATE	TIME	NAME	REMARKS
5	12:00	W. J. Smith	6-11-65
3	12:00	W. J. Smith	6-11-65
2	12:00	W. J. Smith	6-11-65
4	12:00	W. J. Smith	6-11-65
1	12:00	W. J. Smith	6-11-65

CITY OF LAS VEGAS NEVADA		
ENGINEERING DEPT.		
SAD. 448 SANITARY SEWER		
ON WARREN LANE		
DES. D.O.D.D.	DATE 6/17/65	SC. (H) 1" = 20'
DR. C.H.	6/17/65	SC. (M) 1" = 2'
CHKD.		F.B.K. NO. SUBDIVISION
APPROVED BY CITY ENGR.		P.J. O. NO.
		DRAWING NO.
	dis 65	448

107-V14


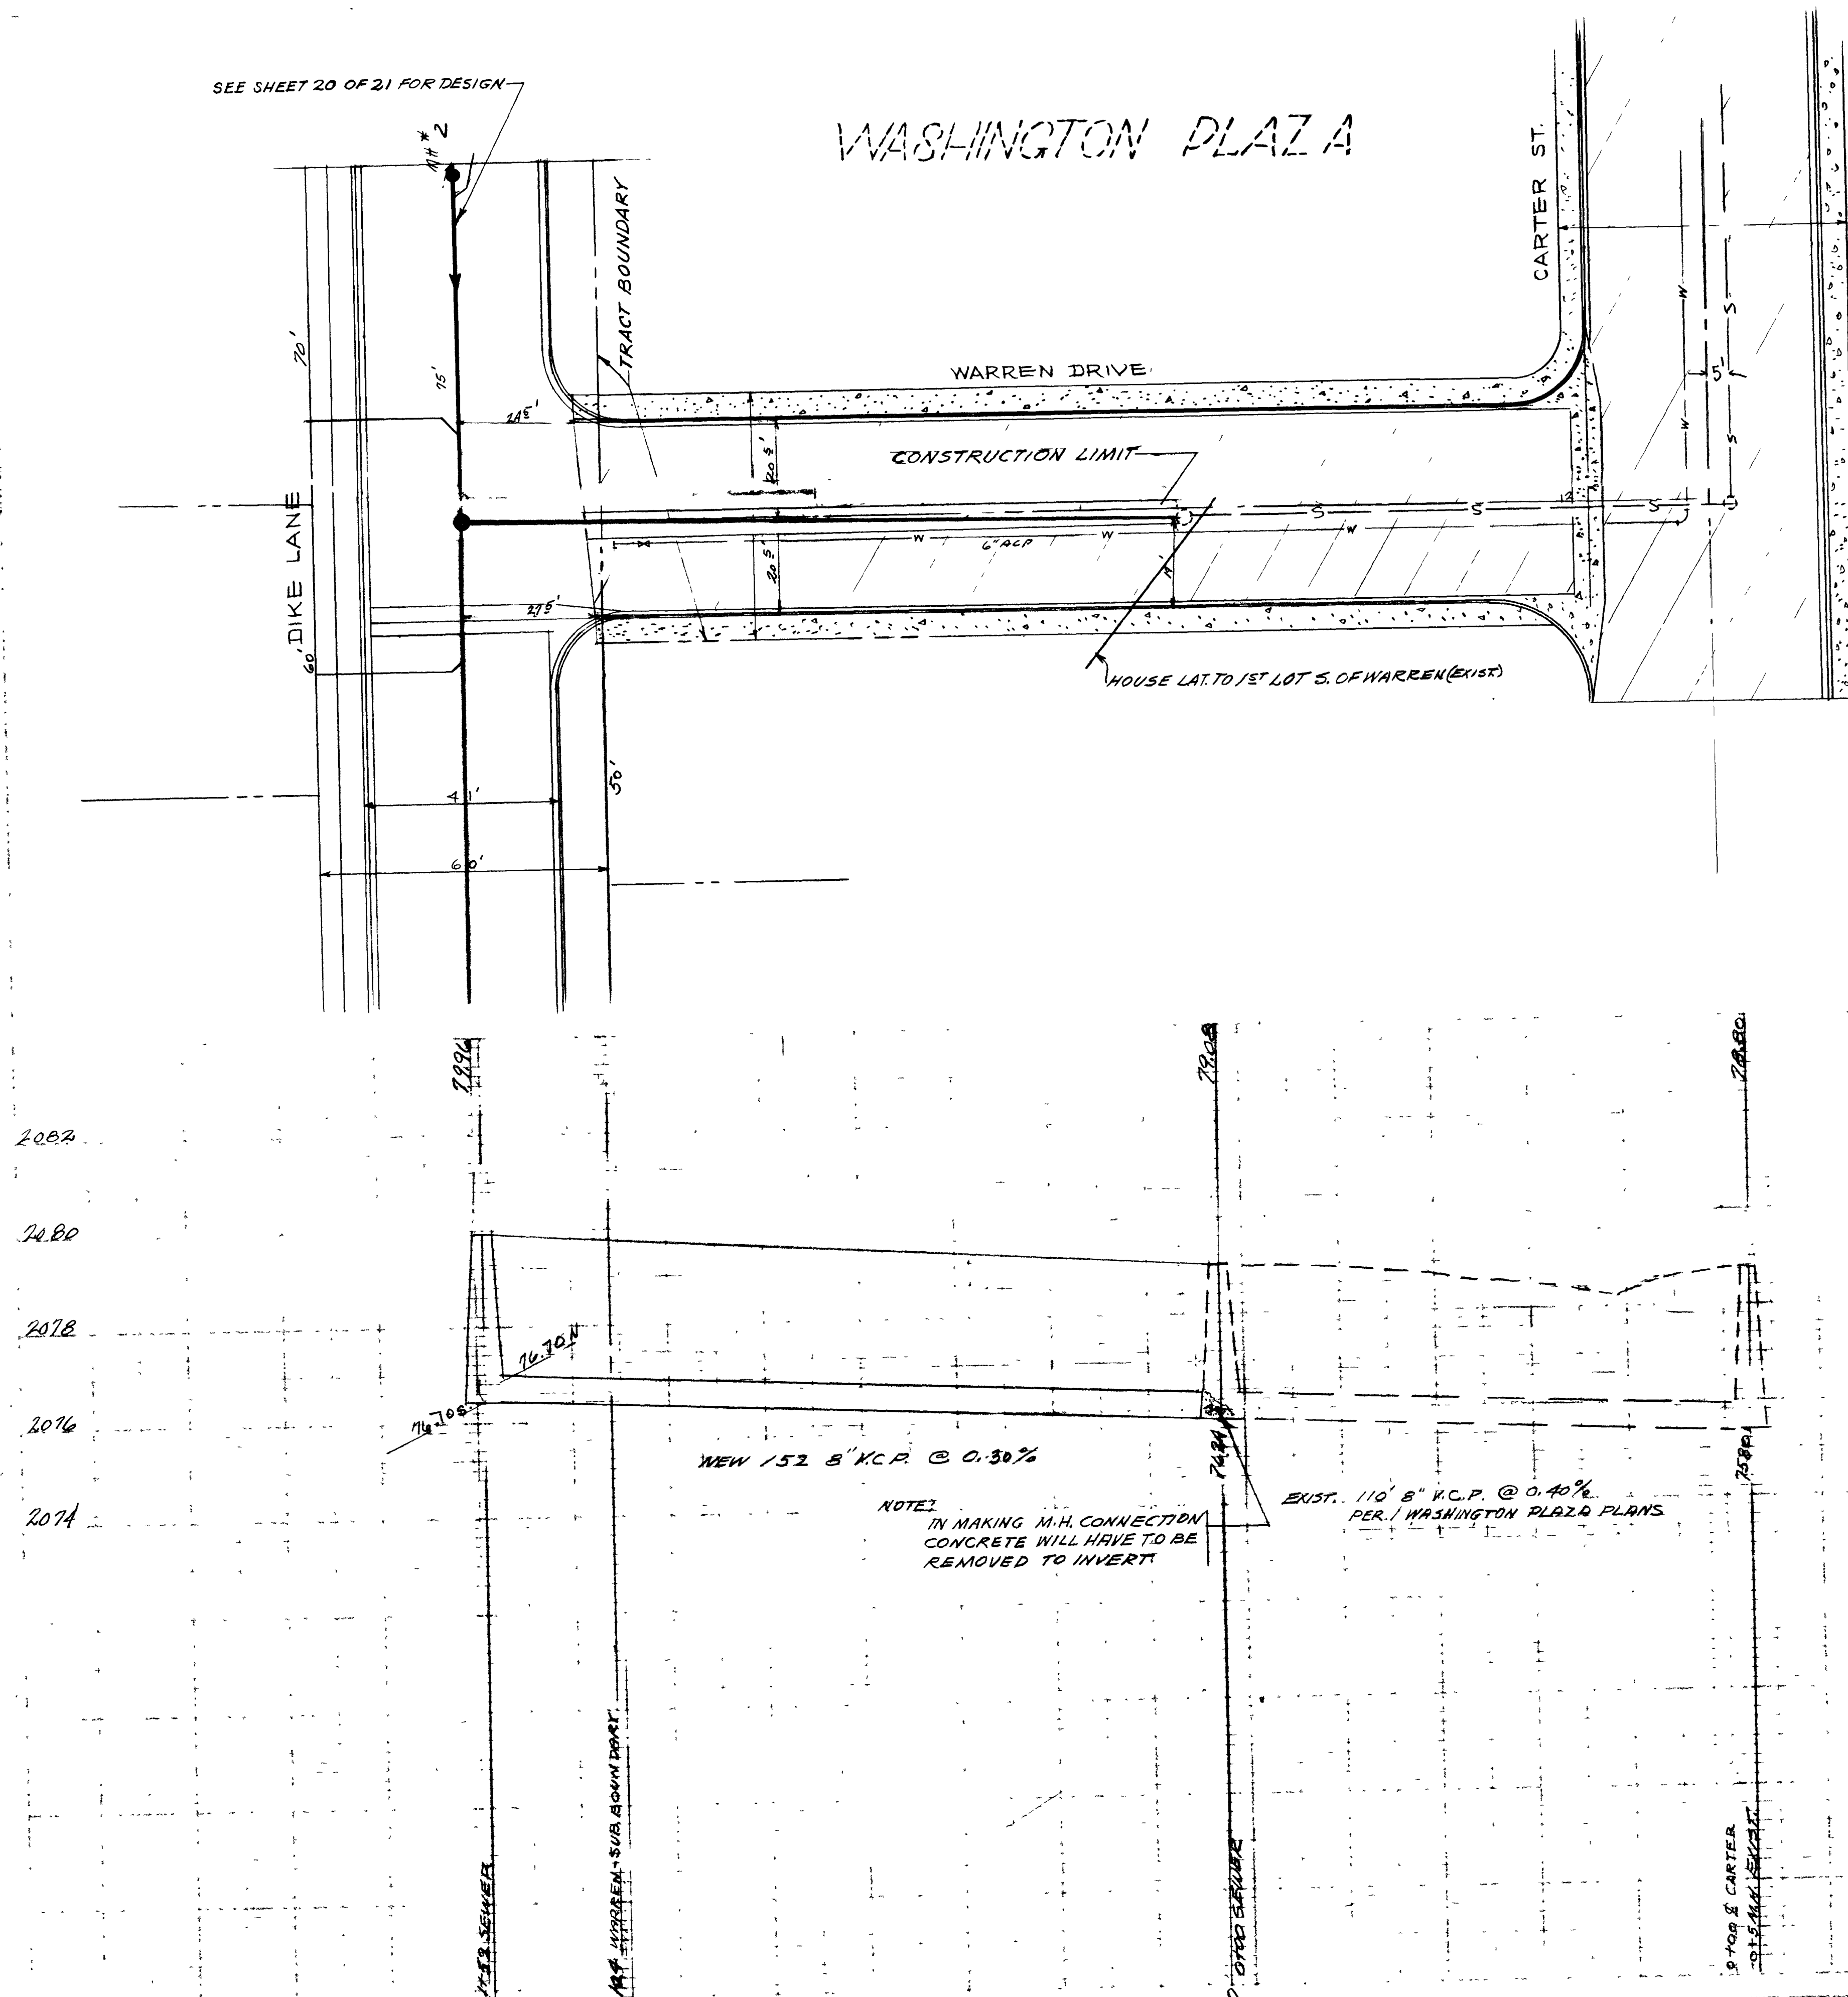


WASHINGTON PLAZA

NO.	DATE	REVISION
1	10/1/68	ISSUED
2	10/1/68	REVISED
3	10/1/68	REVISED
4	10/1/68	REVISED
5	10/1/68	REVISED
6	10/1/68	REVISED
7	10/1/68	REVISED
8	10/1/68	REVISED
9	10/1/68	REVISED
10	10/1/68	REVISED

THIS DRAWING IS THE PROPERTY OF THE CITY OF LAS VEGAS, NEVADA. IT IS TO BE KEPT IN THE OFFICE OF THE ENGINEER AND NOT TO BE LOANED, REPRODUCED, COPIED, OR IN ANY MANNER USED FOR ANY OTHER PROJECT WITHOUT THE WRITTEN PERMISSION OF THE ENGINEER.

APPROVED BY: *[Signature]* DATE: 10/1/68
 DESIGNED BY: *[Signature]* DATE: 10/1/68
 CHECKED BY: *[Signature]* DATE: 10/1/68
 DRAWN BY: *[Signature]* DATE: 10/1/68

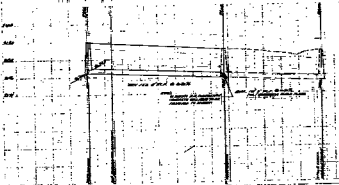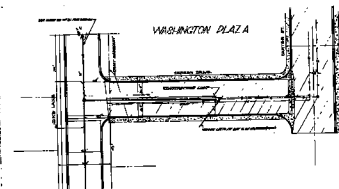

NO.	DATE	REVISION
1	10/1/68	ISSUED
2	10/1/68	REVISED
3	10/1/68	REVISED
4	10/1/68	REVISED
5	10/1/68	REVISED
6	10/1/68	REVISED
7	10/1/68	REVISED
8	10/1/68	REVISED
9	10/1/68	REVISED
10	10/1/68	REVISED

CITY OF LAS VEGAS, NEVADA	
ENGINEERING DEPT.	
JULIUS J. JENSEN, ENGINEER	
OF WASHINGTON PLAZA	
DATE: 10/1/68	BY: <i>[Signature]</i>
CHECKED BY: <i>[Signature]</i>	DATE: 10/1/68