




	SHEET UT1 6 OF 17 SHEETS DRAWING NO. 10744781		WASHBURN & DURANGO UNIT 1 (AKA - NORTH CANYON ESTATES)		TOLL BROTHERS 1635 VILLAGE CENTER CIRCLE, SUITE 100 FARMERS BRANCH, GA 30134 (702) 243-9860 FAX (702) 243-9610		ALPHA & ENGINEERING COMPANY 50 So. Justice #2021 Las Vegas, NV 89107 Telephone: (702) 877-1300	DATE APPROVED REVISION BY DATE REV
	DRAWN BY: _____ RCN _____	05/13/03	DESIGNED BY: _____ RCN _____	05/13/03	CHECKED BY: _____ GWS _____	05/13/03		
PROJECT NO: _____ 516710		SCALE: 1" = 40'						

NORTH 88°58'14" WEST BEING THE EAST-WEST LINE CENTER
OF SECTION LINE BETWEEN THE WEST QUARTER (1/4)
CORNER AND THE WEST SIXTEENTH (1/16) CORNER OF
SECTION 33, TOWNSHIP 19 SOUTH, RANGE 60 EAST M.D.M.,
CITY OF LAS VEGAS, CLARK COUNTY, NEVADA. AS SHOWN
BY MAP IN THE OFFICE OF THE CLARK COUNTY, NEVADA
RECORDER IN FILE 82 OF PARCEL MAPS PAGE 75.

CITY OF LAS VEGAS VERTICAL CONTROL
RIVET AND PLATE IN TOP OF CURB, NE
RETURN OF DURANGO DRIVE & WASHBURN RD.
STATION $1+V90$
33W4
ELEVATION = 740.8191 METERS 2430.50 FEET (NAVD88) OLD
740.7932 METERS 2430.42 FEET NEW
OLD - 0.02' = NEW

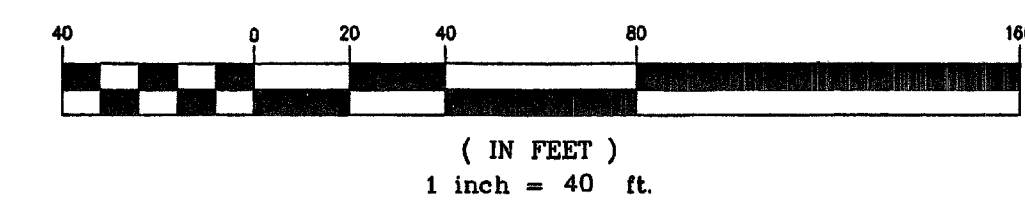

INSTALLATION OF SERVICE LATERALS (1" TO 2") FOR FUTURE LOTS SHALL BE
 9 INSTALLED PER THE UDACS PLATE 1D. IF ANY OF THE SERVICE
 LATERAL TO BE INSTALLED FOR FUTURE LOTS ARE INCORRECTLY LOCATED OR ARE
 NOT USED FOR ANY REASON WHEN THE LOTS ARE DEVELOPED, THE DEVELOPER
 SHALL ABANDON THE LATERALS AT THE CONNECTION TO THE ACTIVE MAIN IN
 ACCORDANCE WITH THE DISTRICT'S STANDARDS AND AT THE DEVELOPER'S EXPENSE.

CITY FIRE MARSHAL 1125.00
DATE _____

[Signature]
LAS VEGAS VALLEY WATER DISTRICT 12/11/03
DATE _____

ES

1-702-455-7511
CLARK COUNTY TRAFFIC OPERATIONS
AND
1-702-229-6611
LAS VEGAS AREA
COMPUTERIZED TRAFFIC SYSTEM

Call
before you
Underground

A diagram illustrating a traffic control system. It shows a vehicle on a road, a control unit, and a computerized traffic system. The vehicle is positioned on a road that leads into a tunnel or underground structure. The control unit is connected to the vehicle and the computerized traffic system. The computerized traffic system is represented by a box with a grid pattern, and it is connected to the control unit by a line. The diagram is labeled with 'Call before you Underground' and 'LAS VEGAS AREA COMPUTERIZED TRAFFIC SYSTEM'.

AVOID OVERHEAD POWER LINE CONTACT CALL BEFORE YOU OVERHEAD 1-702-583-6111	NOTICE! EXISTING UTILITIES ARE SHOWN ON PLANS FOR THE CONVENIENCE ONLY. THE CONTRACTOR IS RESPONSIBLE FOR THE PROTECTION OF ALL UTILITIES. THE ENGINEER BEARS NO RESPONSIBILITY FOR UTILITIES NOT SHOWN OR SHOWN INCORRECTLY.	AVOID CUTTING UNDERGROUND UTILITIES. IT'S COSTLY. Call Before You Dig 1-800-227-2600
NEVADA POWER ENVIRONMENT AND SAFETY SERVICES DEPARTMENT UNDERGROUND SERVICE (USA)		

11-24-16

SHEET
UT1
 6 OF 17 SHEETS
 DRAWING NO.
 10744789
 HTE# 04-18736

-SEWER ASBUILT -