
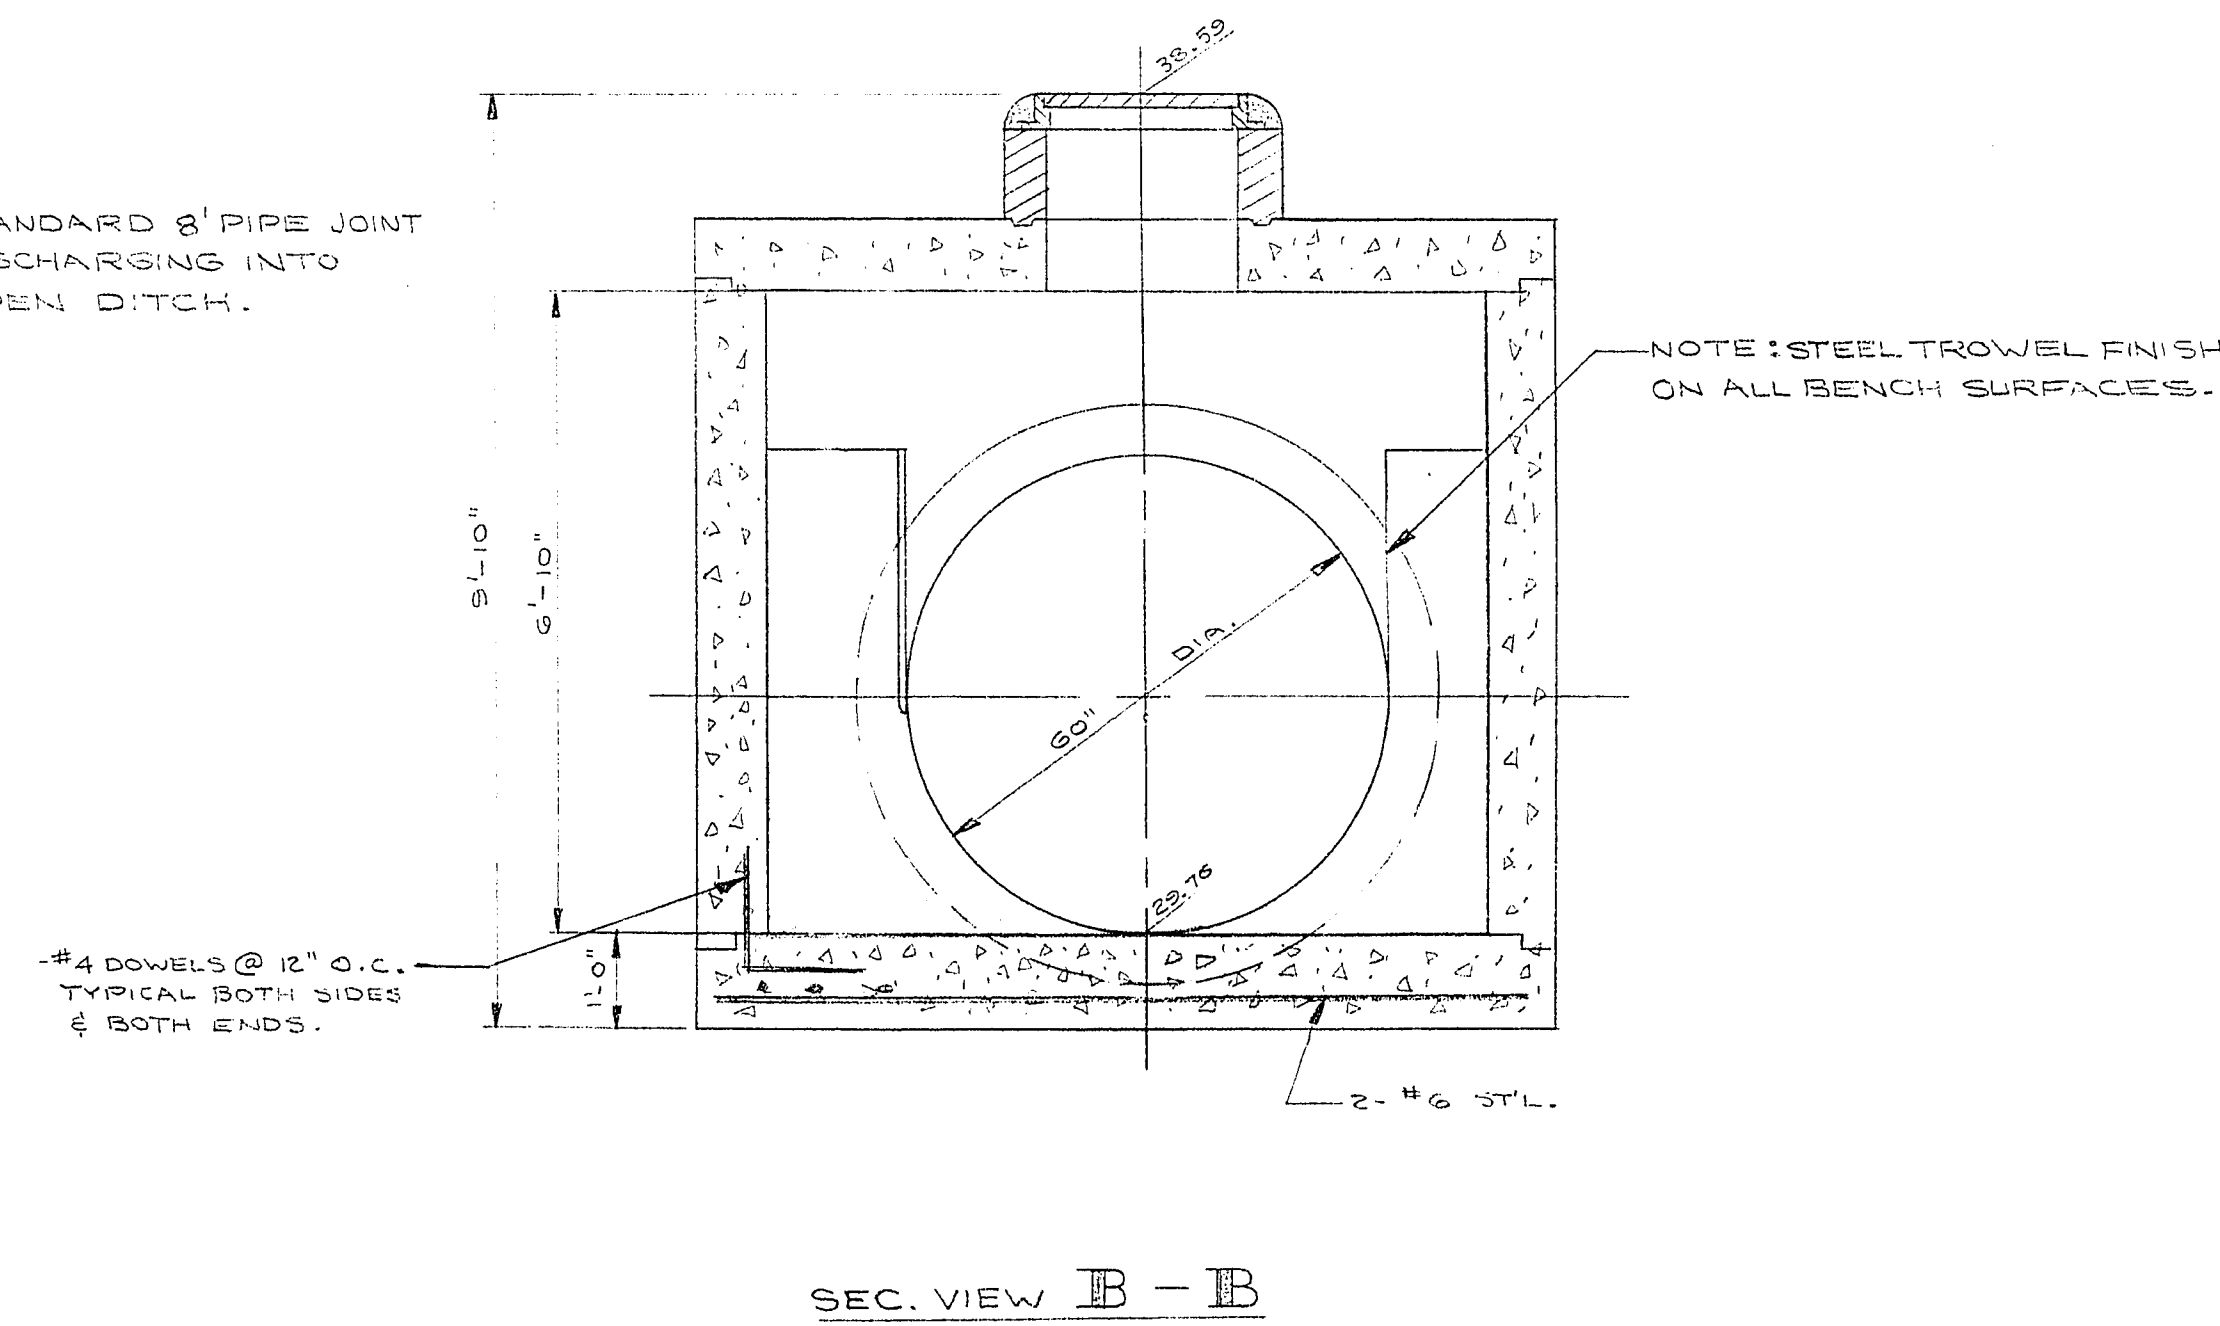
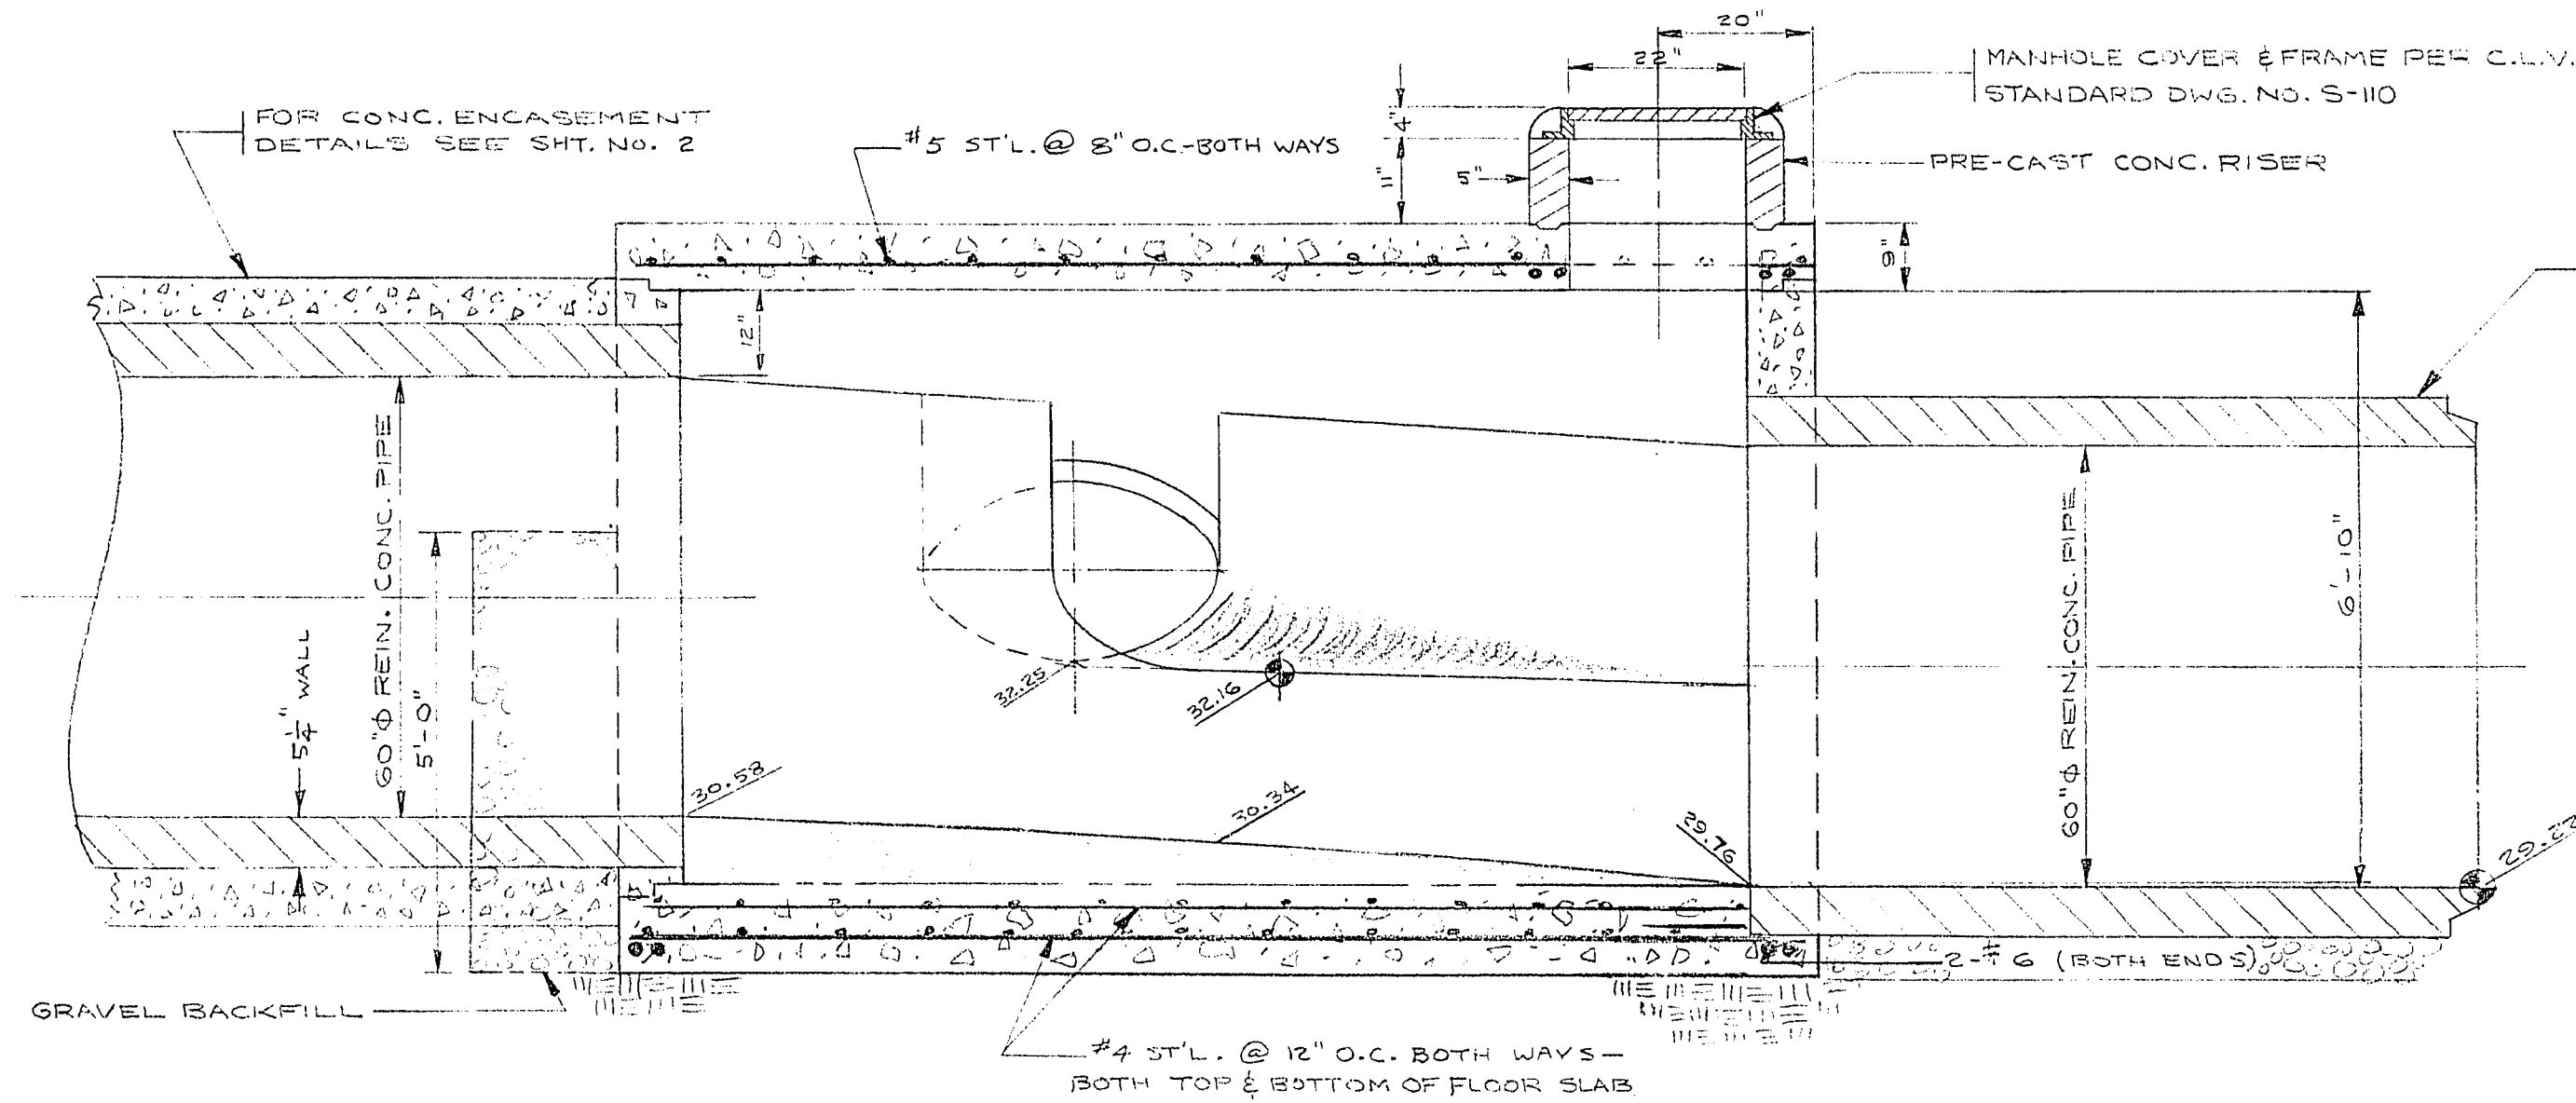
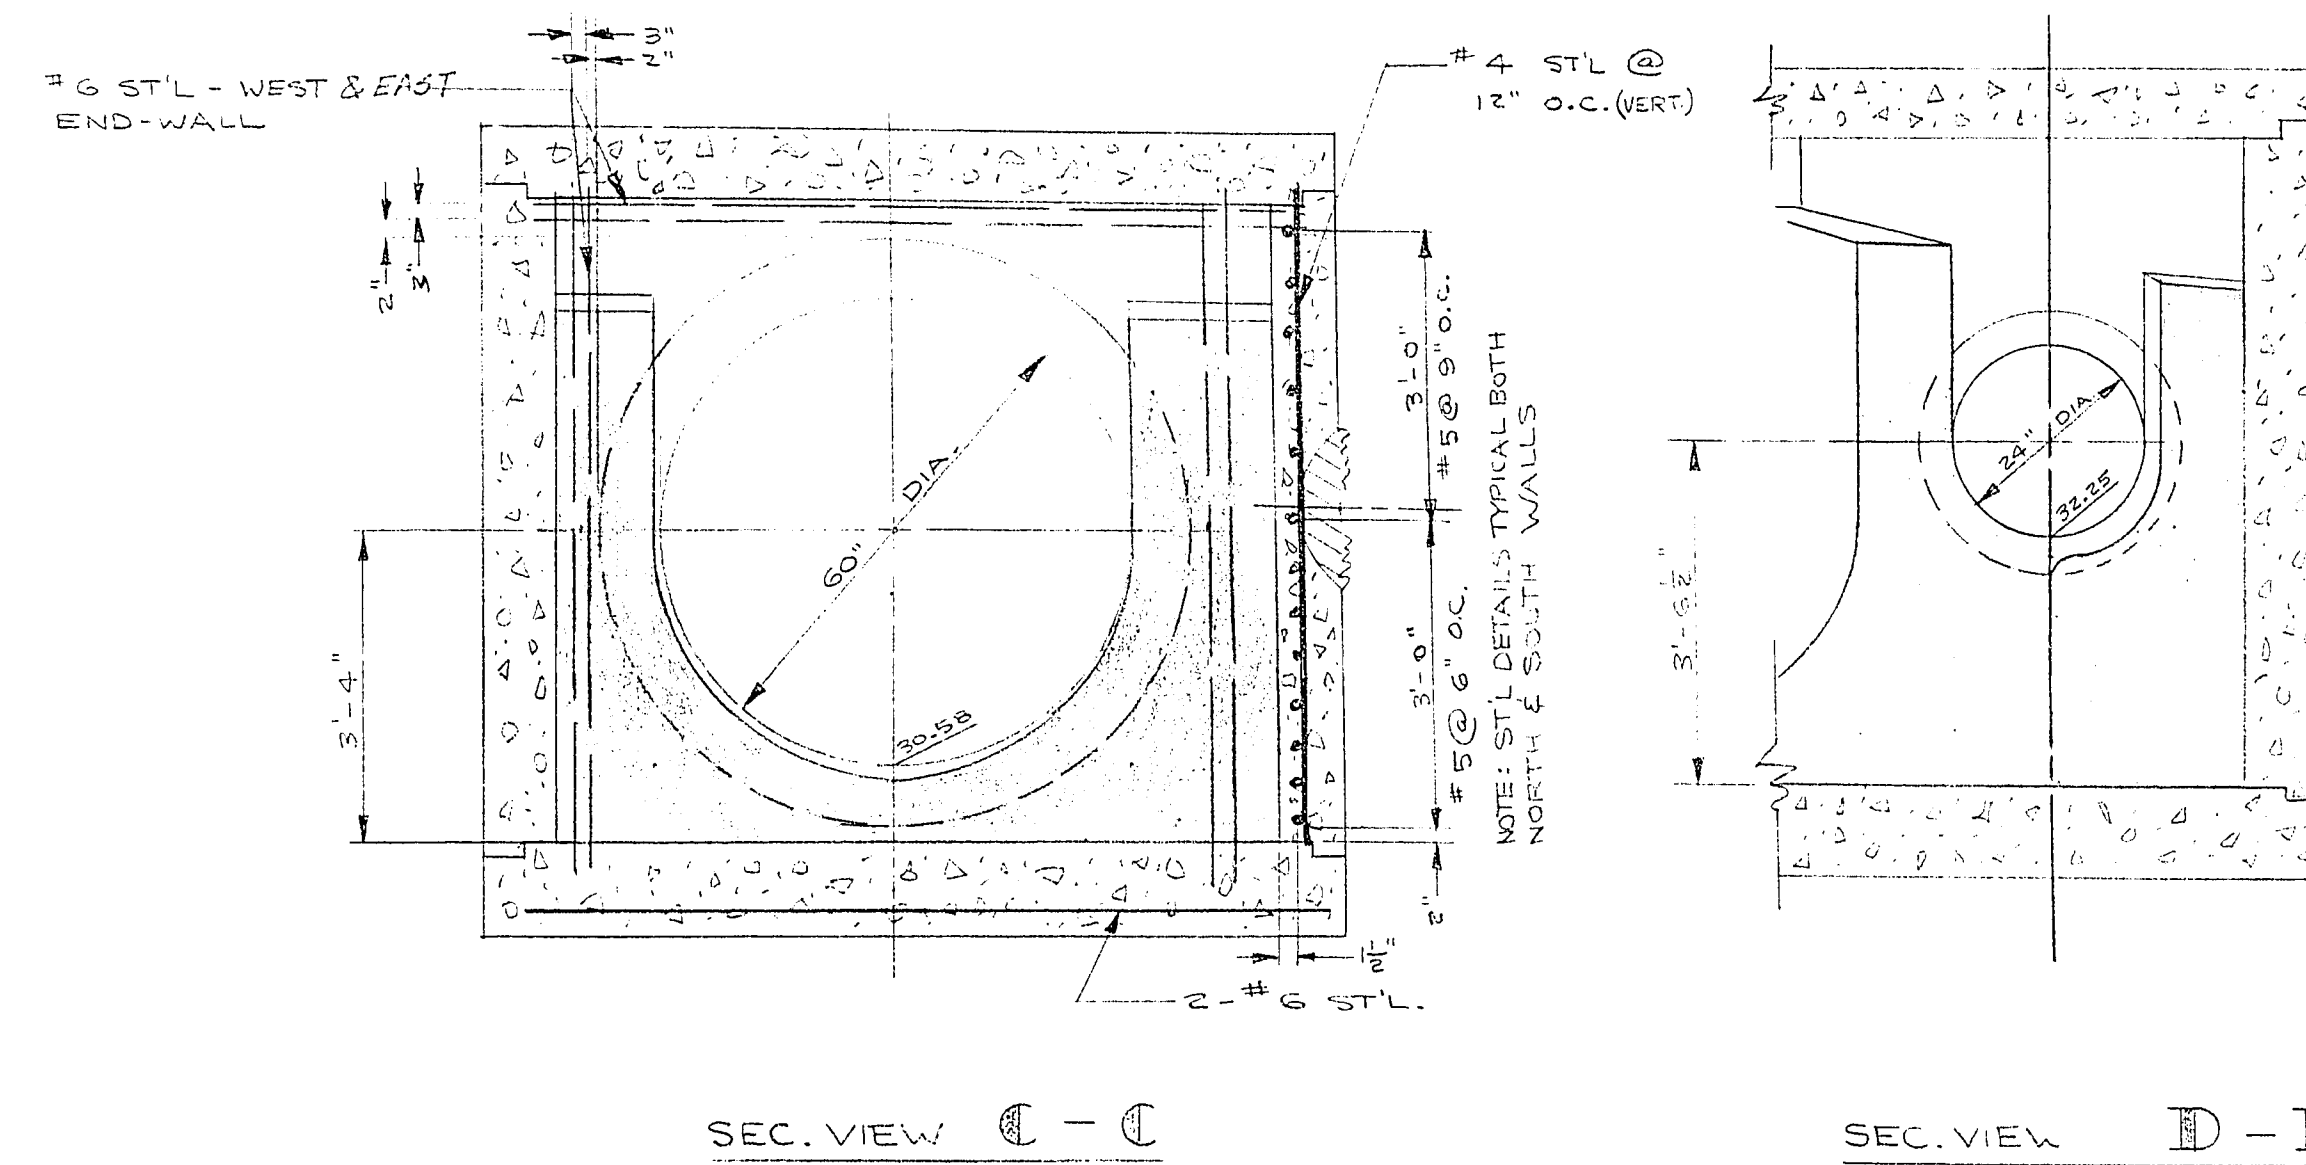


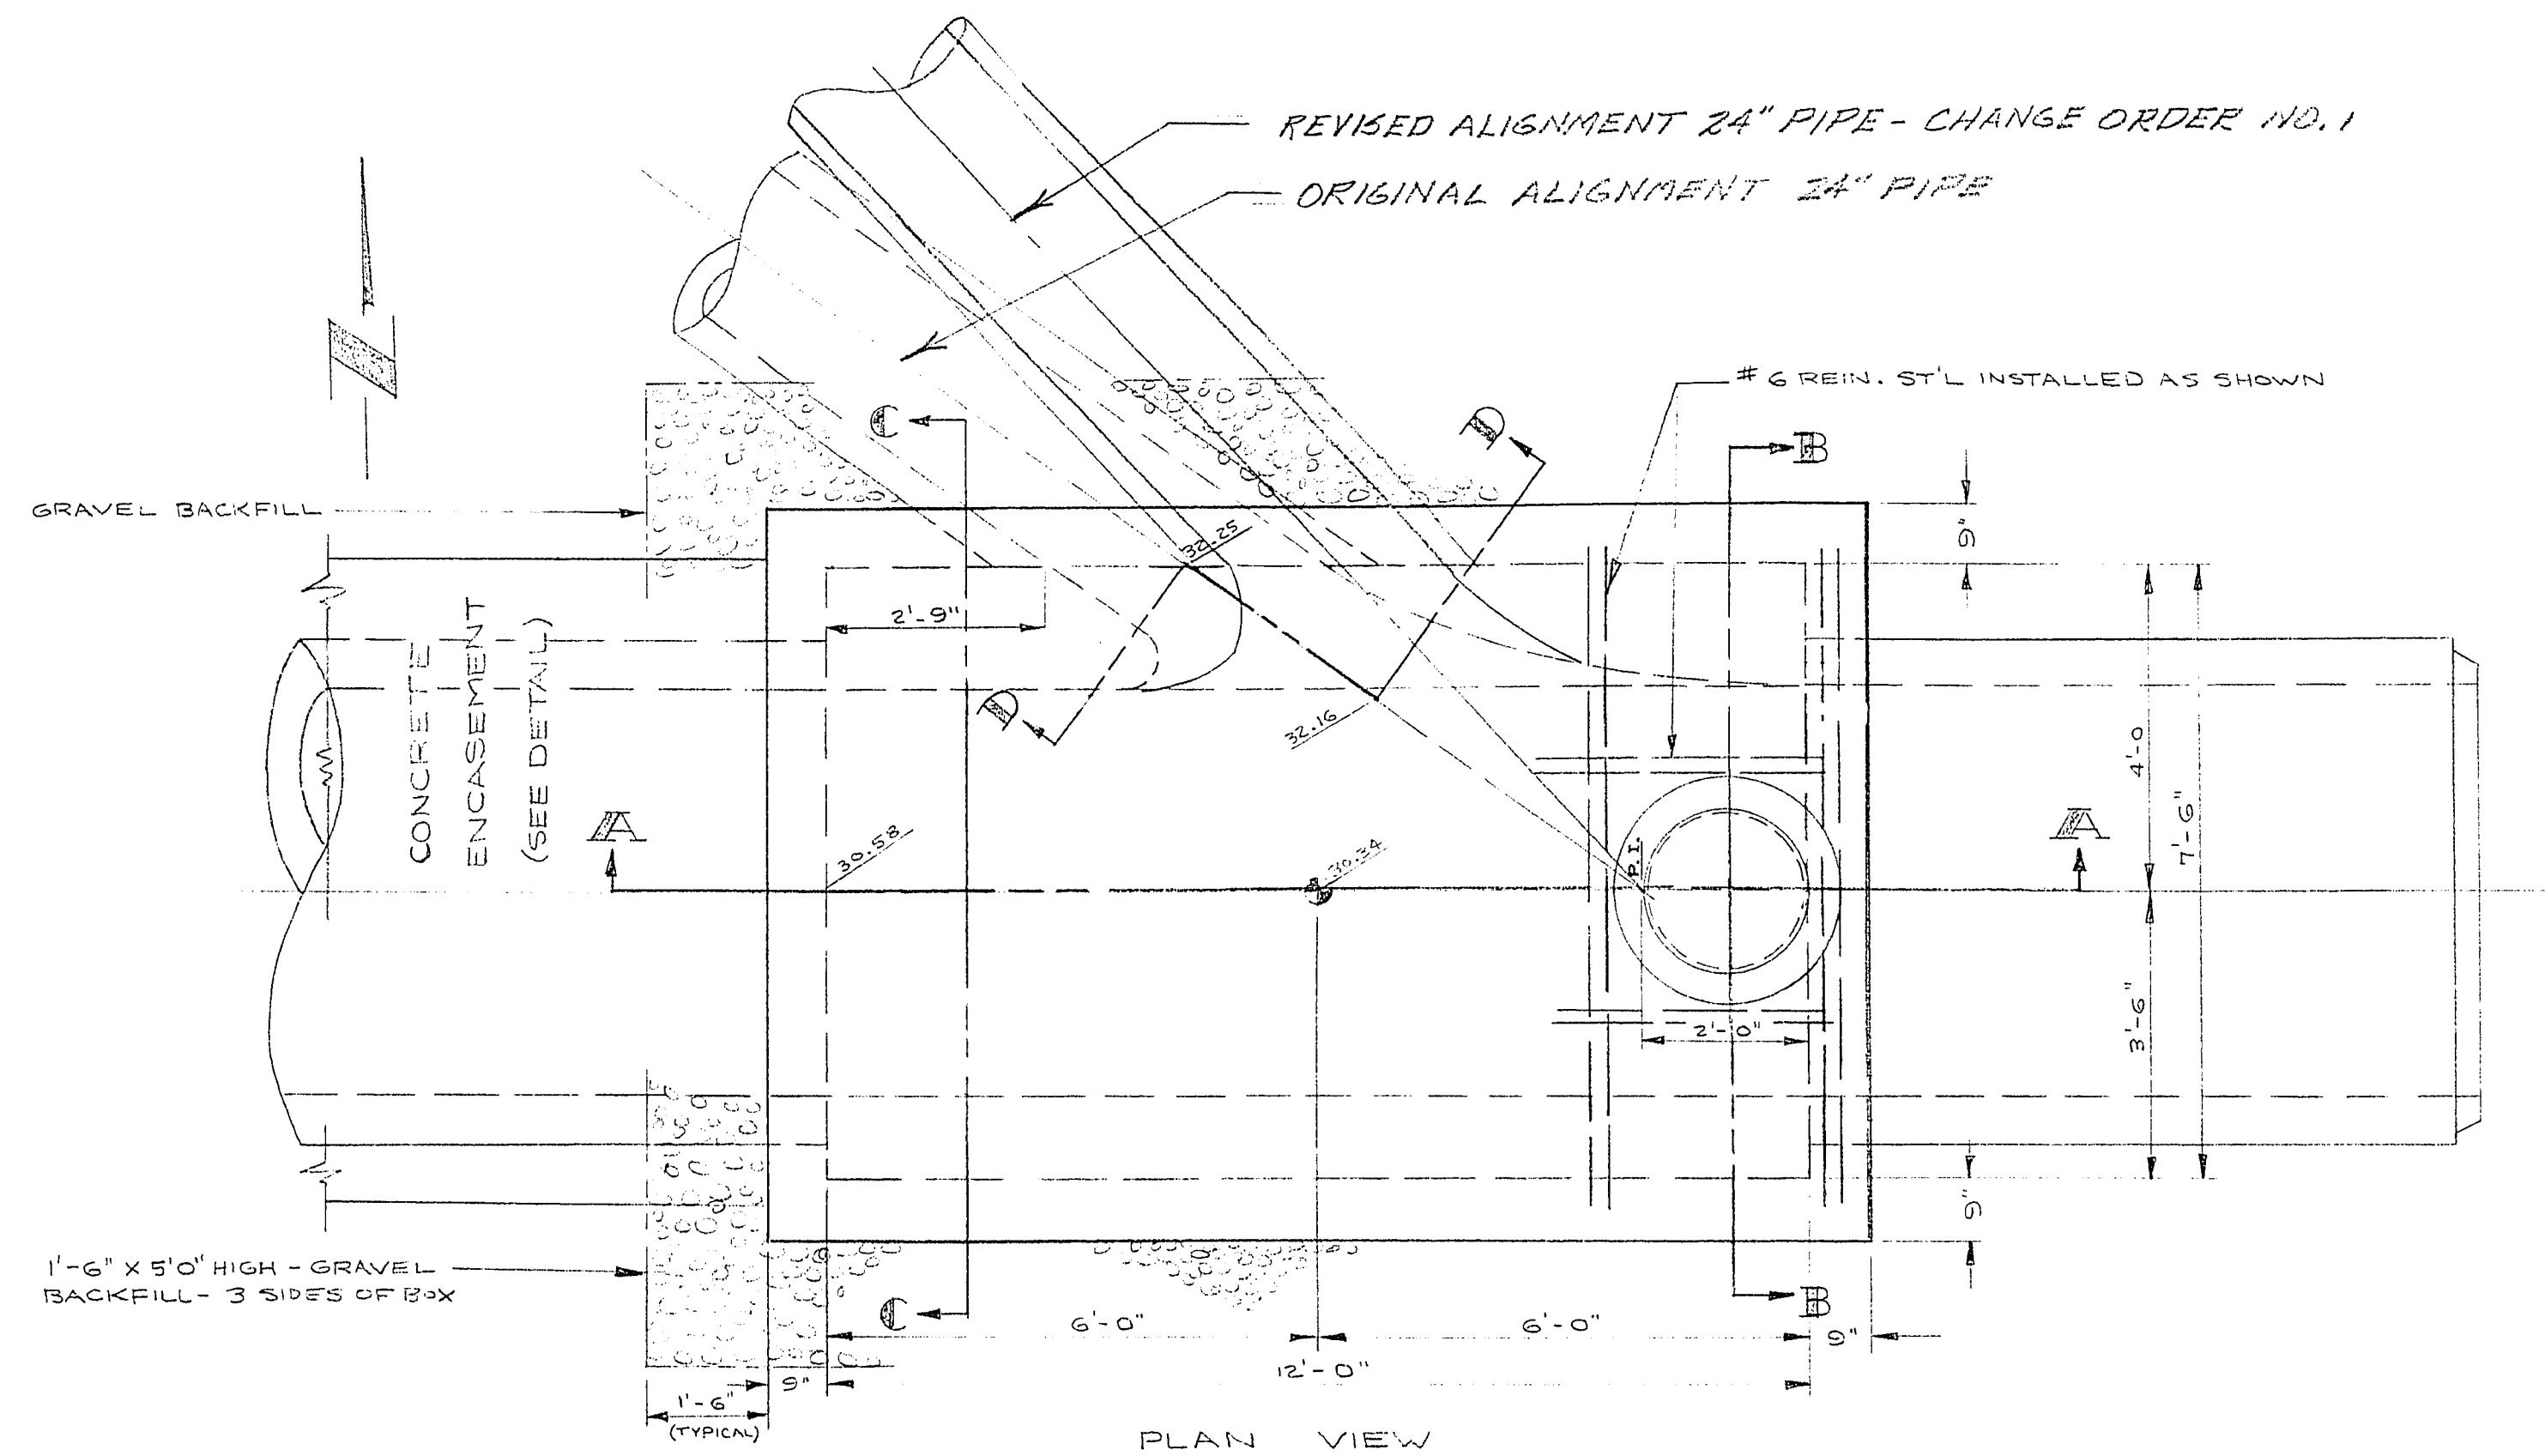

GENERAL NOTES:

1. ST'L REIN. OMITTED FROM SOME VIEWS OF DWG. FOR CLARITY.
2. JUNCTION BOX TO BE CONSTRUCTED OF CLASS F-3000 CONCRETE.
3. PIPE TO BE T&G REIN. CONC. TYPE - STANDARD STRENGTH.

REVISION: CHANGE IN ALIGNMENT 24" PIPE 4-9-56 *W*

APPROVAL *Director* DIRECTOR PUBLIC WORKS

STAGE I CONSTRUCTION

CITY OF LAS VEGAS NEVADA

ENGINEERING DEPT.

WASHINGTON AVE. STORM SEWER

JUNCTION CHAMBER DETAILS

REVISIONS			
NO.	BY	DESCRIPTION	DATE
1			
2			
3			
4			
5			
6			
7			
8			
9			
10			

DESIGNED BY	CRAWFORD	DATE	2-10-55
DRAWN BY	Ables	FIELD BOOK NO.	
CHECKED BY	<i>W. J. W.</i>	WORK ORDER NO.	1161
APPROVED	<i>W. J. W.</i>	DRAWING NO.	327-V-45
CITY ENGR.	<i>W. J. W.</i>		