

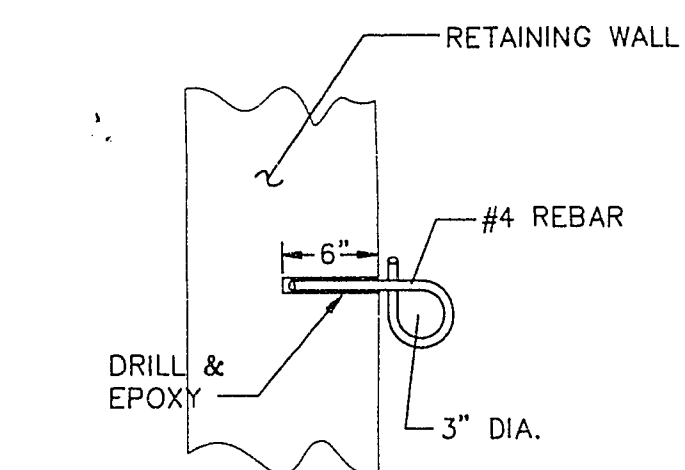
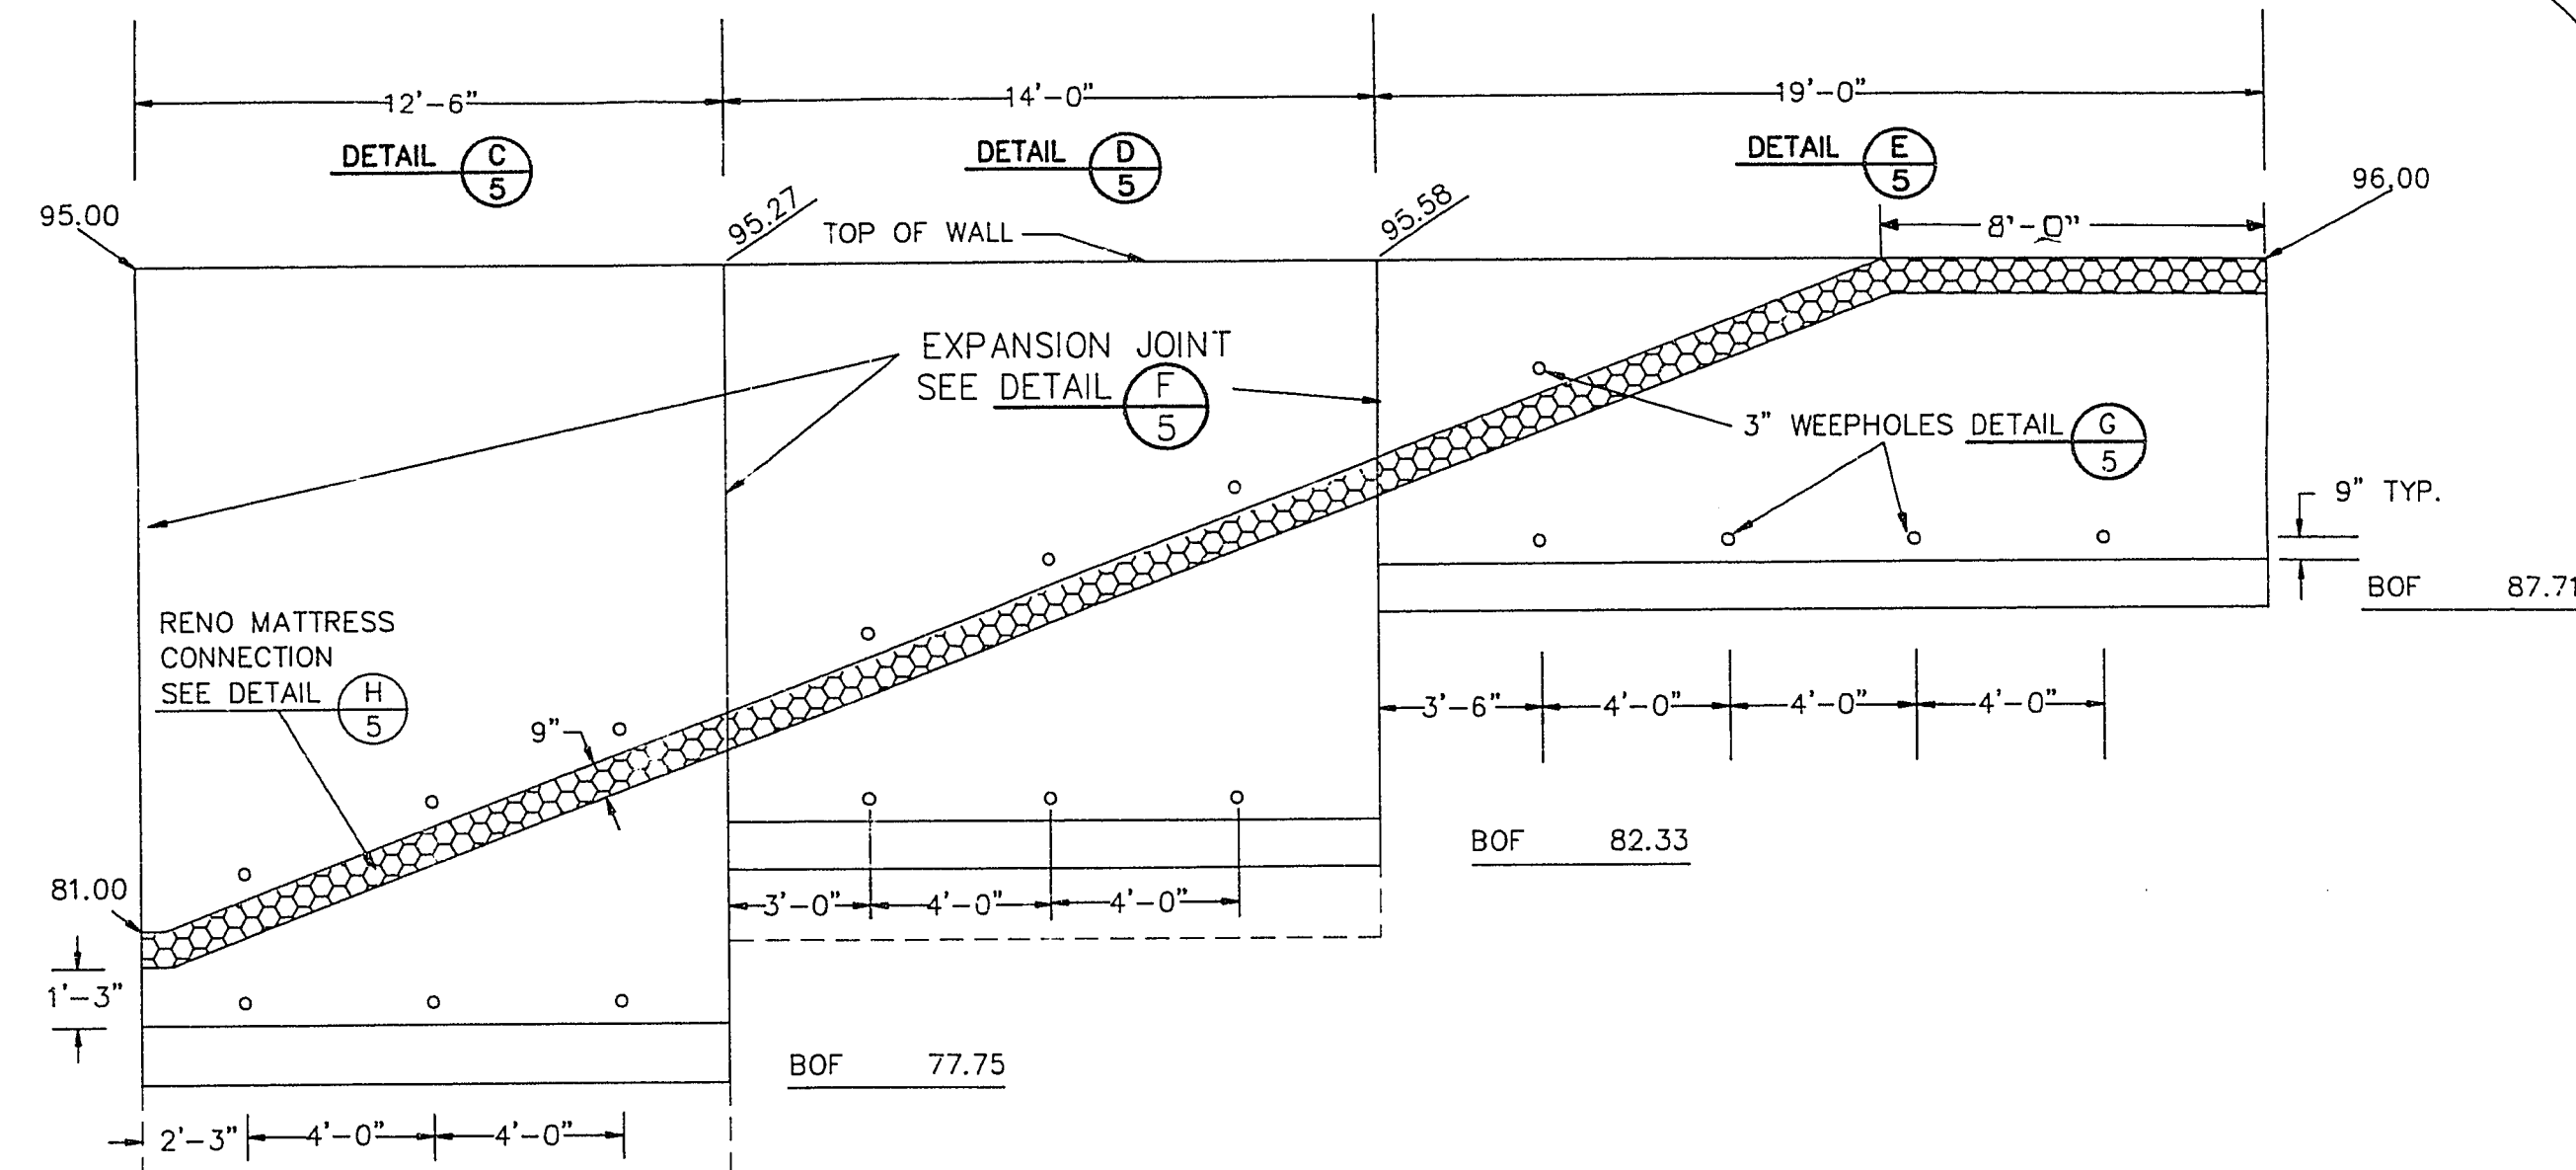
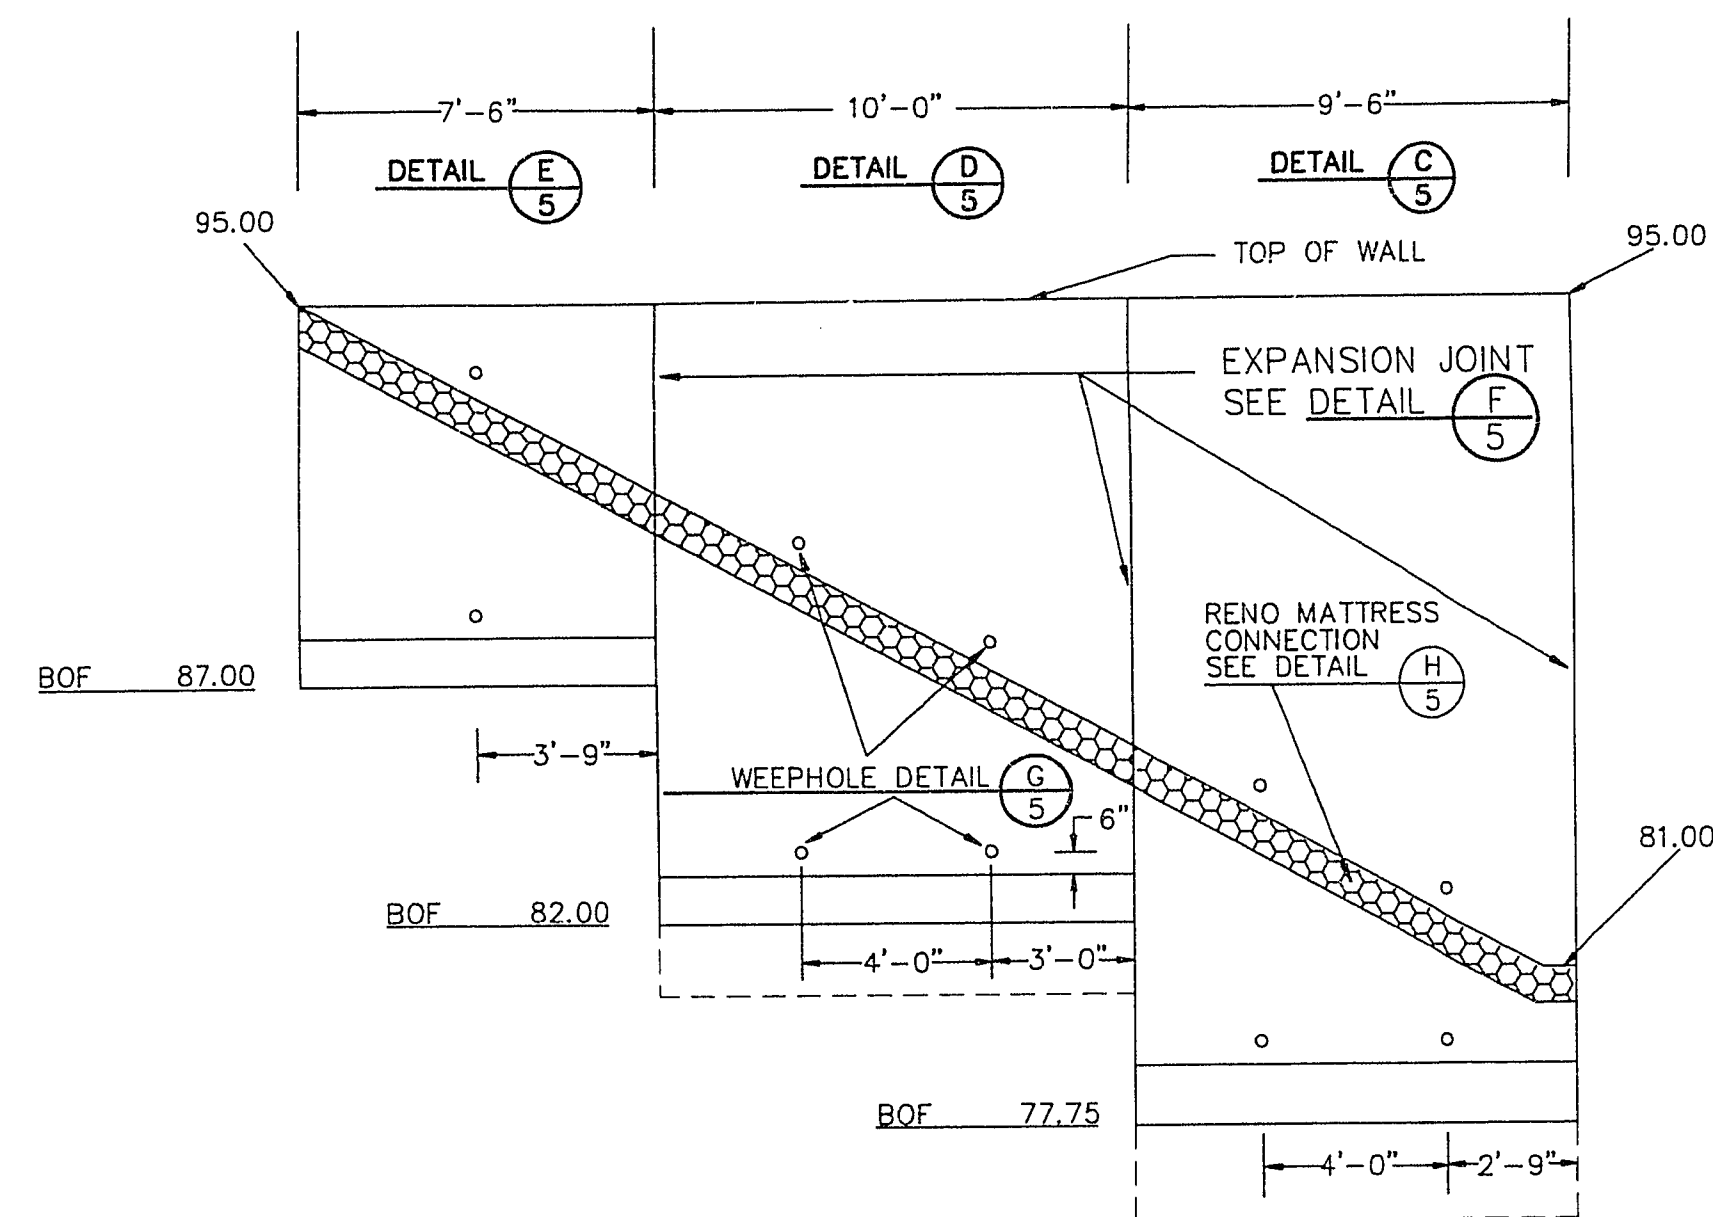
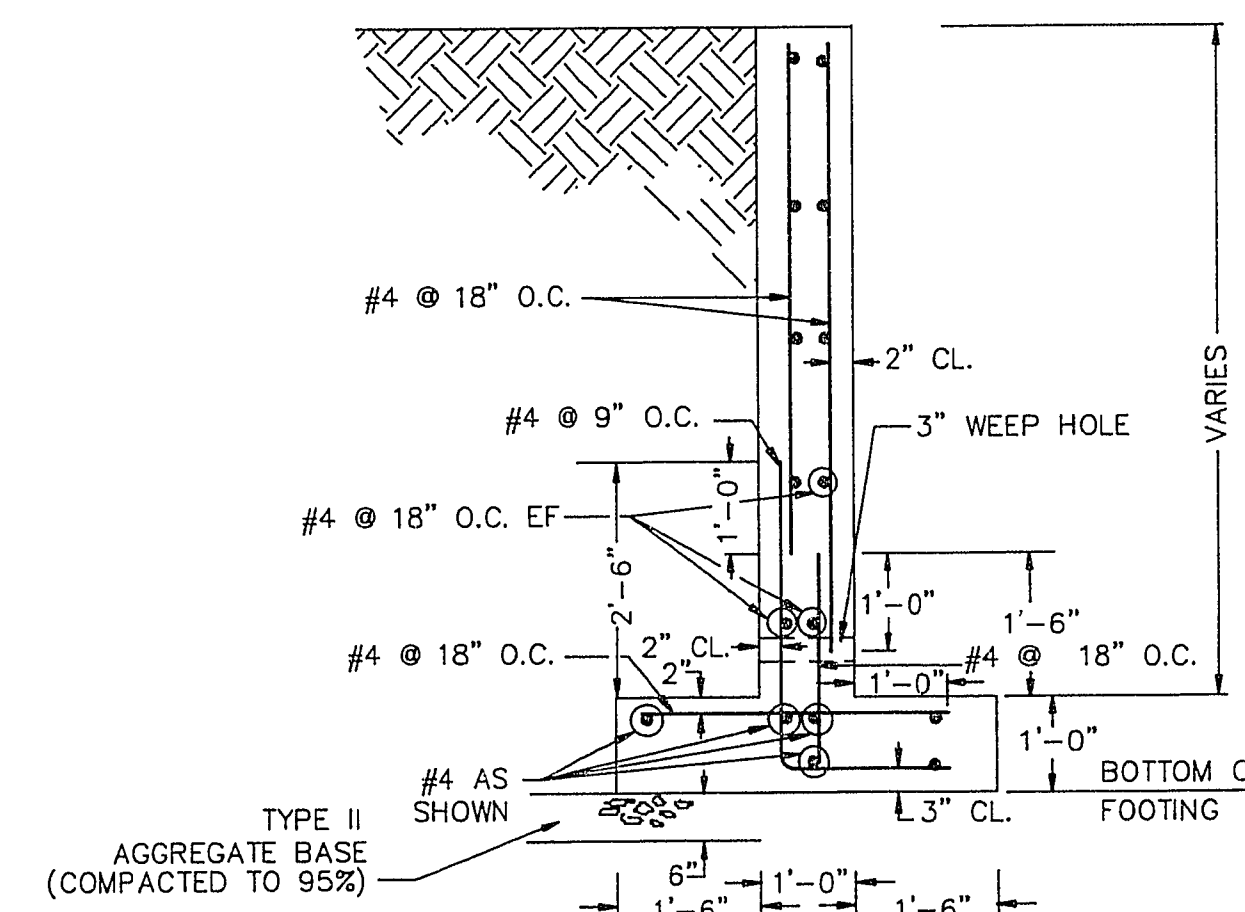
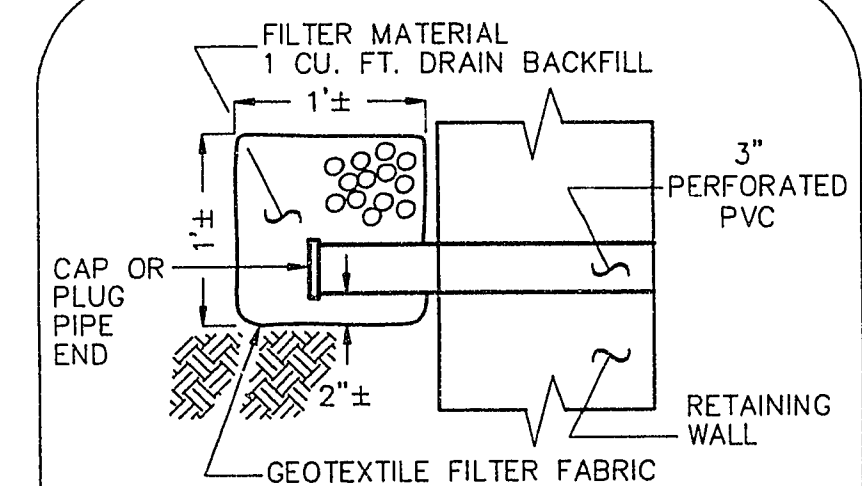
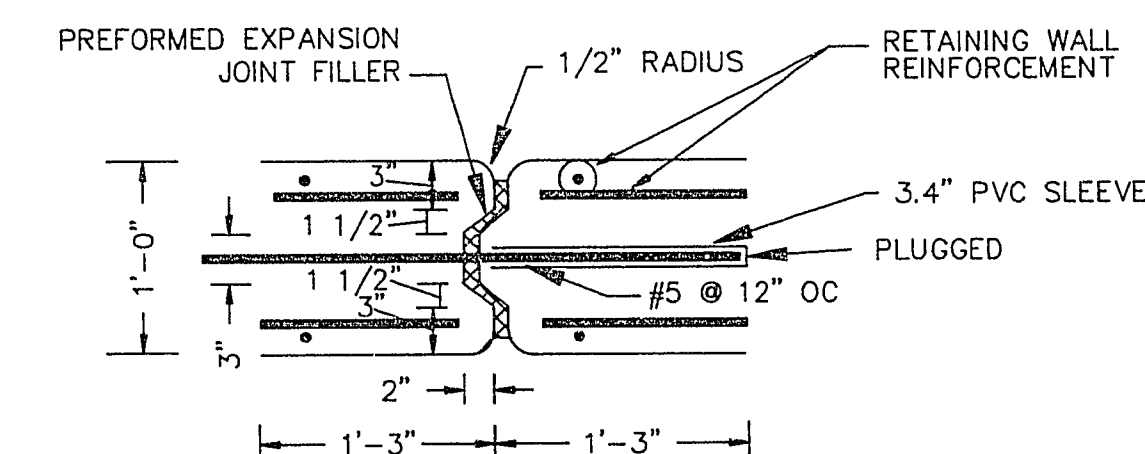


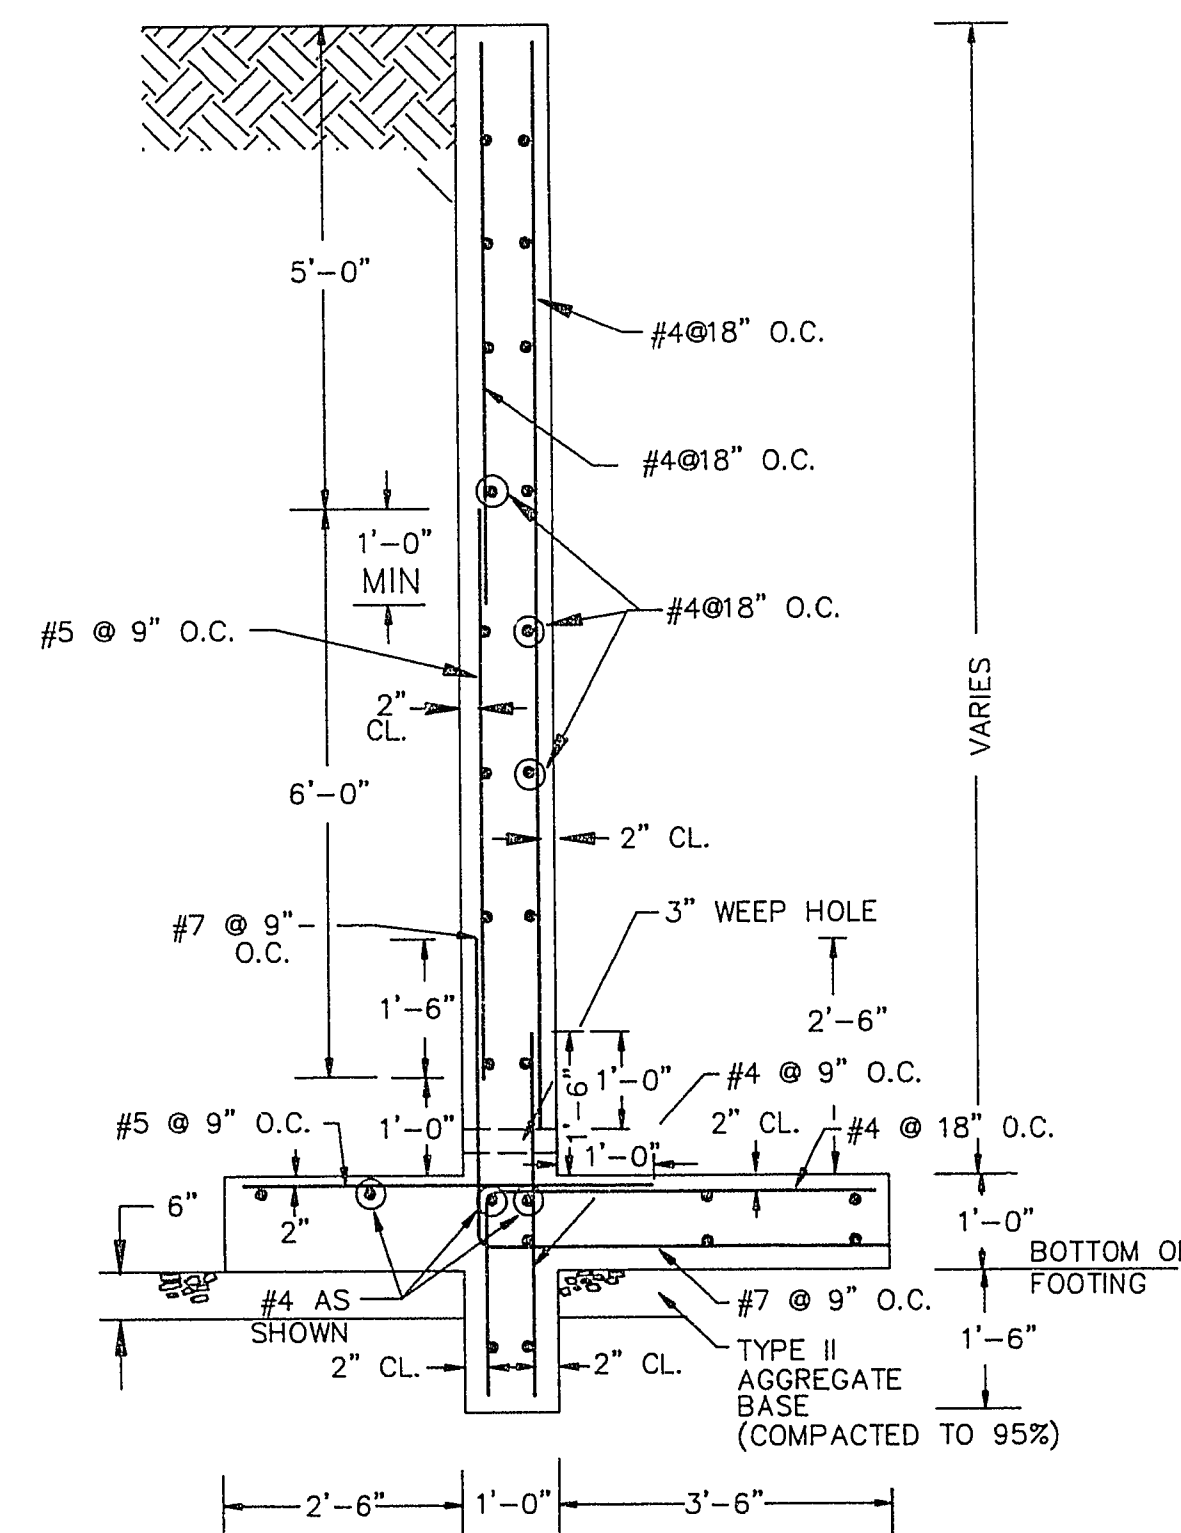

- NOTES:
1. THE RENO MATTRESS SHALL BE ATTACHED TO THE NORTH AND SOUTH RETAINING WALLS UTILIZING THE EYELET DETAILED ABOVE.
 2. THE EYELETS SHALL BE PLACED AT 18" O.C..
 3. THE EYELETS AND THE RENO MATTRESS SHALL BE WIRED TOGETHER USING 2.2 mm TIE WIRE.

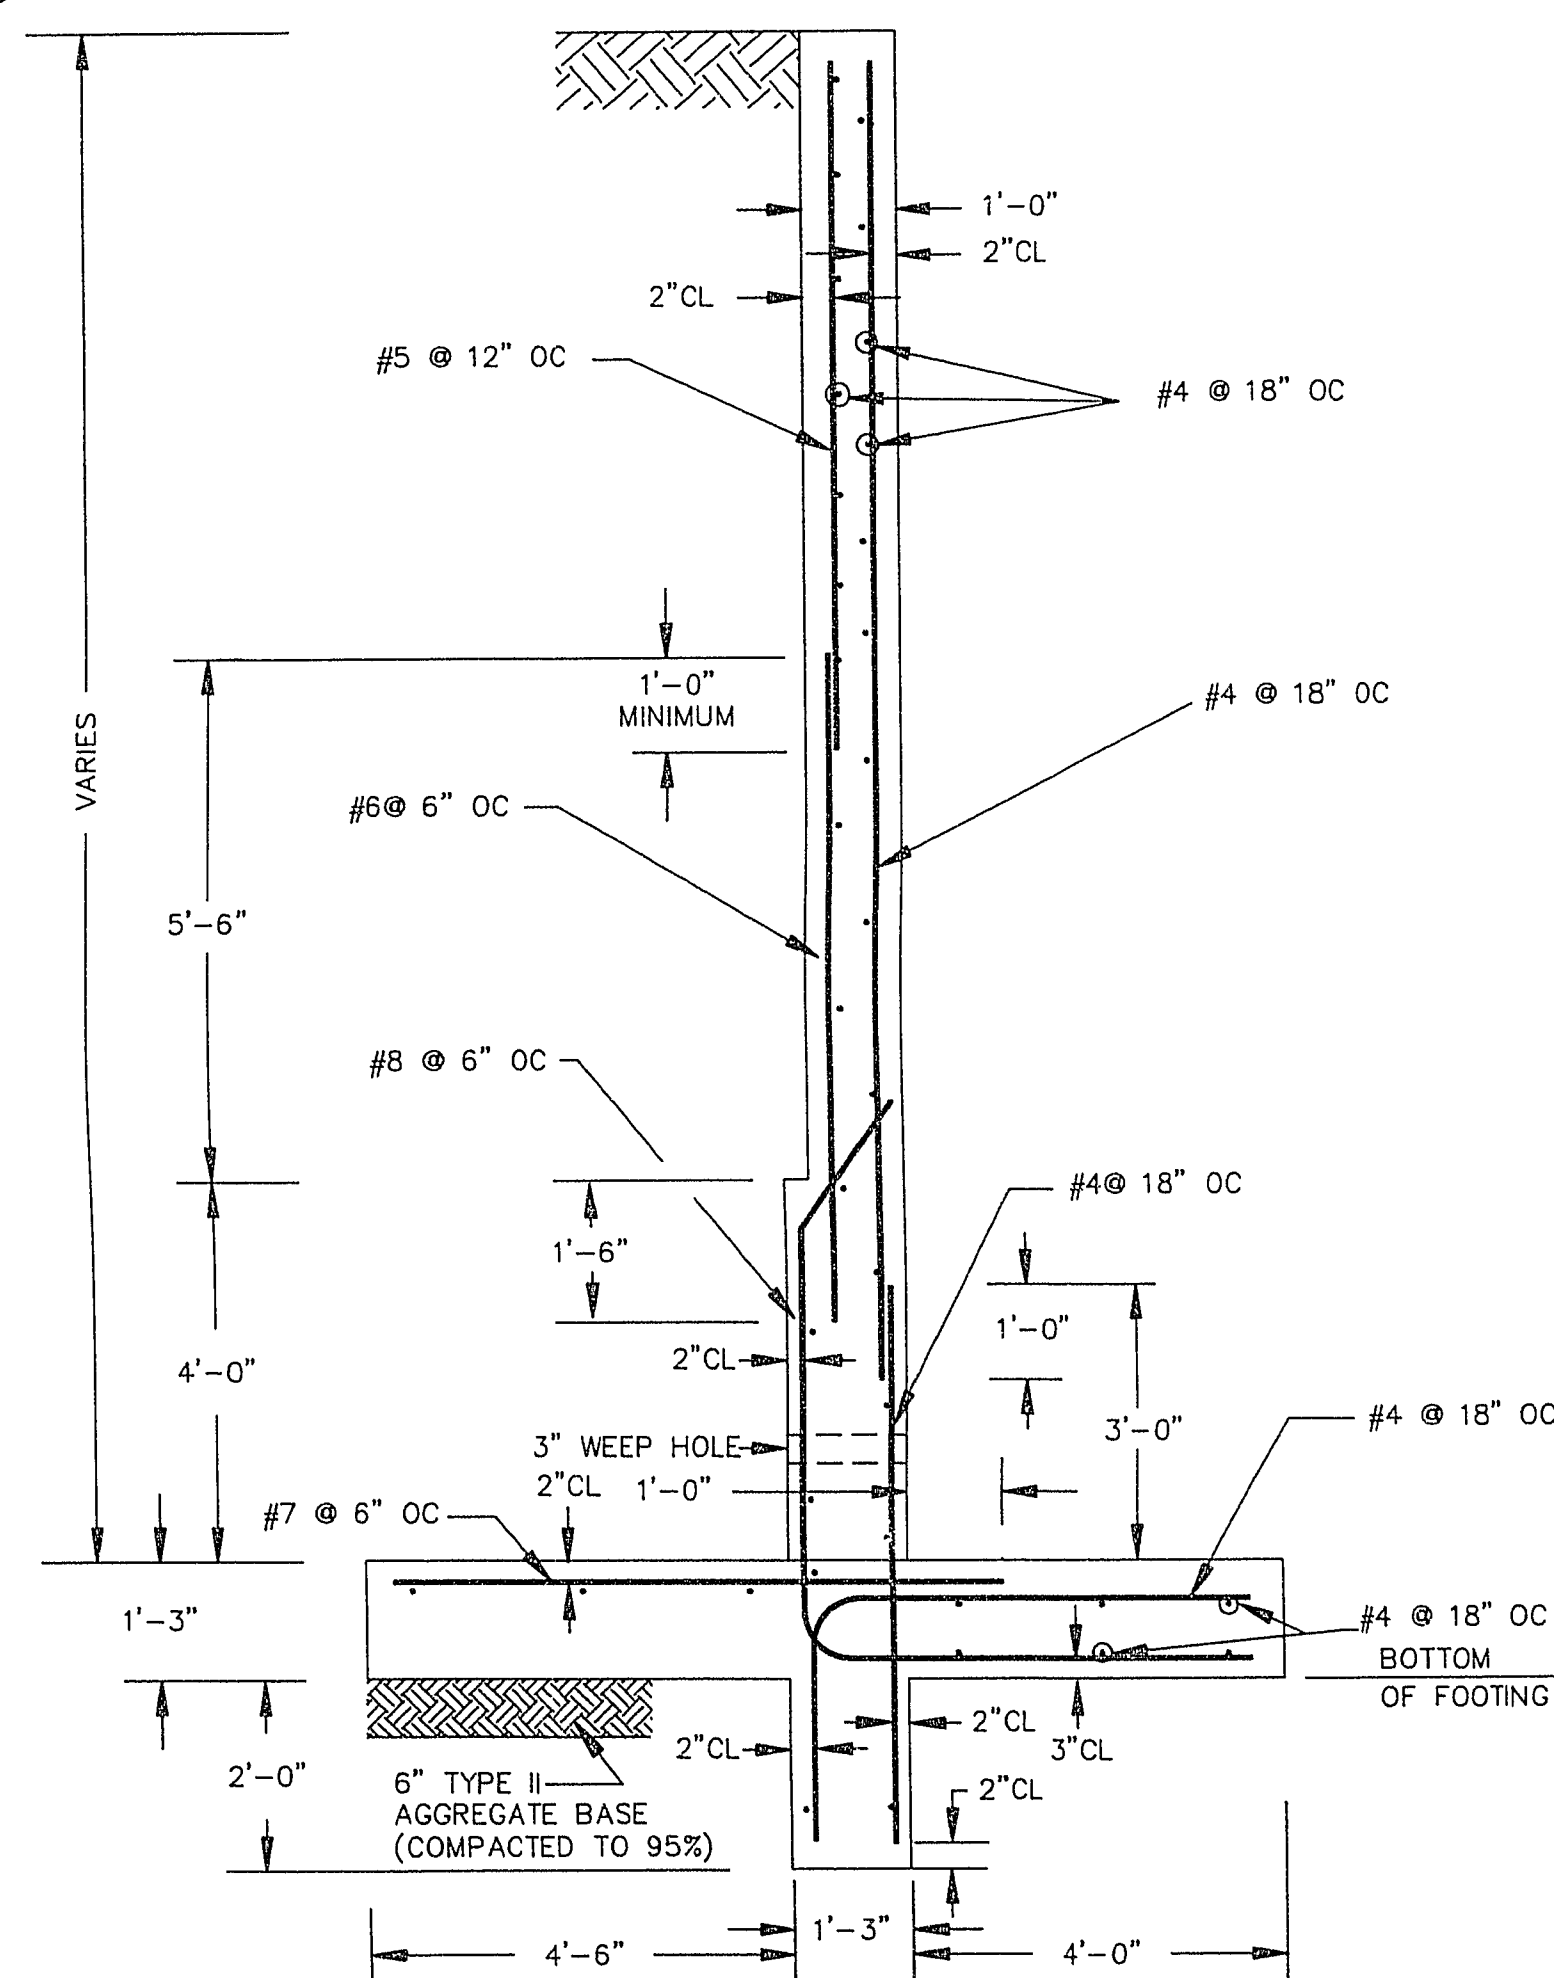

RECORD DRAWING

These Record Drawings have been prepared based on information provided by others. The Engineer has not verified the accuracy of such information and shall not be responsible for any errors or omissions which may be incorporated herein as a result.

Avoid cutting underground utility lines. It's costly.

**Call
before you
Dig**

1-800-227-2600
UNDERGROUND SERVICE ALERT (USA)

[illegible]

16/01/21
M. J. Smith

DESIGNED: LHC
 DRAWN: PSM
 CHECKED: LHC
 JOB NO: 343-90
 SCALE: AS
 HORIZ: NOTED
 VERT: NOTED

TROPICANA
NEVADA 89119
007

ARCHITECTS
1055 EAST
SUITE 800
LAS VEGAS
(702) 798-



ME
CONSULTING ENGINEERS

WALL

7. CONVEYANCE OUTFALL

& RETAINING DETAILS

**WILKINSON AVENUE
DOWD HILL ROAD
N:**

PROJECT: WASHI	DESCRIPTION: SANIT
SHEET	
5	
5	15