

DEPARTMENT OF PUBLIC WORKS

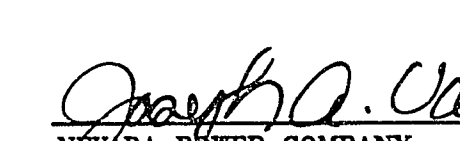
APPROVALS

 12-12-91
CITY ENGINEER DATE

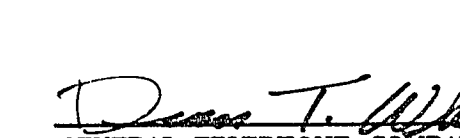
 12/12/91
CLV CHIEF OF CONSTRUCTION SERVICES DATE

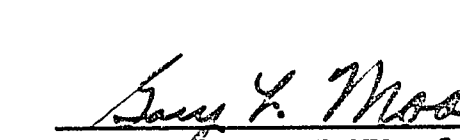
 12/12/91
CLV CHIEF OF DESIGN ENGINEERING DATE

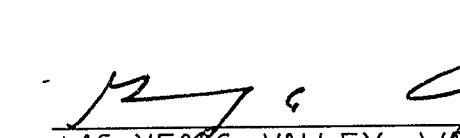
 12/12/91
CLARK COUNTY REGIONAL FLOOD CONTROL DISTRICT DATE

 11/12/91
NEVADA POWER COMPANY DATE

 11-12-91
SOUTHWEST GAS COMPANY DATE

 11/12/91
CENTRAL TELEPHONE COMPANY DATE

 11-12-91
PRIME CABLE COMPANY - COMMUNITY CABLE T.V., INC. DATE

 3-25-92
LAS VEGAS VALLEY WATER DISTRICT DATE

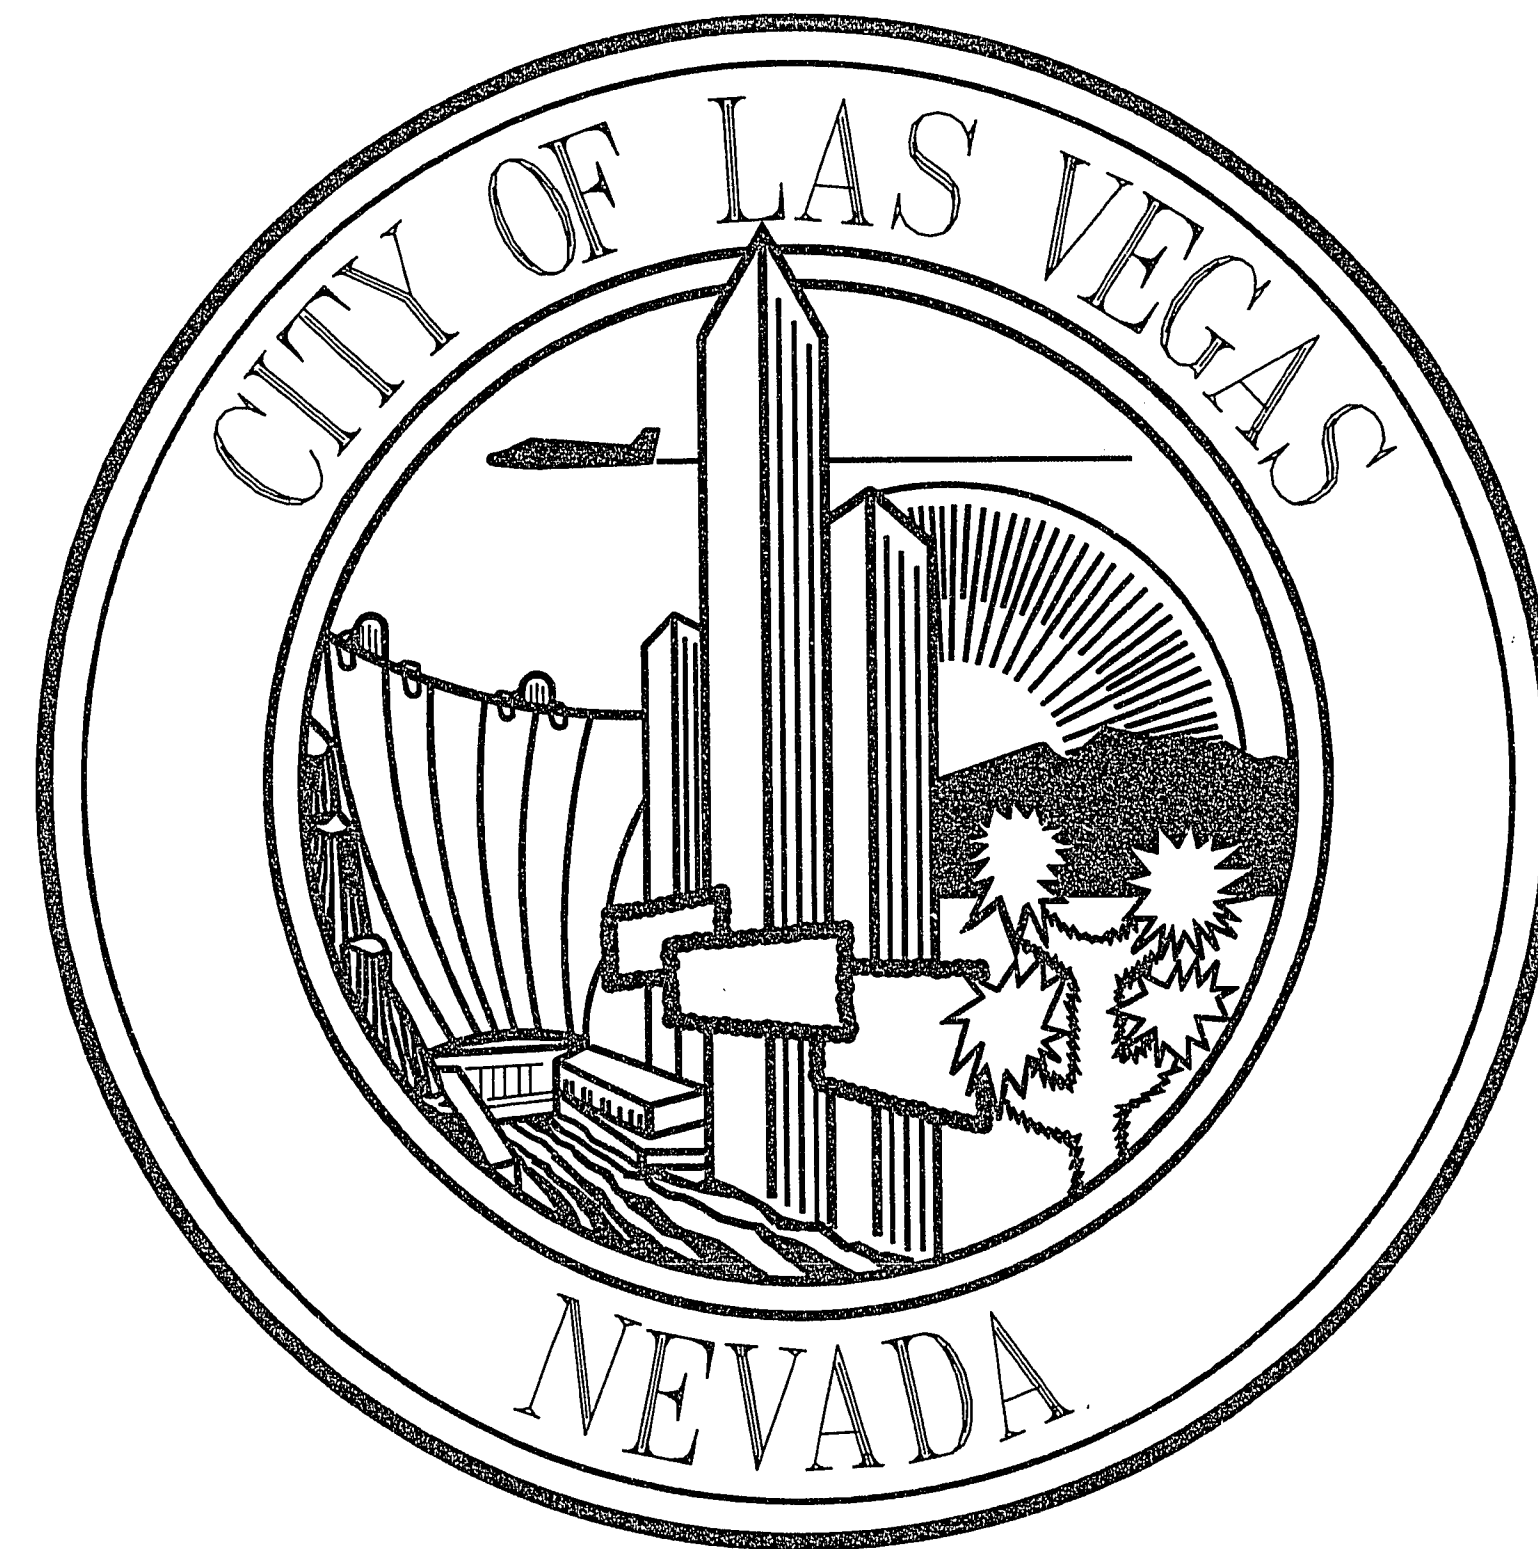
Mayor:
Jan Laverty Jones

Councilmen:
Bob Nolen
Arnie Adamsen
Scott Higginson
Frank Hawkins Jr.

City Manager:
William J. Noonan

Director of Public Works:
Richard D. Goecke

City Engineer:
Gary A. Presswood, P.E.



WASHINGTON AVENUE CONVEYANCE SYSTEM IMPROVEMENTS

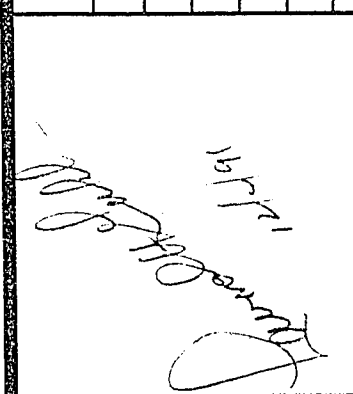
SANDHILL ROAD OUTFALL STRUCTURE

FUNDING PROVIDED BY CLARK COUNTY REGIONAL FLOOD CONTROL DISTRICT

RECORD DRAWING
These Record Drawings have been prepared based on information provided by others. The Engineer has not verified the accuracy of such information and shall not be responsible for any errors or omissions which may be incorporated herein as a result.

REVISIONS

No.	Date	Description
1	2/6/92	SEE SHEET 3



DESIGNED: R. T. P. M.
DRAWN: J. H. G.
CHECKED: J. H. G.
JOB NO. 943-80
SCALE: NONE
HORIZ. NONE
VERT. NONE

1055 EAST TROPICANA
SUITE 800
LAS VEGAS, NEVADA 89119
(702) 798-1007

CONSULTING ENGINEERS

PROJECT: CITY OF LAS VEGAS
WASHINGTON AVENUE CONVEYANCE SYSTEM

DESCRIPTION: COVER SHEET
BID No. 92.1730.18

SHEET
1
OF 15