



Call before you Dig.
1-800-227-2600
UNDERGROUND SERVICE ALERT (USA)

SCALE: 1"=40'

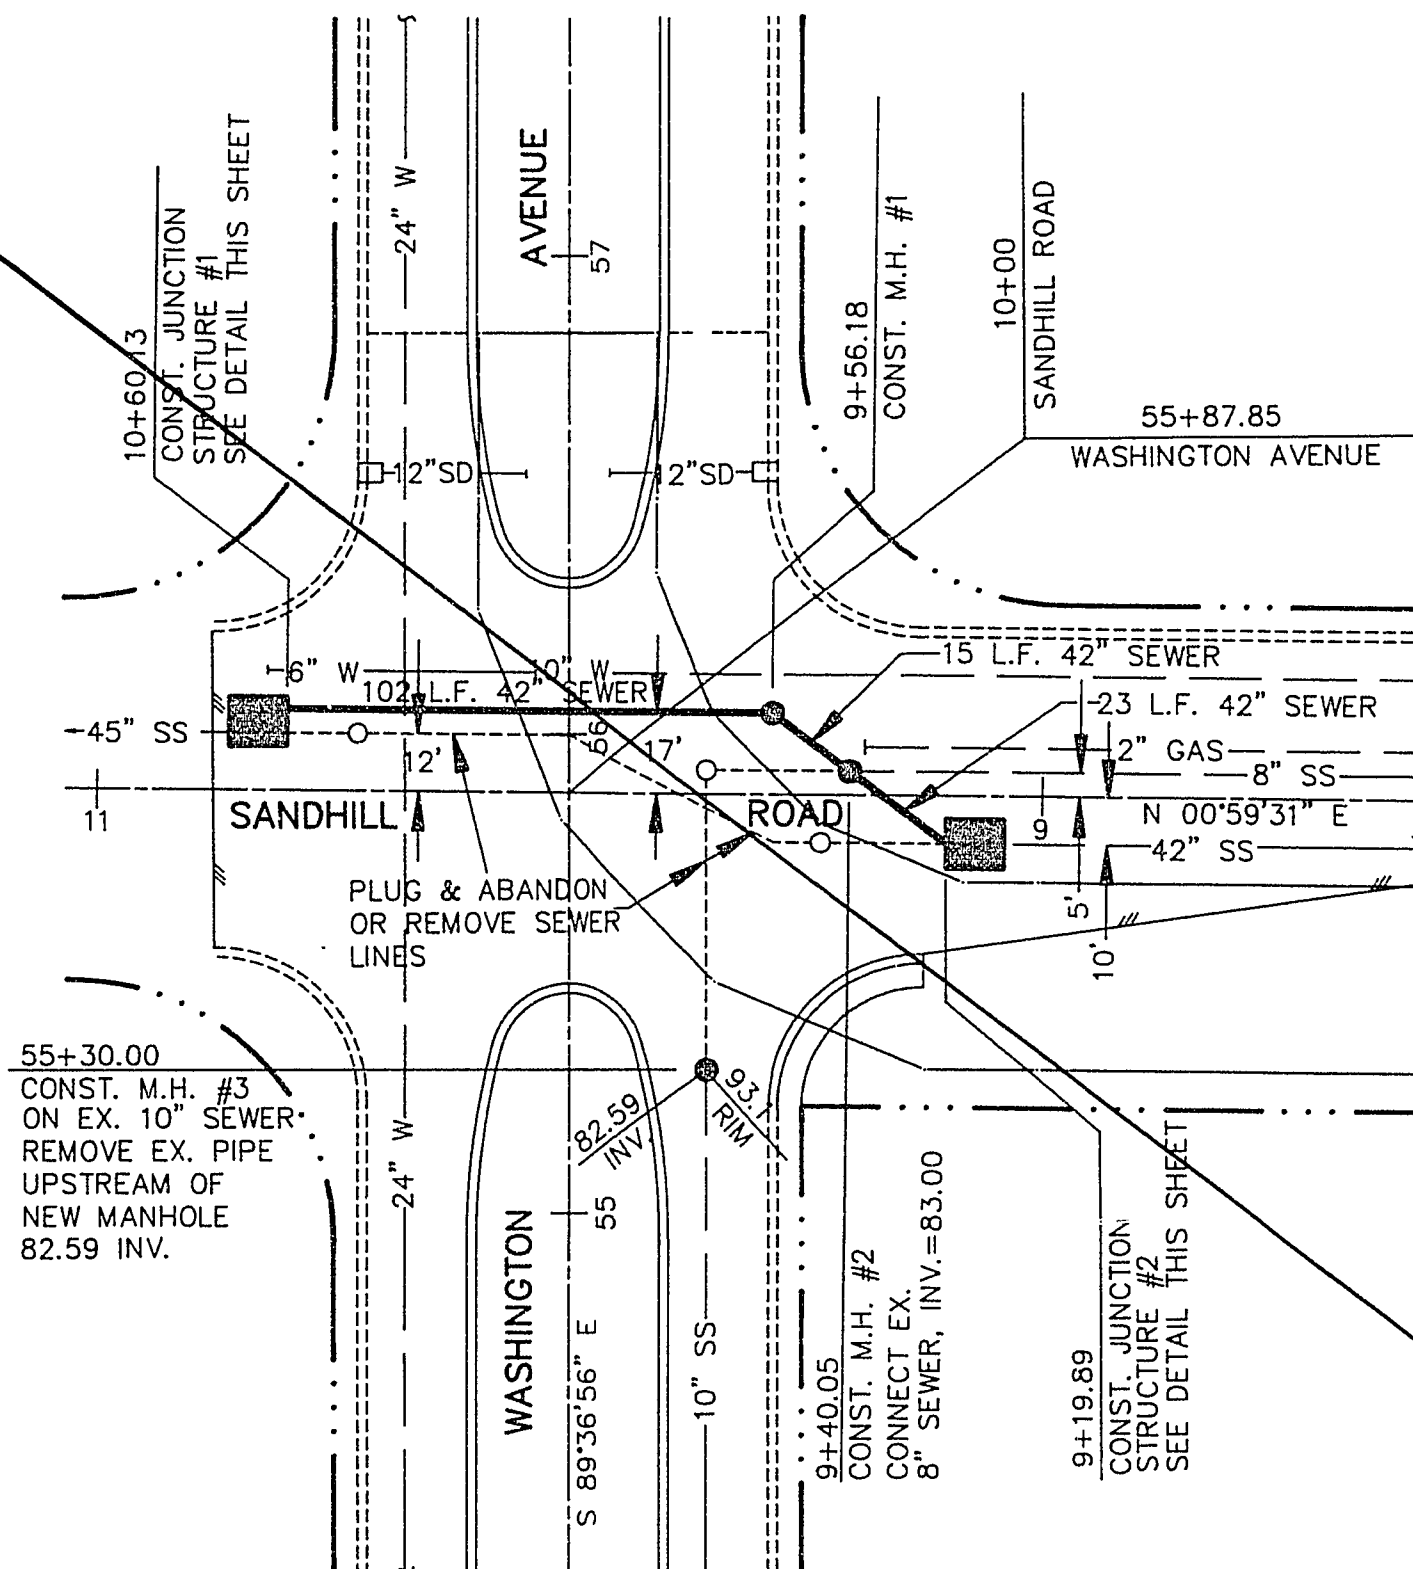


NOTE:
THE FOLLOWING SEWER IMPROVEMENTS SHALL
BE LINED WITH PVC SHEET LINER AMERON T-LOCK
OR APPROVED EQUAL:
1. ALL NEW 42" RCP
2. UPPER PORTIONS OF MANHOLES #1 AND #2
3. UPPER PORTIONS OF JUNCTION STR. #1 AND #2

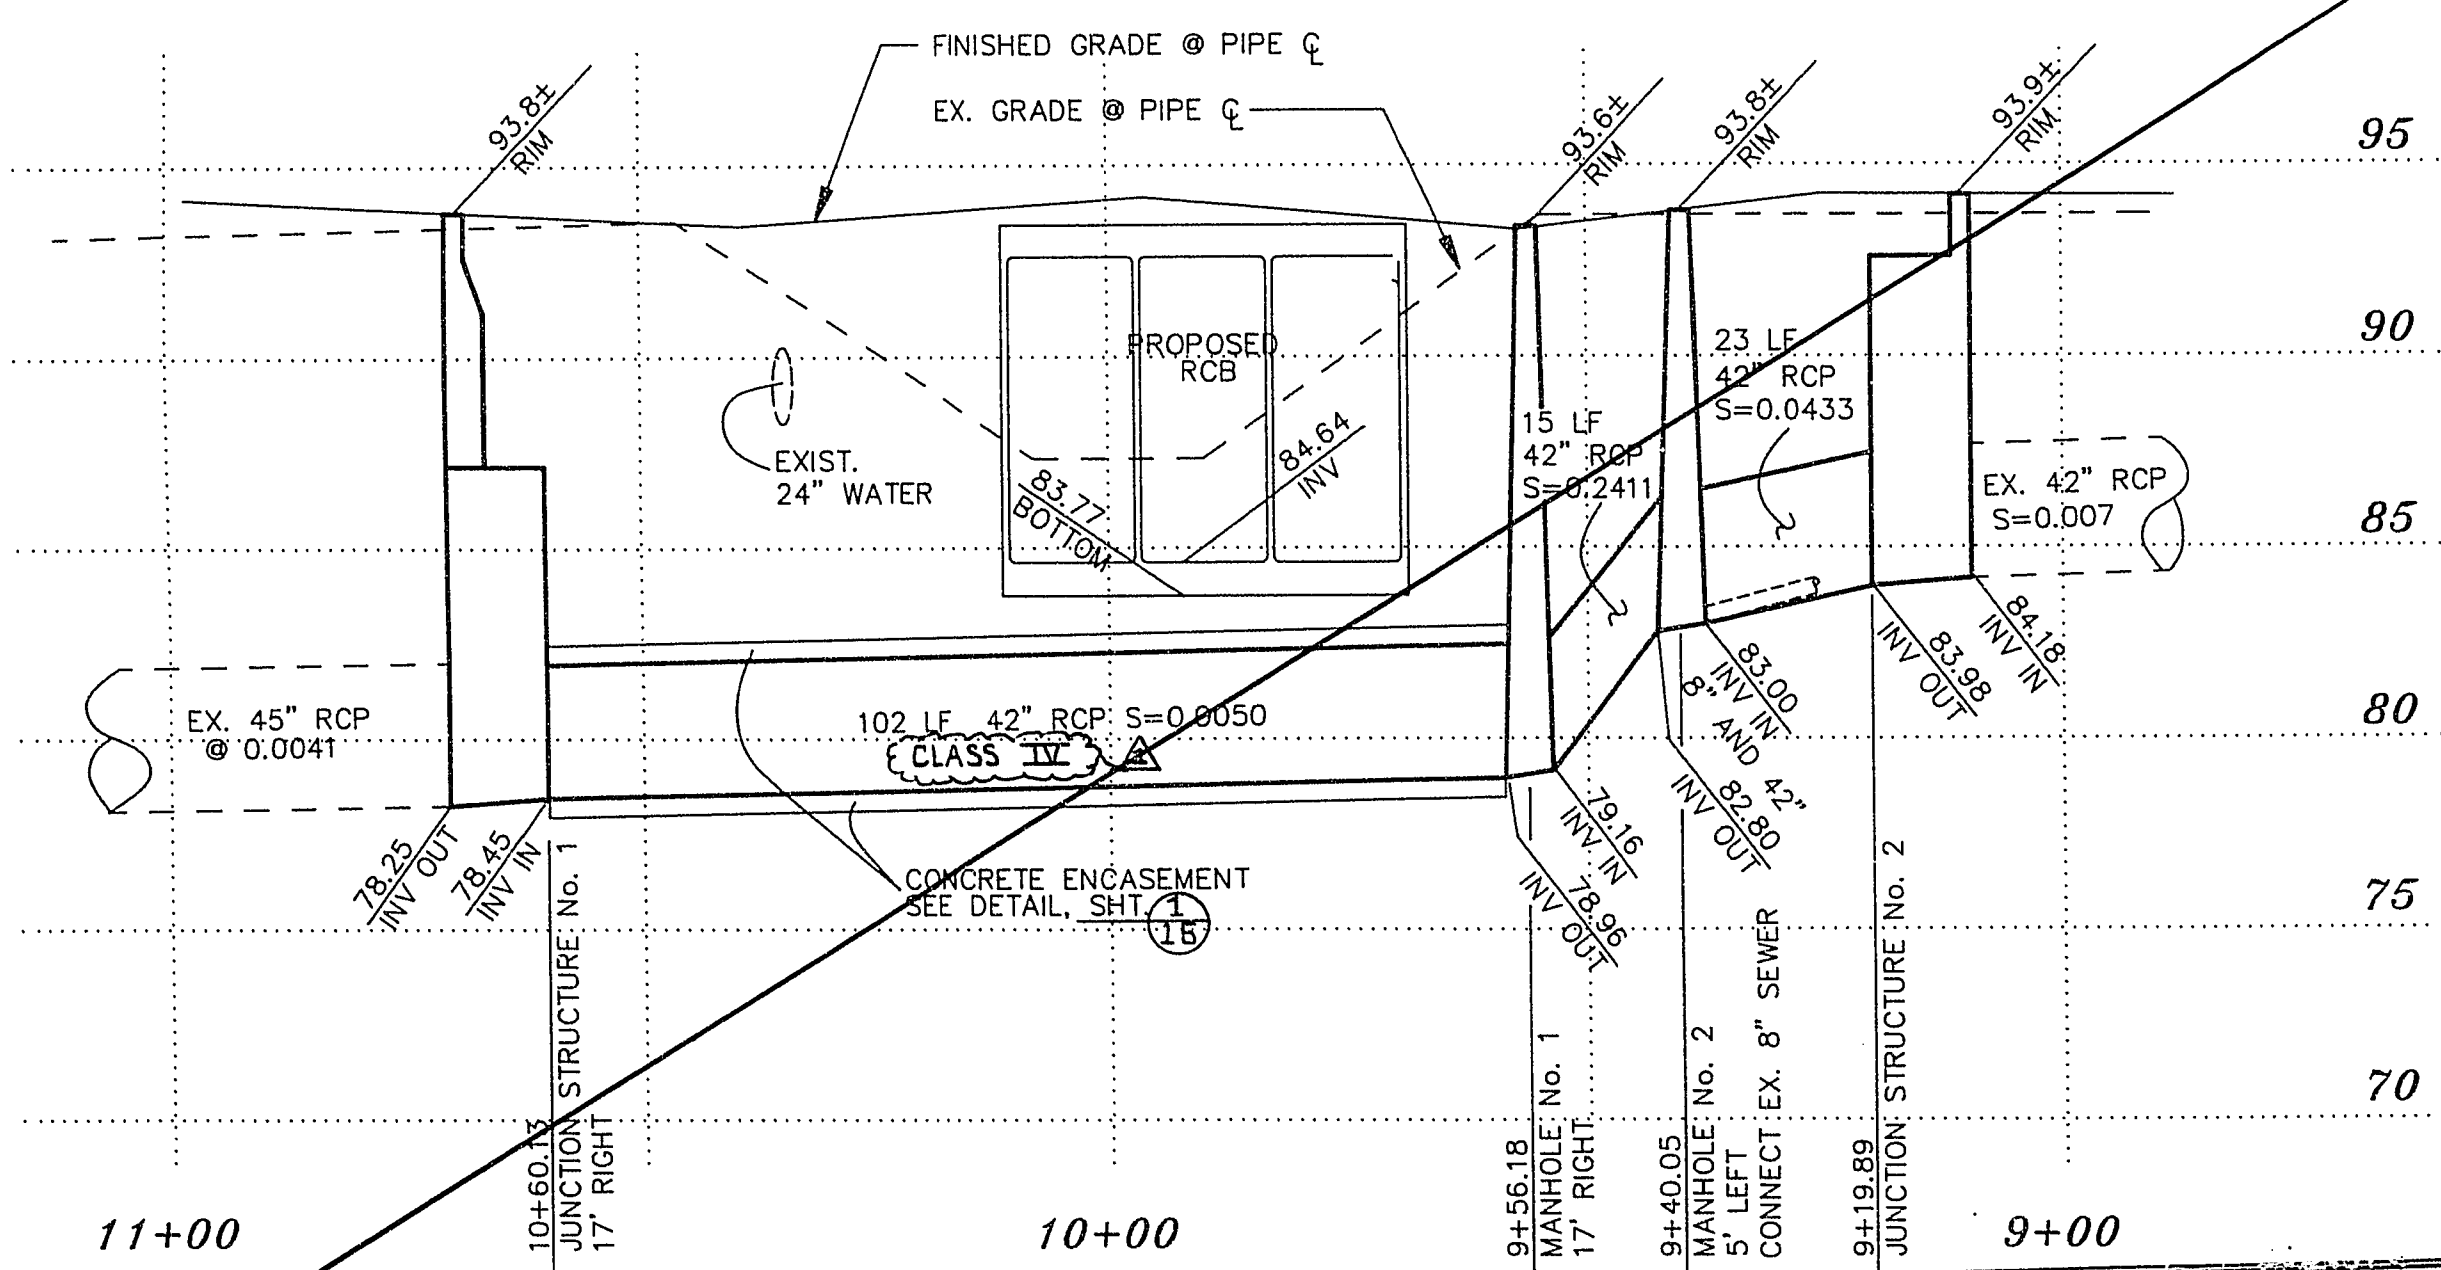


SCALE:
HOR. 1"=20'
VERT. 1"=5'

RECORD DRAWING
These Record Drawings have been prepared
based on information provided by others.
The Engineer has not verified the accuracy of
such information and shall not be responsible
for any errors or omissions which may be
incorporated herein as a result.

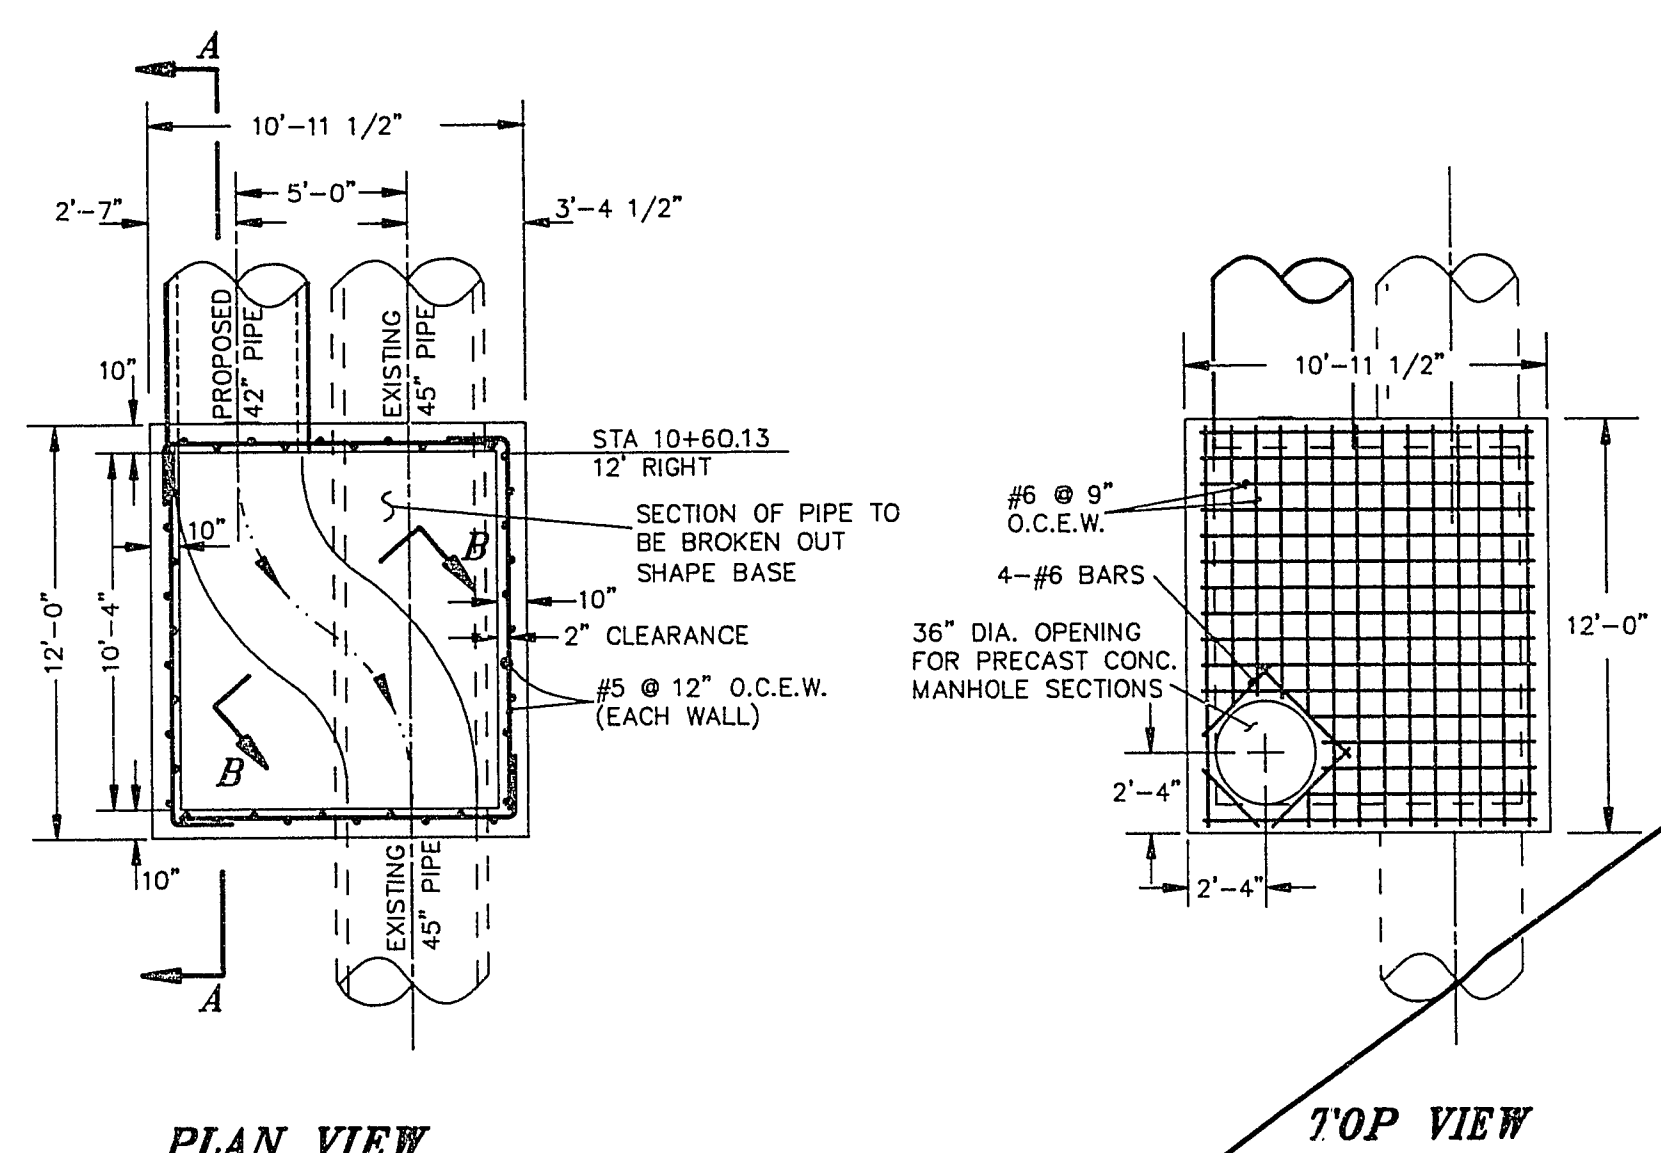


DELETED

JUNCTION STRUCTURE #1
N.T.S.

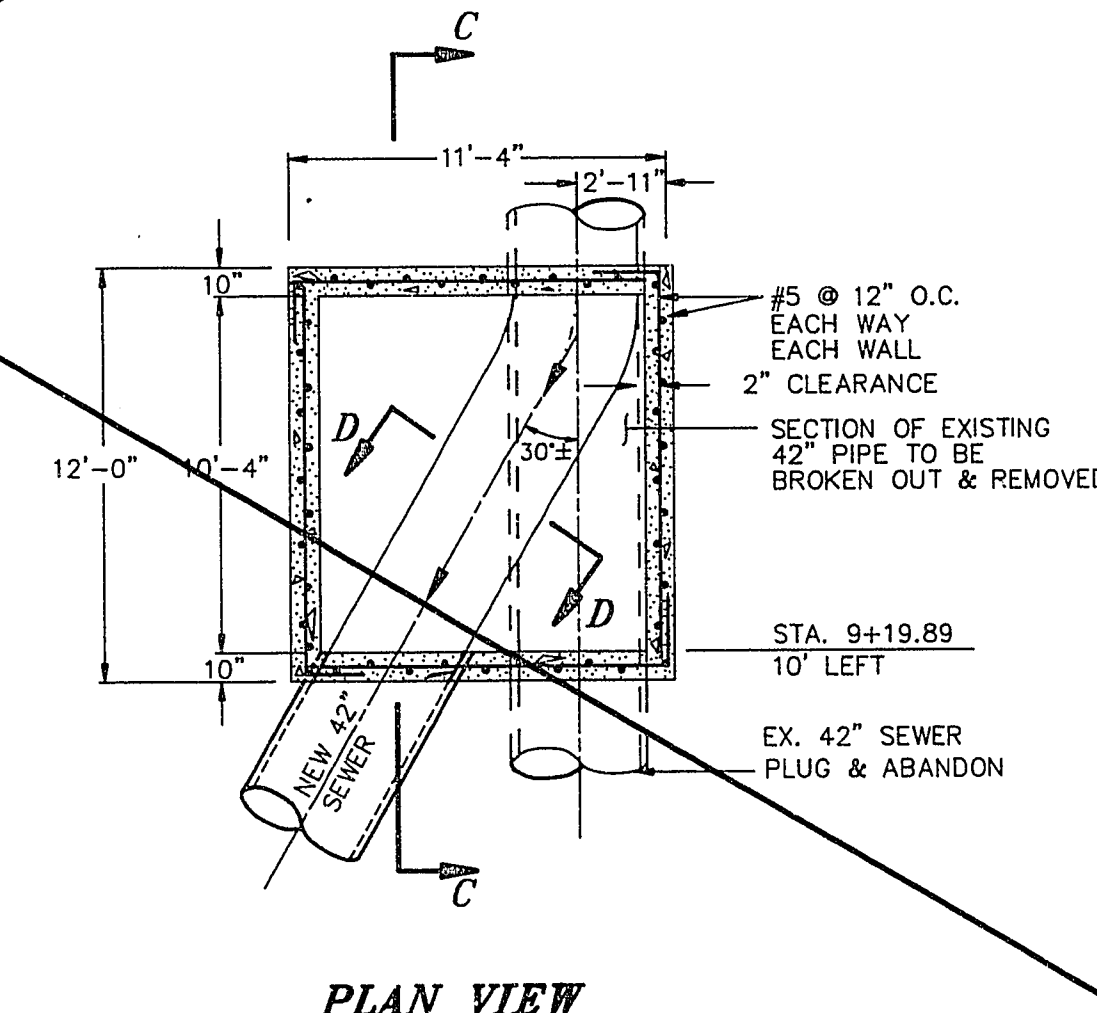


PLAN VIEW

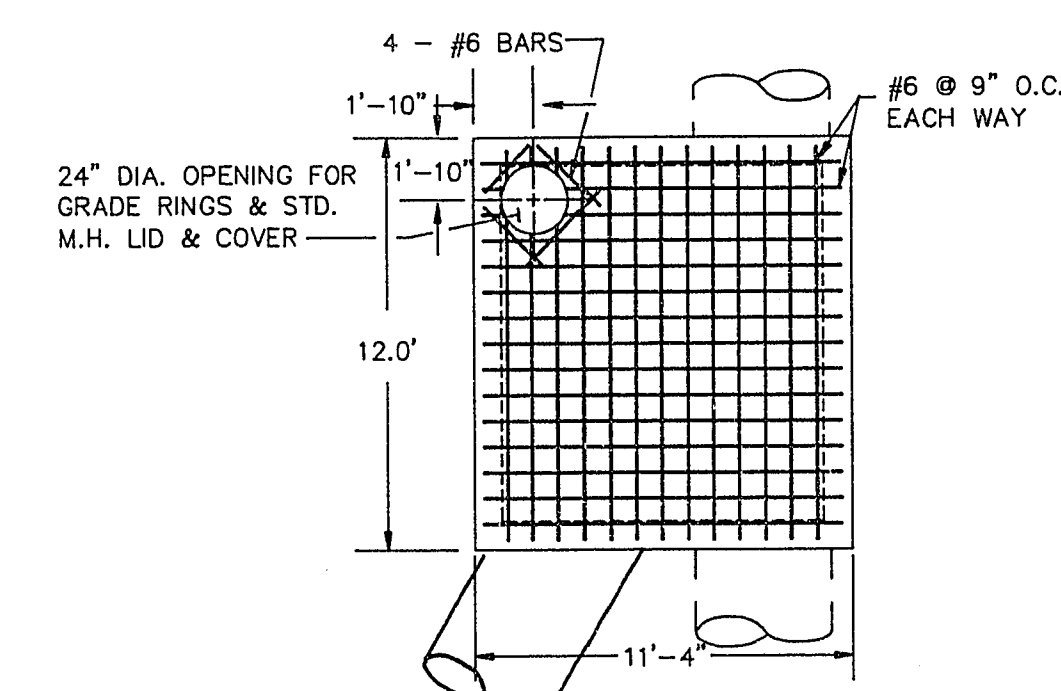


TOP VIEW


JUNCTION STRUCTURE #2
N.T.S.

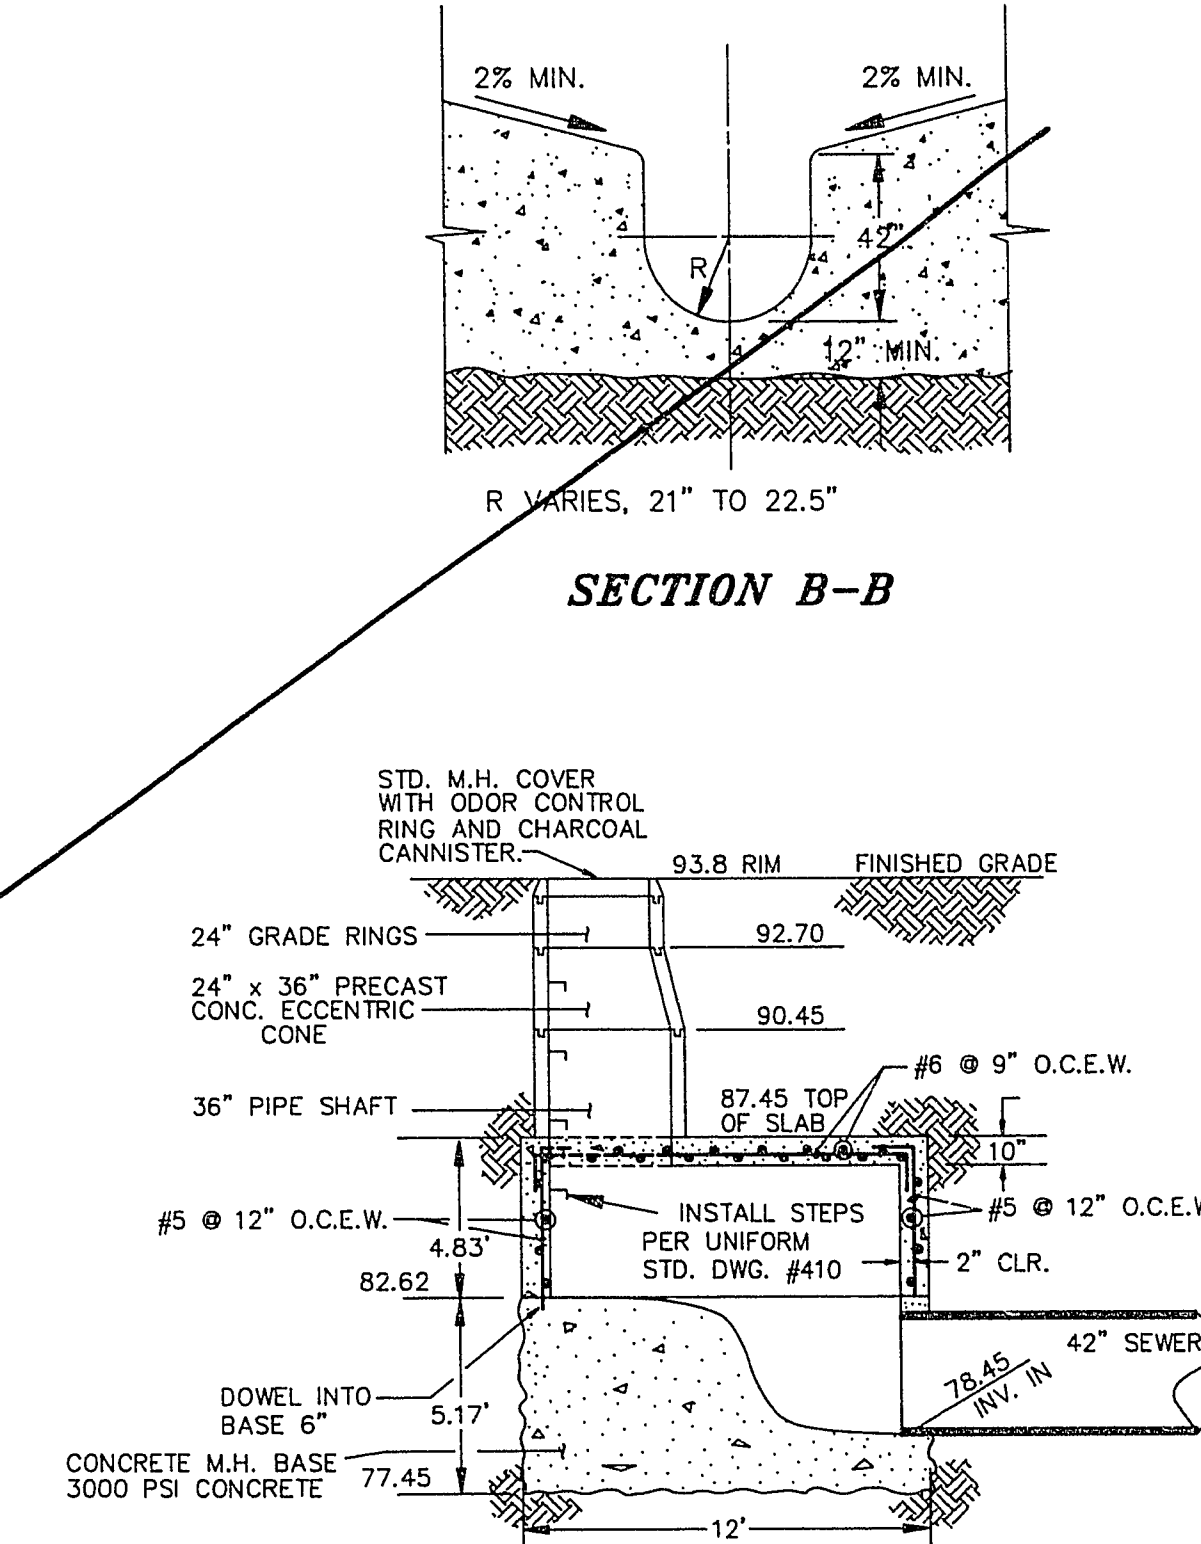

SECTION A-A

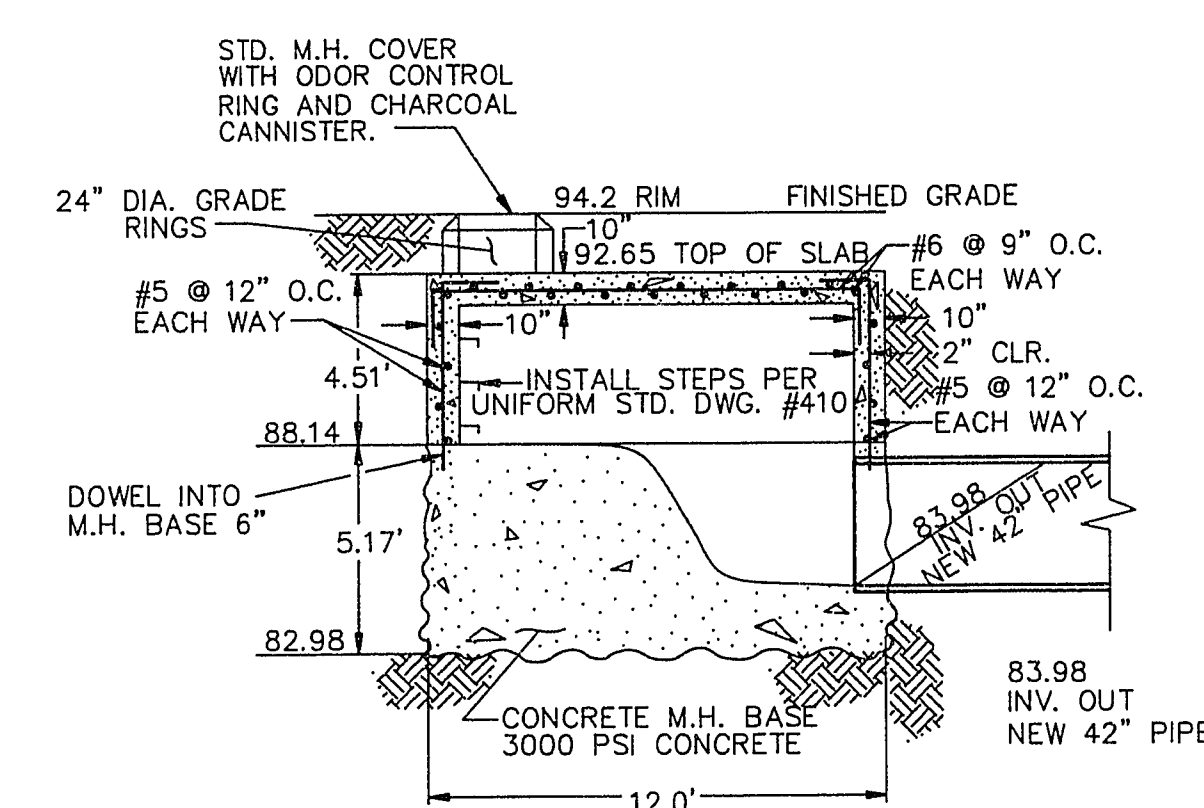

SECTION C-C

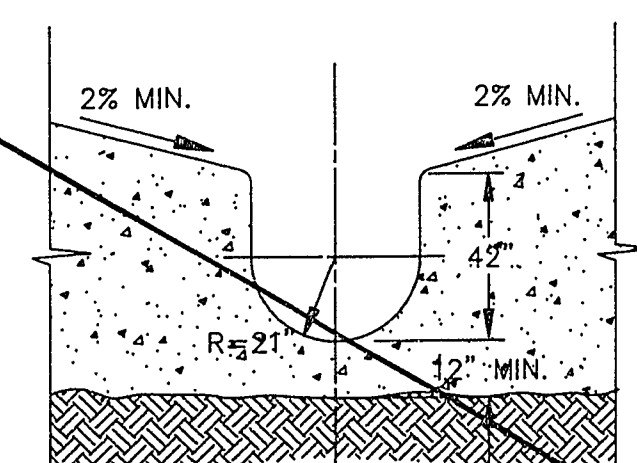

SECTION D-D

REVISIONS		CHD	APPD
No.	Date	By	App.
1	12/12/91	W. J. GIBLER	W. J. GIBLER
DESIGNED BY: BROW		DRWN: B.B./P.M.	
CHECKED BY: L. GIBLER		JOB NO: 343-90	
SCALE: AS NOTED		HORIZ: AS NOTED	
VERT: AS NOTED			
PROJECT: WASHINGTON AVE. CONVEYANCE SYSTEM			
SANDHILL ROAD OUTFALL STRUCTURE			
DESCRIPTION: SANITARY SEWER RELOCATION			
SHEET 14 OF 15			