
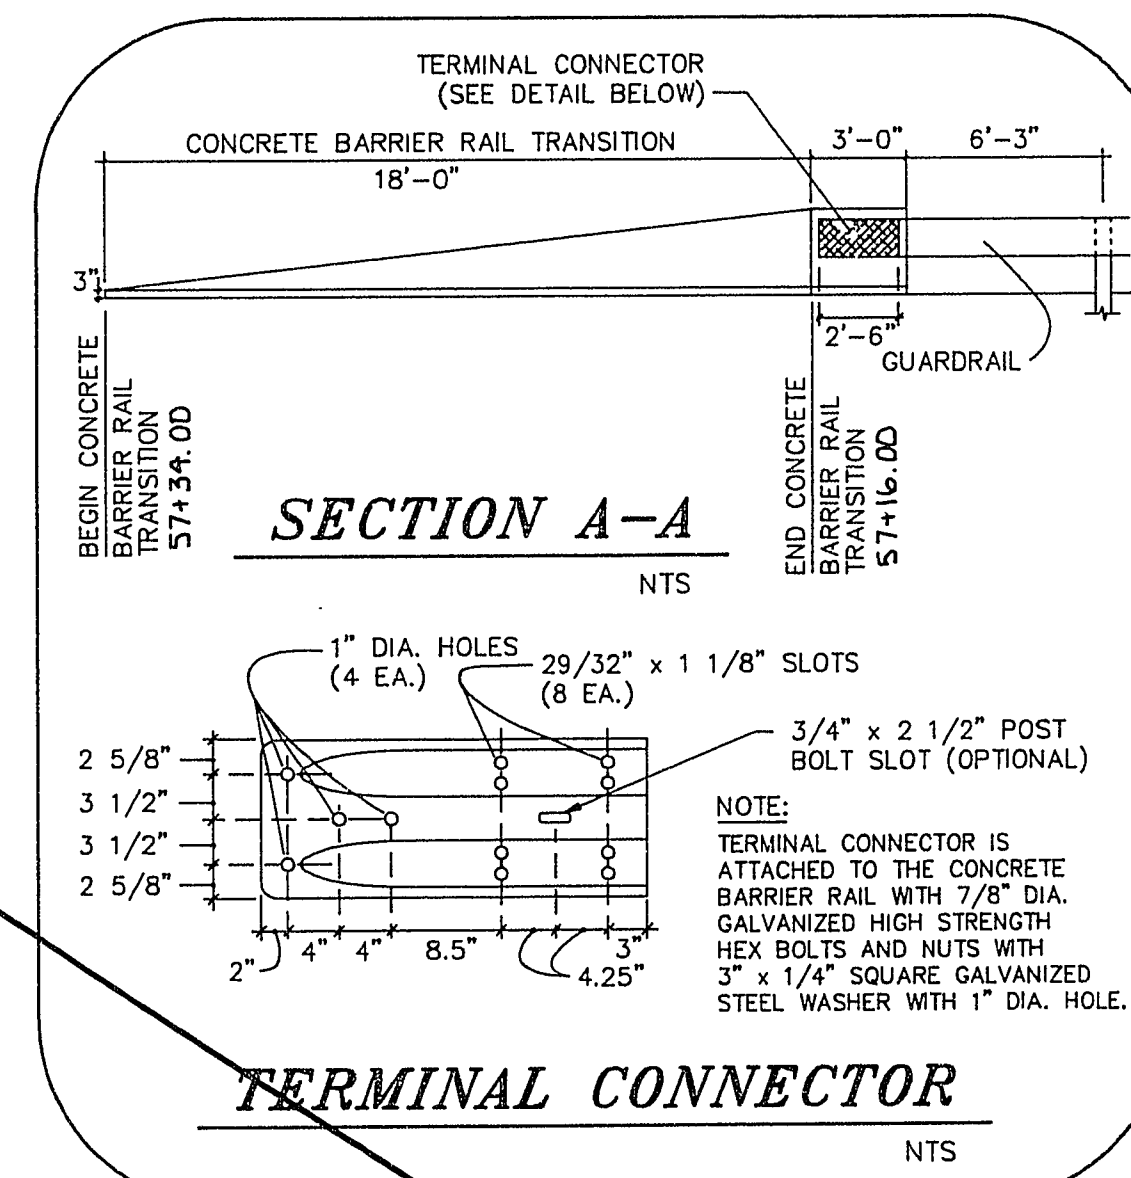
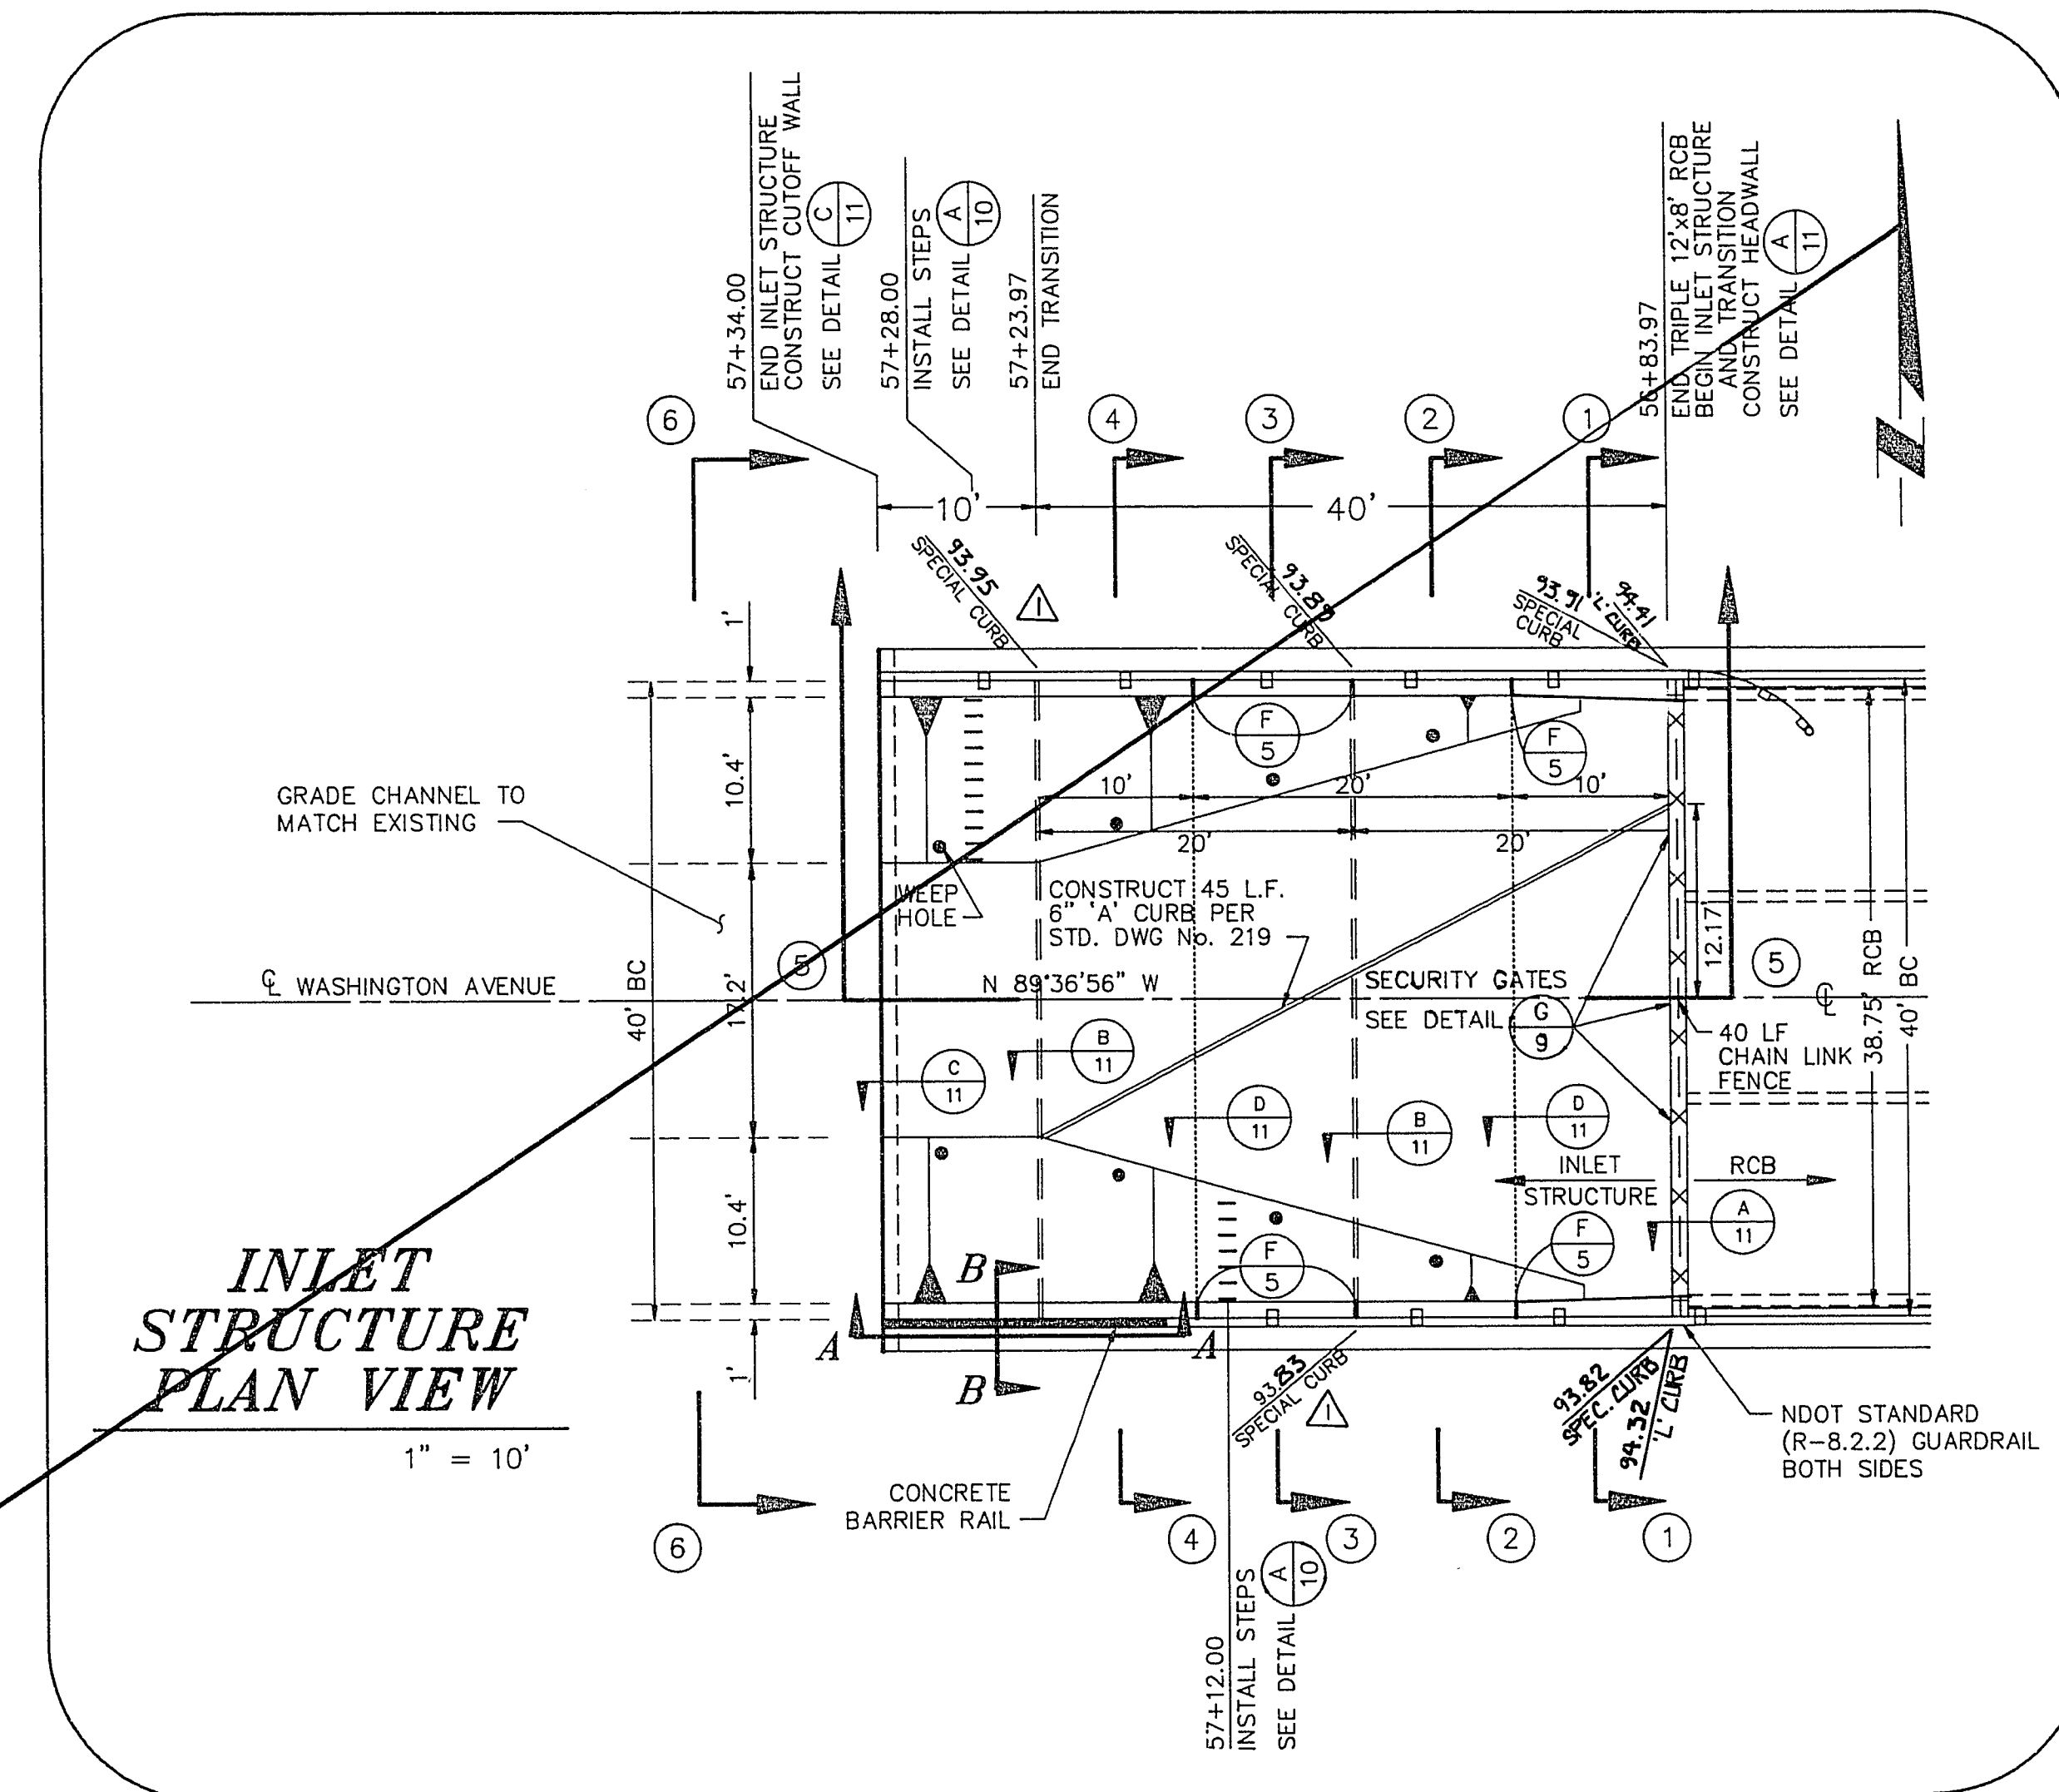
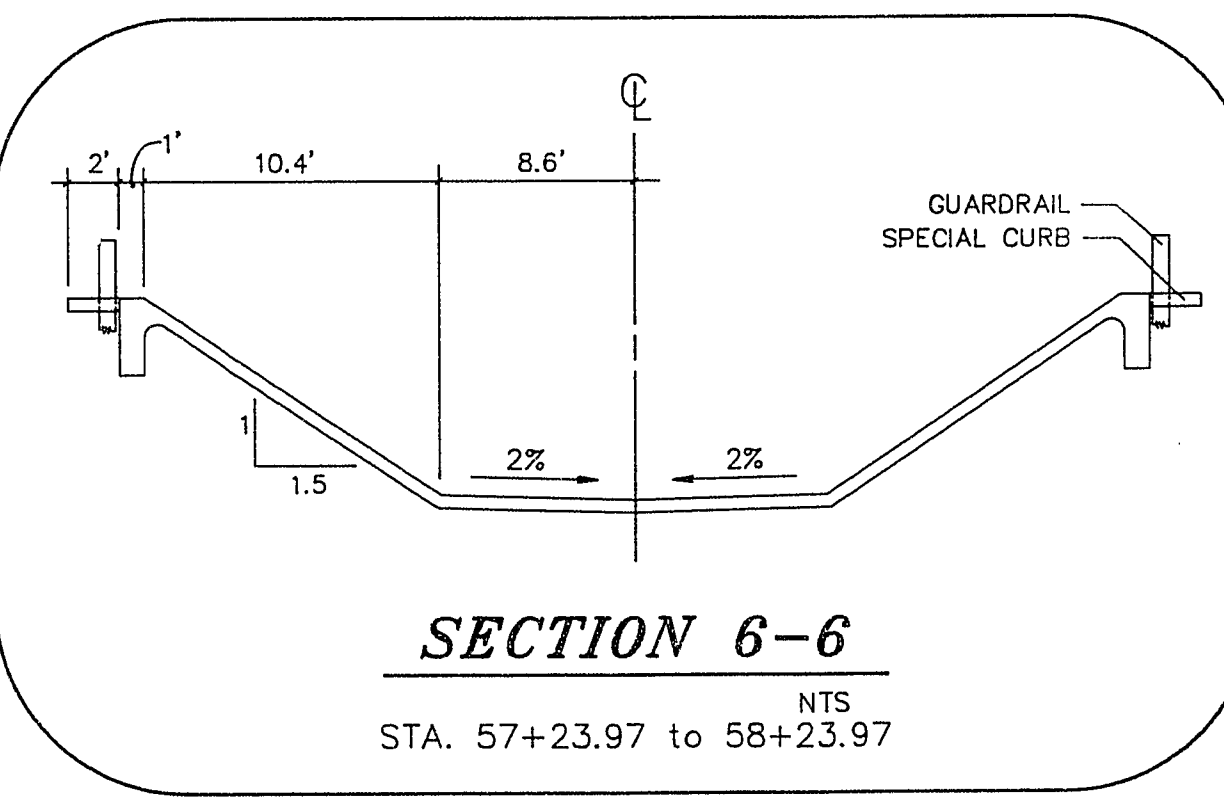
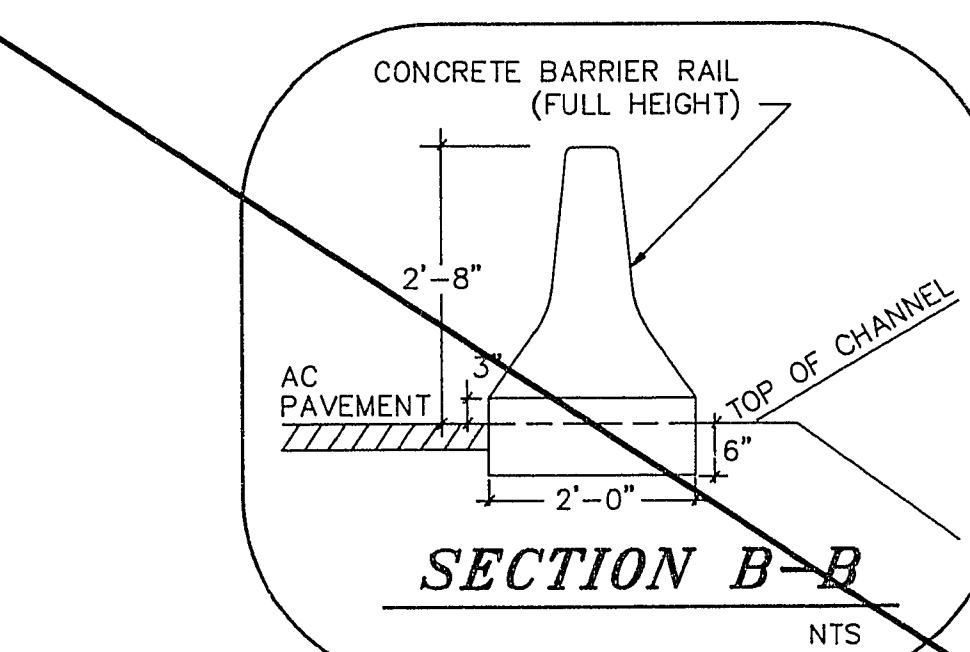
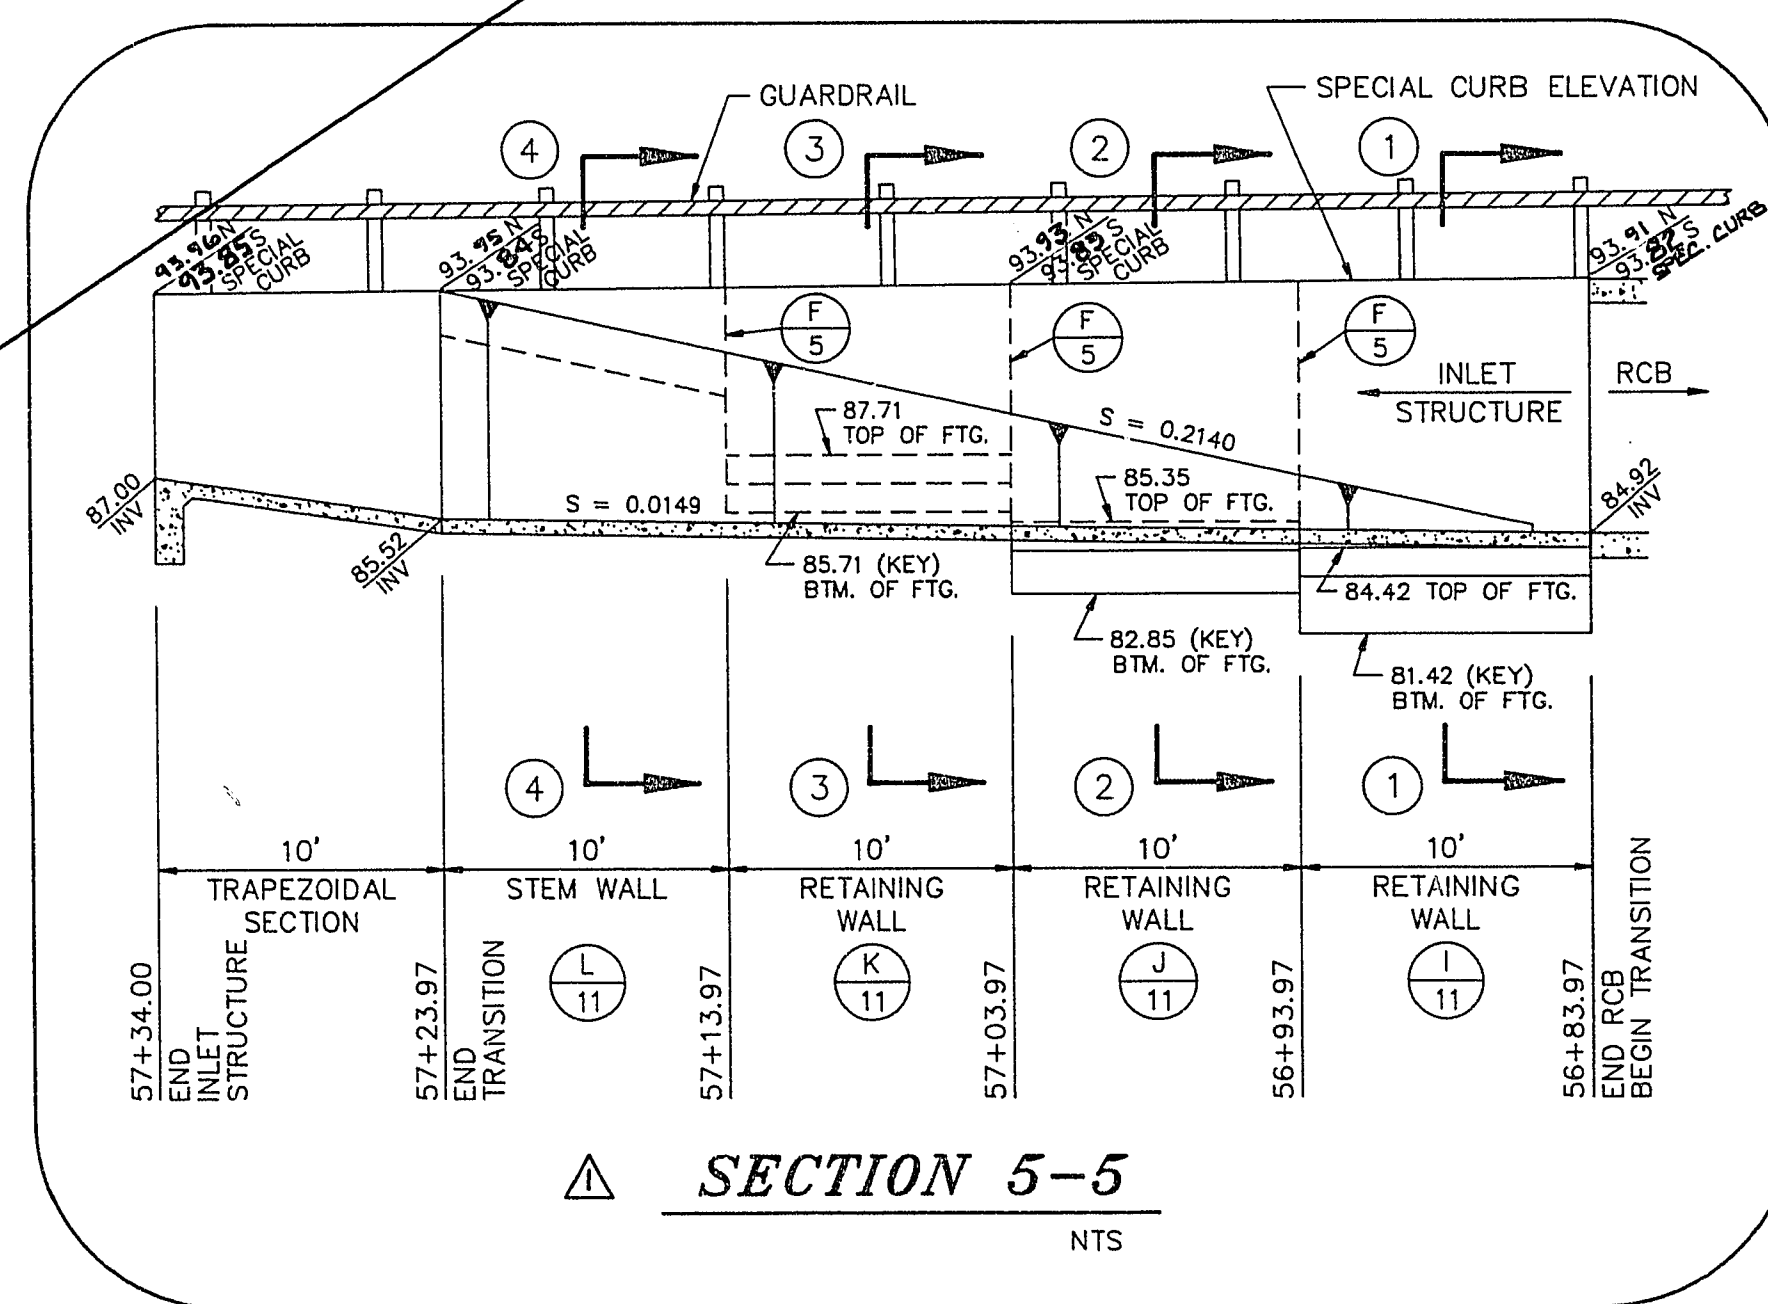
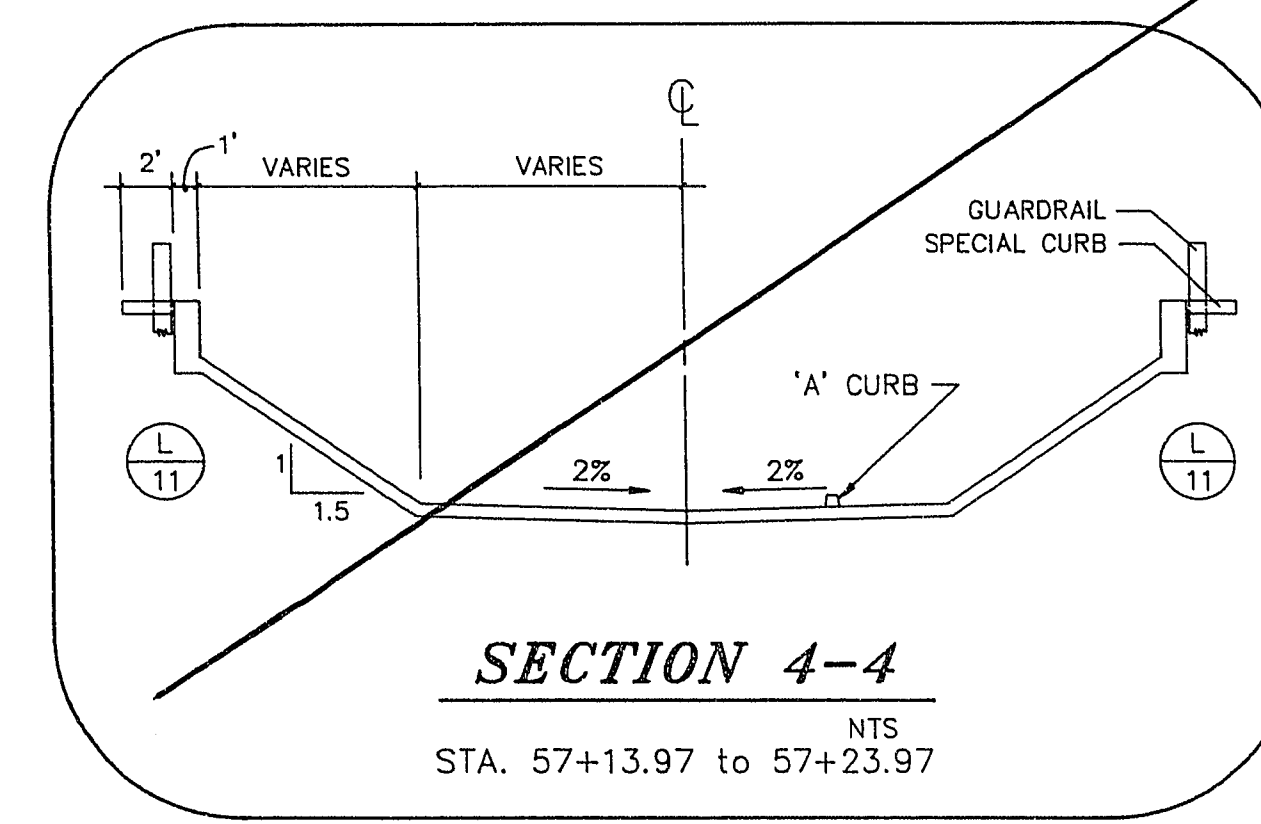
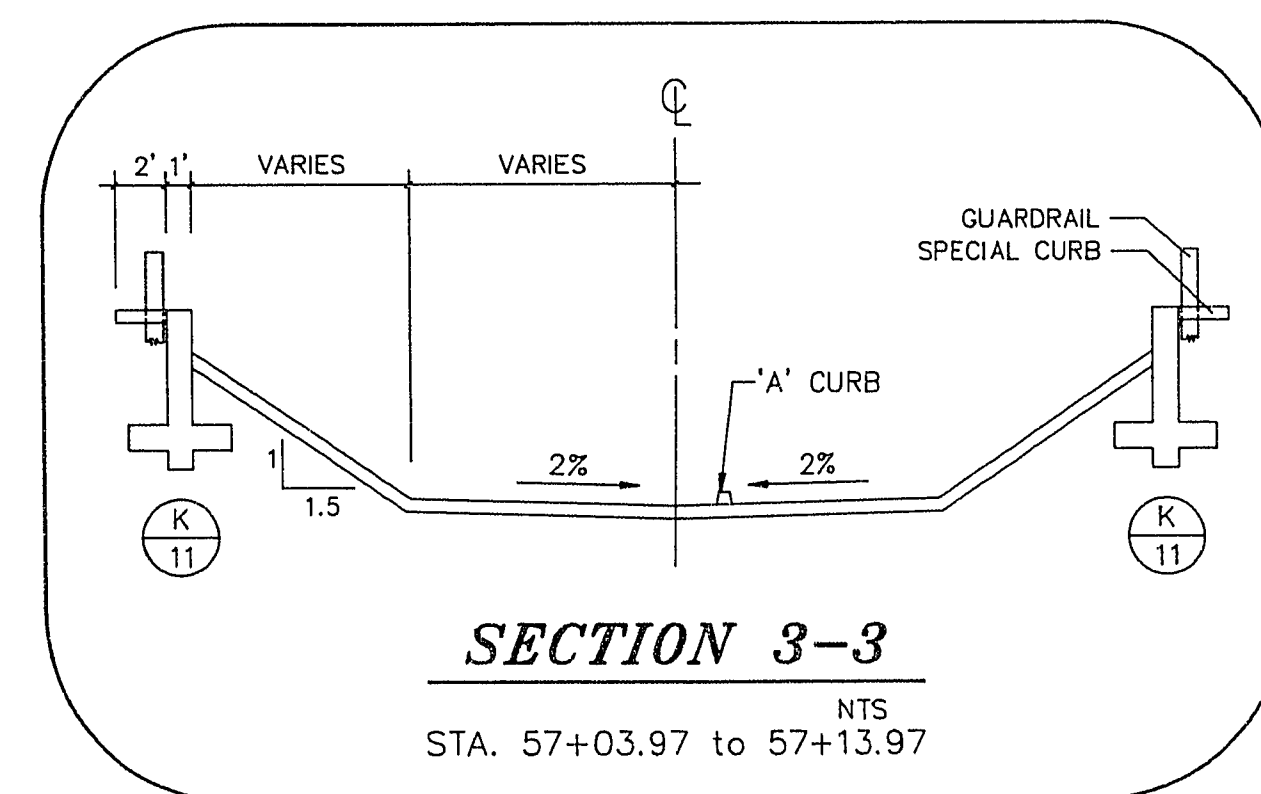
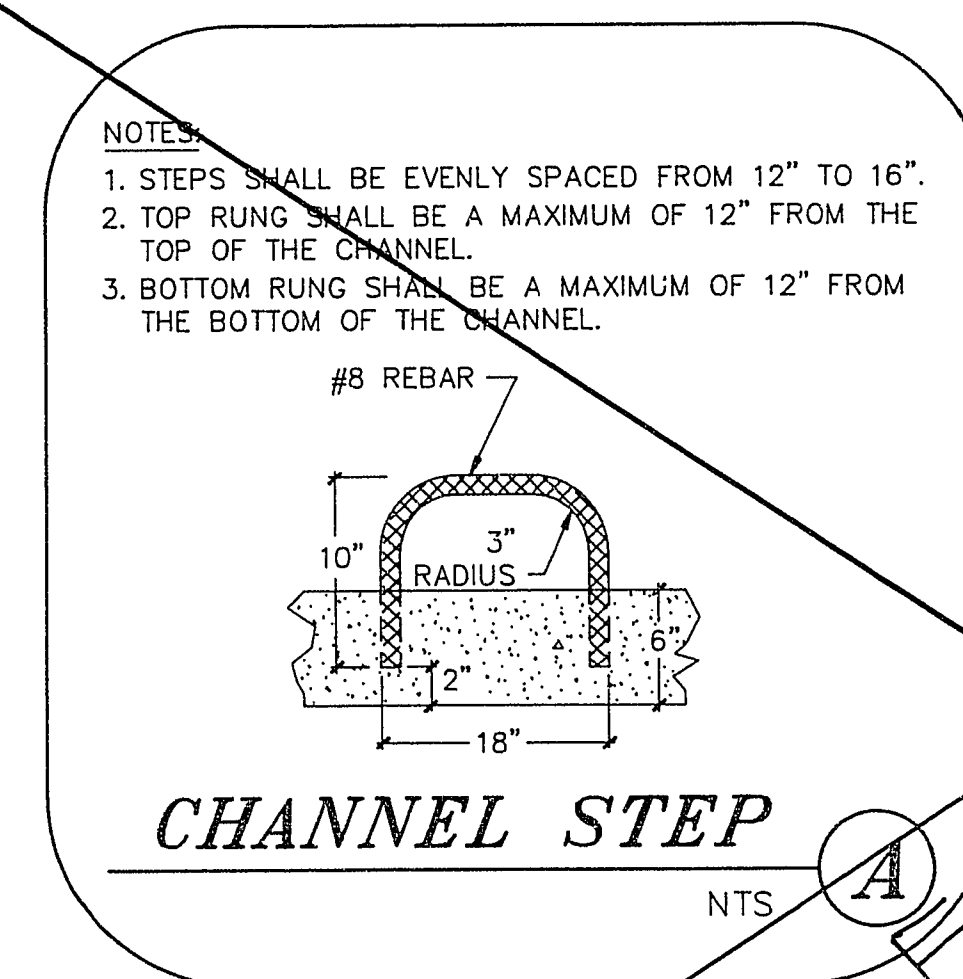
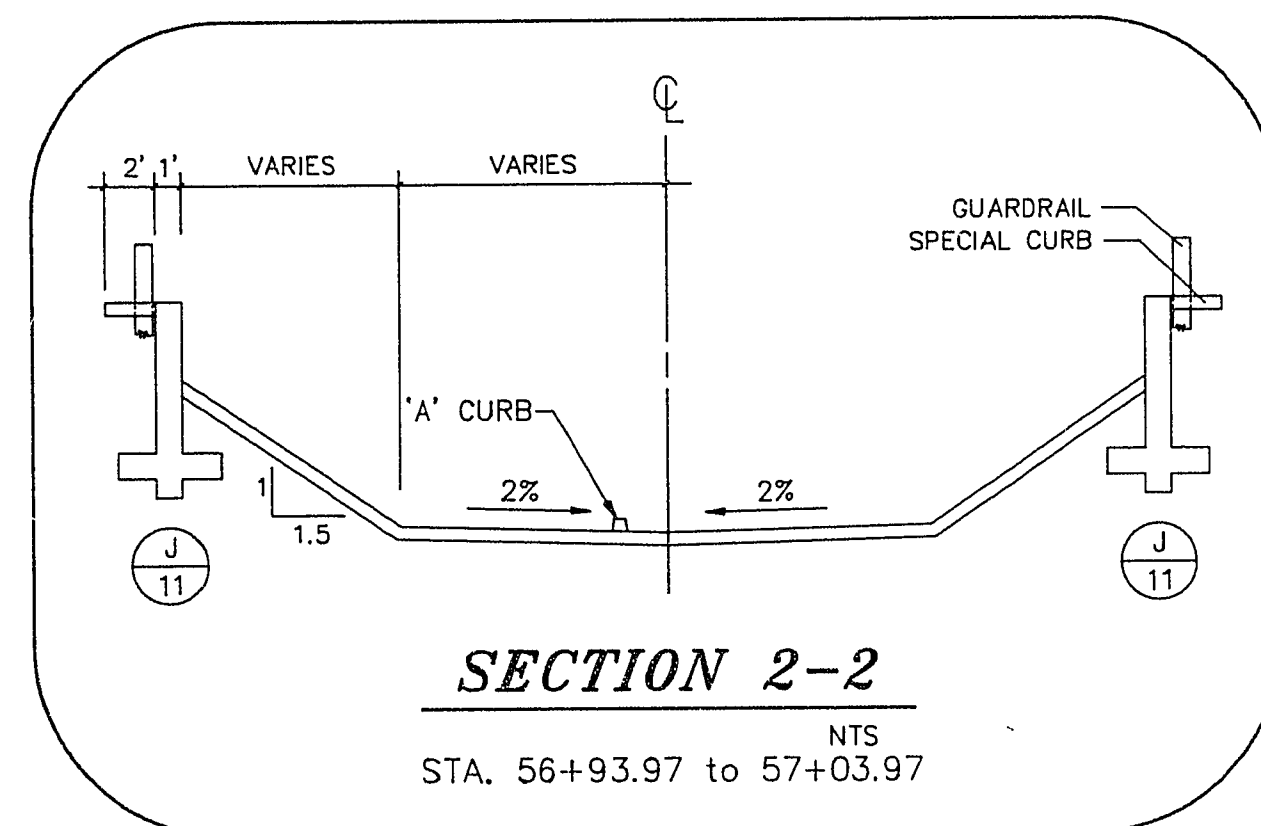
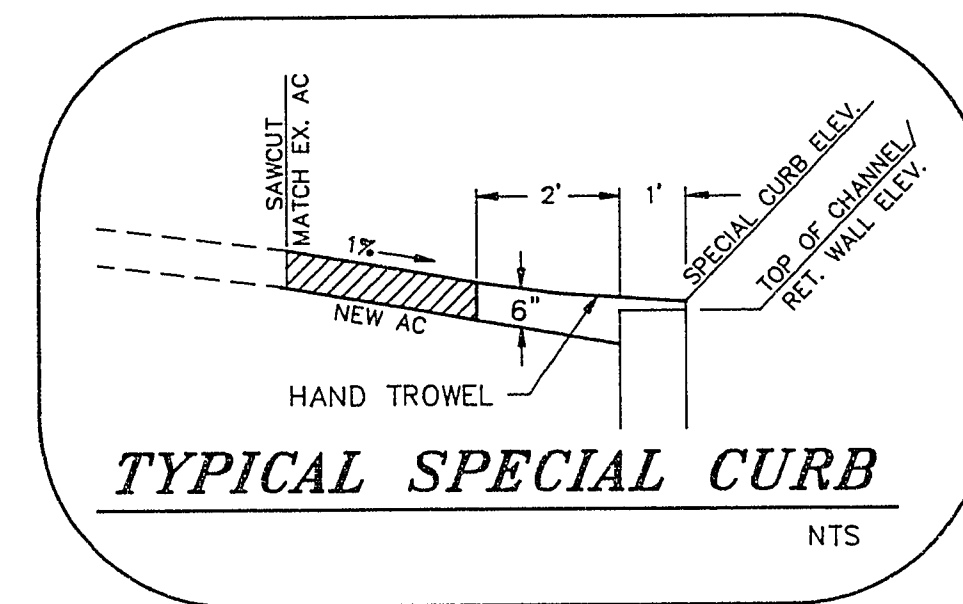


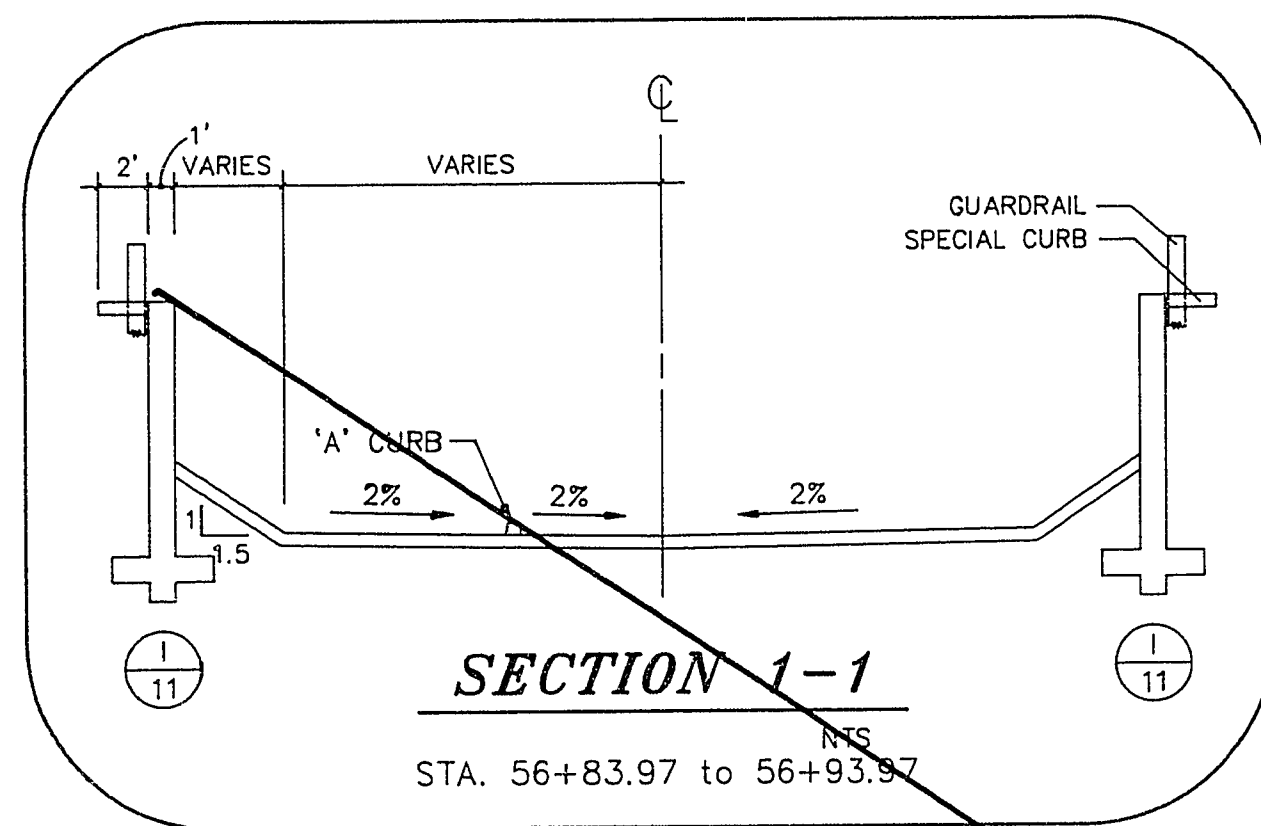


RECORD DRAWING

These Record Drawings have been prepared based on information provided by others. The Engineer has not verified the accuracy of such information and shall not be responsible for any errors or omissions which may be incorporated herein as a result.

Call before you Dig
1-800-227-2600

REVISIONS		DESIGNED: DB		CHECKED: JHE		JOB NO. 343-90		SCALE: AS NOTED	
No.	Date	By	Check	By	Check	No.	Date	By	Check
1						1			
2						2			
3						3			
100						100			

1055 EAST TROPICANA
LAS VEGAS, NEVADA 89119
(702) 798-1007

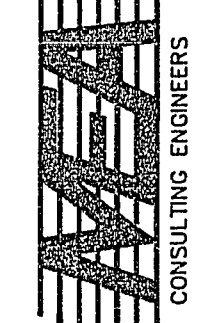

PROJECT: CITY OF LAS VEGAS
WASHINGTON AVENUE CONVEYANCE SYSTEM

DESCRIPTION: INLET PLAN and SECTIONS

SHEET 10 OF 15