


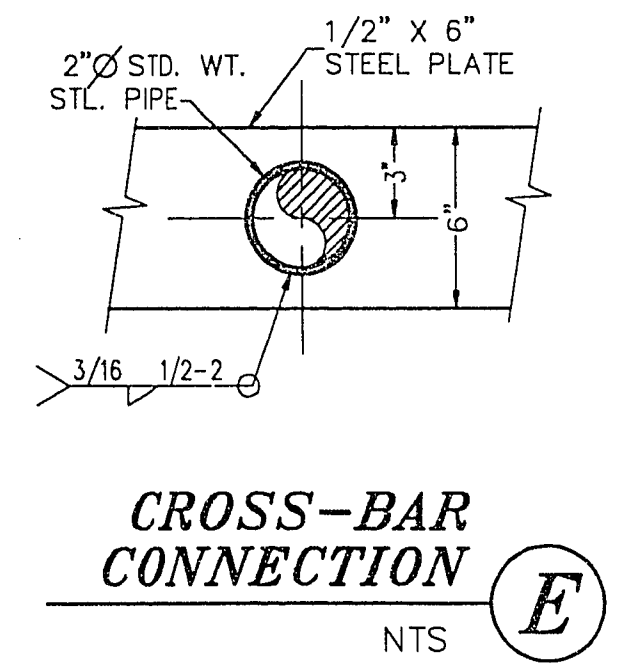
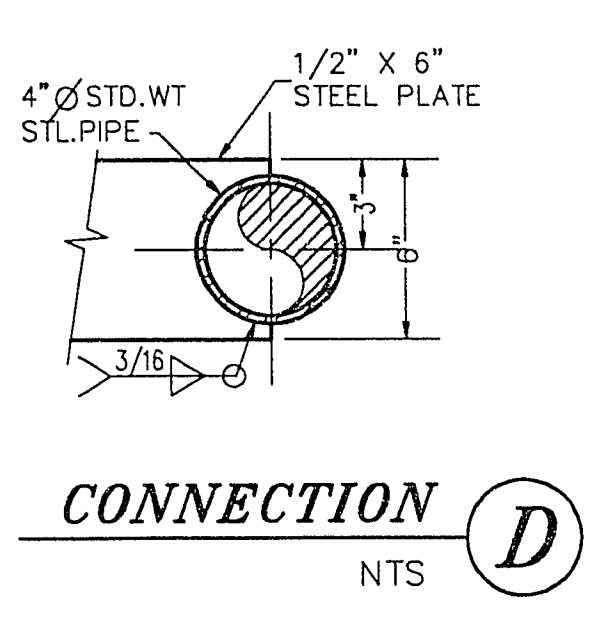
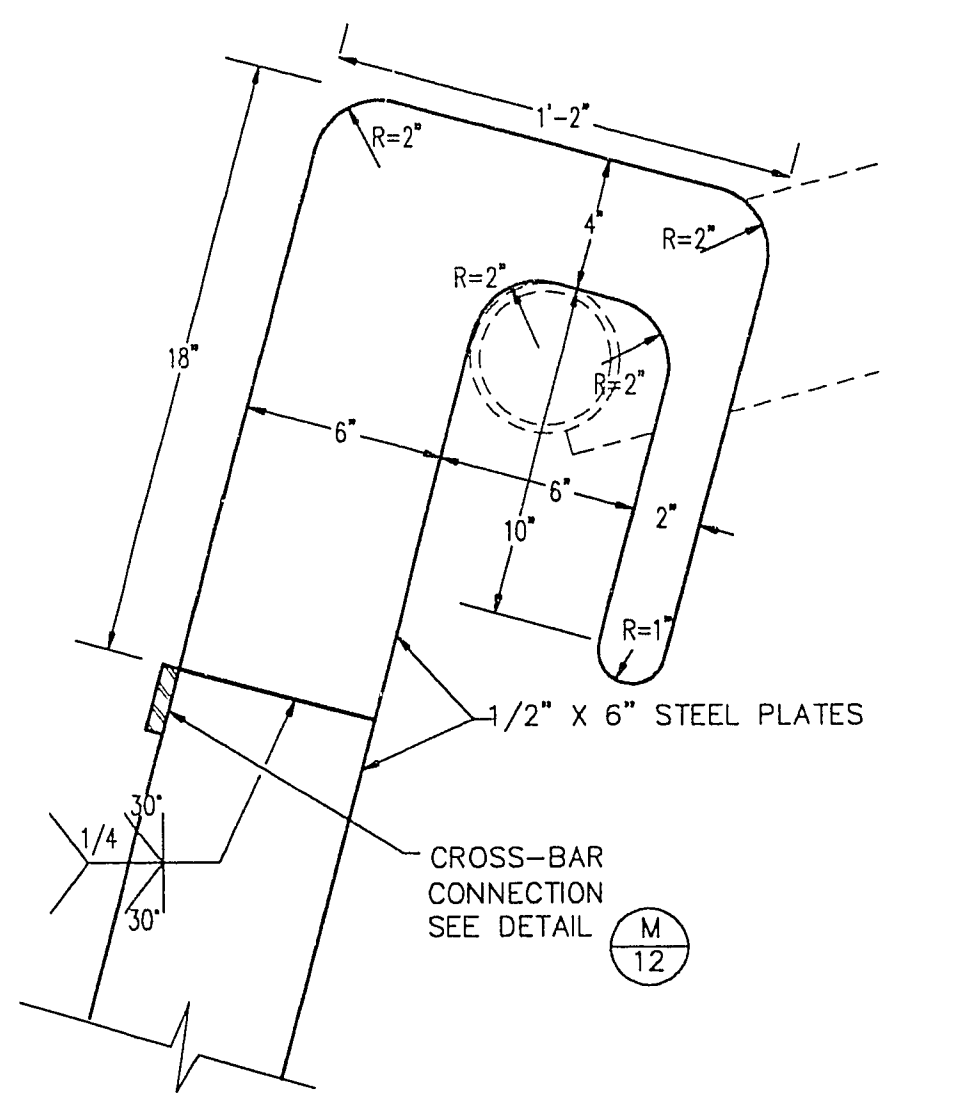
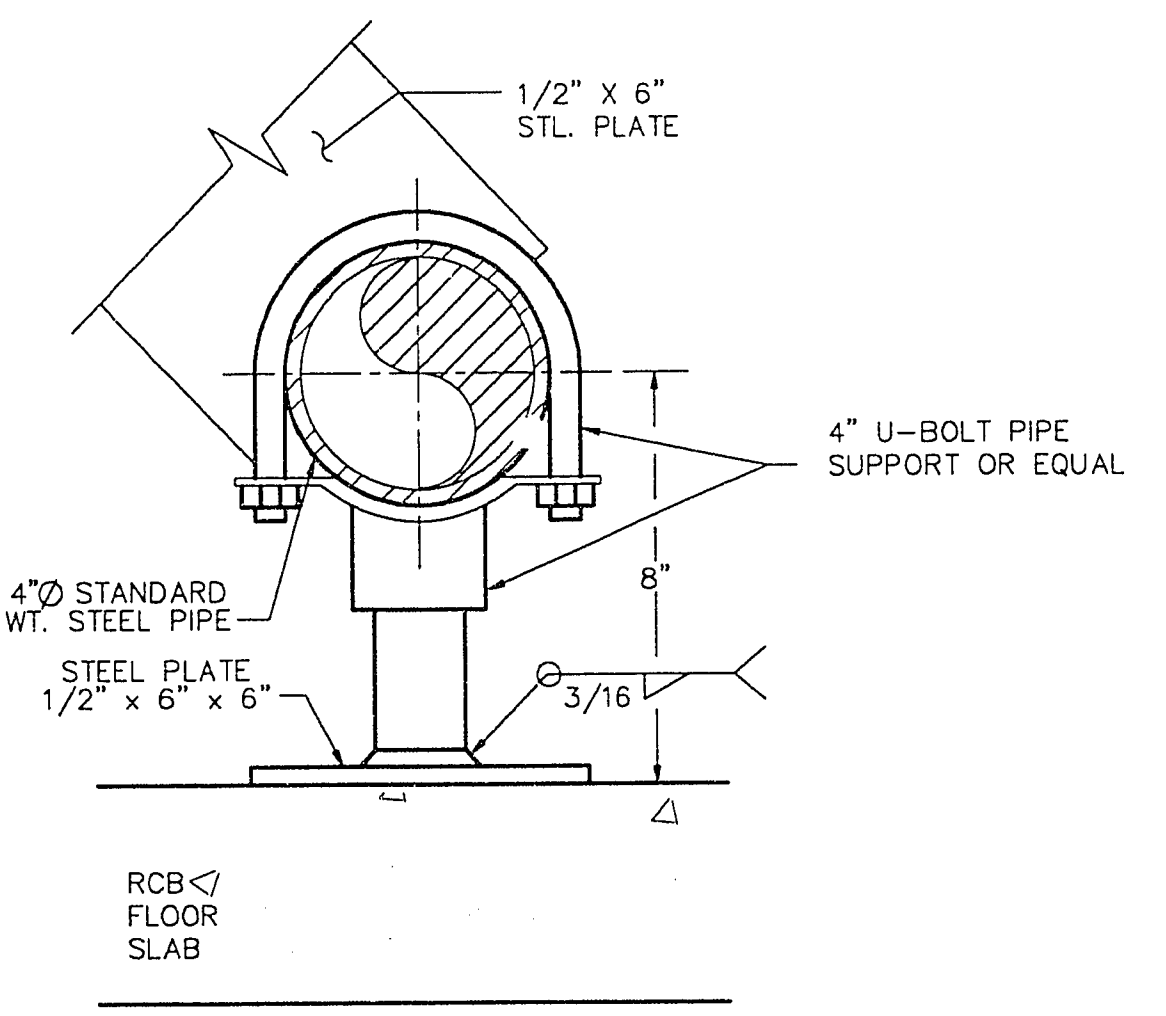
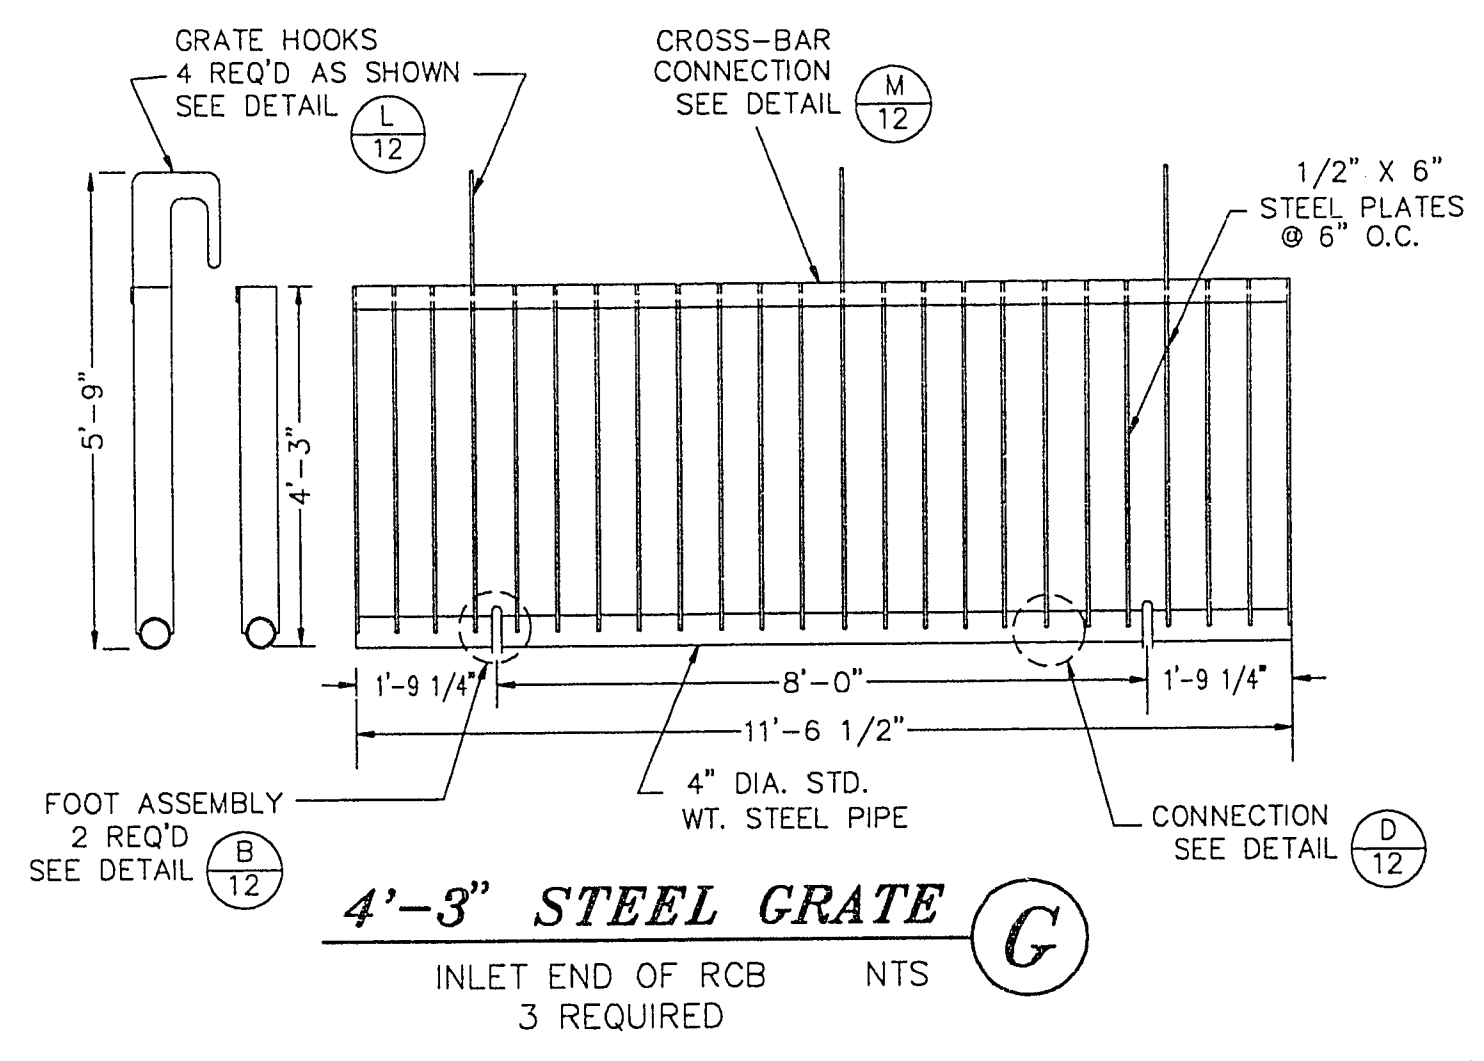
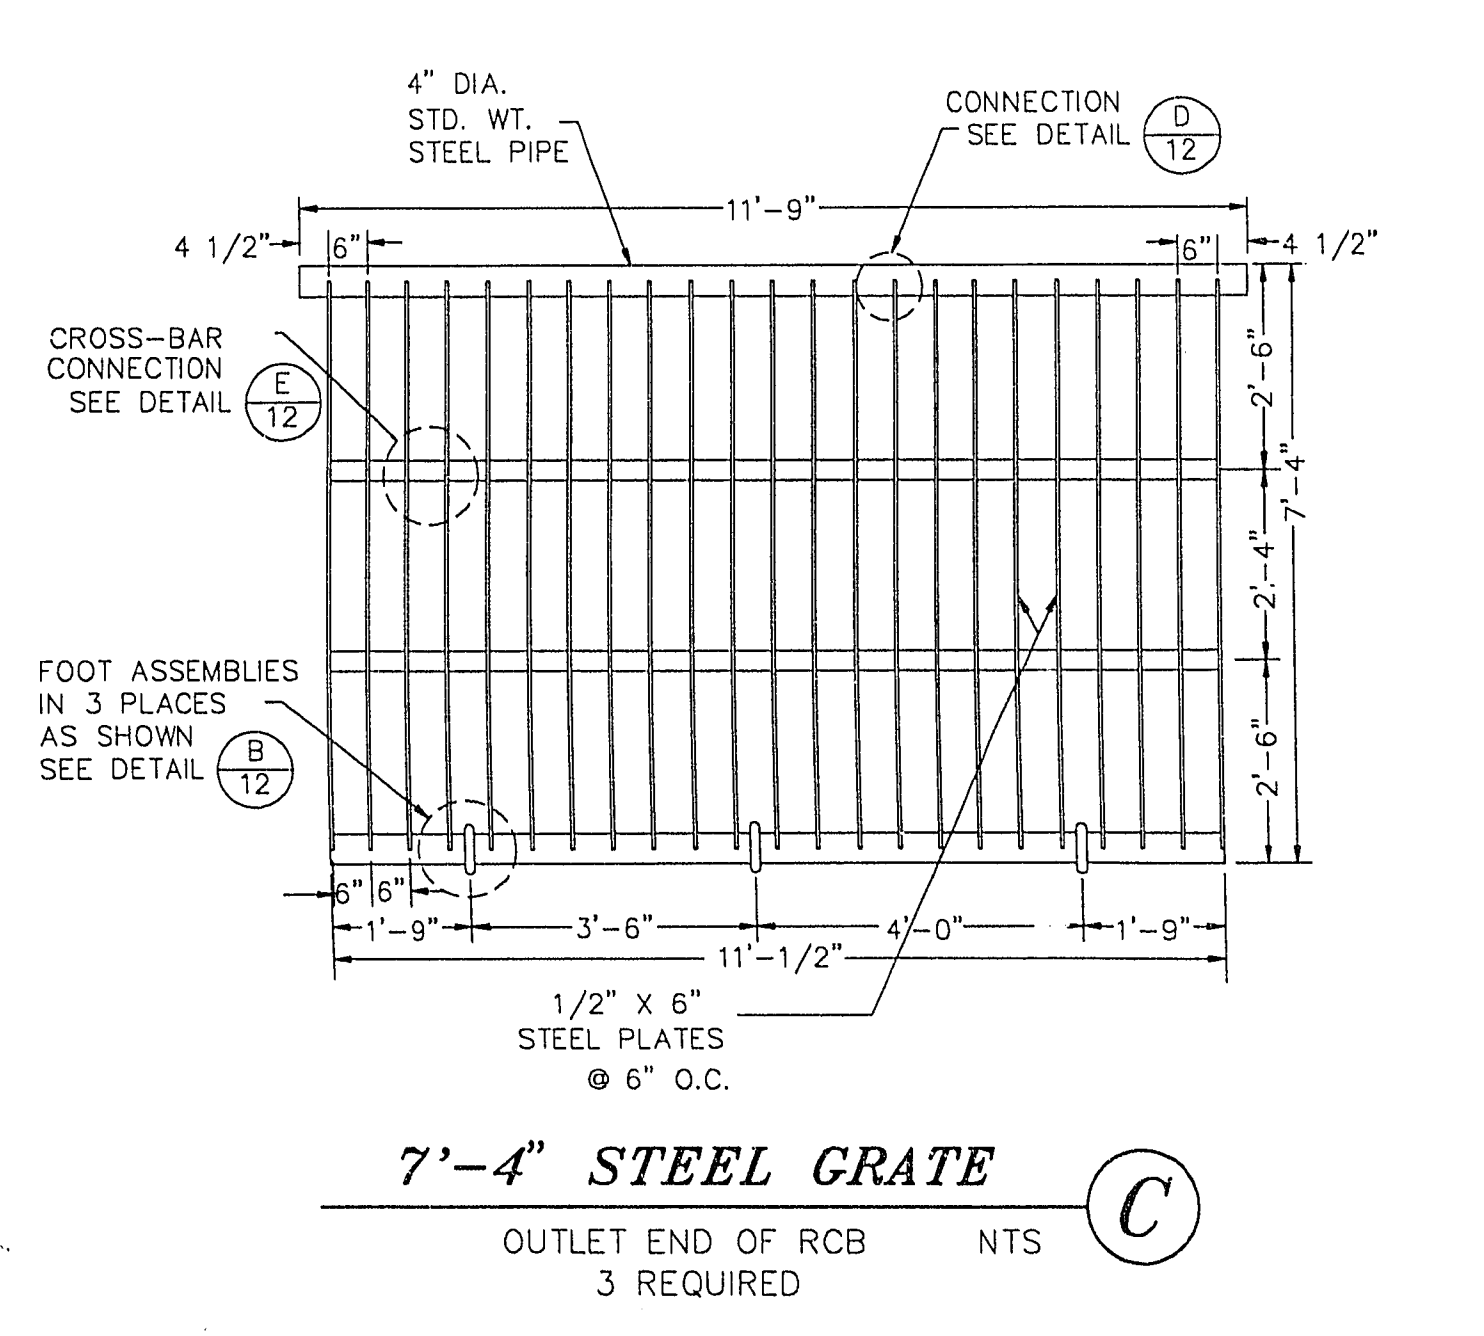
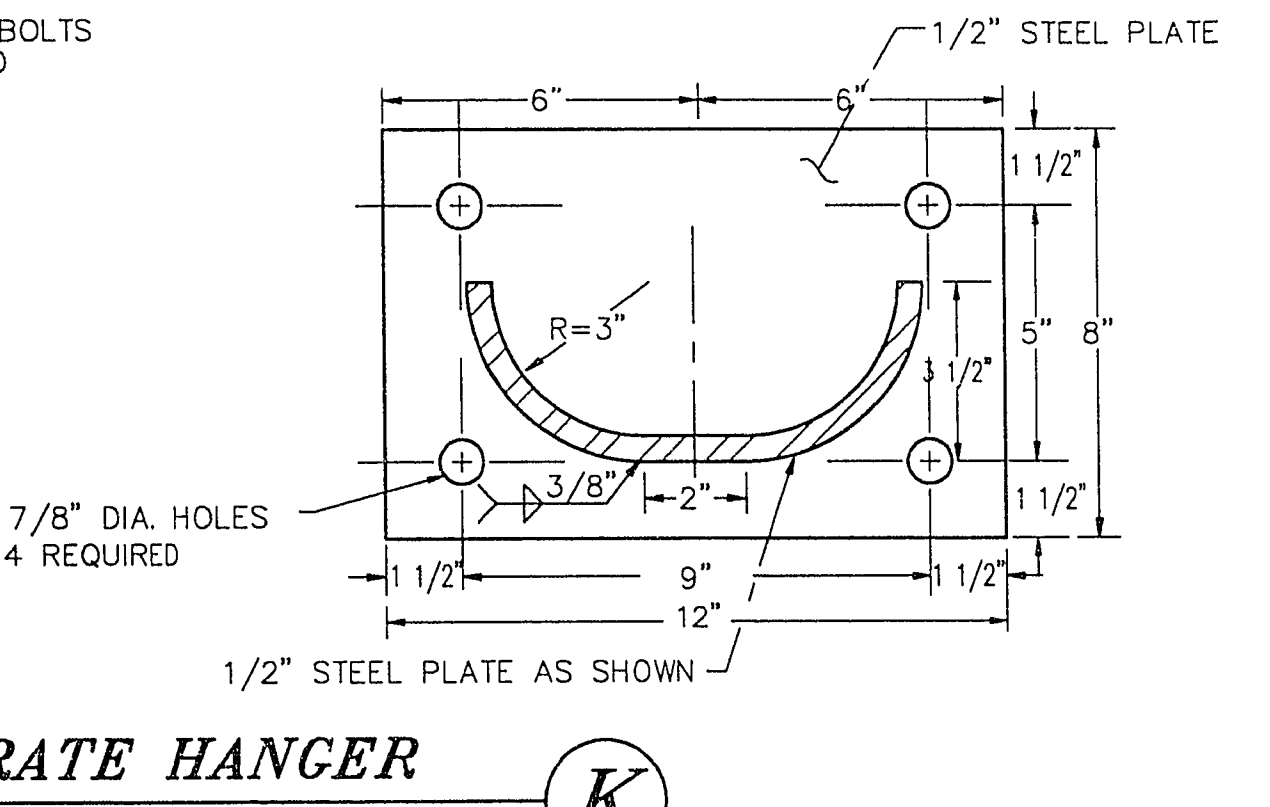
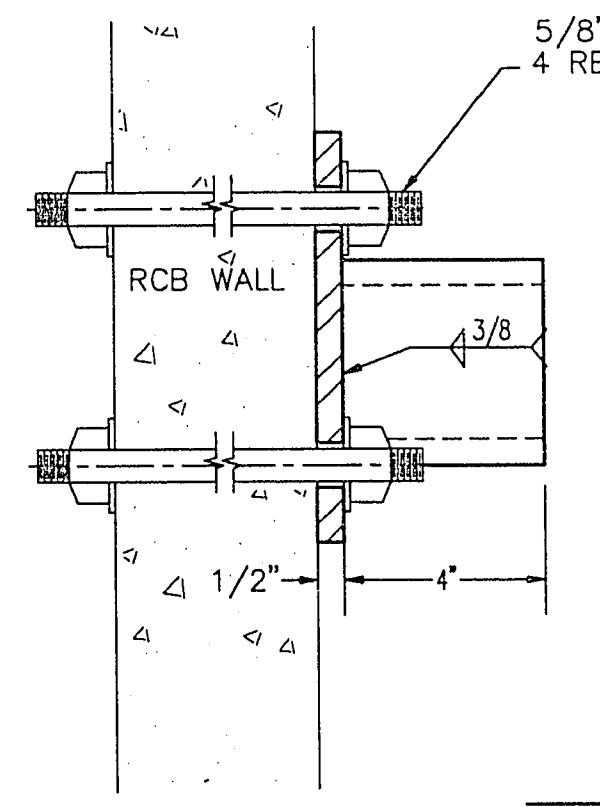
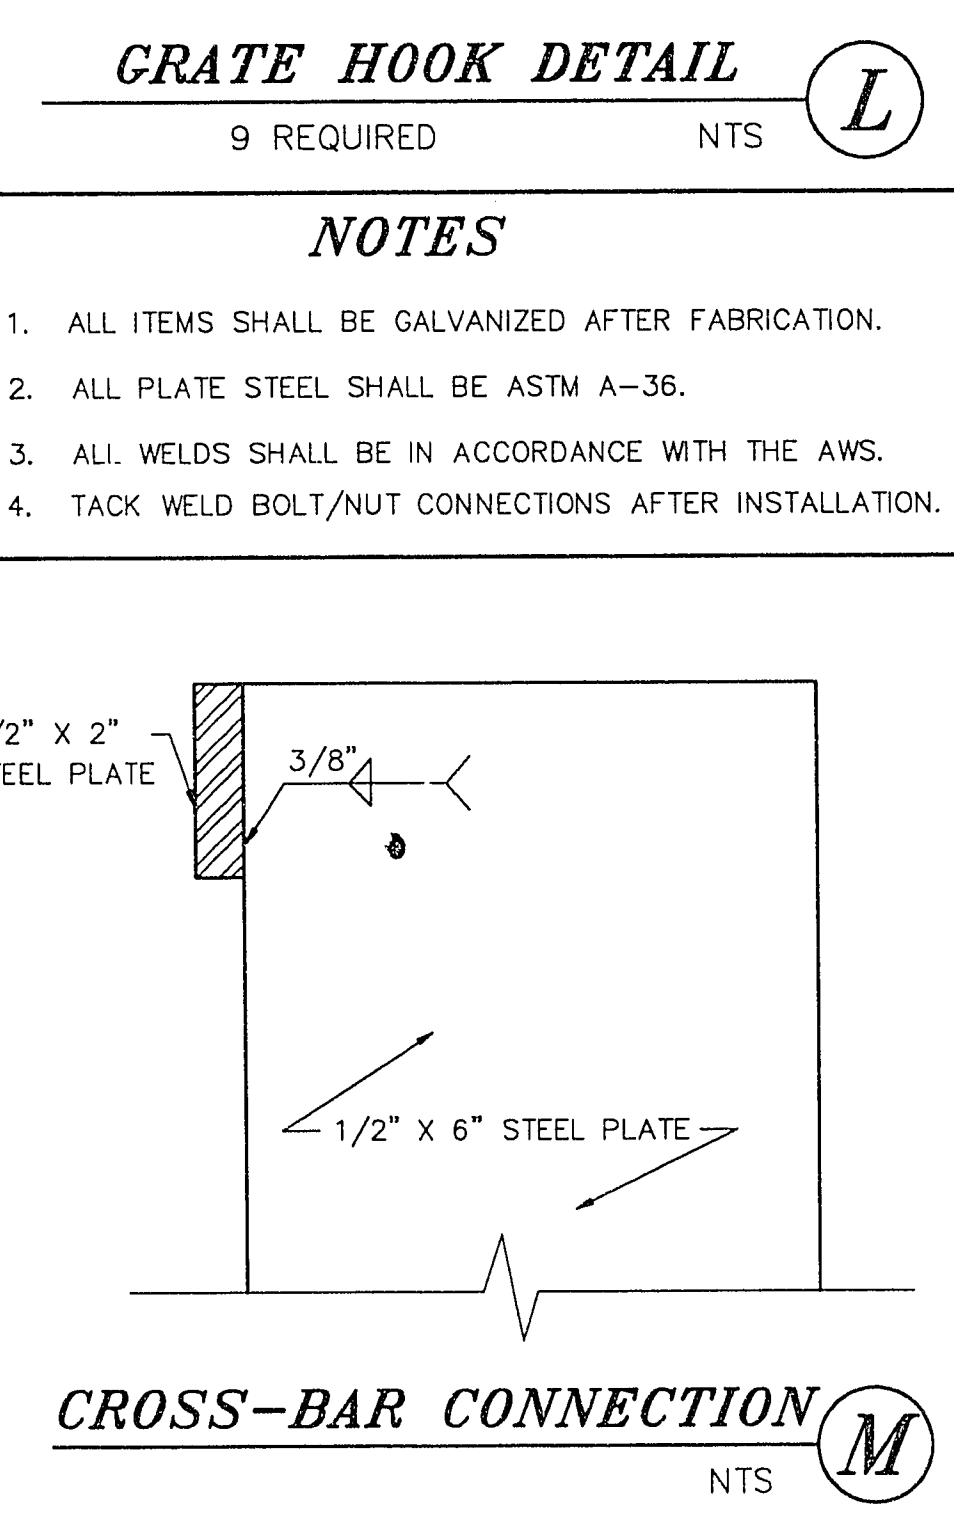
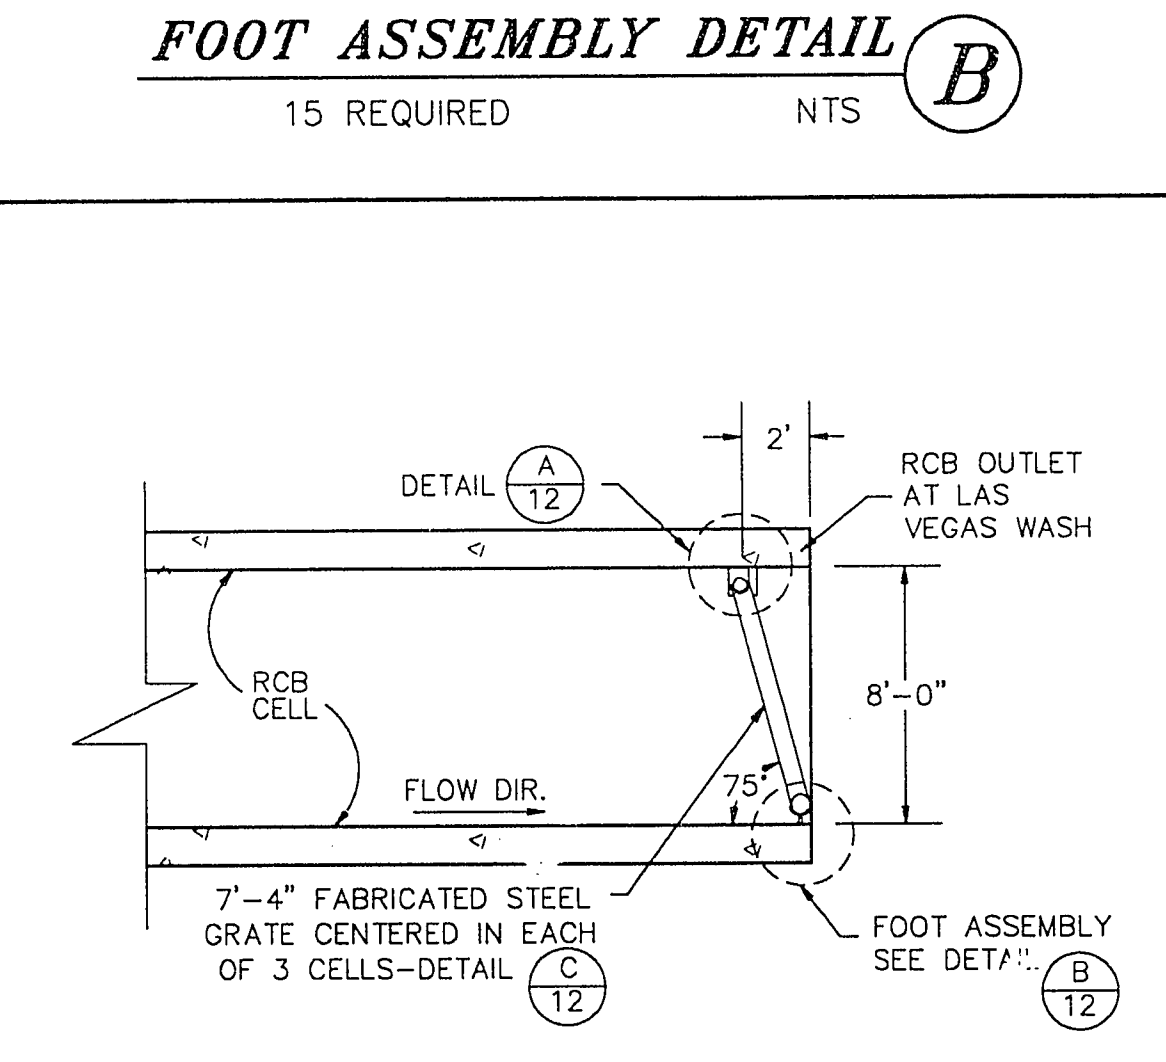
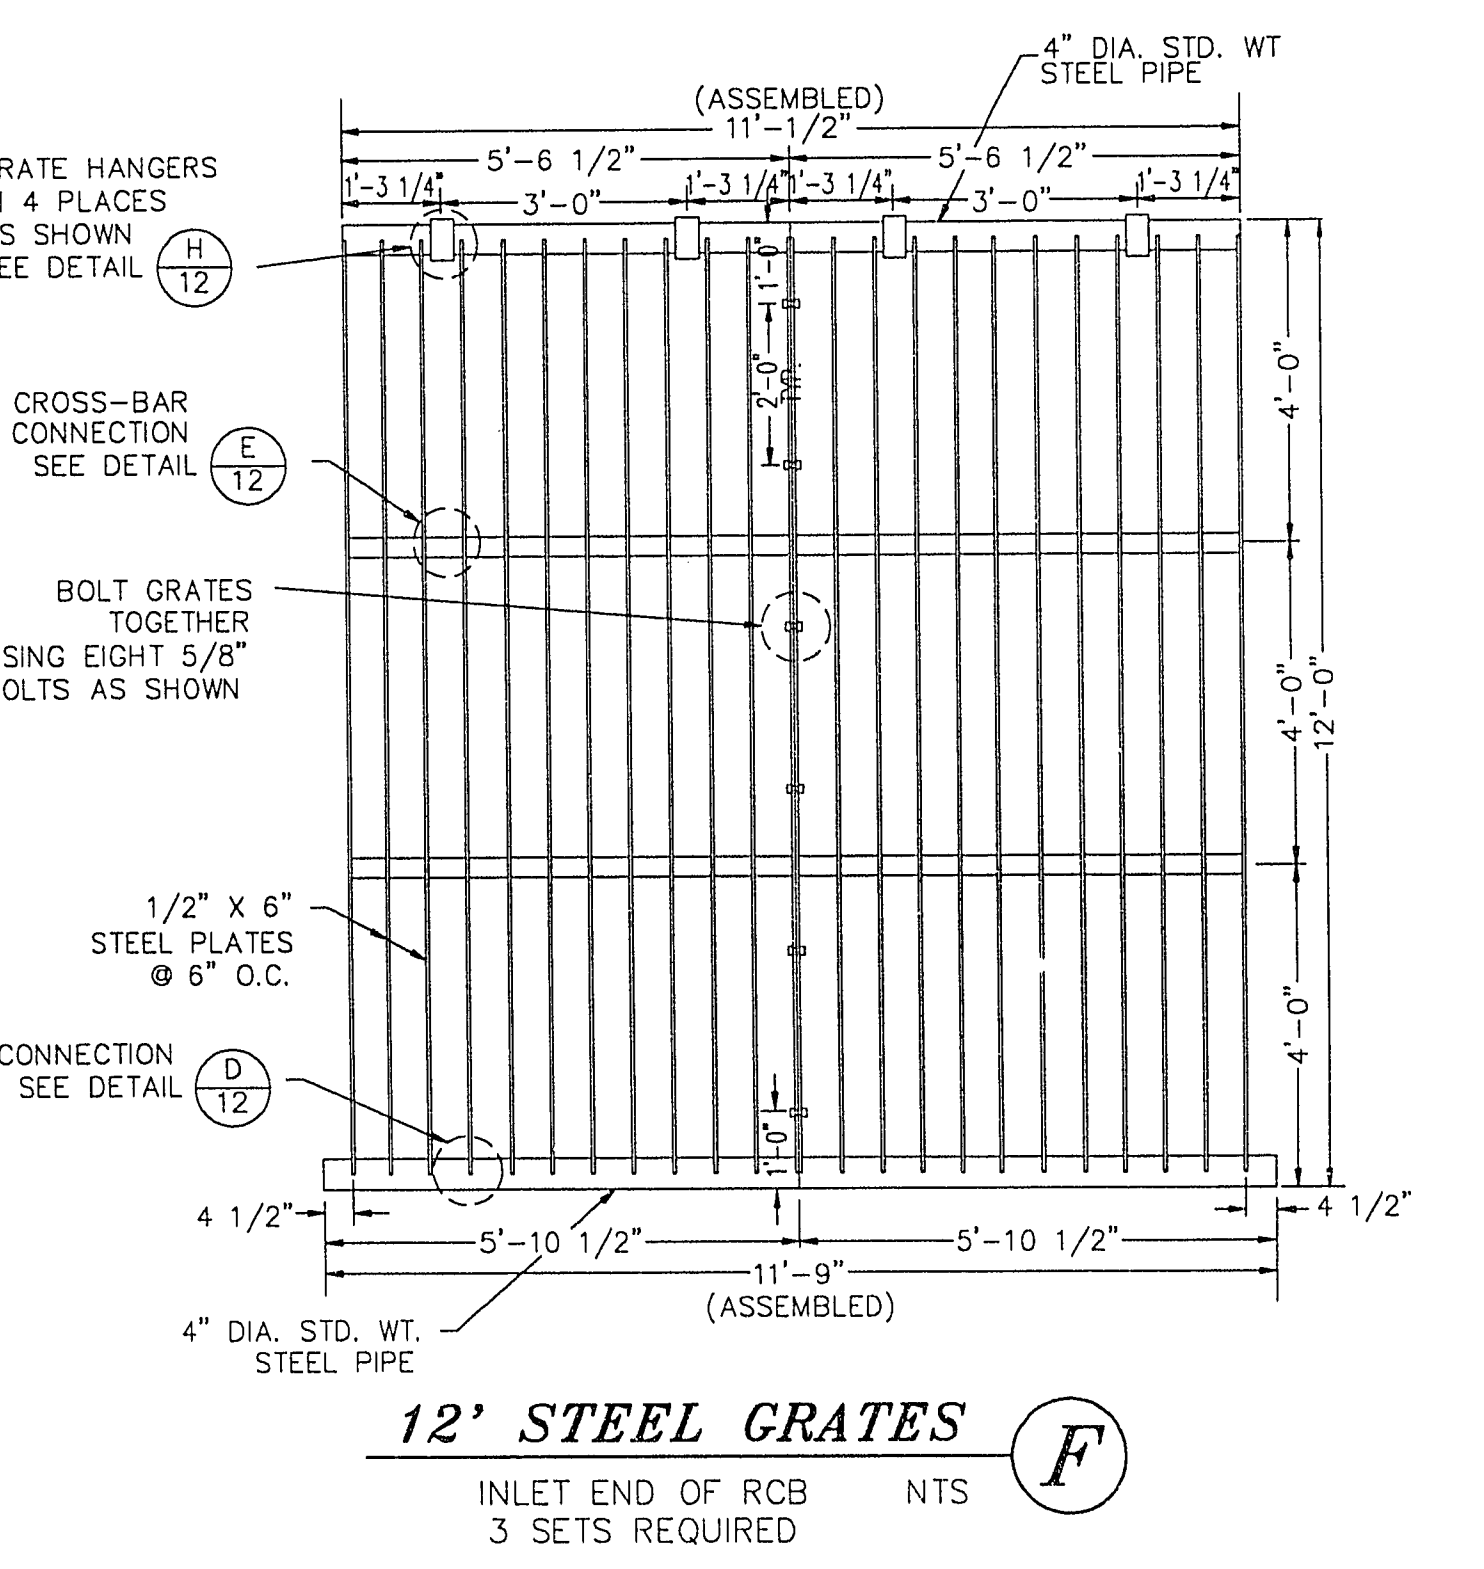
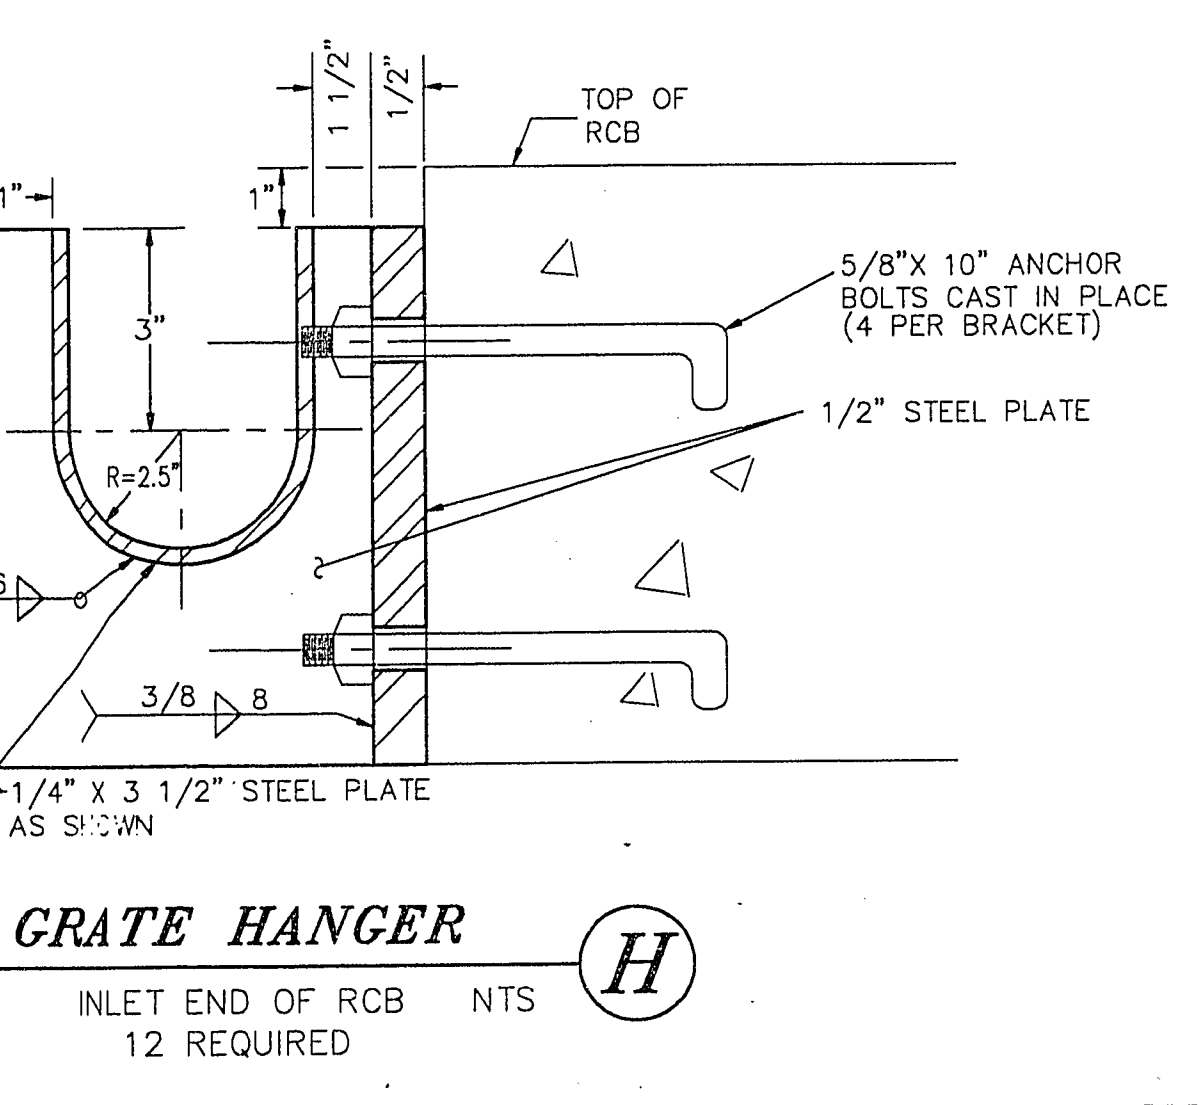
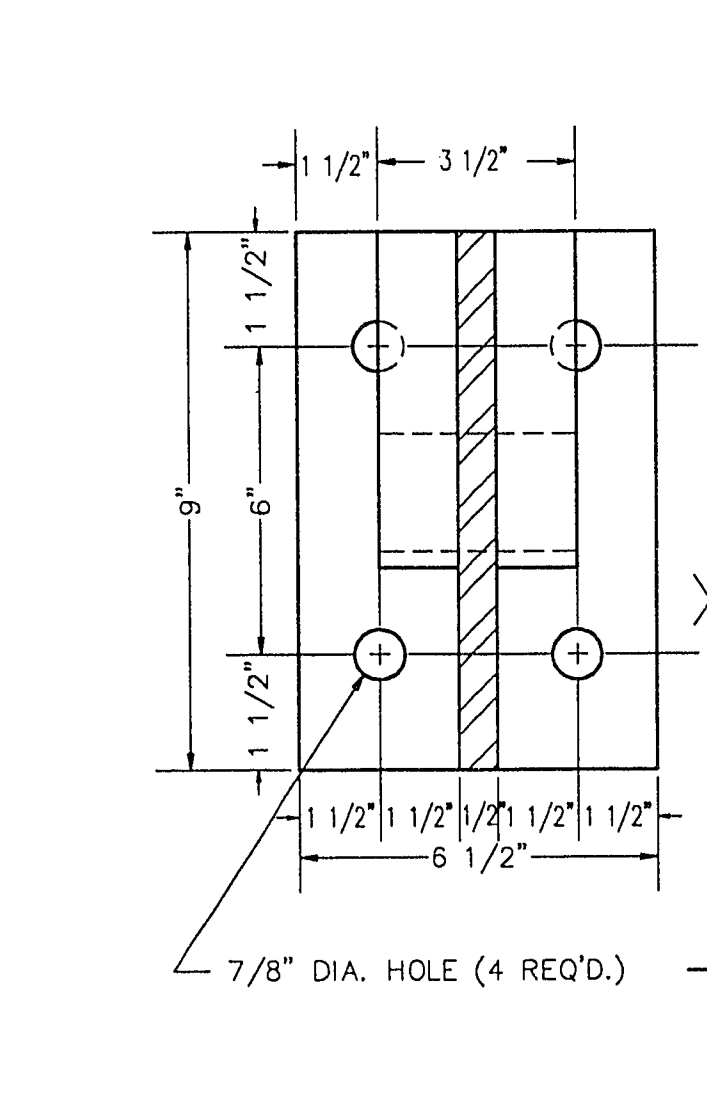


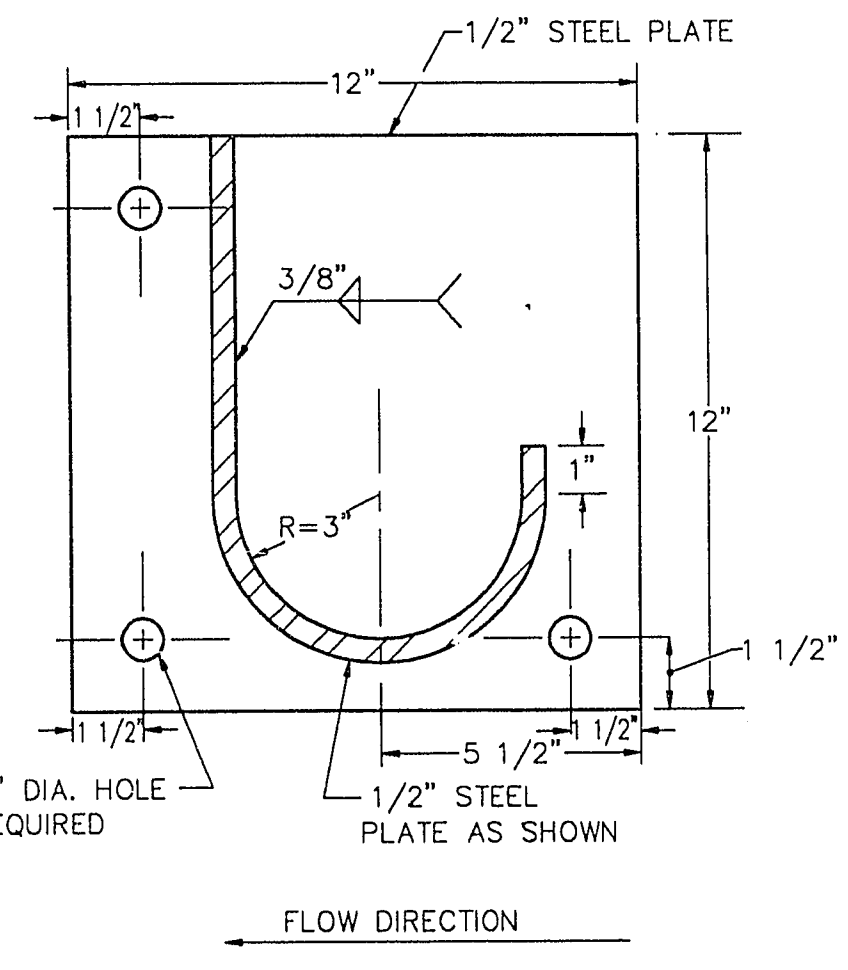

Call before you Dig.
1-800-227-2600
UNDERGROUND SERVICE ALERT (USA)

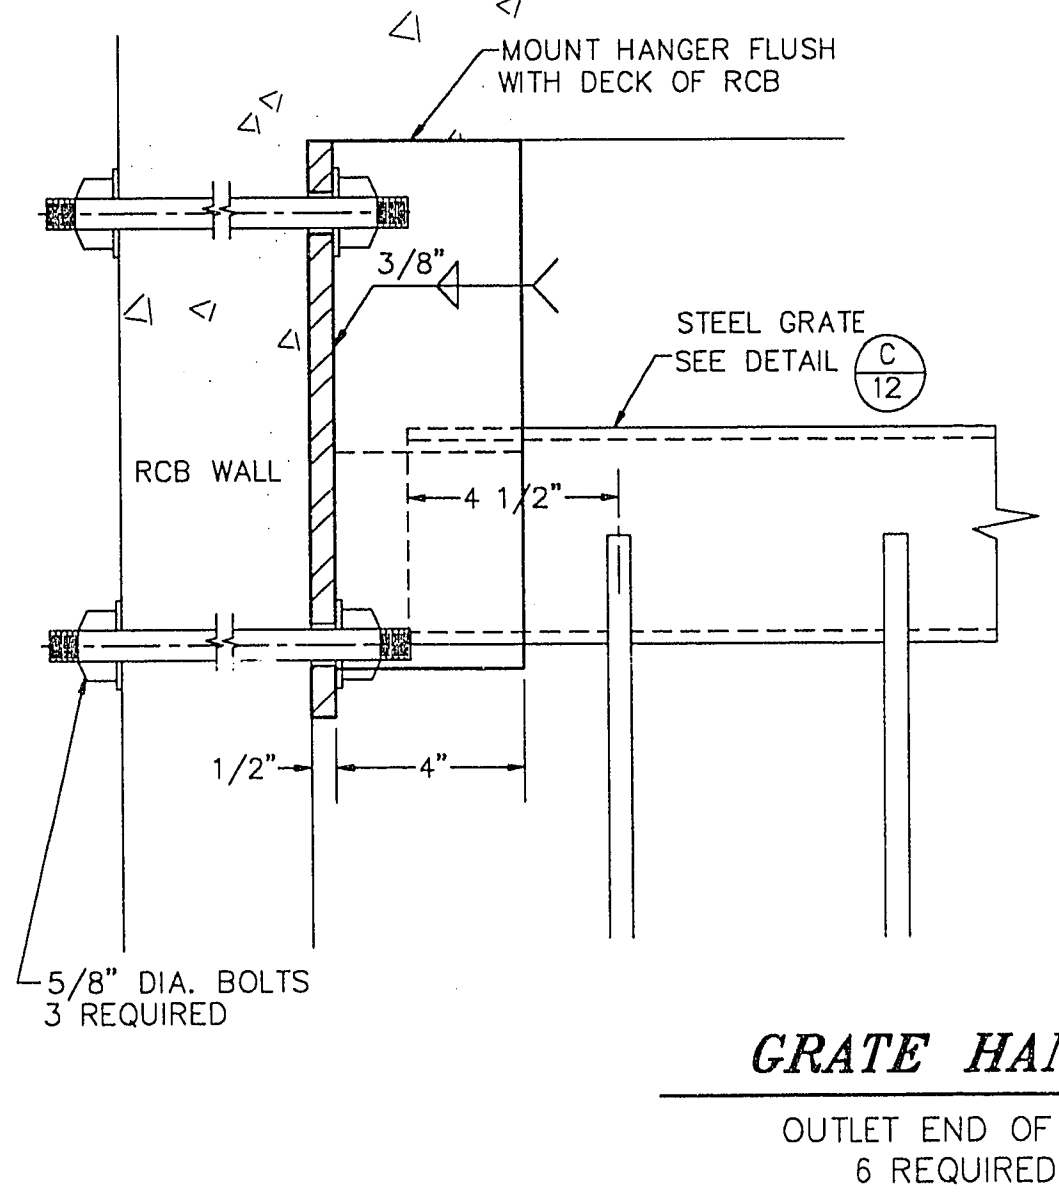

RECORD DRAWING
These Record Drawings have been prepared based on information provided by others. The Engineer has not verified the accuracy of such information and shall not be responsible for any errors or omissions which may be incorporated herein as a result.

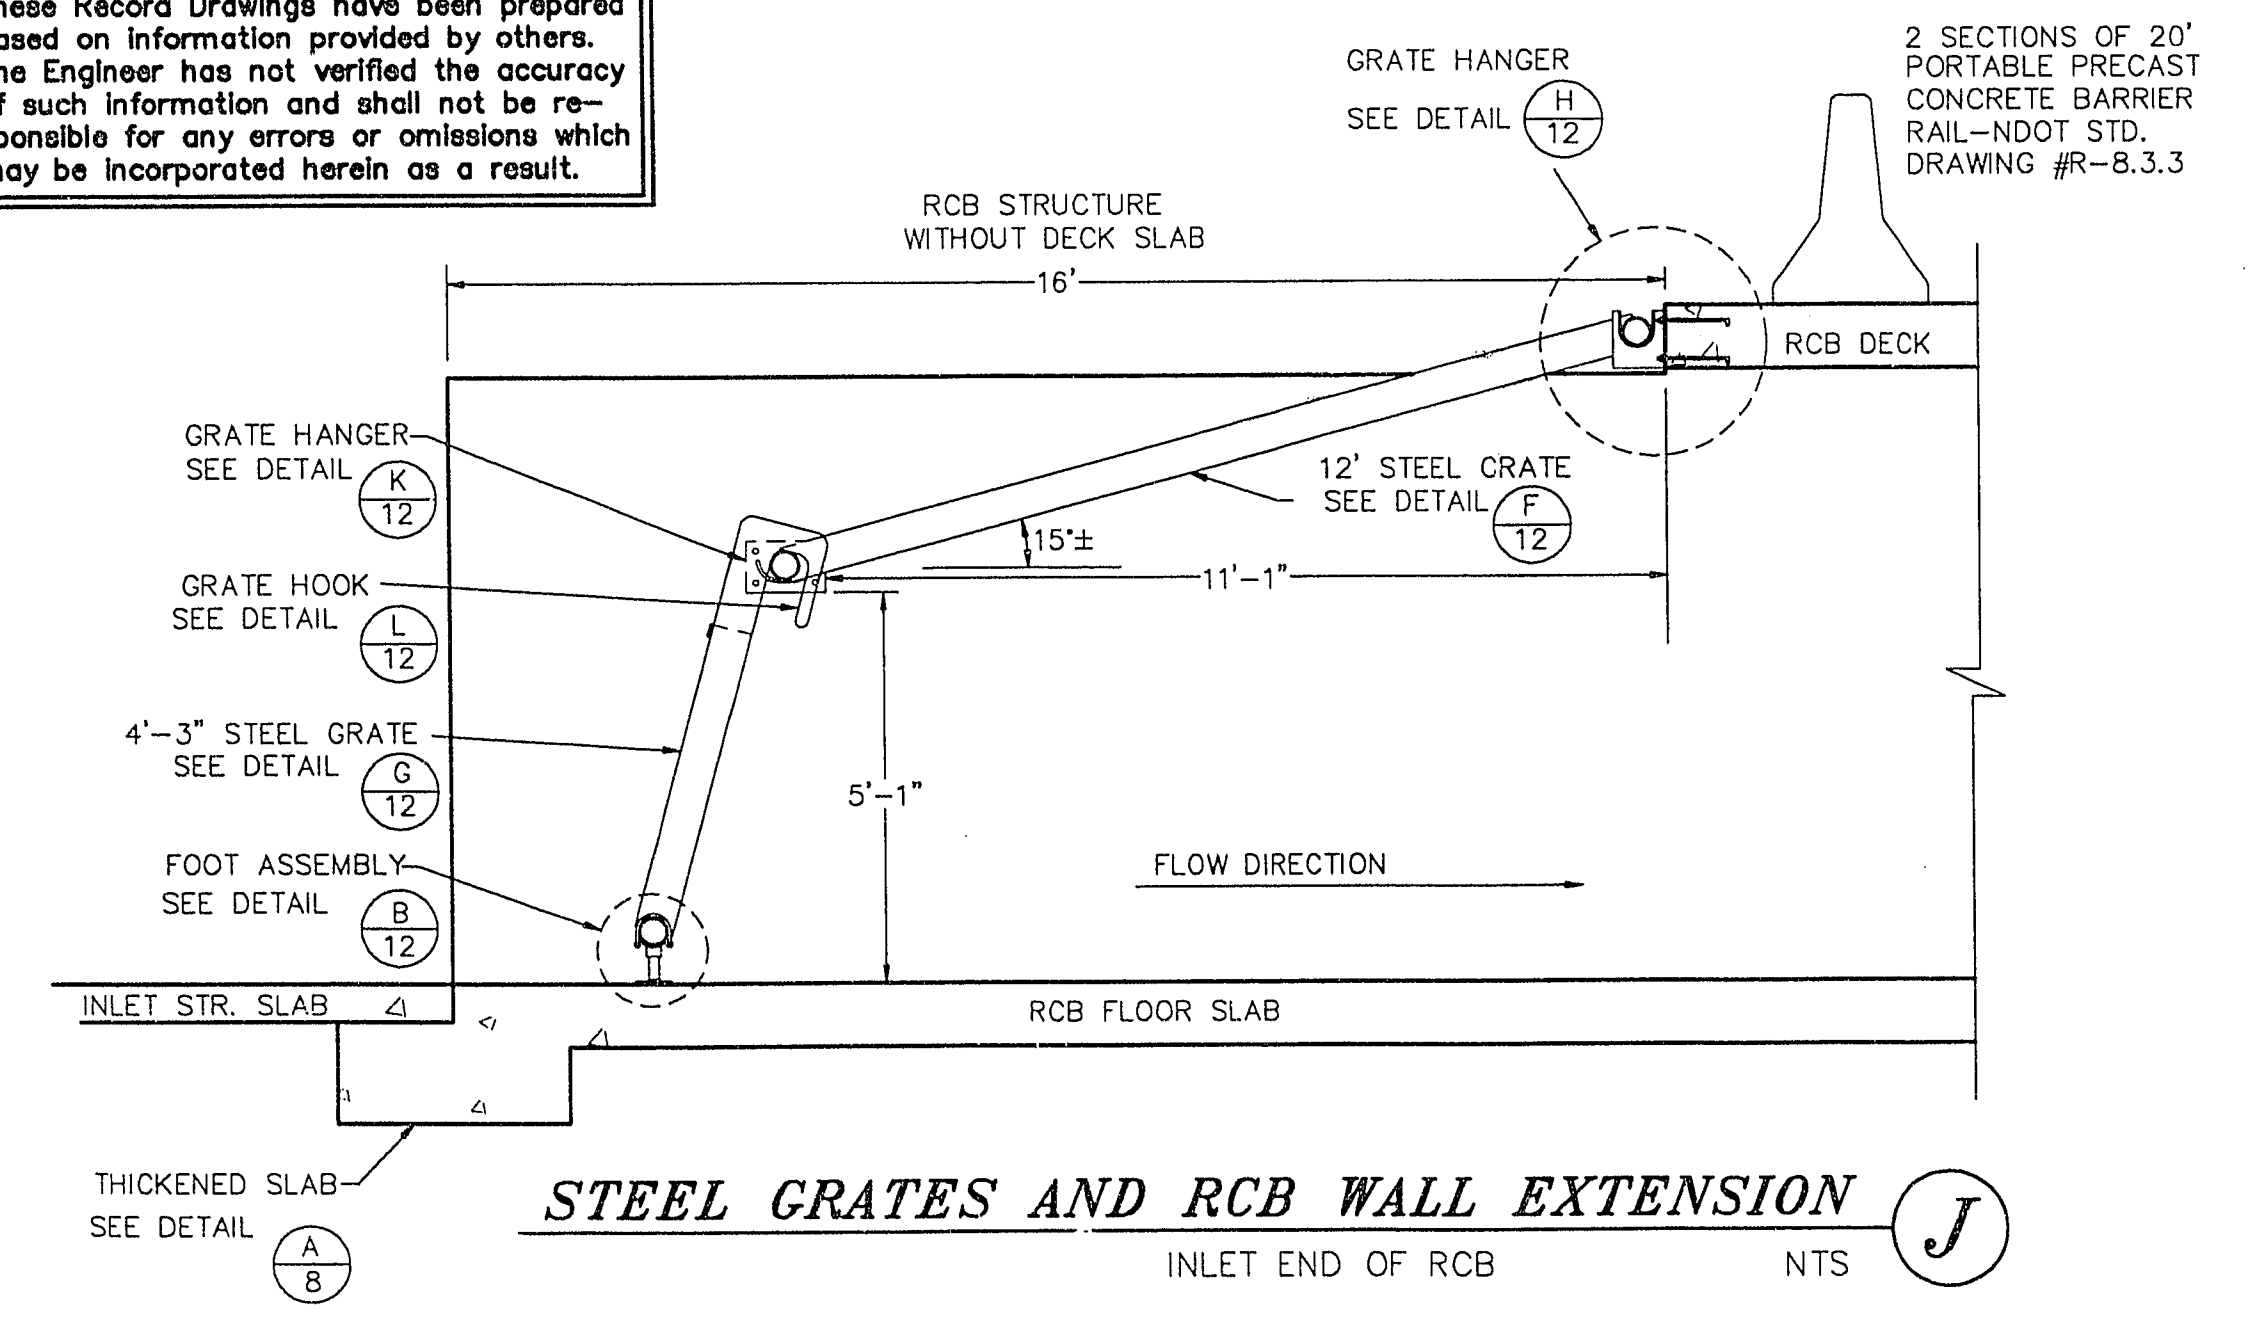

REVISIONS	
No.	Date

DESIGNED: BMB/LNG	DRAWN: BMB/KOP
CHECKED: BMB/LNG	JOB NO. 393-91
SCALE: HORIZ. 1"=10'	VERT. 1"=4'

1055 EAST TROPICANA
SUITE 600
LAS VEGAS, NEVADA 89119
(702) 798-1007

ME
CONSULTING ENGINEERS

PROJECT: CITY OF LAS VEGAS
WASHINGTON AVENUE CONVEYANCE SYSTEM

DESCRIPTION: STEEL GRATES DETAILS

SHEET 12 OF 12