

Avoid cutting underground utility lines. It's costly.

Call before you Dig.

1-800-227-2600

DESIGNED: BB





DRAWN: BB

CHECKED: LING

JOB NO. 482-93

SCALE: HORIZ. AS NOTED

VERT. AS NOTED

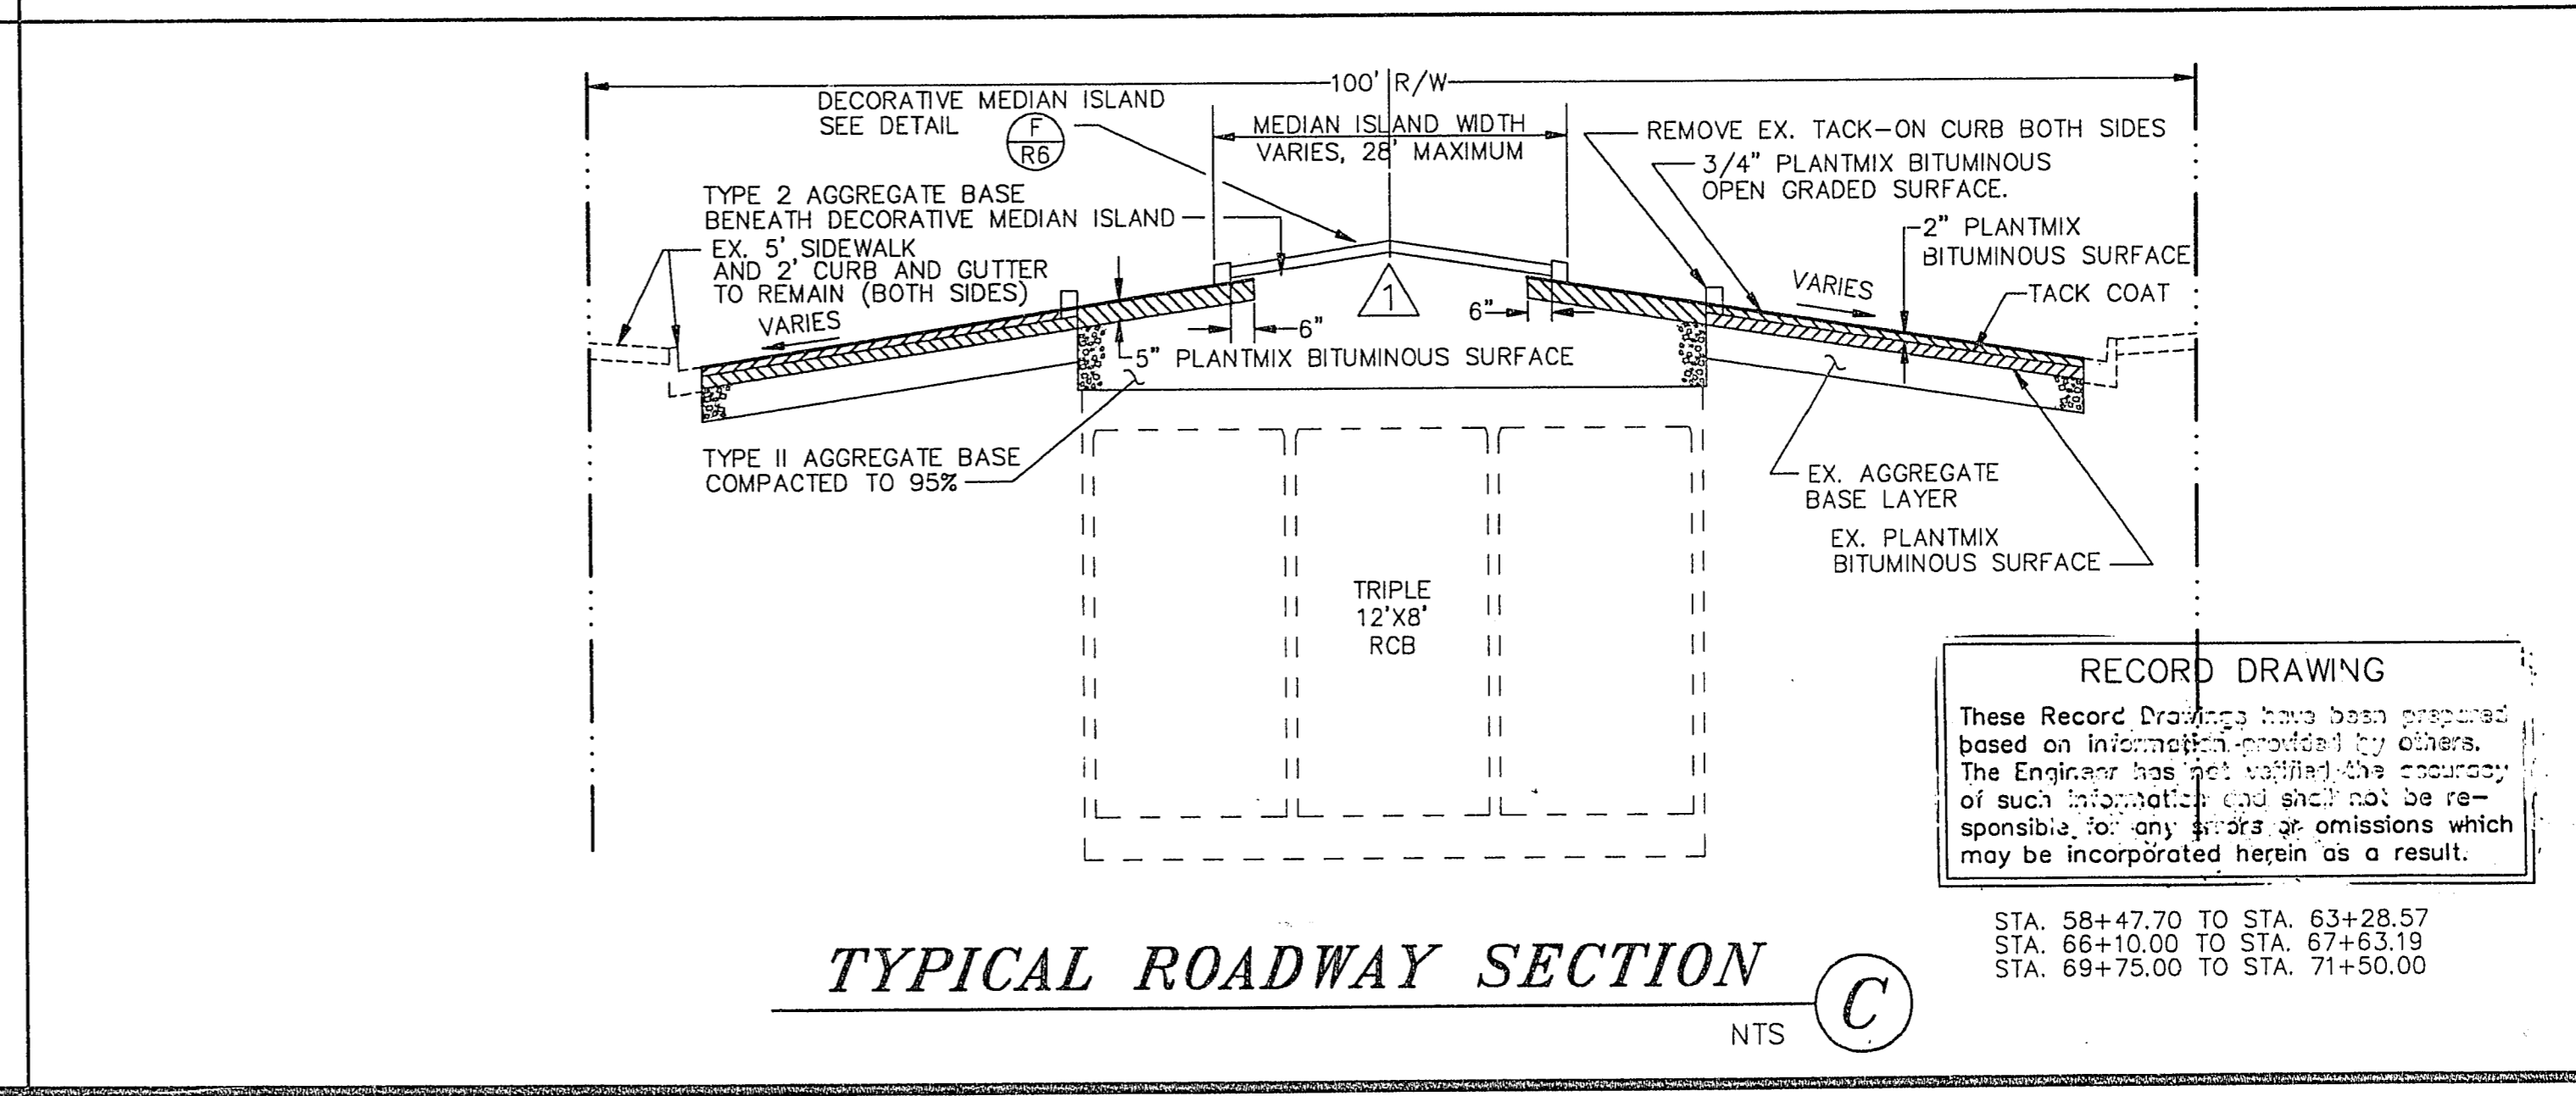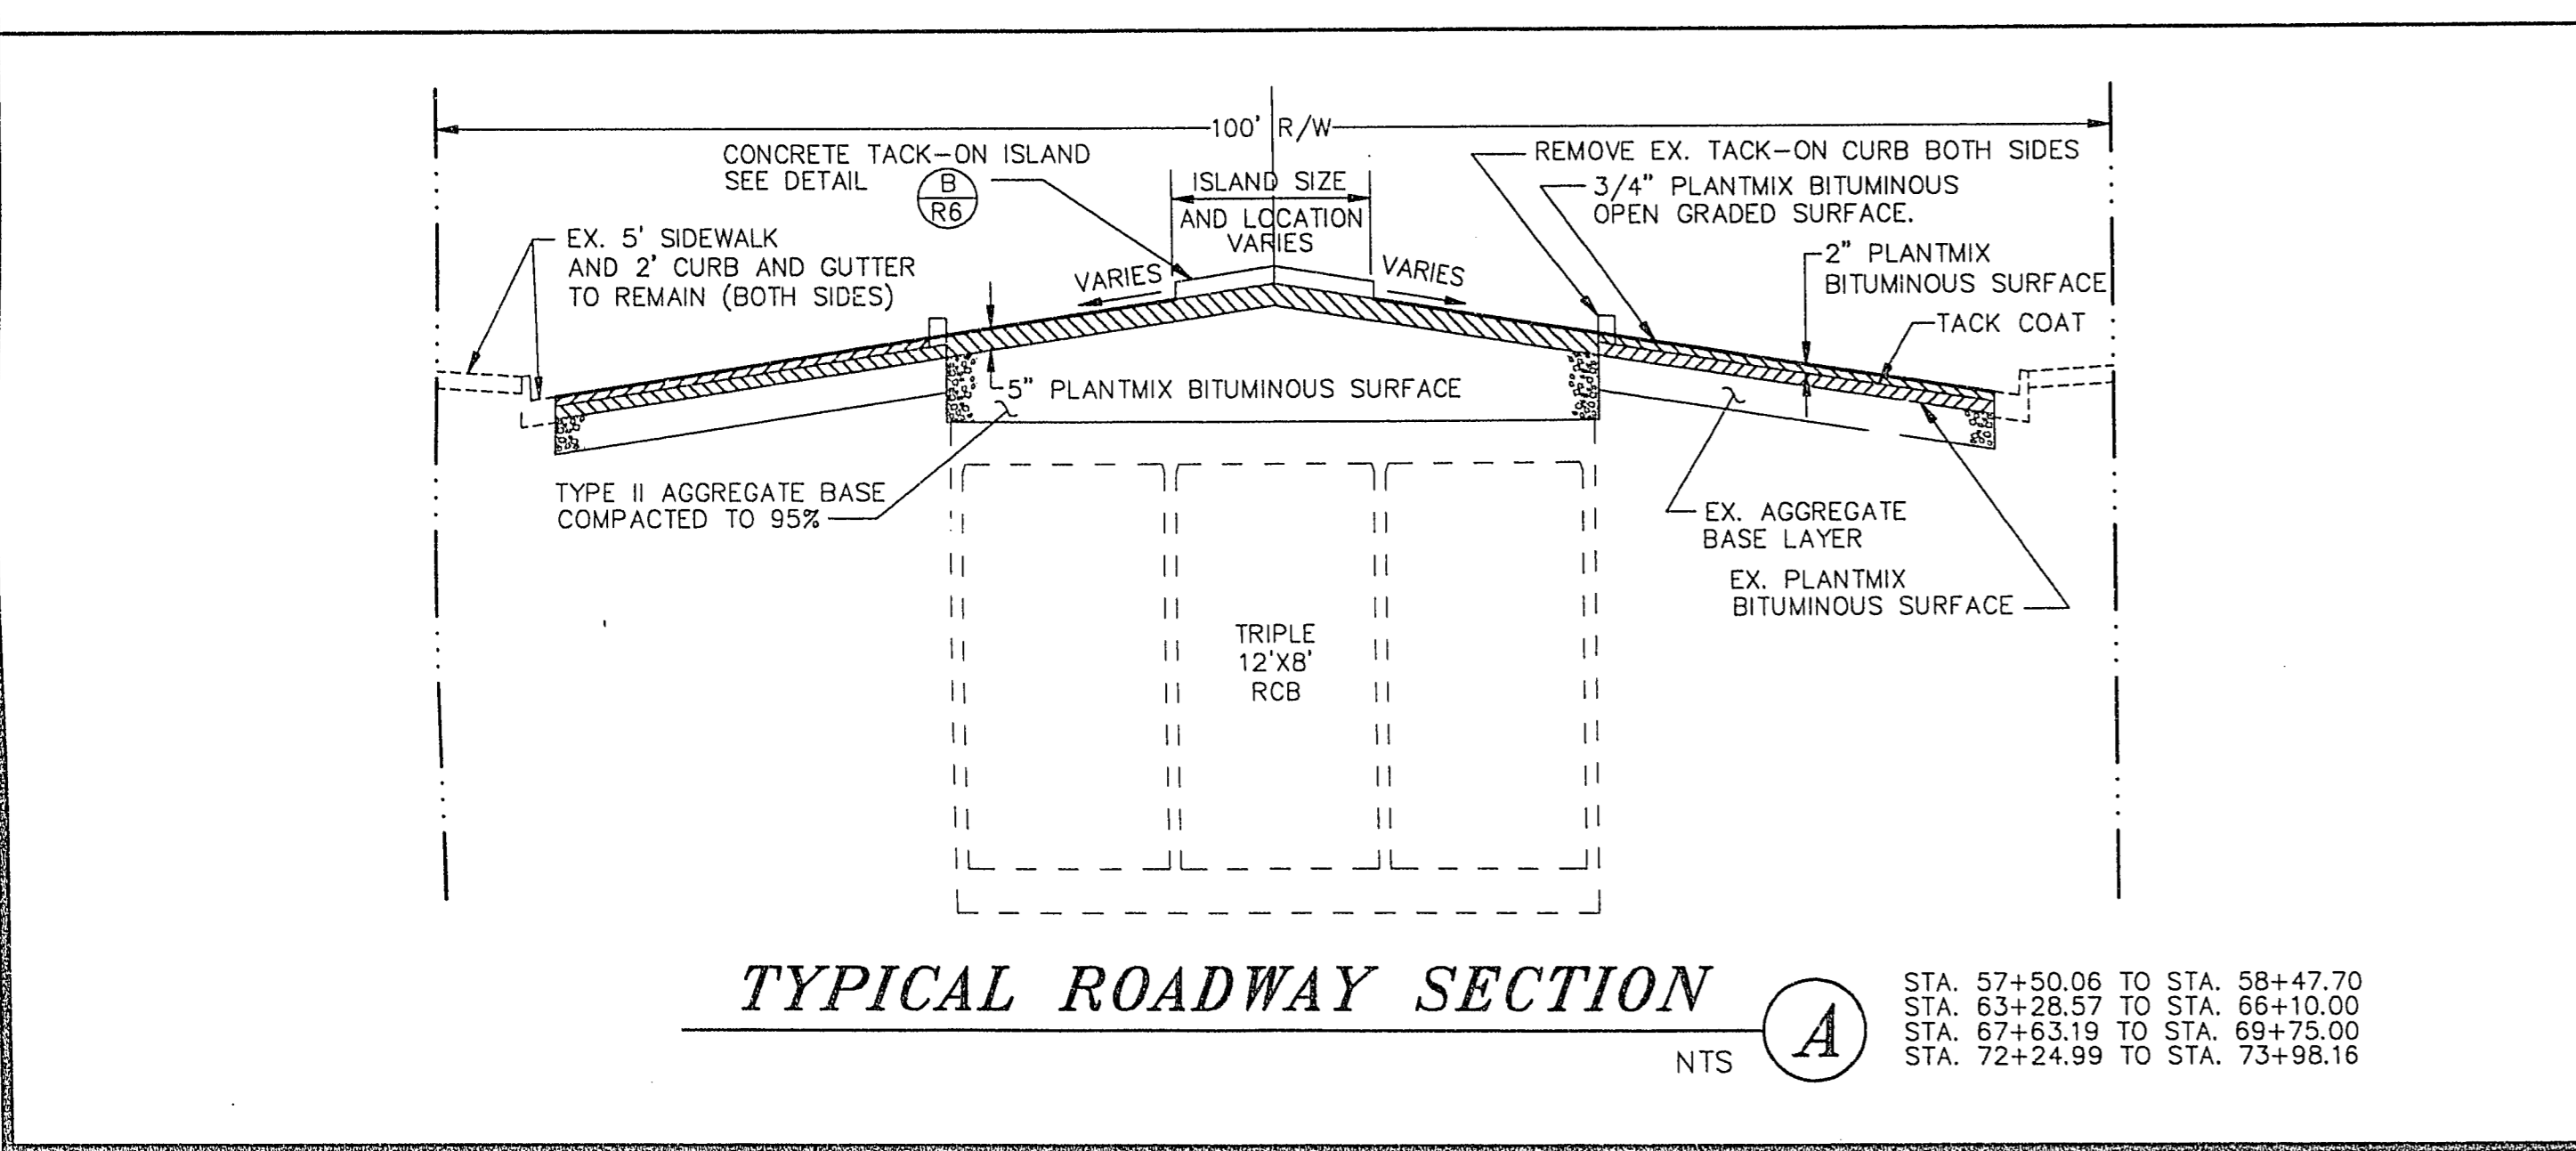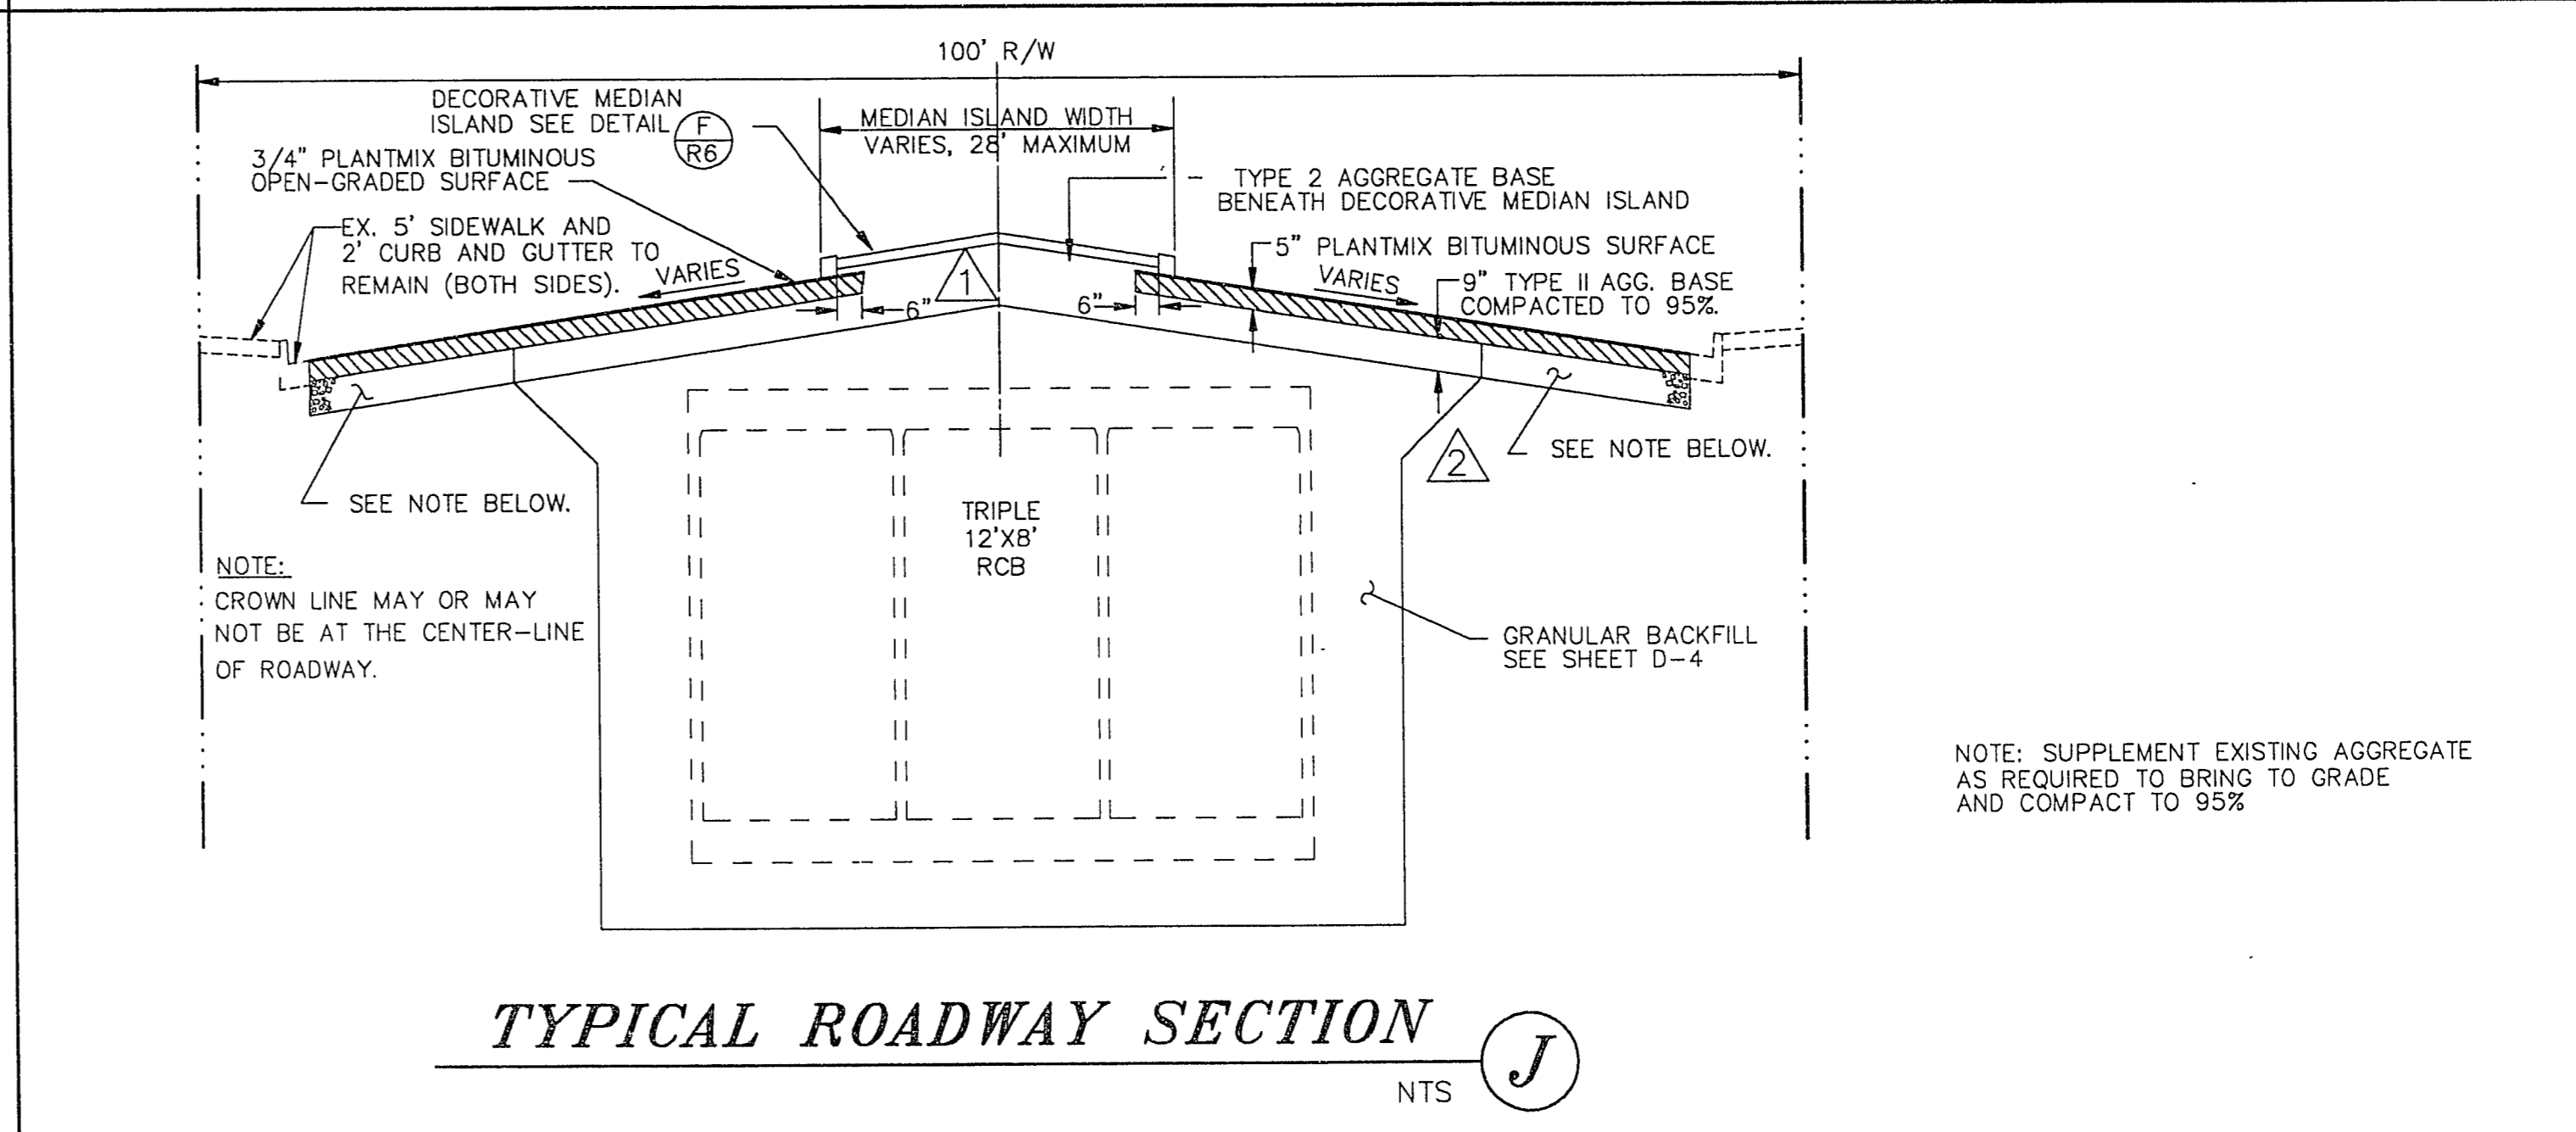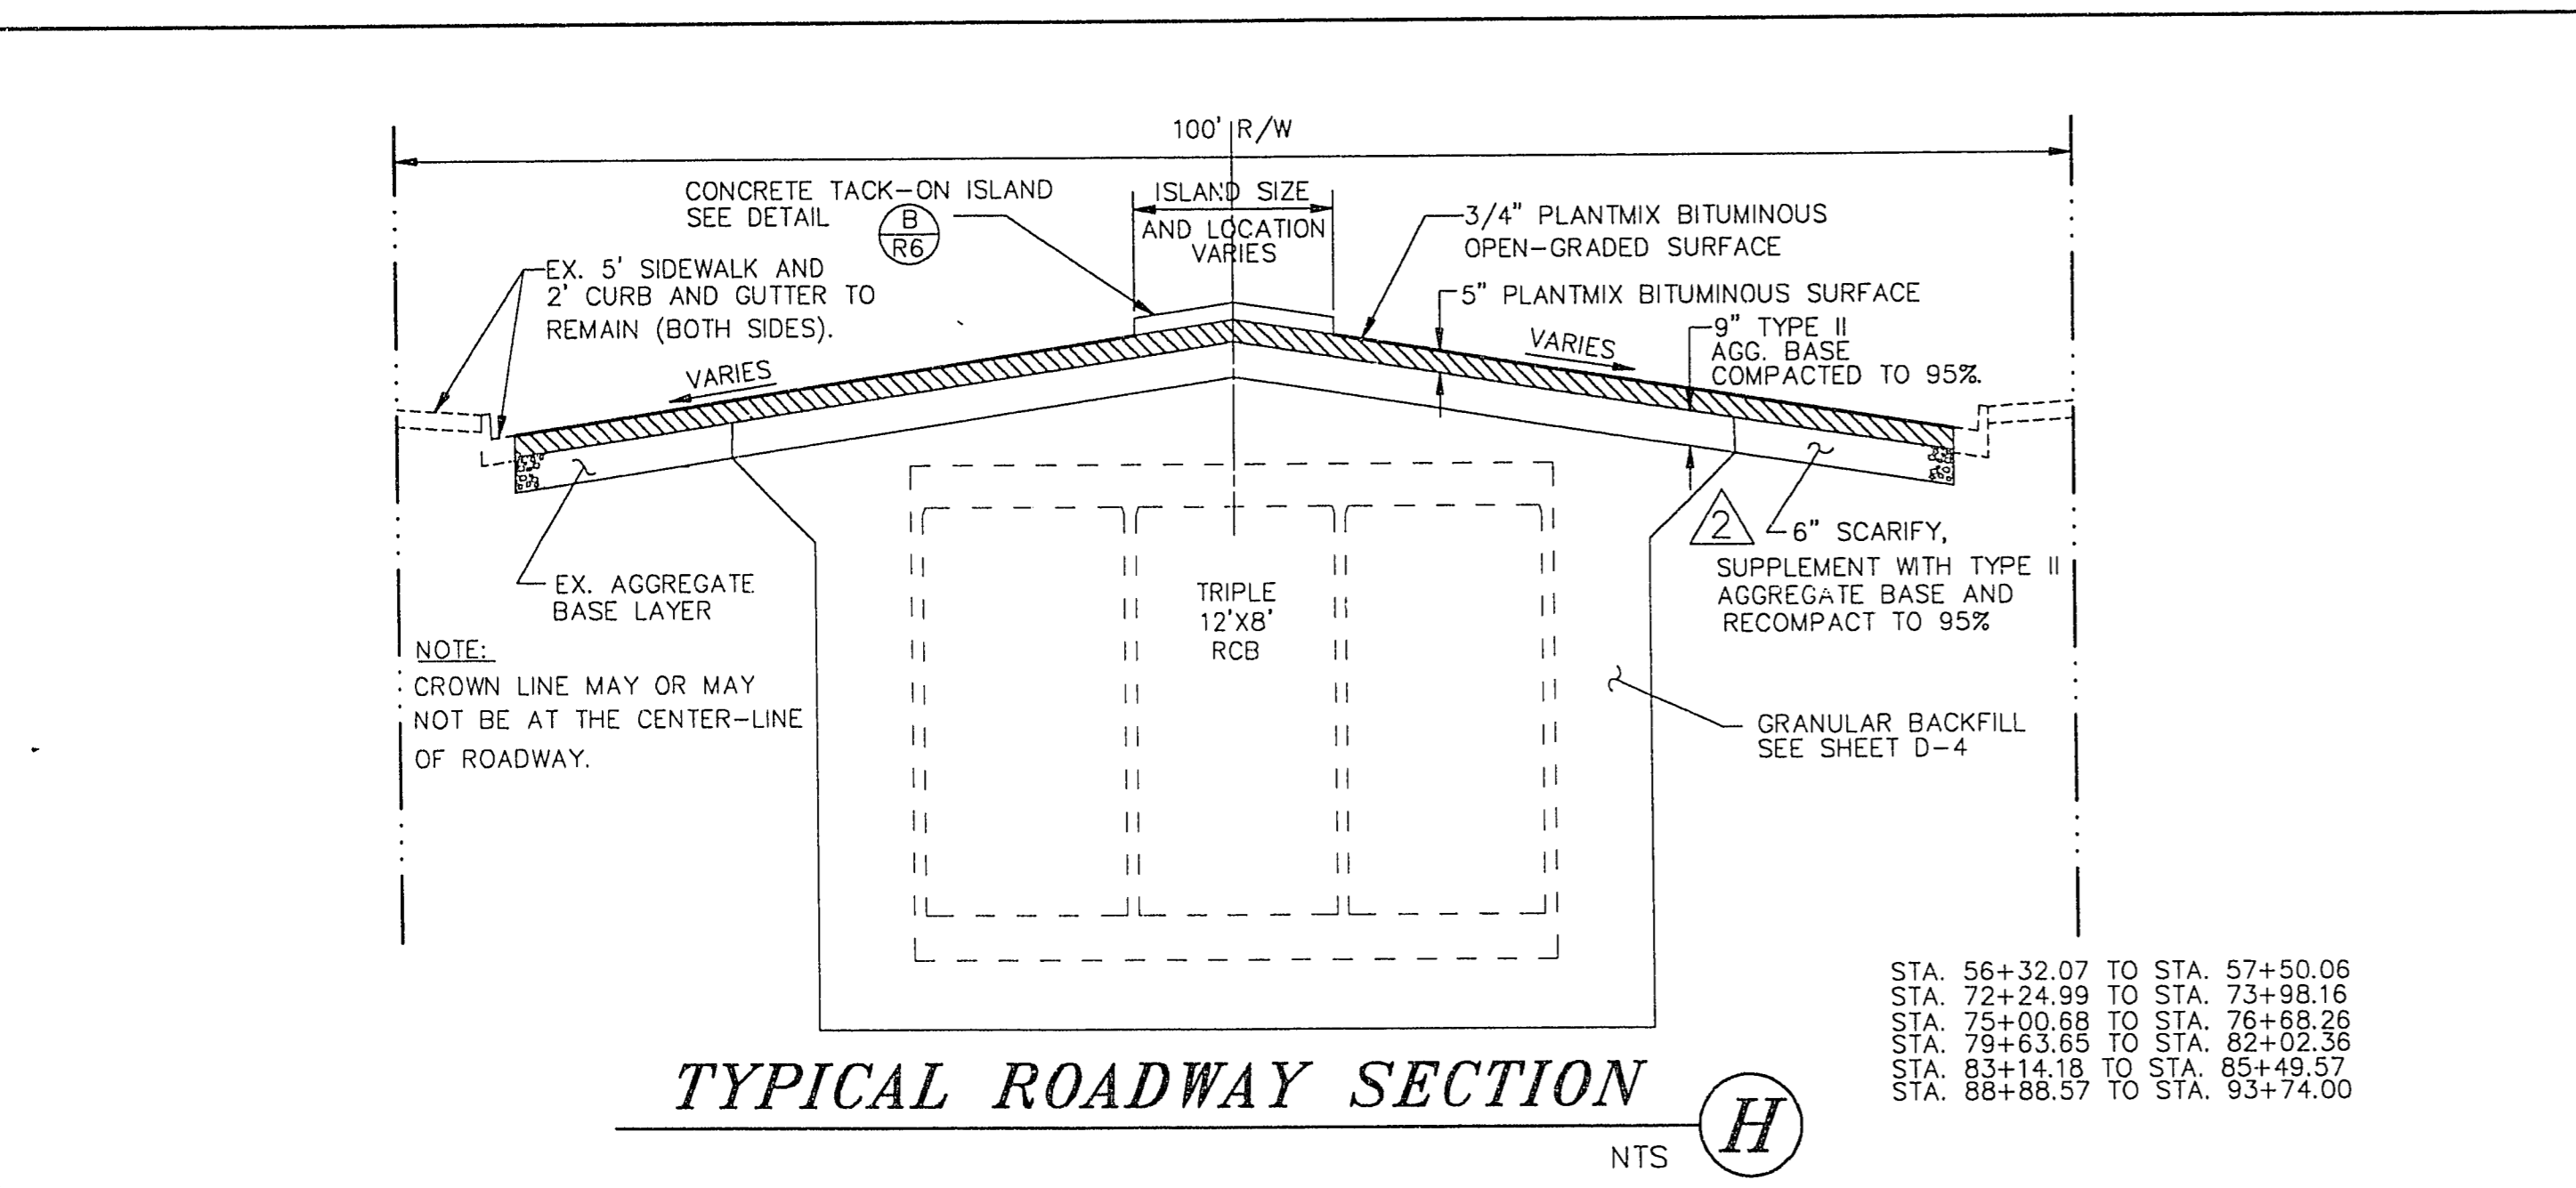

RECORD DRAWING

These Record Drawings have been prepared based on information provided by others. The Engineer has not verified the accuracy of such information and shall not be responsible for any errors or omissions which may be incorporated herein as a result.

REVISIONS	
No.	Date
1	11/22/94 Deleted 2" plus under dec. island
2	11/28/94 Revised Roadway typical sections
3	1/30/95 Modified Tack On Island Curb

PROJECT: CITY OF LAS VEGAS WASHINGTON AVENUE CONVEYANCE SYSTEM

DESCRIPTION: ROADWAY DETAILS

SHEET R-6

REVISED 19 OF 23