
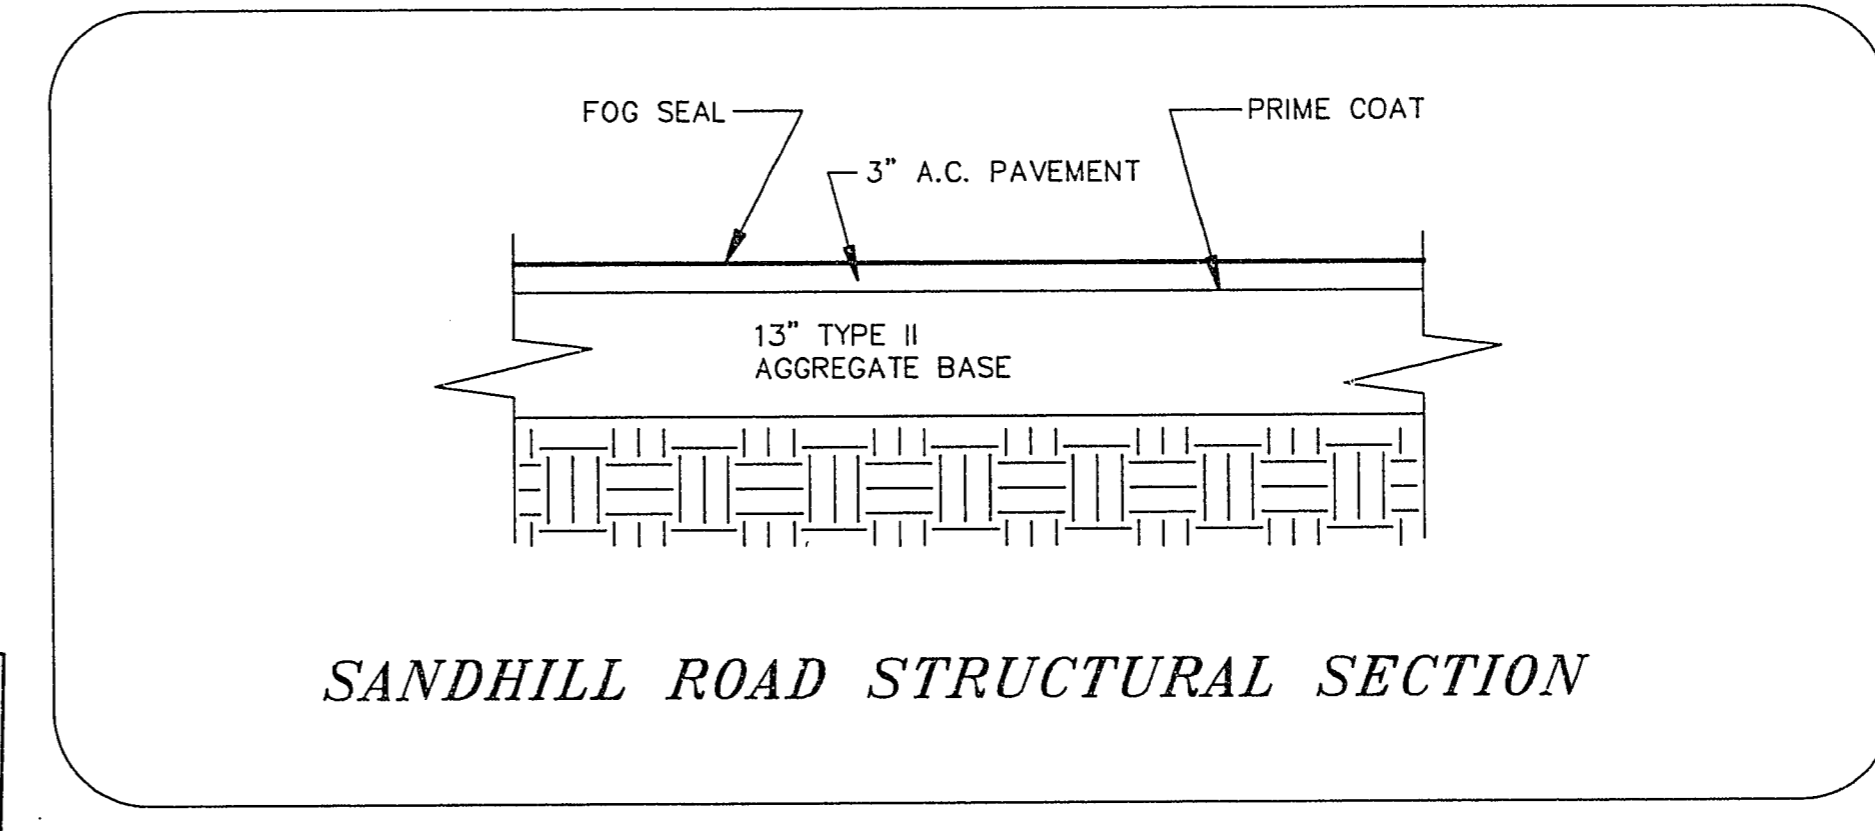
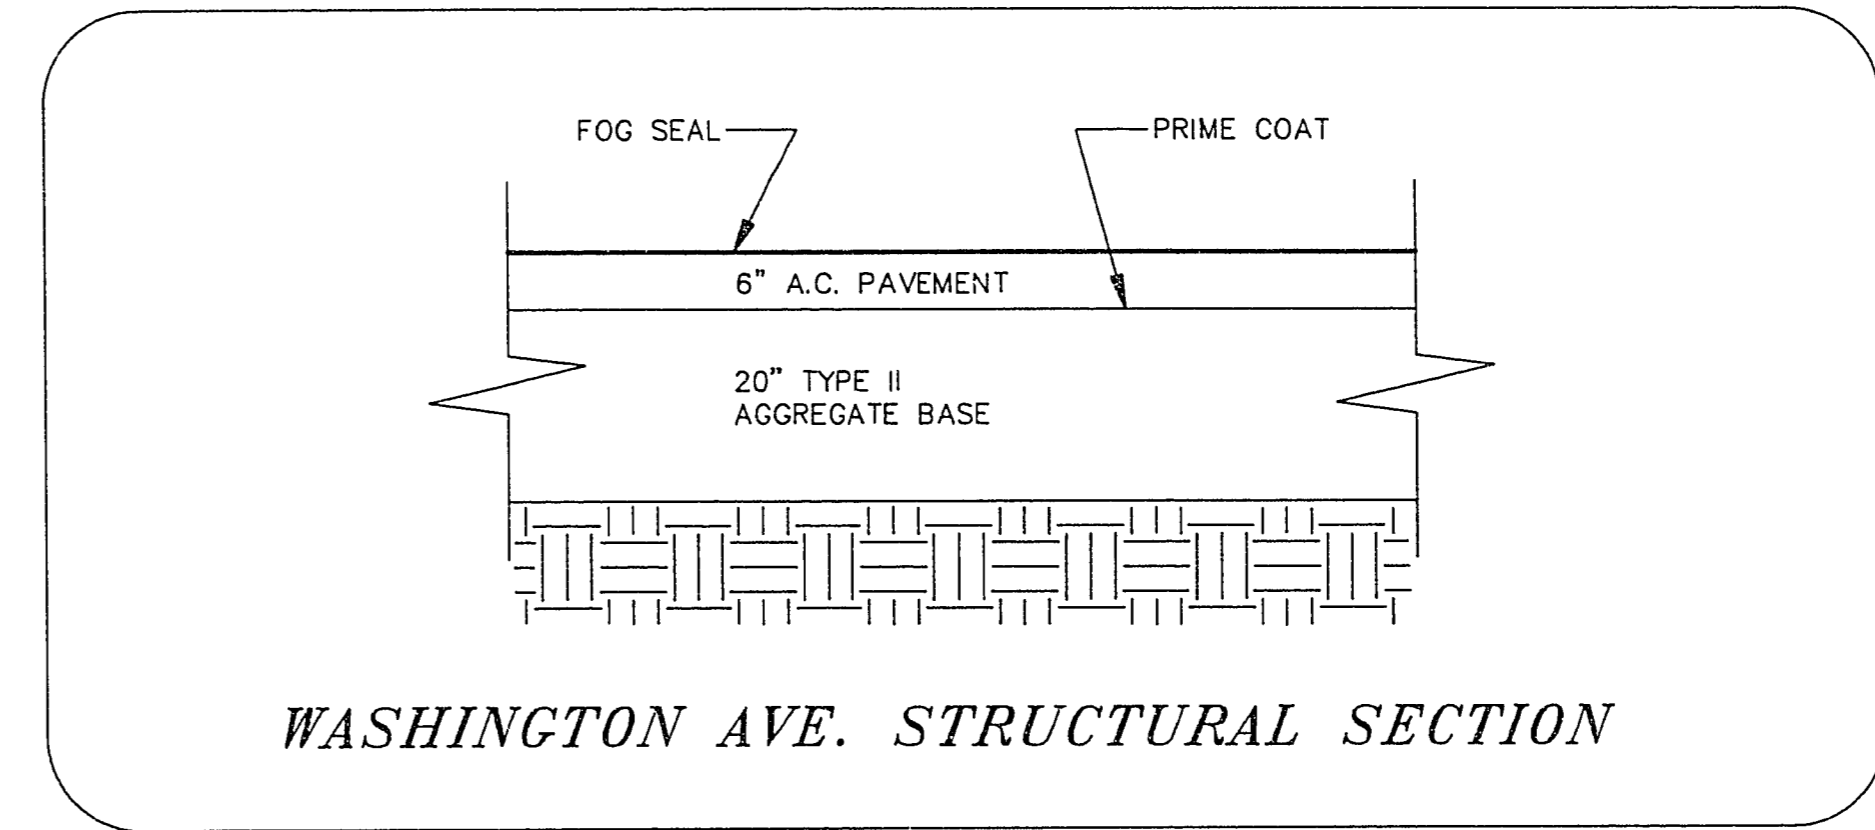




CONSTRUCTION NOTES

- | | |
|--|---|
| <p>CONSTRUCT</p> <ul style="list-style-type: none"> ① SAWCUT AND MATCH EXISTING PAVEMENT ② CONSTRUCT A.C. TRANSITION ③ CONSTRUCT 24" 'L' TYPE CURB AND GUTTER PER STD. DWG. No. 216 ④ CONSTRUCT CONCRETE SIDEWALK PER STD. DWG. No. 234 ⑤ CONSTRUCT 'L' TYPE ISLAND CURB PER STD. DWG. No. 219 ⑥ EXISTING SIDEWALK AND CURB & GUTTER TO REMAIN ⑦ VERTICALLY ADJUST SEWER MANHOLE ⑧ ADJUST WATER VALVES PER STD. DWG. No. 517 ⑨ CONSTRUCT MEDIAN ISLAND PER STD. DWG. No. 218 ⑩ CONSTRUCT ASPHALT PAVEMENT | <p>REMOVE AND/OR RELOCATE</p> <ul style="list-style-type: none"> ⑪ REMOVE EXISTING ASPHALT ⑫ REMOVE EXISTING CURB & GUTTER ⑬ REMOVE EXISTING SIDEWALK ⑭ REMOVE EXISTING DRIVEWAY ⑮ REMOVE EXISTING DRAINAGE PIPE ⑯ REMOVE AND RELOCATE TRAFFIC SIGN ⑰ REMOVE AND RELOCATE BY OTHERS |
|--|---|

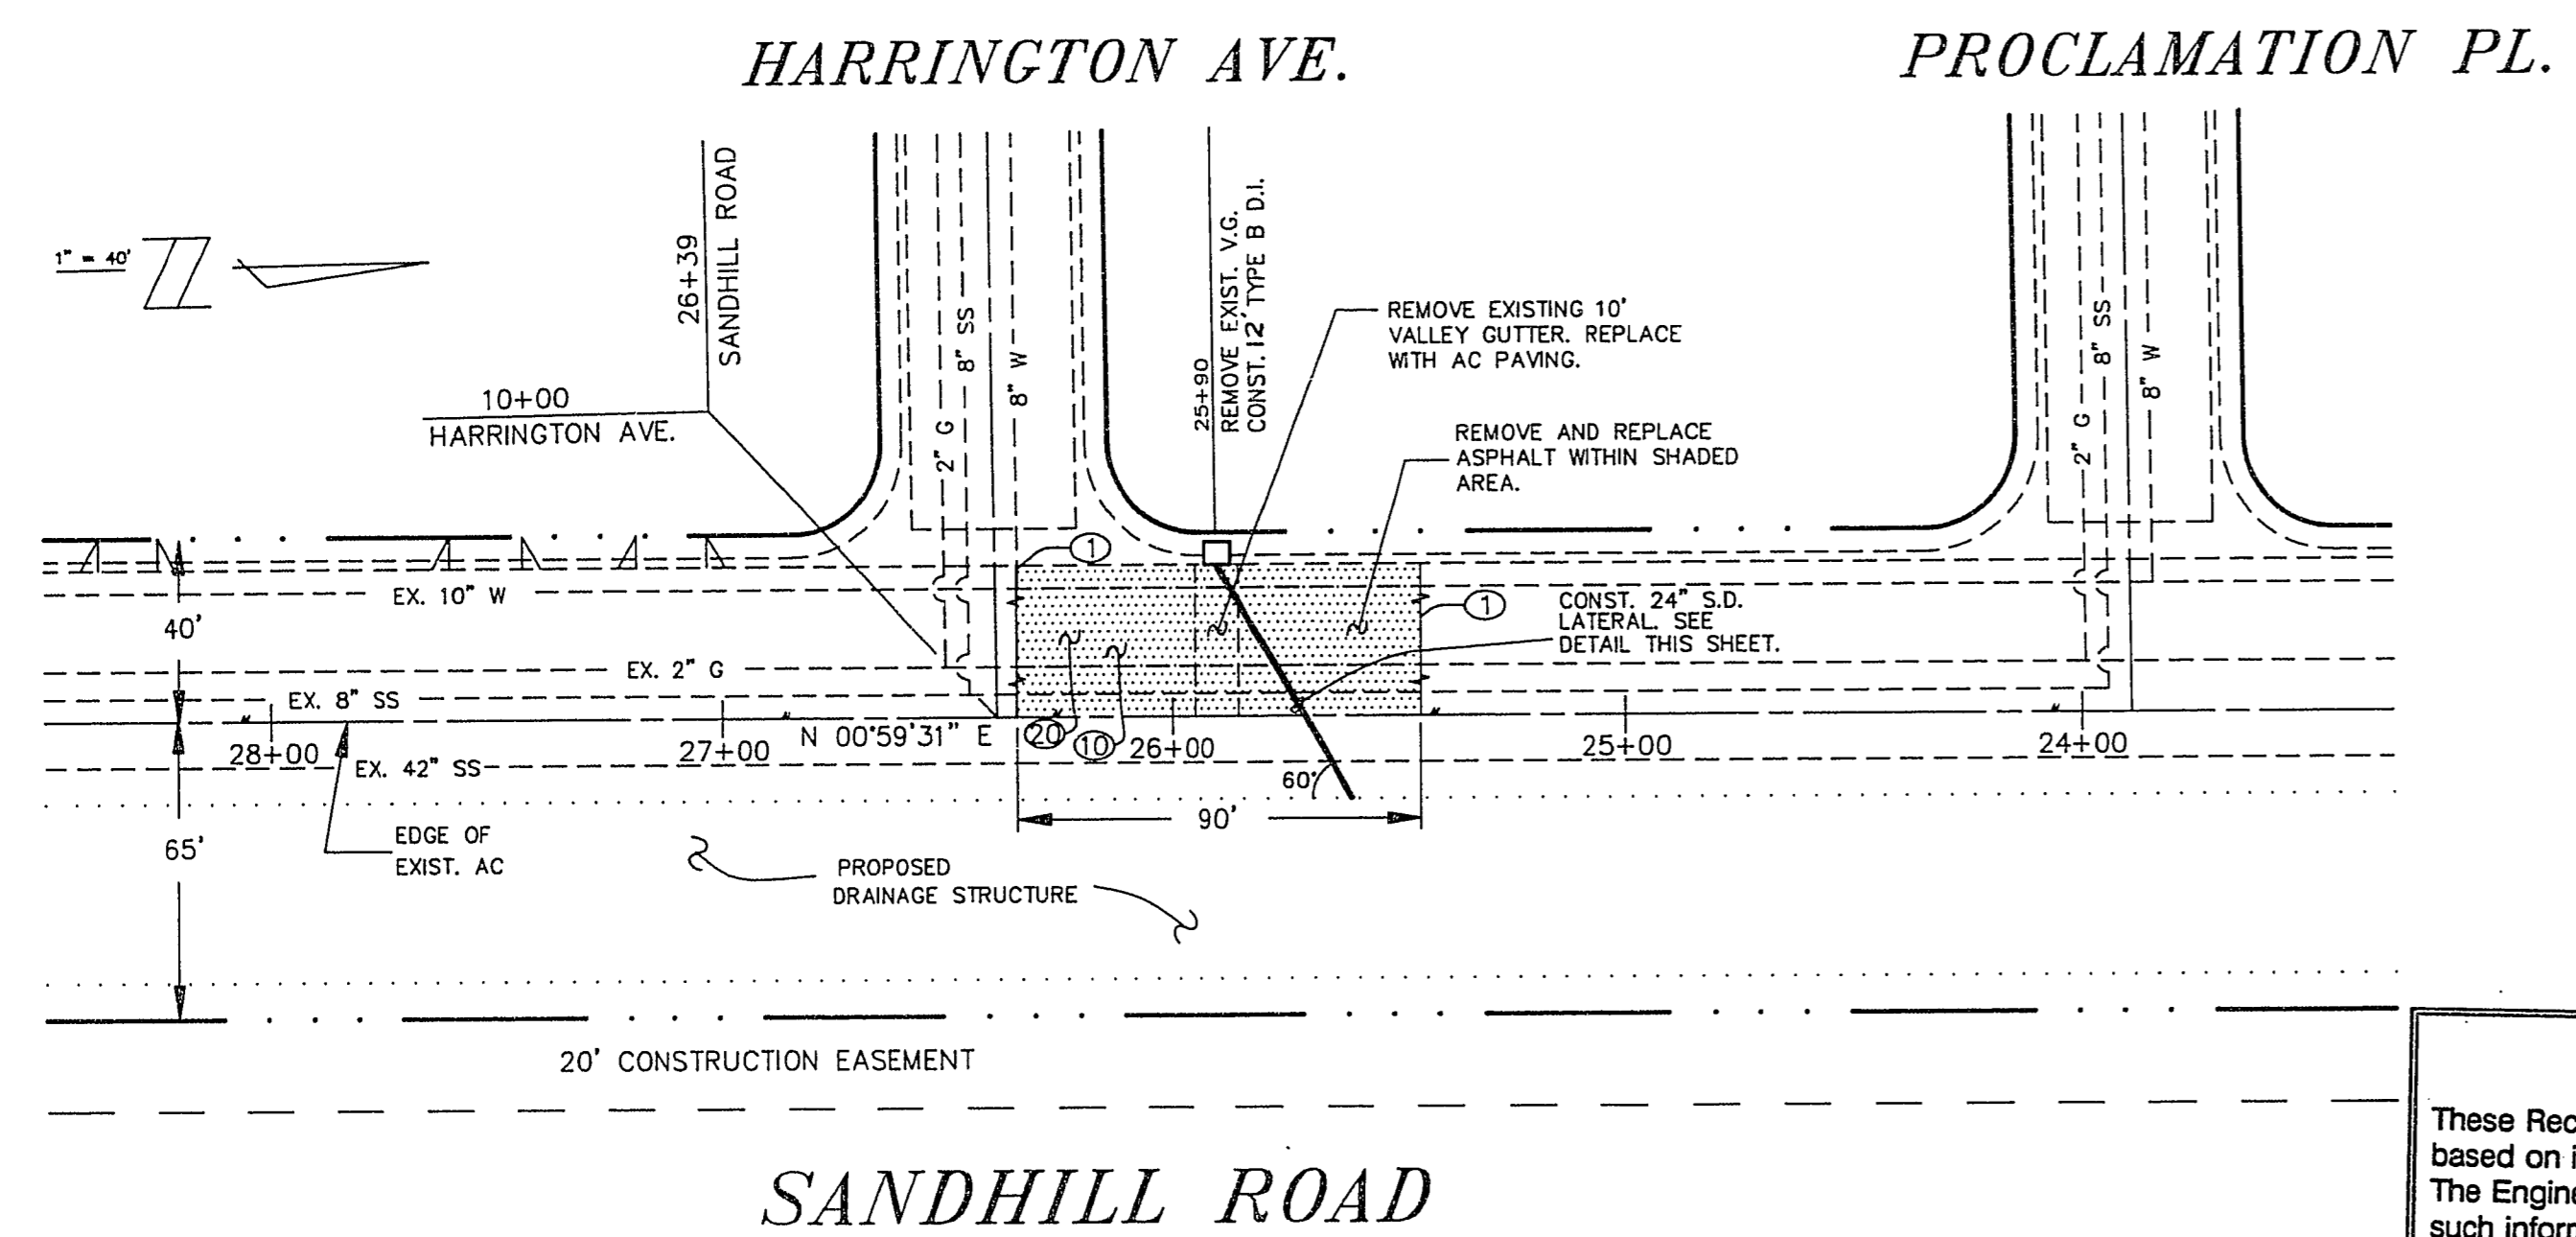

RECORD DRAWING

These Record Drawings have been prepared based on information provided by others. The Engineer has not verified the accuracy of such information and shall not be responsible for any errors or omissions which may be incorporated herein as a result.

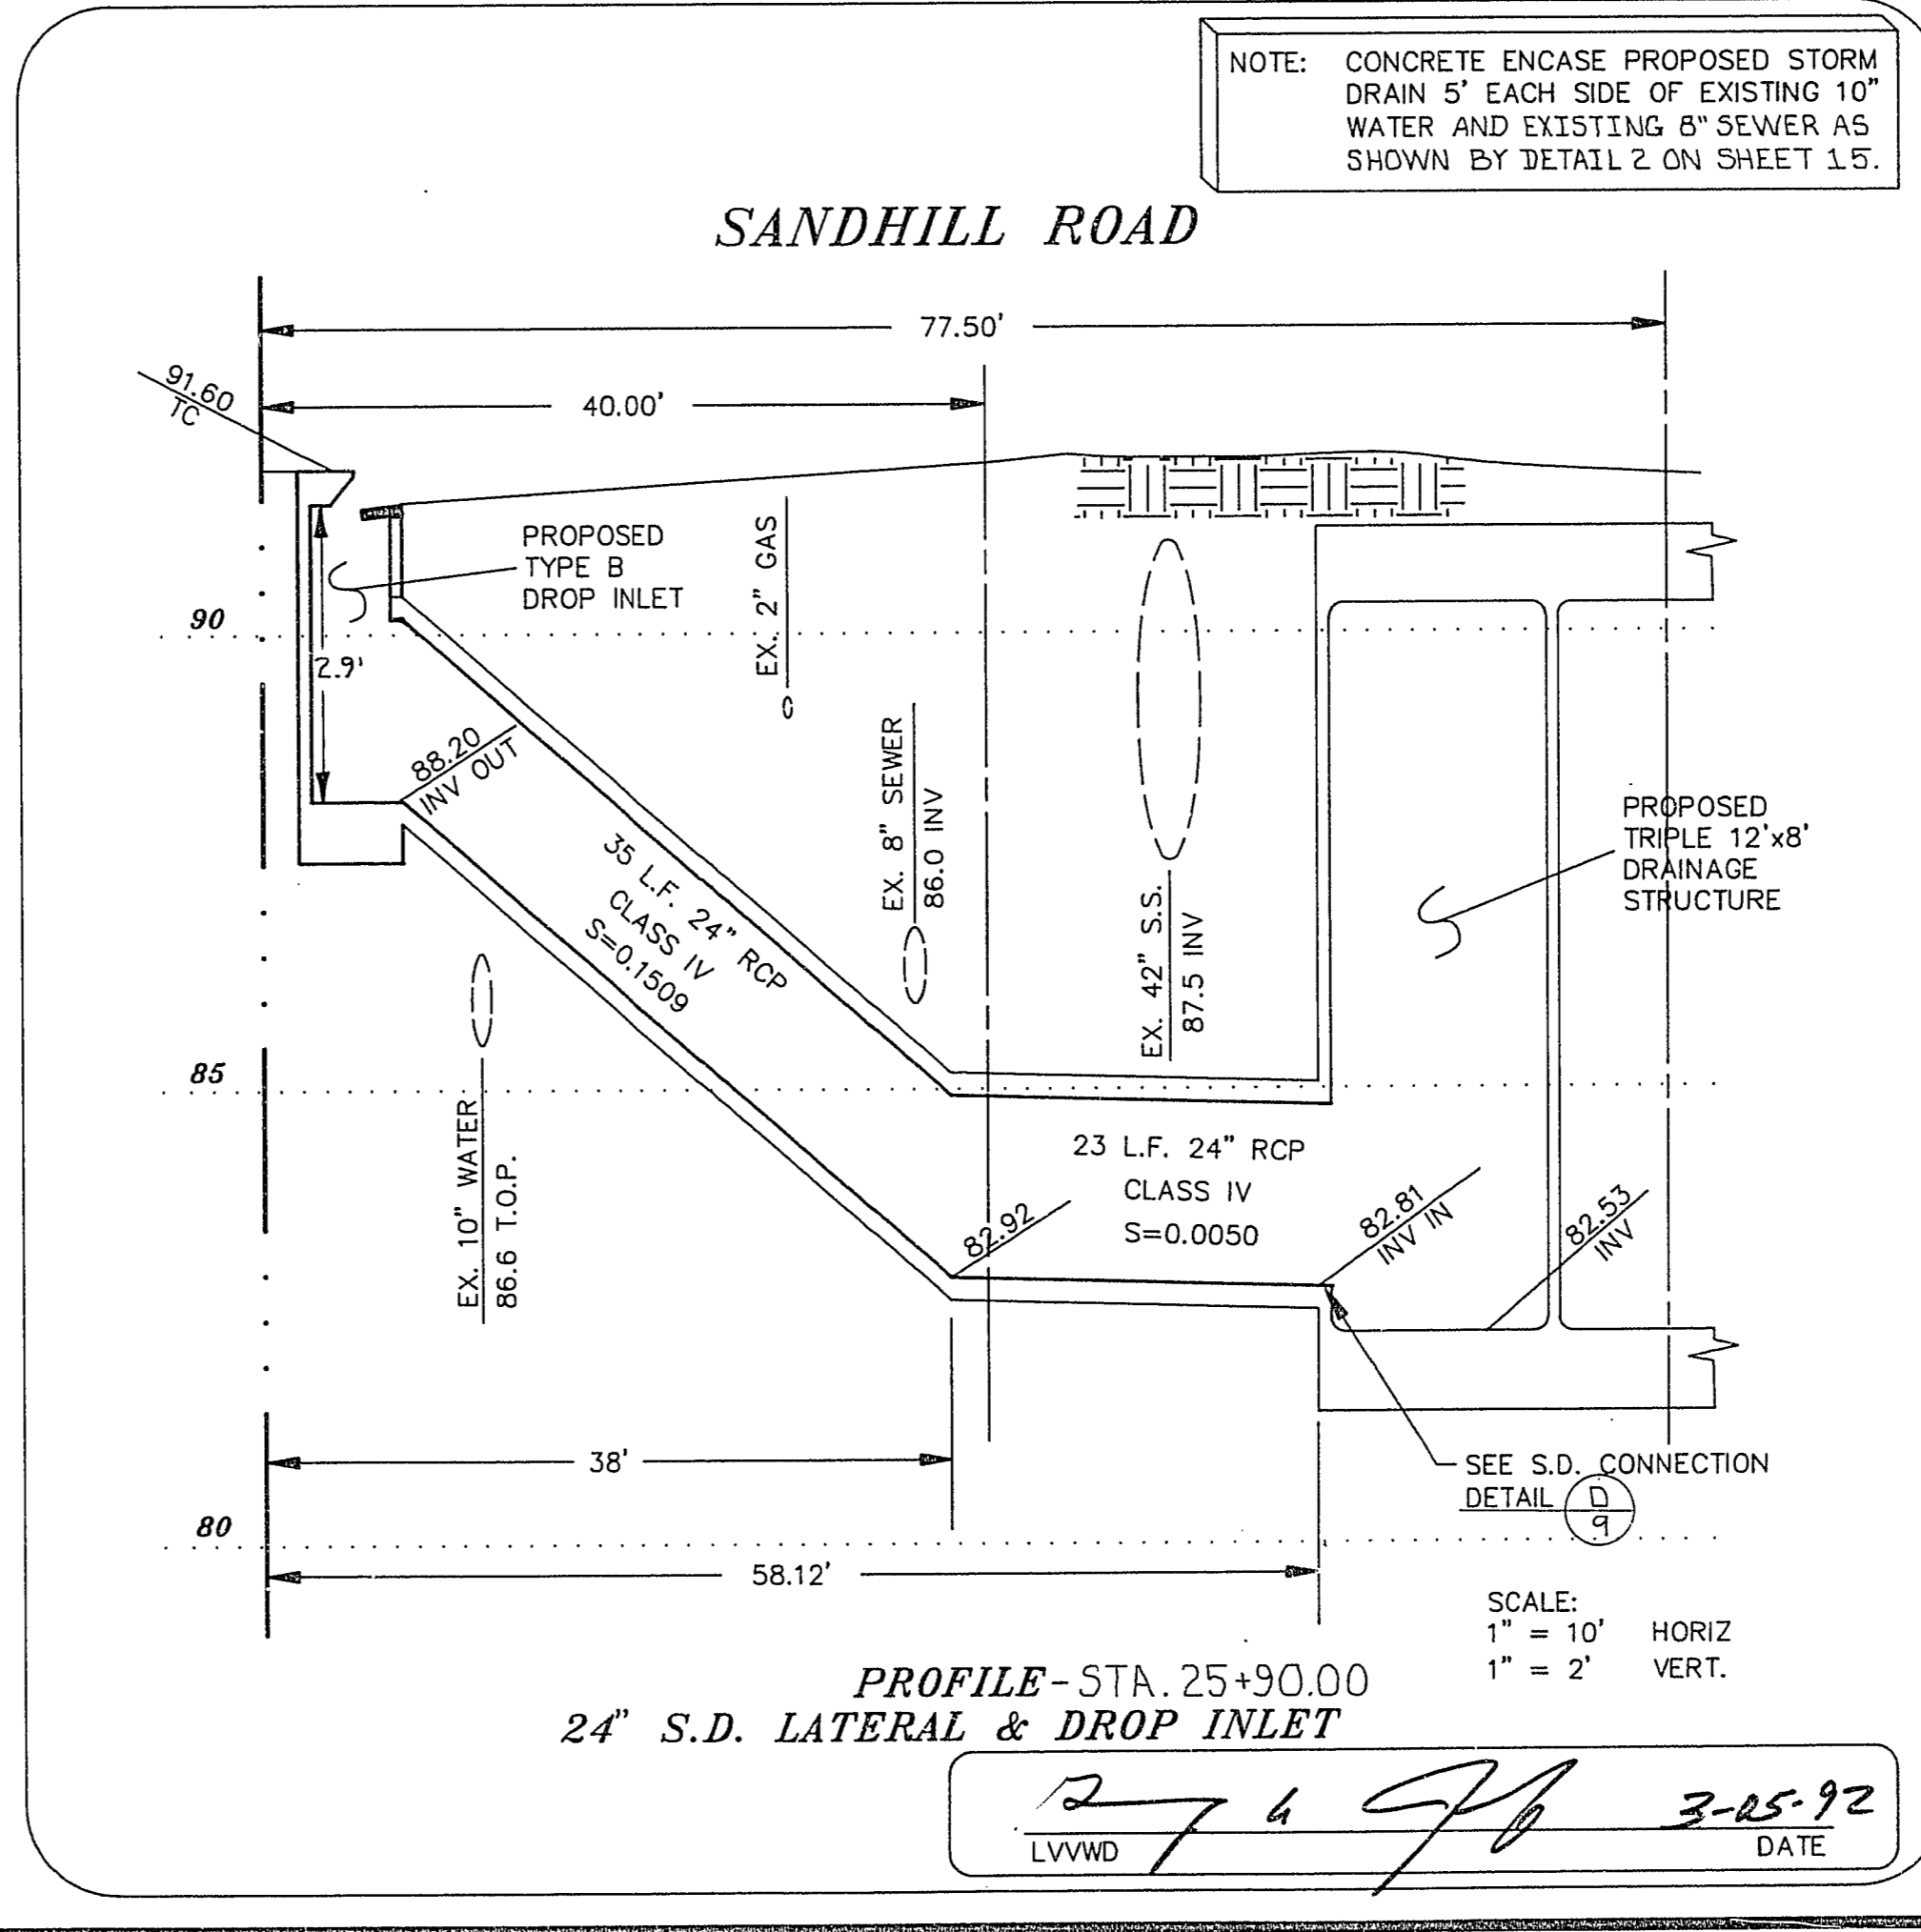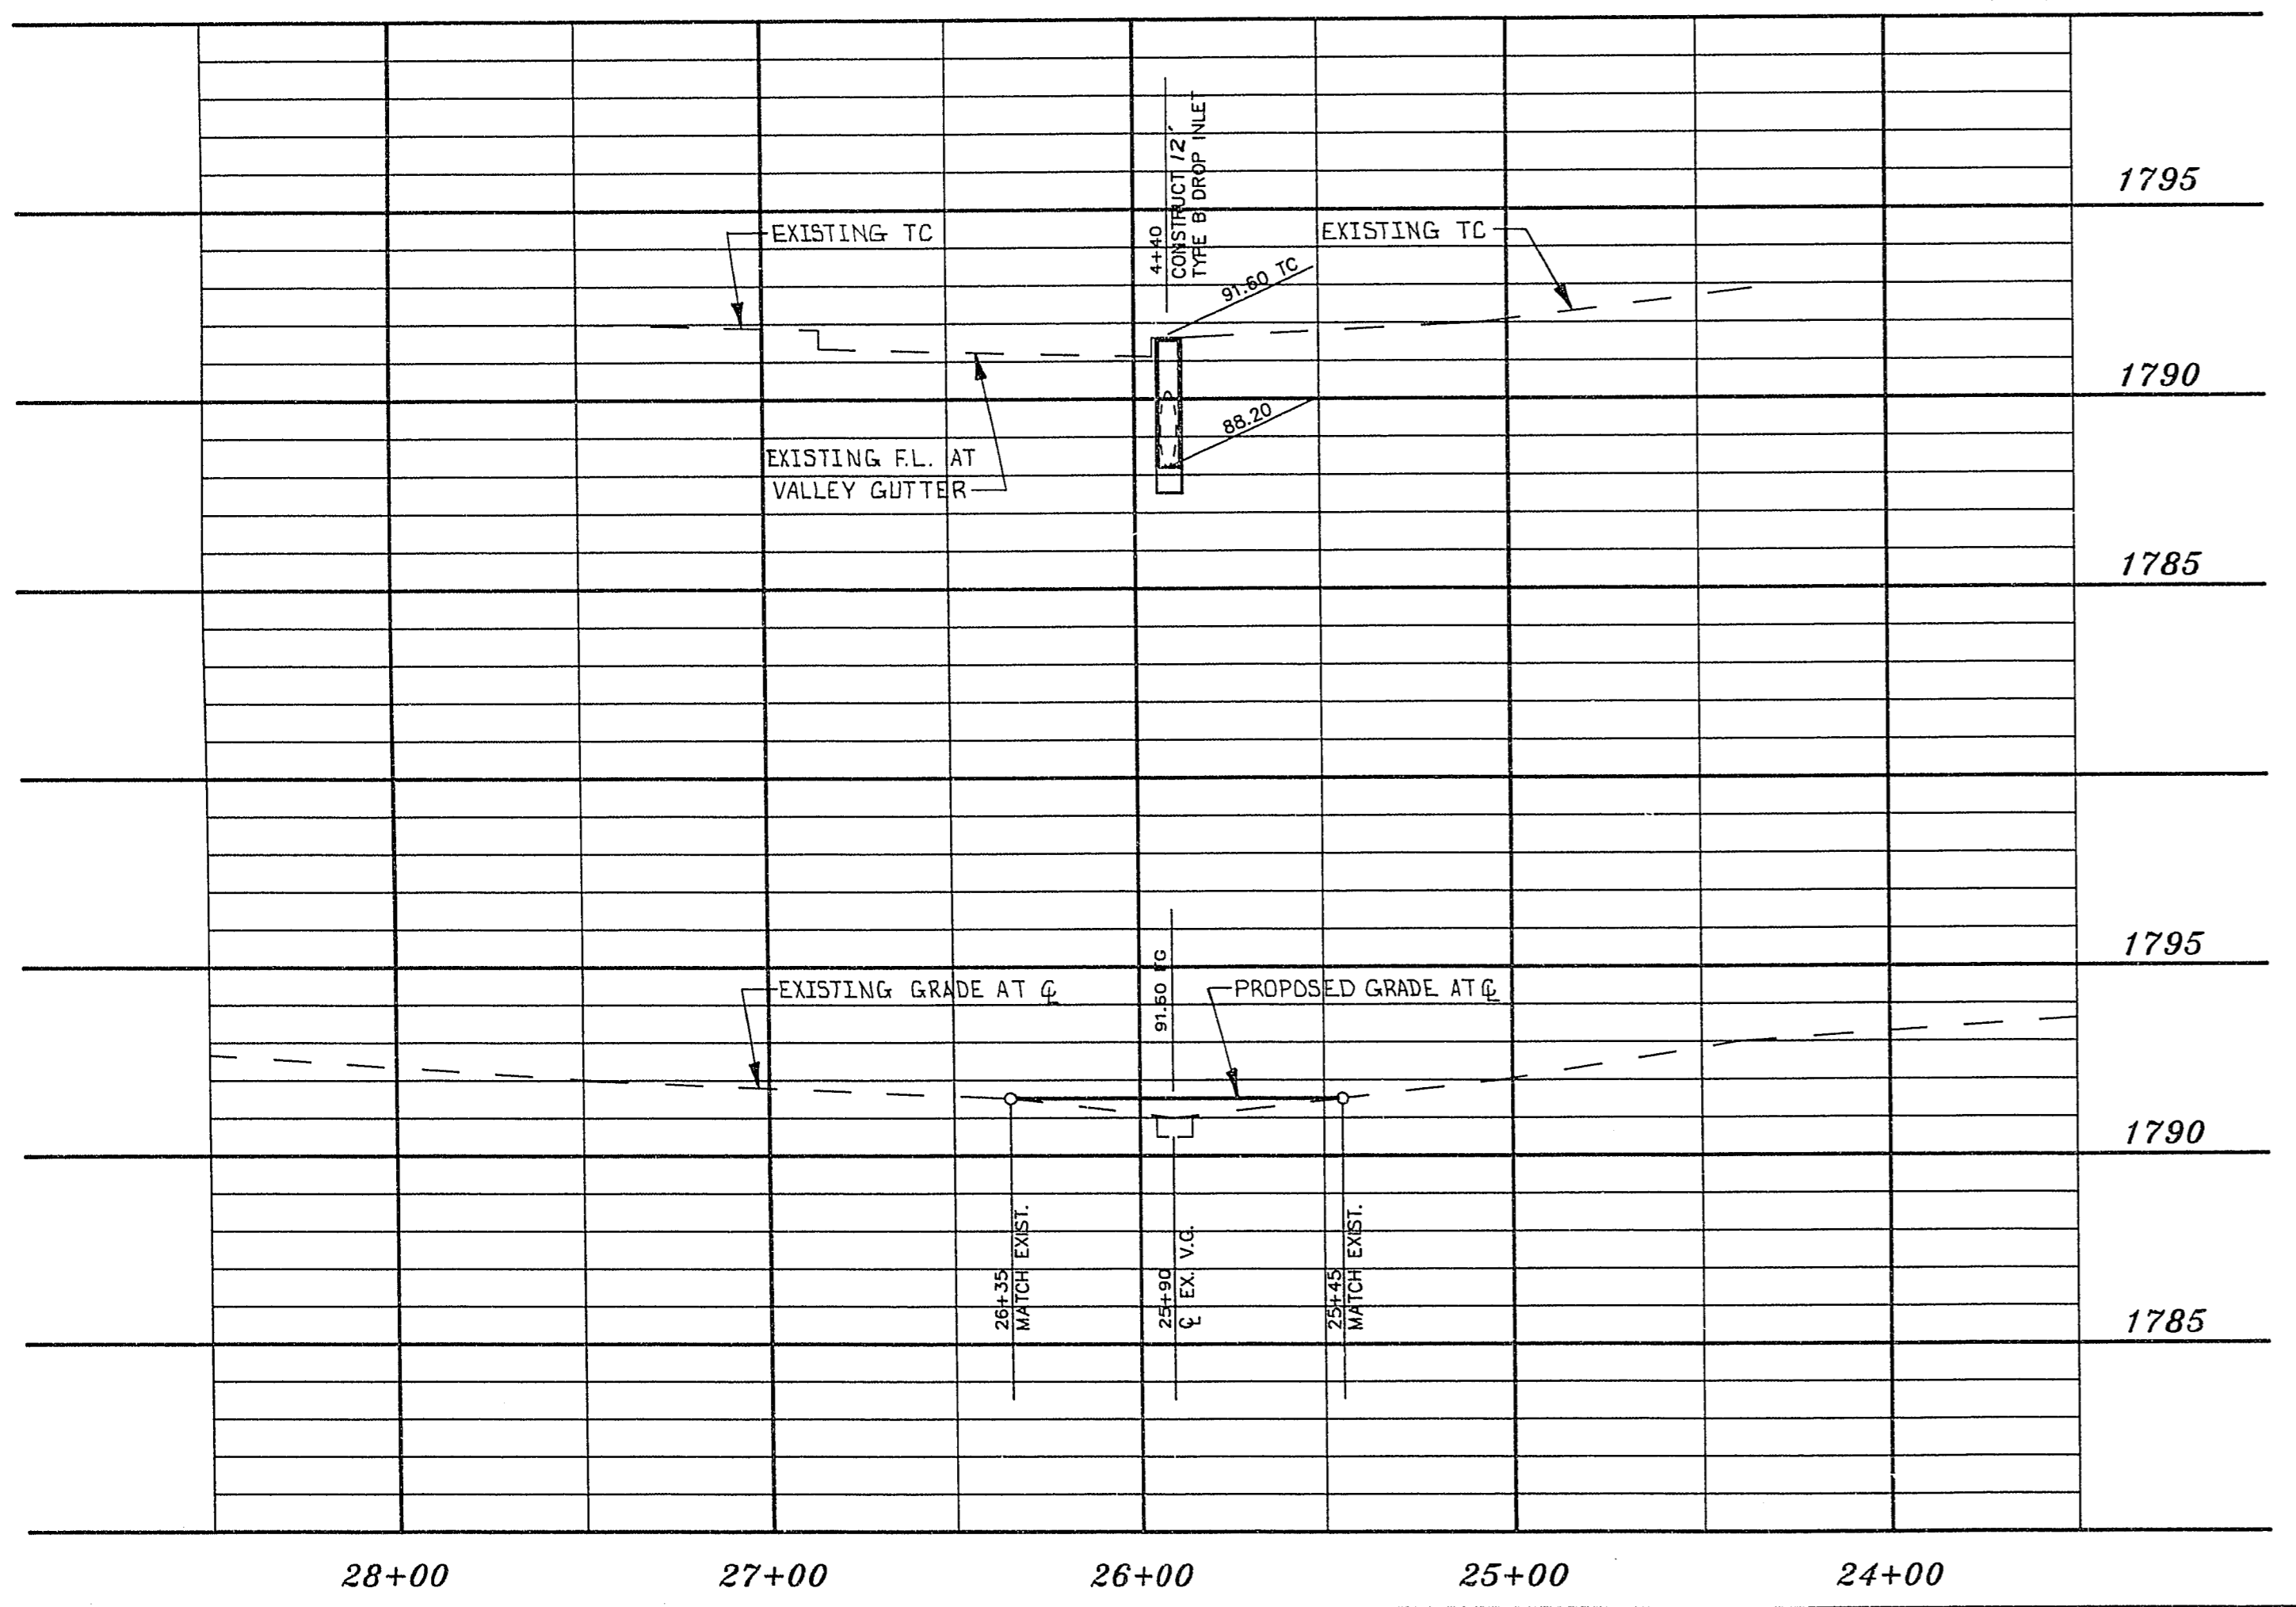

REVISIONS	
No.	Date

DESIGNED BY: RJT
 DRAWN BY: RUT/PSM
 CHECKED BY: JHG
 JOB NO.: 343-90
 SCALE: AS NOTED
 HORIZ: AS NOTED
 VERT: AS NOTED

1055 EAST TROPICANA
 SUITE 800
 LAS VEGAS, NEVADA 89119
 (702)798-1007

AEA
 CONSULTING ENGINEERS

PROJECT: WASHINGTON AVENUE CONVEYANCE SYSTEM
 SANDHILL OUTFALL
 SANDHILL ROAD
 DROP INLET & LATERAL DESIGN

SHEET 12 OF 15

Avoid cutting underground utility lines - It's costly.

Call before you Dig.

1-800-227-2600
UNDERGROUND SERVICE ALERT (USA)

DATE: 3-25-92
 DATE: 3-25-92