

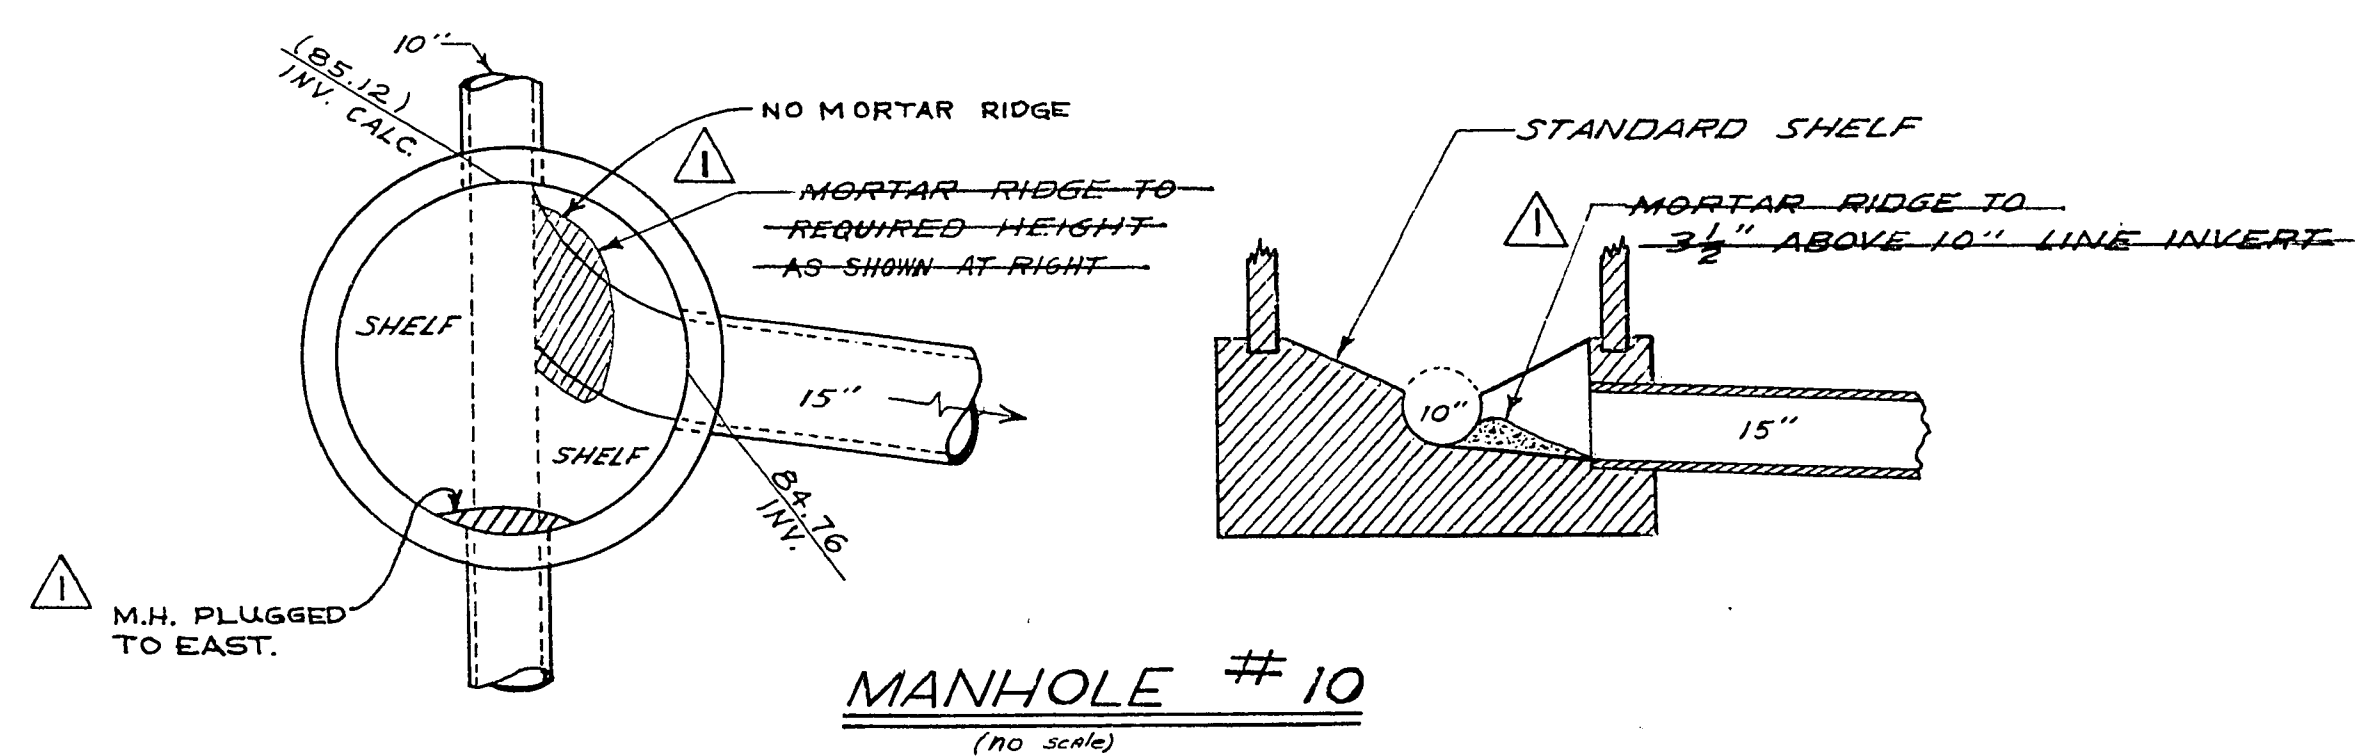
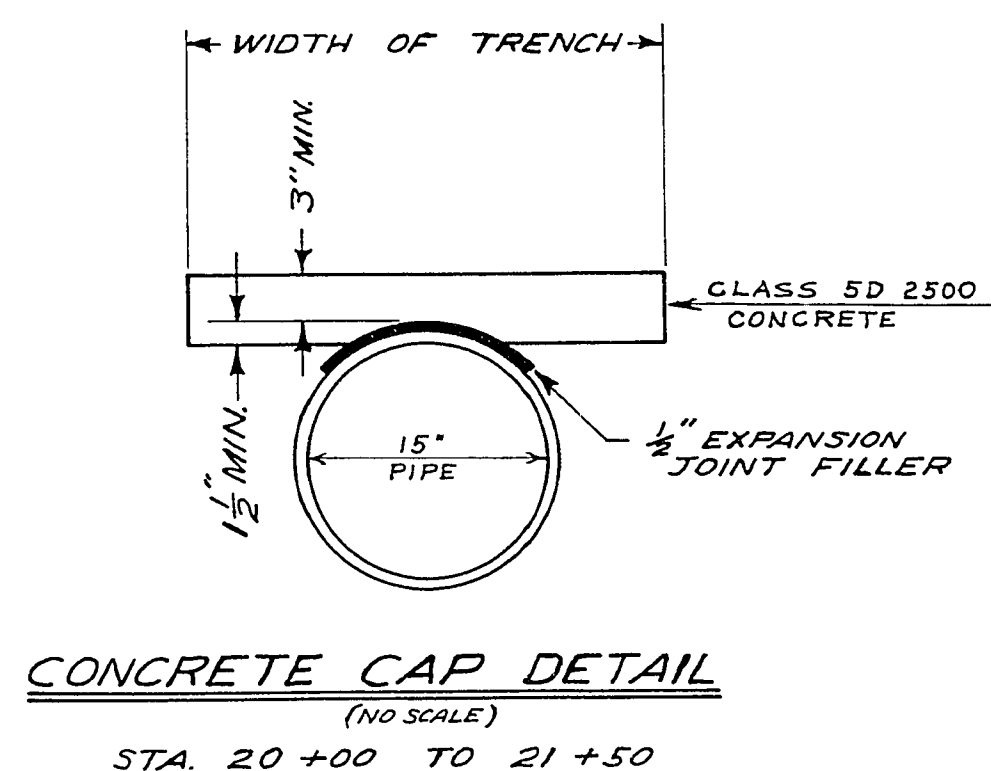
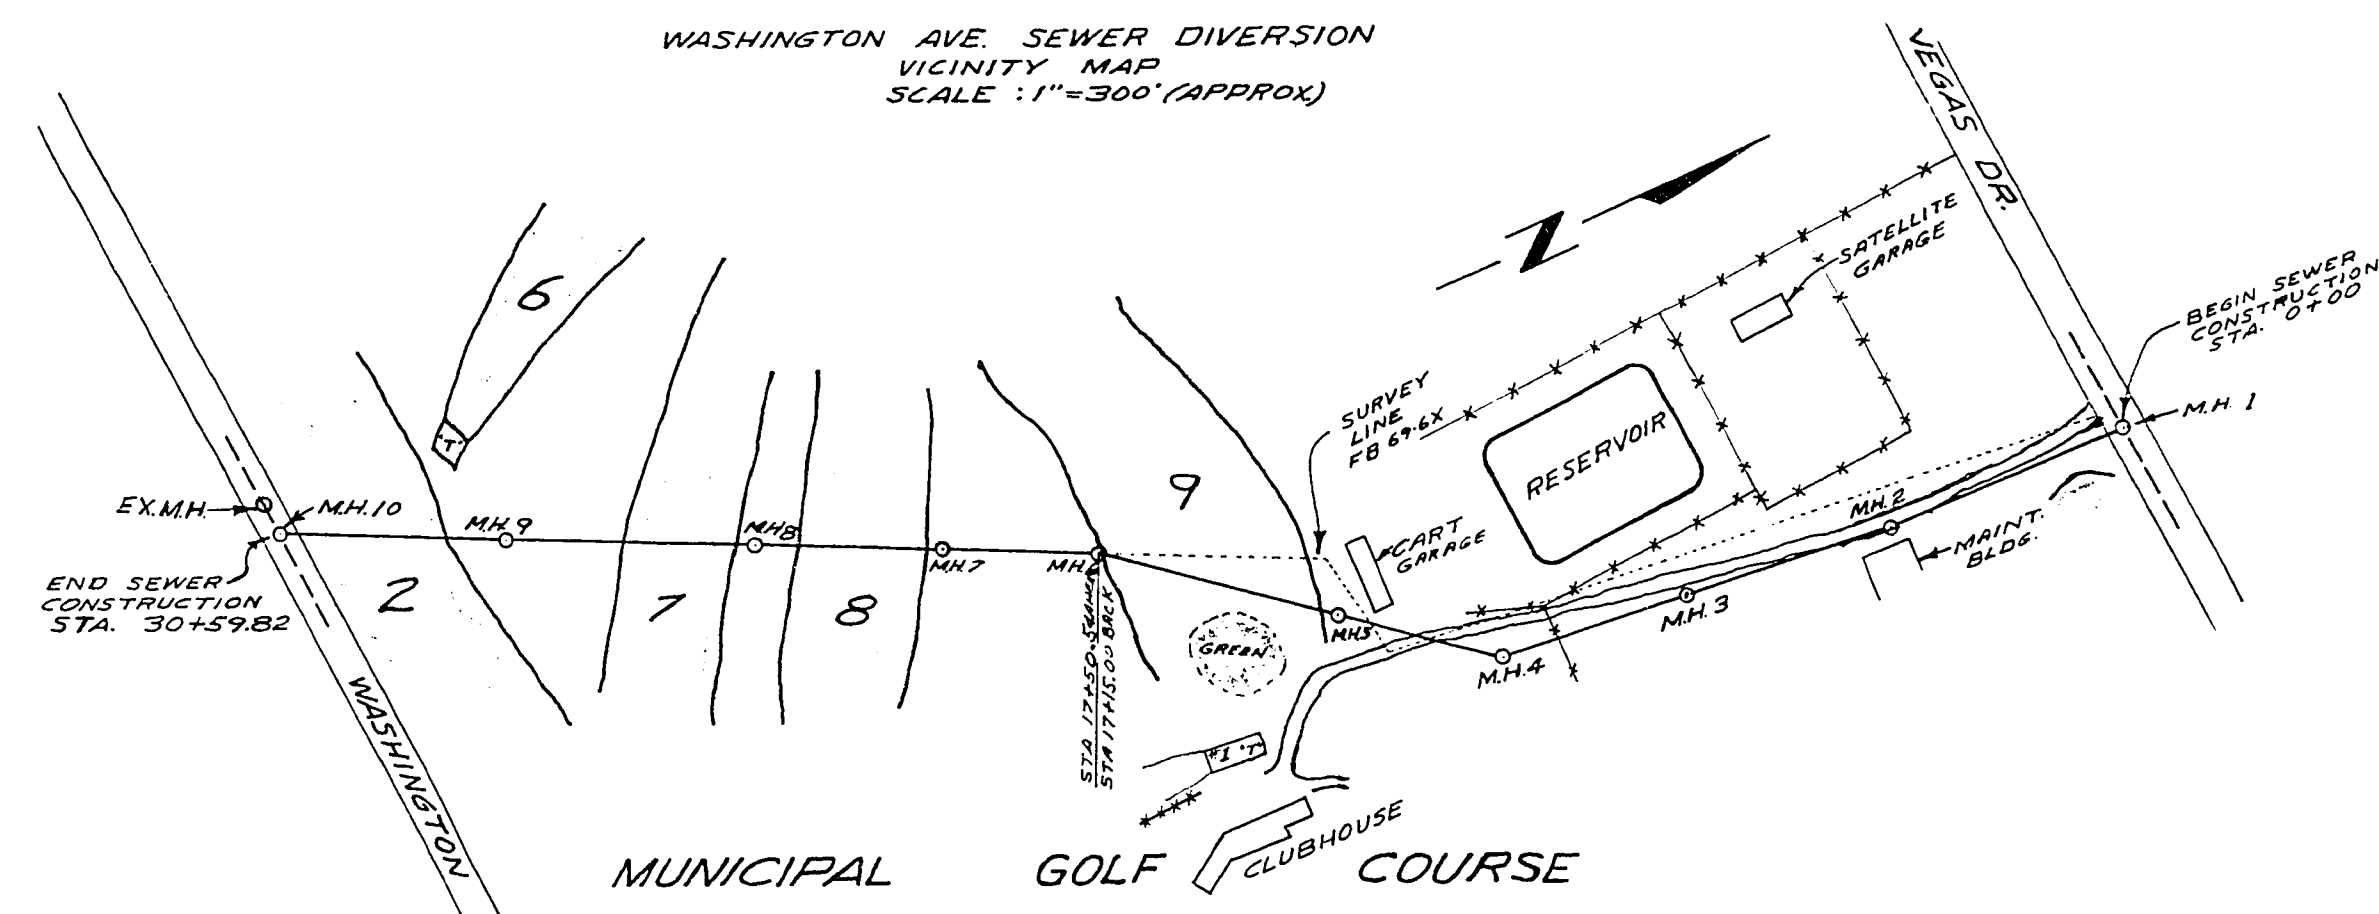


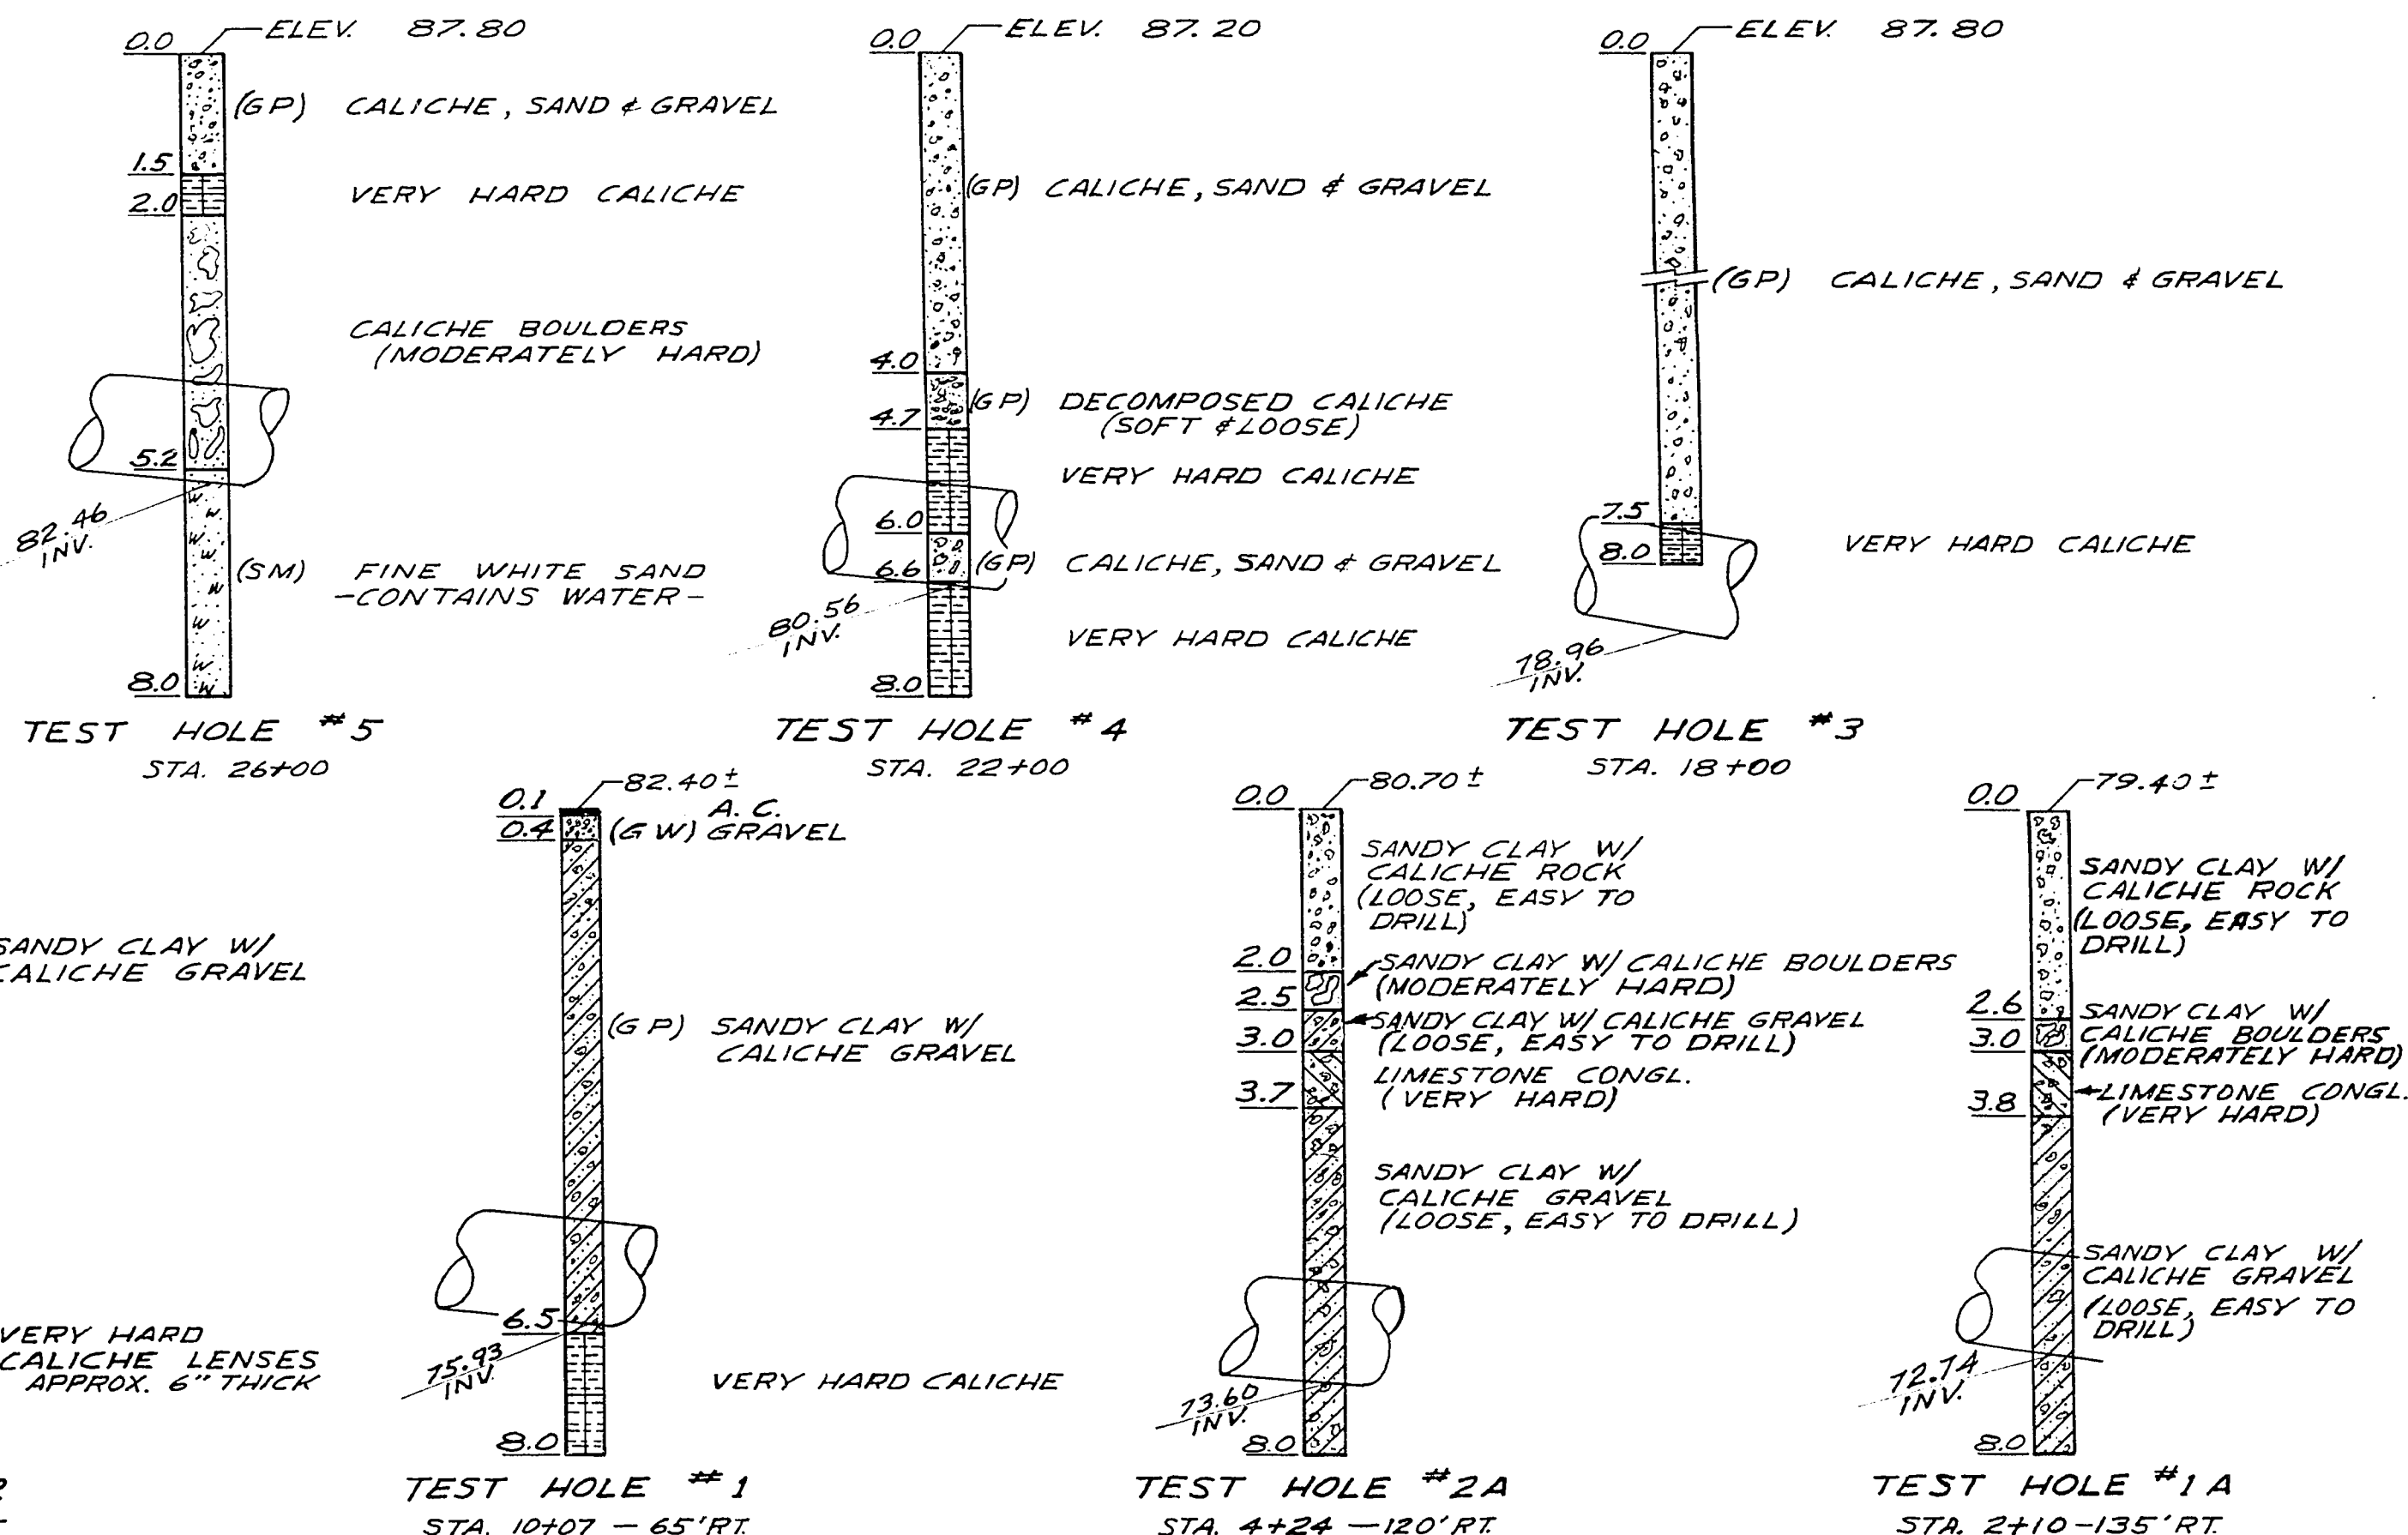

EXISTING UTILITIES ARE LOCATED ON THE PLANS FOR THE CONVENIENCE OF THE CONTRACTOR ONLY. THE CONTRACTOR SHALL BE FULLY RESPONSIBLE FOR THE LOCATION OF UTILITIES NOT SHOWN ON THE PLANS OR NOT IN THE LOCATION SHOWN ON THE PLANS.

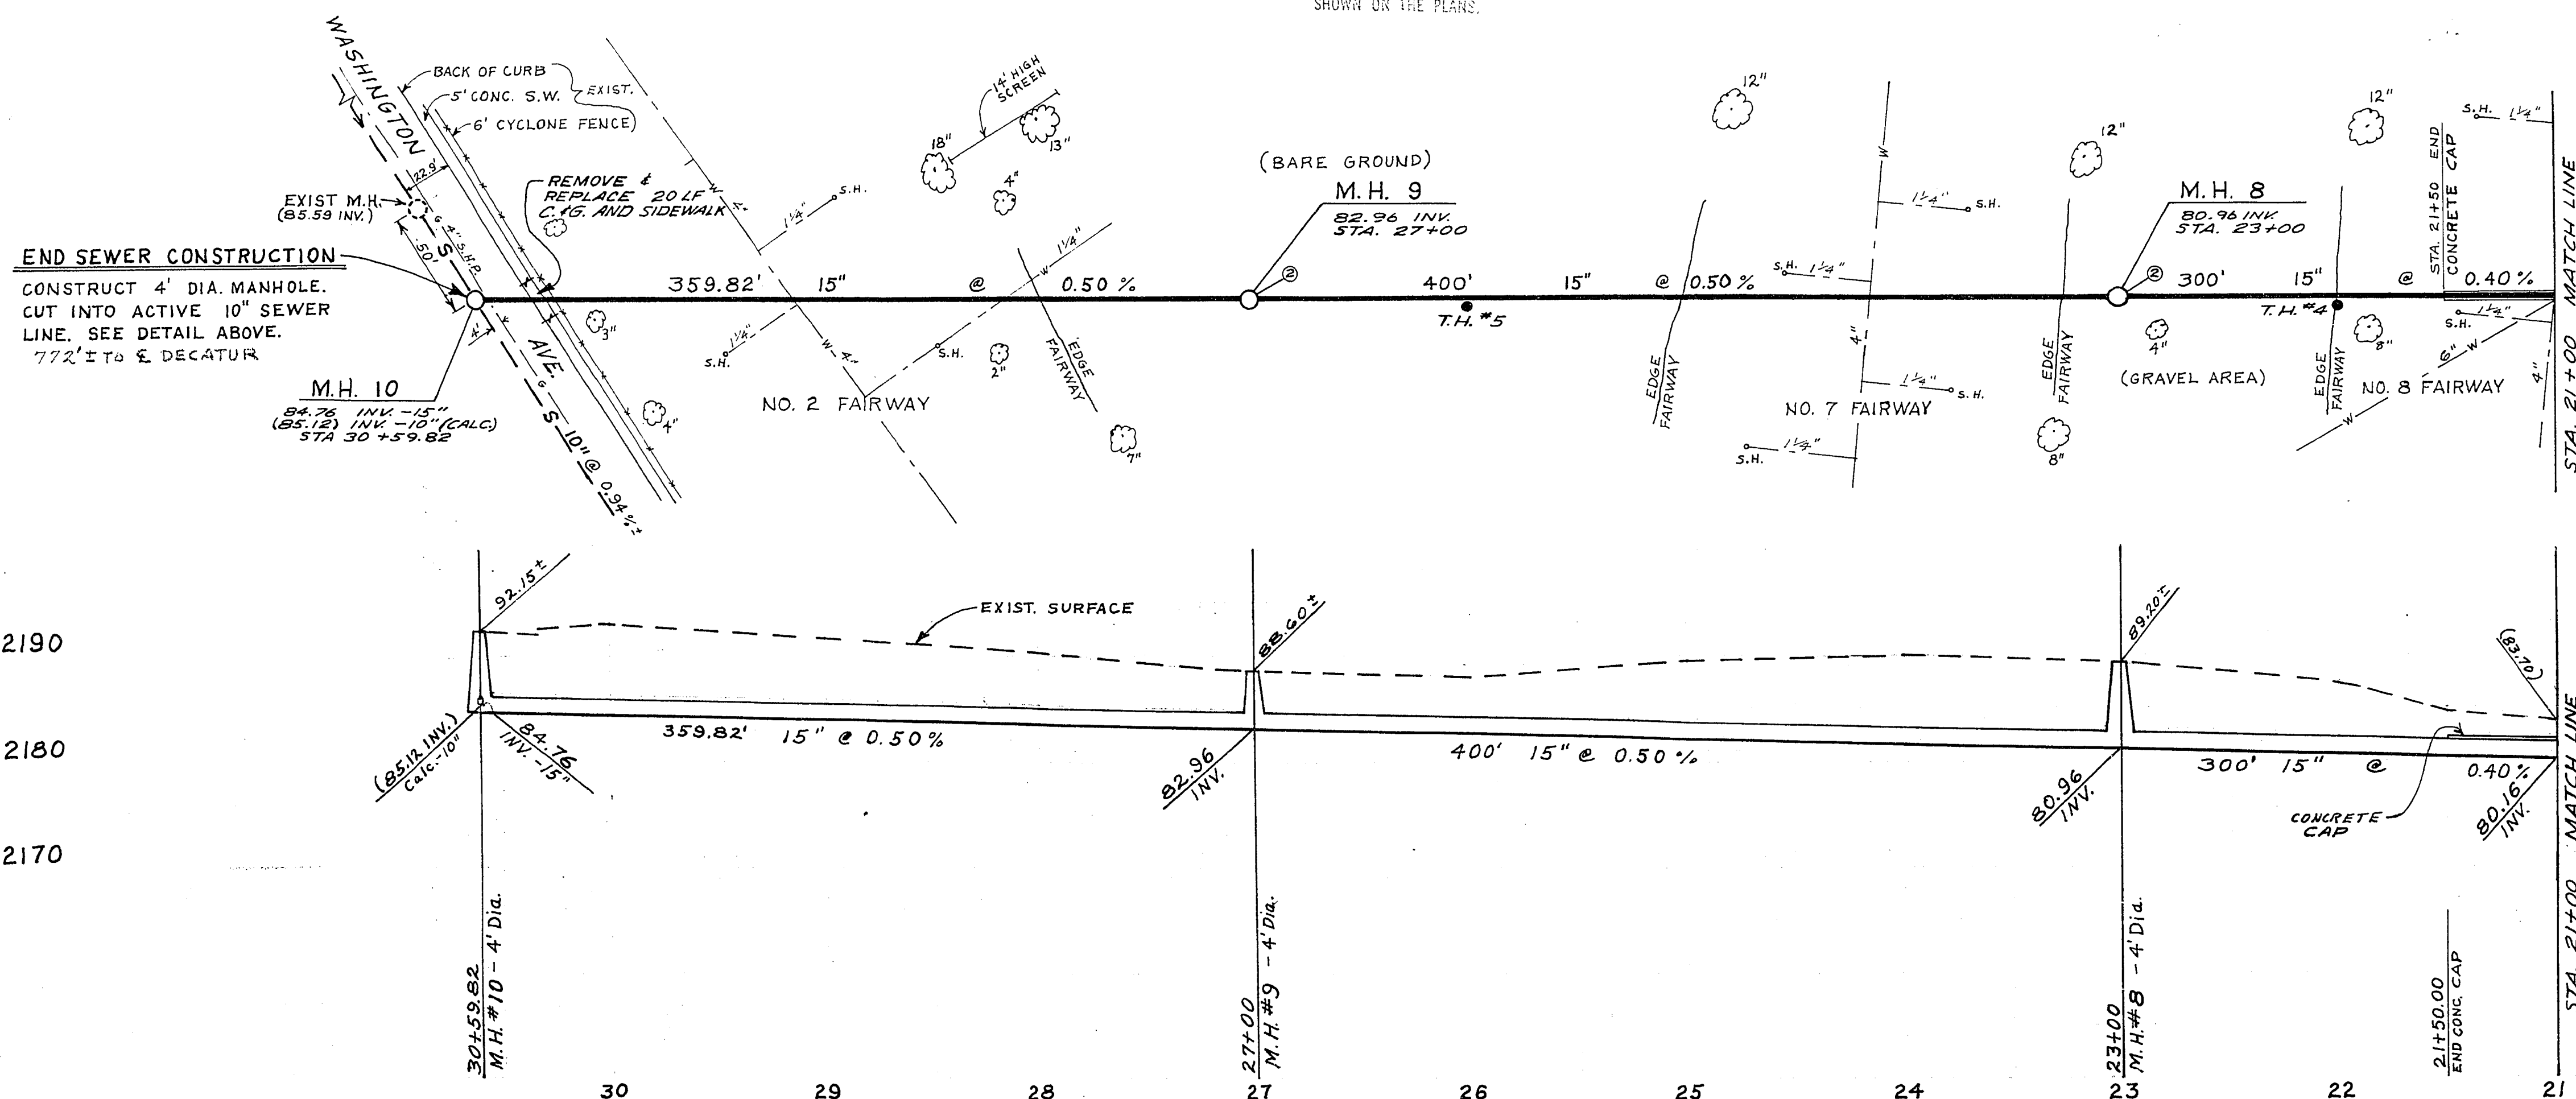

I CERTIFY THAT THIS PLAN WAS PREPARED UNDER MY SUPERVISION.

DATE 1-18-71

ROBERT T. VANDINE, R.P.E. 1095

RT	CHK	DATE
7	DRY	1/14/71
6	REV	1-18-71
5	CON	1-18-71
4	TR	1-18-71
3	UTL	
2	SUD	
1	FIELD	

CONTRACT
DRAWING
JAN 22 1971

REVISION NO.	DESCRIPTION	BY	DATE	APPROVAL
1	"AS BUILT" M.H. #10	JHE.	8-4-81	R.T.V.

CITY OF LAS VEGAS NEVADA
ENGINEERING DEPT.

WASHINGTON AVENUE
SEWER DIVERSION

W.O. 3106
DES. K. ANDERSON
DR. OLSEN - ELLISON
CKD.

DATE 1-18-71
SC. (H) 1" = 50'
SC. (V) 1" = 10'
F.B.K. NO. 69-6X/67-4X
P.O. NO.
DRAWING NO. 307-V428A

APPROVED BY CITY ENGR. *R. T. V.* JAN 13 1971

SHEET 2 OF 2