

5' 5'-6"  
 2'-8"  
 4'-1/4"  
 TOP OF WALL  
 4"  
 PEDESTRIAN BRIDGE - SEE STRUCTURAL

5' OUTSIDE RADIUS (TYP)  
 5' MAX  
 1/2" O.D. RAIL (TYP)  
 WELD STEEL CLOTH TO INSIDE CHANNEL @ EACH POINT (TYP)  
 CHANNEL WELD TO PIPE FRAME (BOTH SIDES)-TYP.  
 2" DIA. STD. STEEL VERTICAL POST, EXCEPT WHERE CONNECTING TO ADJACENT RAILINGS (TYP).  
 3" SQ OPENING X 225 GAUGE PLAIN STEEL WIRE CLOTH AS MFD BY MCNICHOLS, OR APPROVED EQUAL, SUBMIT 12" SQ SAMPLE FOR APPROVAL.  
 301 "U" EDGING" STEEL "U" CHANNEL TO SUPPORT WIRE CLOTH AS MFRD BY MCNICHOLS (OR APR. EQUAL.) (800) 275 3520  
 1/2" O.D. RAIL (TYP)  
 MITRE CHANNEL AT CORNERS, WELD GAPS, GRIND SMOOTH (TYP).  
 TOP OF WALL

6  
 SD-11 TYP

### 3 RAMP HANDRAIL DETAIL

## SECTION E-E

NOTE:  
FOR WALLS AND  
FOUNDATIONS - SEE  
STRUCTURAL PLANS.

## SECTION F-F

NOTE:  
FOR WALLS AND  
FOUNDATIONS - SEE  
STRUCTURAL PLANS.

## SECTION G-G

NOTE:  
FOR WALLS AND  
FOUNDATIONS - SEE  
STRUCTURAL PLANS.

## 2 RAMP SECTIONS

## SECTION C-C

NOTE:  
FOR WALLS AND  
FOUNDATIONS - SEE  
STRUCTURAL PLANS.

## SECTION D-D

NOTE:  
FOR WALLS AND  
FOUNDATIONS - SEE  
STRUCTURAL PLANS.


### 1 ADA RAMP TO TENNIS COURT

## SECTION A-A


NOTE:  
FOR WALLS AND  
FOUNDATIONS - SEE  
STRUCTURAL PLANS.

## SECTION B-B

NOTE:  
FOR WALLS AND  
FOUNDATIONS - SEE  
STRUCTURAL PLANS

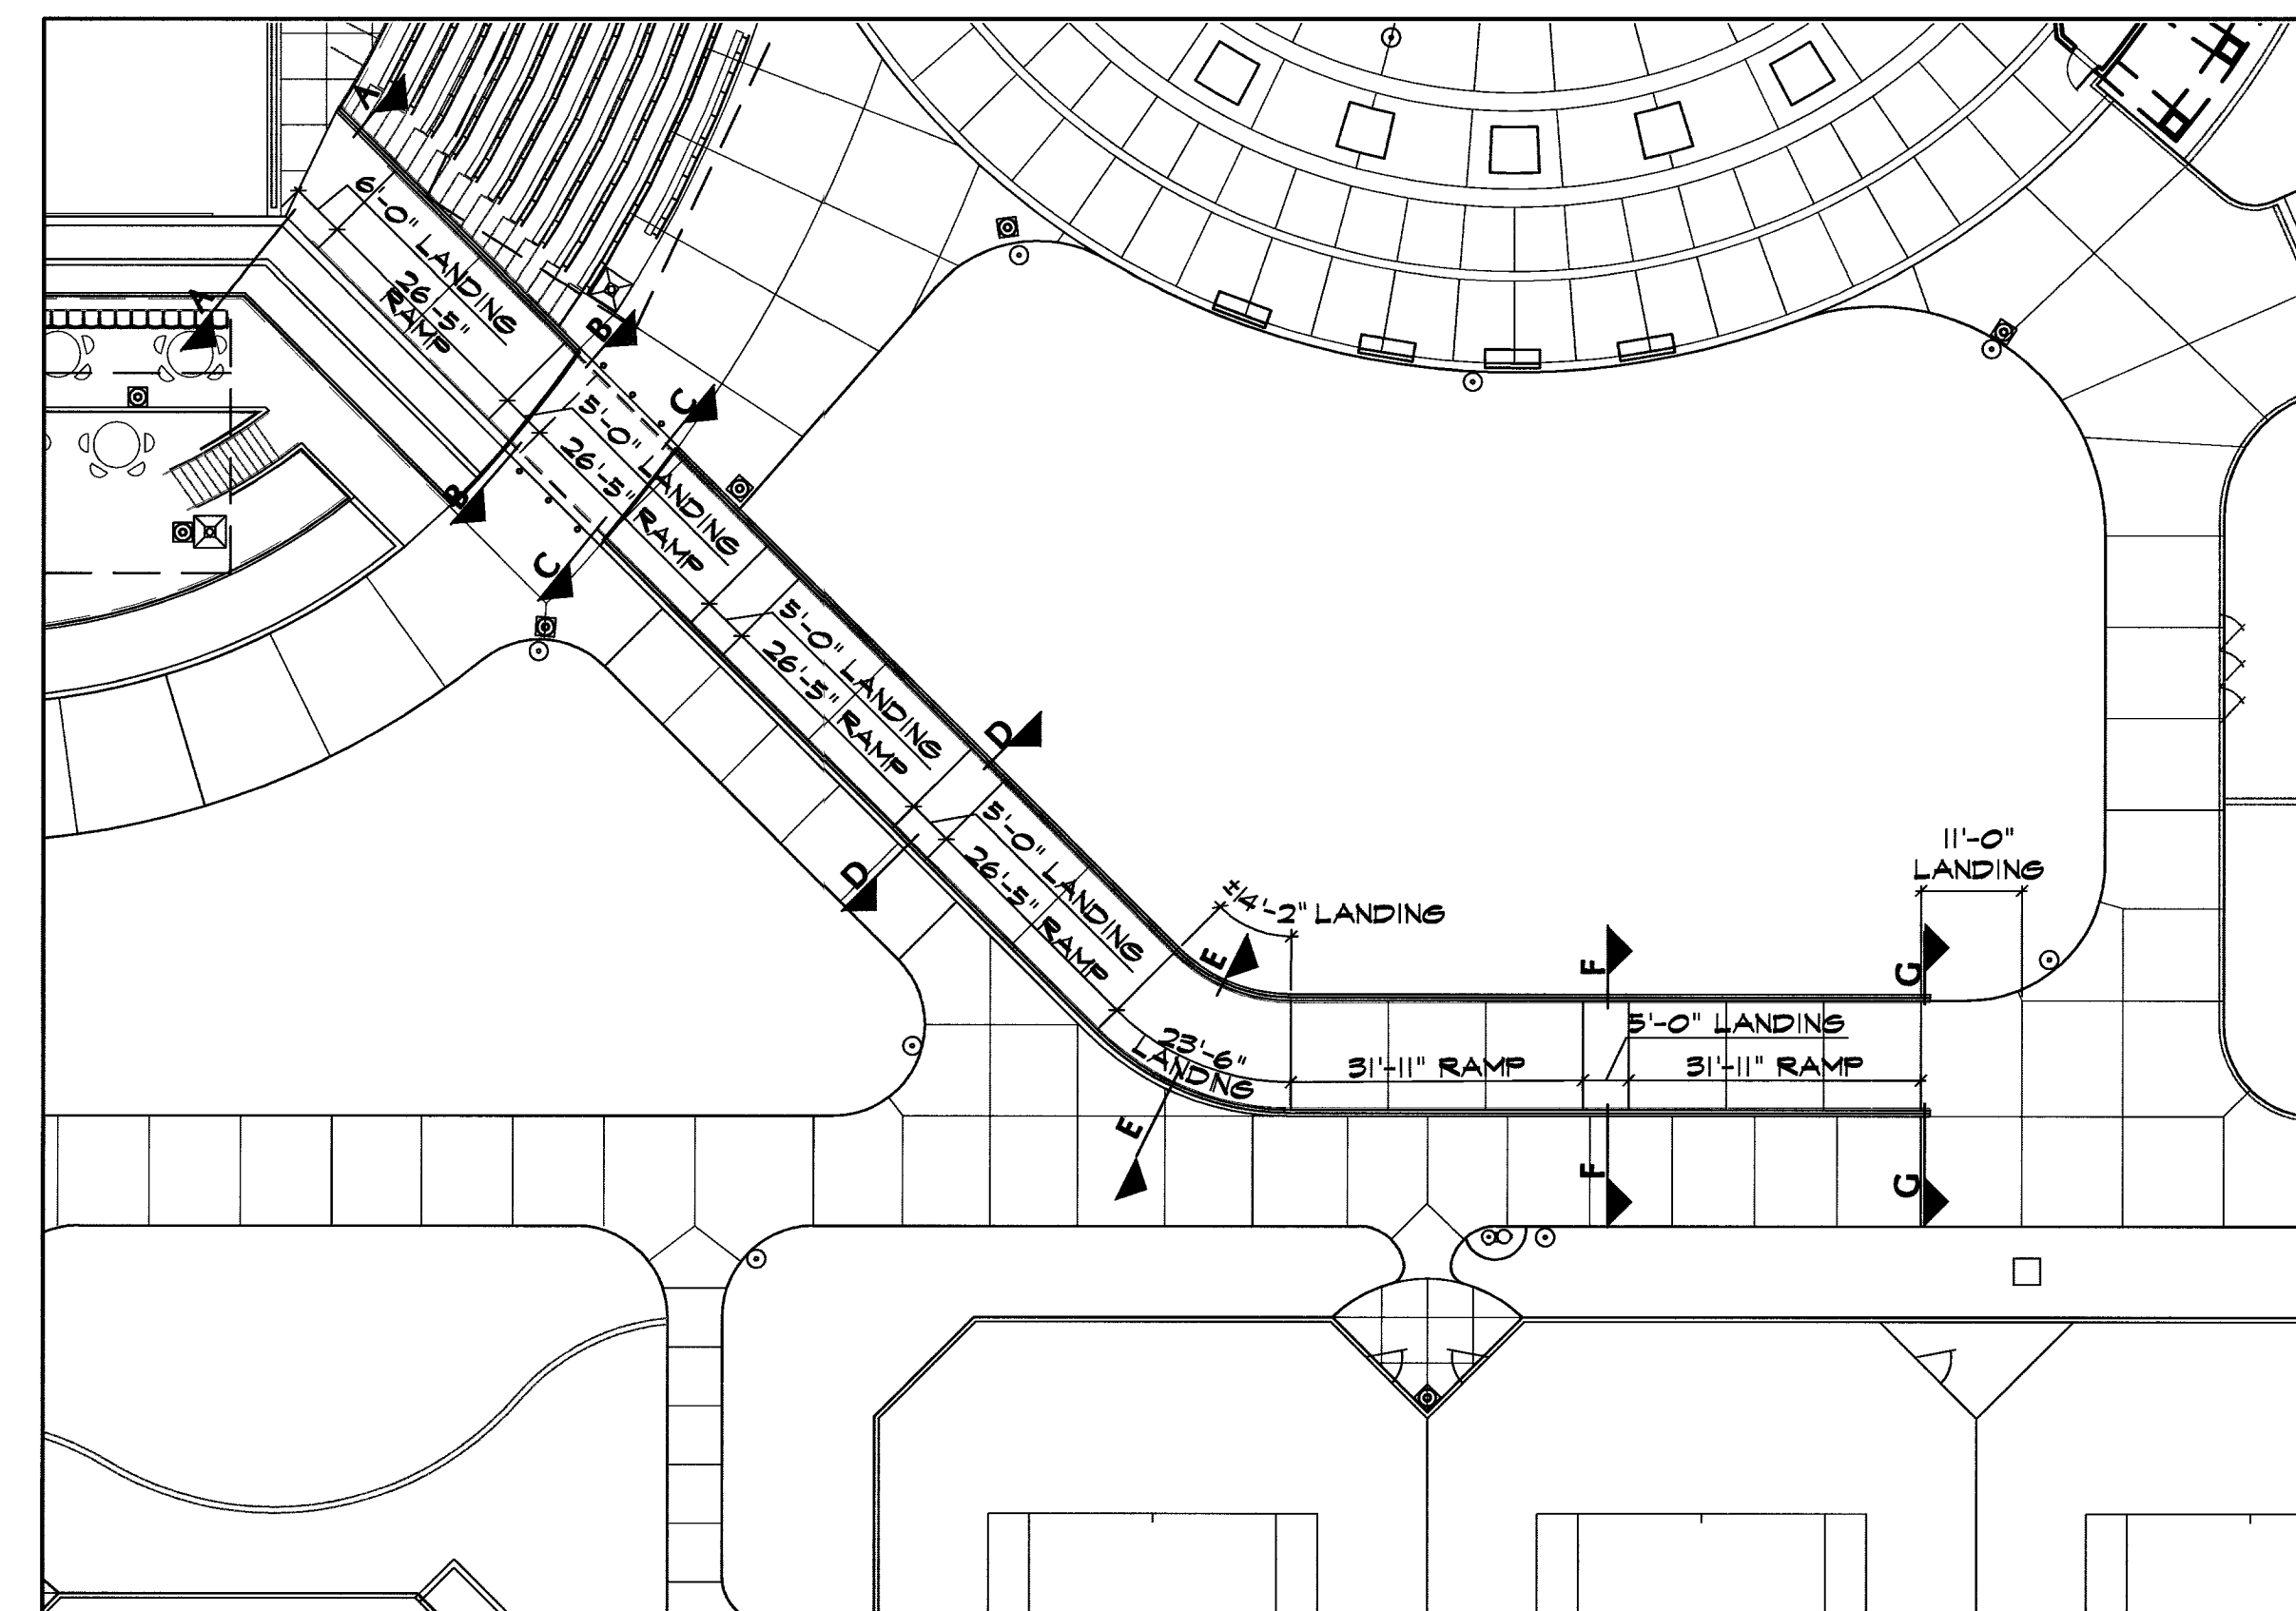[illegible]

7251 W CHARLESTON BLVD  
LAS VEGAS, NEVADA 89117  
PHONE (702) 258-0115  
FAX (702) 869-8547

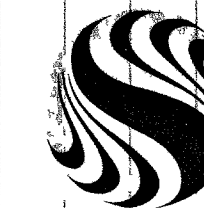

# Stantec

WASHINGTON BUFFALO PARK - PHASE 1A  
WASHINGTON & BUFFALO, LAS VEGAS, NV

## SITE DETAILS

RECORD DOCUMENTS ARE PREPARED FROM DATA AND INFORMATION SUPPLIED BY OTHERS. STANTEC CONSULTING, INC. DOES NOT CERTIFY THE ACCURACY OR COMPLETENESS OF RECORD DOCUMENTS. STANTEC CONSULTING, INC. ADVISES ANYONE USING RECORD DOCUMENTS FOR ANY PURPOSE, TO INDEPENDENTLY VERIFY THE ACCURACY OR COMPLETENESS OF THE INFORMATION. STANTEC CONSULTING, INC. DOES NOT WARRANT THE SUITABILITY OF THE INFORMATION FOR THE PURPOSE FOR WHICH THEY INTEND TO BE USED. STANTEC CONSULTING, INC. SHALL NOT BE RESPONSIBLE FOR ANY PROBLEMS, DISCREPANCIES OR REPEATED COSTS INCURRED OUT OF THE USE OF RECORD DOCUMENTS.

OWNER: CITY OF LAS VEGAS  
DEPARTMENT OF PUBLIC WORKS  
ARCHITECTURAL SERVICES

400 EAST STEWART AVENUE  
LAS VEGAS, NEVADA 89101  
PHONE: (702) 229-6535  
FAX: (702) 382-3232  
TDD: (702) 386-9108

|       |                     |
|-------|---------------------|
| DRAWN | KUC                 |
| FILE  | 21865D-19-20-21.dwg |

|       |      |
|-------|------|
| DATE  | 7/03 |
| SCALE | NTS  |

|            |            |
|------------|------------|
| BID NO     | 03.1534108 |
| CLV DWG NO | 650.76-1A  |

|                |
|----------------|
| 100% SUBMITTAL |
| SHT NO         |

SD-19

RECORD DRAWING (01/19/06)

96984