



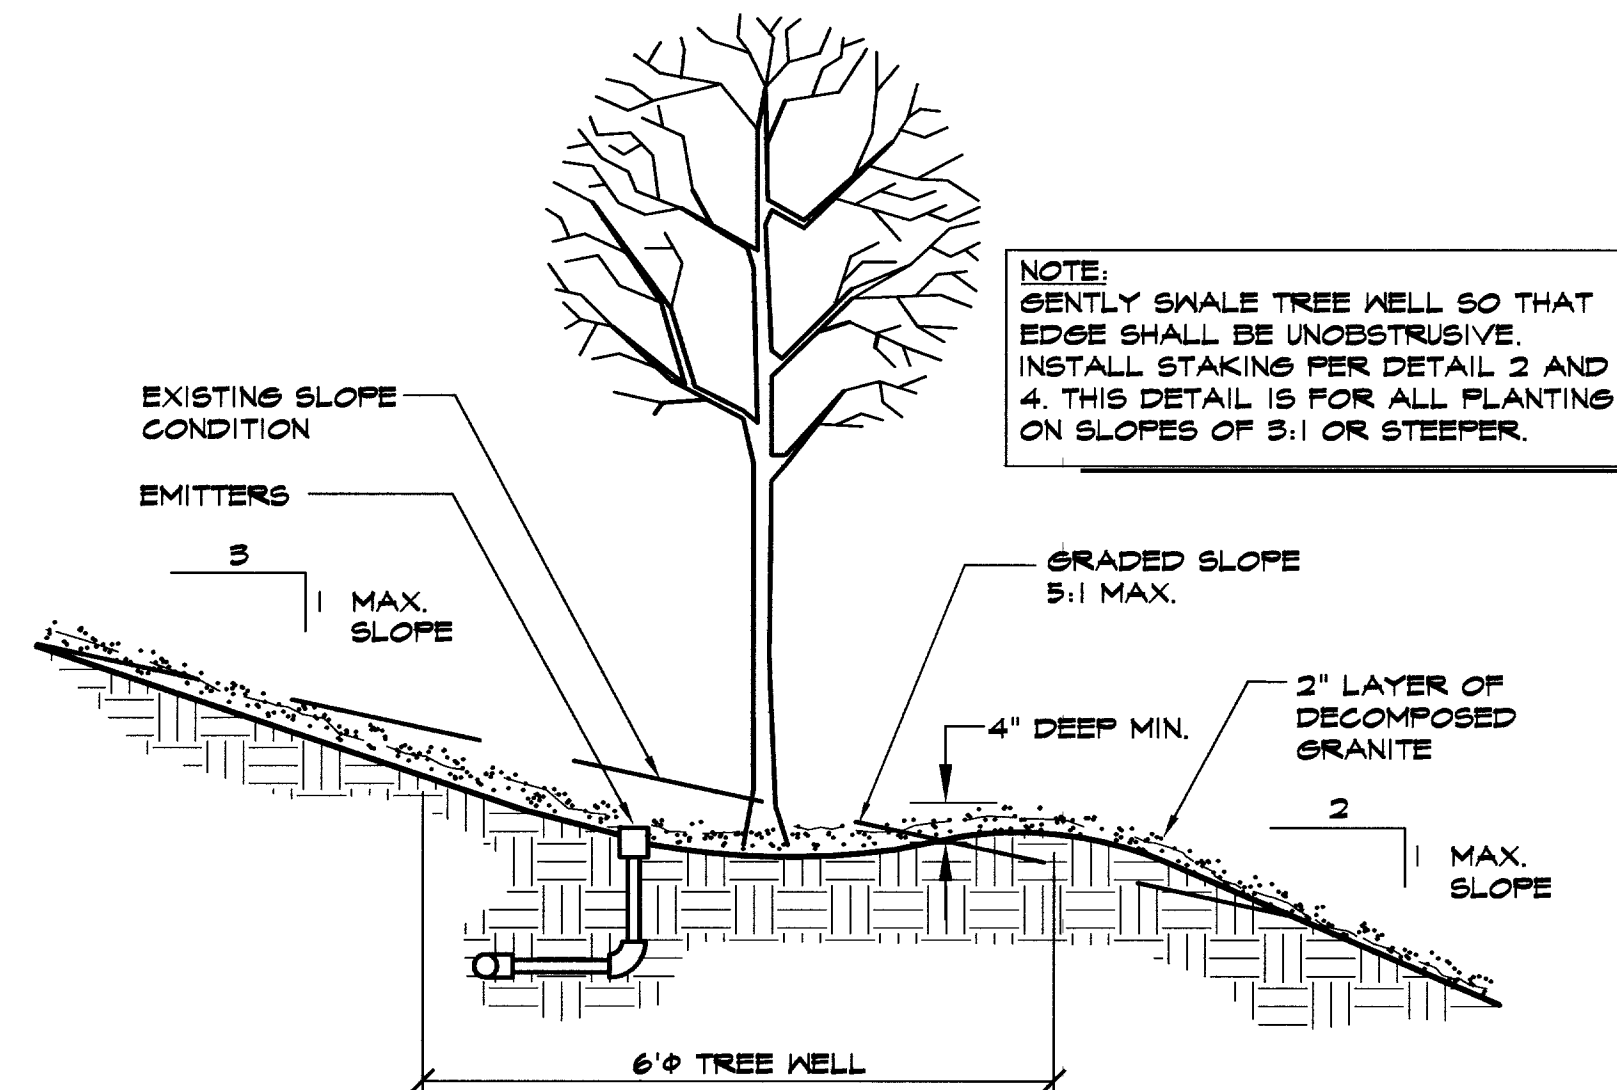

8 TREE PLANTING ON SLOPE

NTS


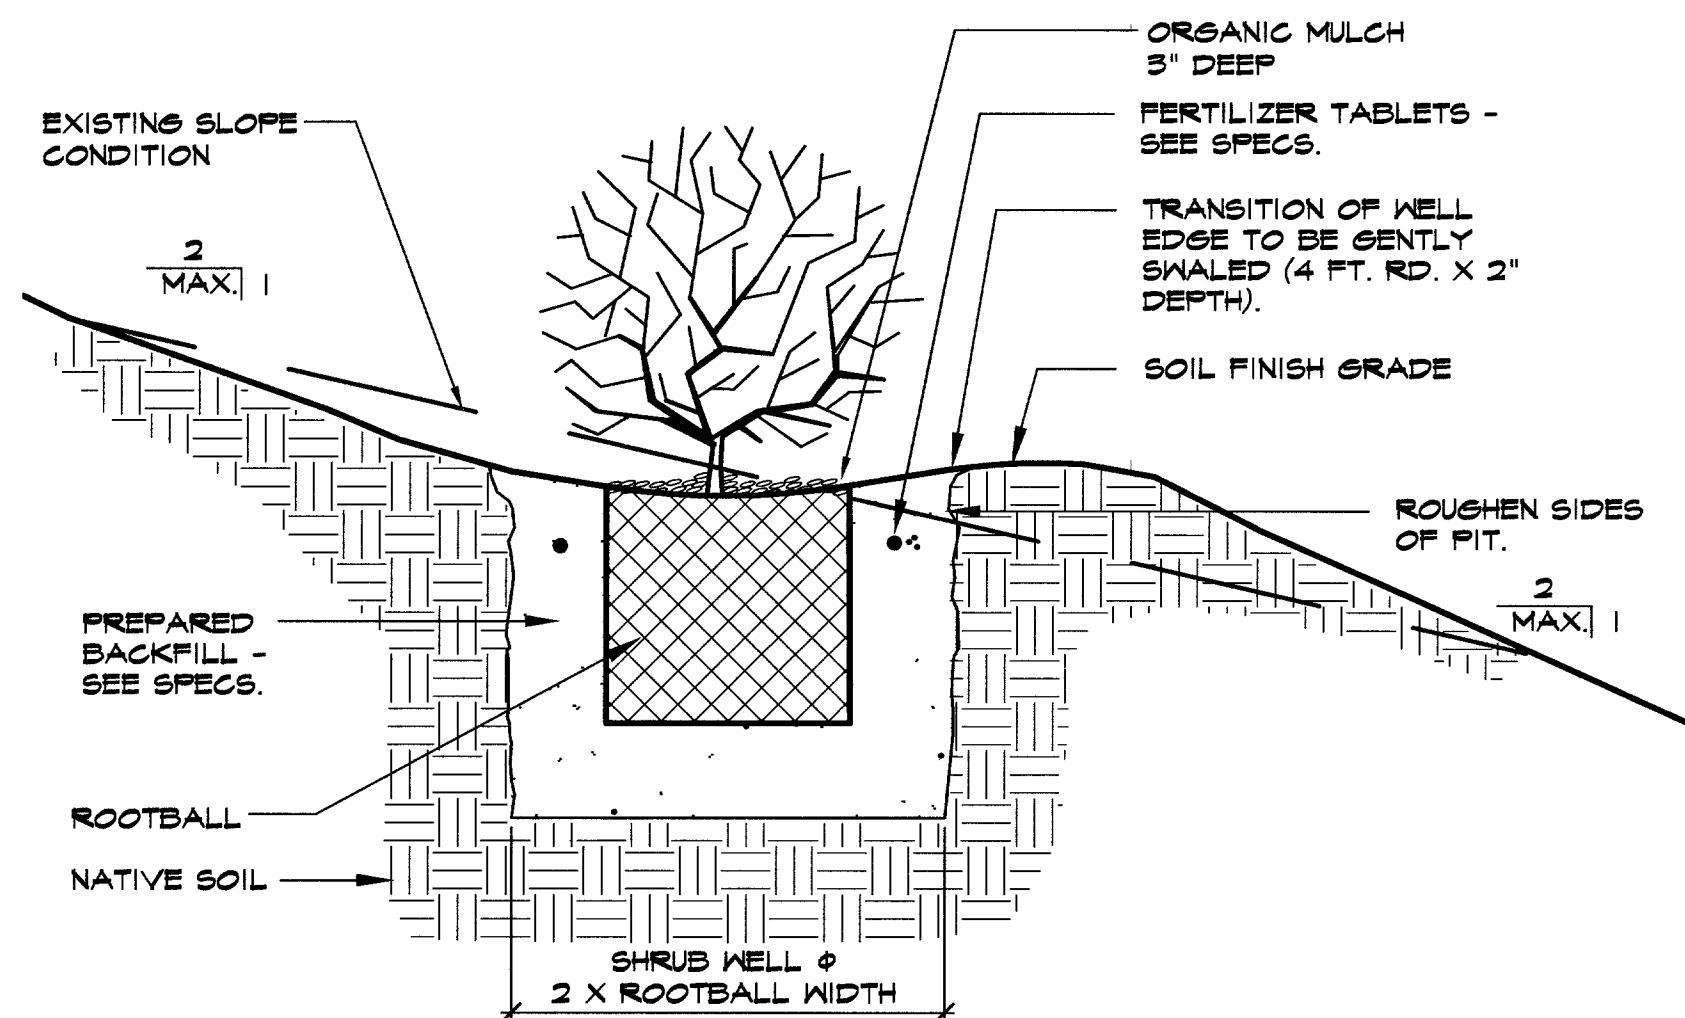


9 SHRUB PLANTING ON SLOPE

NTS

NOTE: FOR 6" - 10" GRANITE, PRE-EMERGENT SHALL BE APPLIED BEFORE GRANITE PLACEMENT. FOR 1/4" MINUS GRANITE, APPLY PRE-EMERGENT TO SUBGRADE AND FINISH GRADE.


DECOMPOSED GRANITE	SIZE	DEPTH
COLOR: SEE SPEC.	1/4" MINUS	2" MIN. ALSO LOCATE IN TREE PITS (AVOID OVER ROOTBALL) TO 2" DEPTH
COLOR: SEE SPECS.	6" - 10"	12"

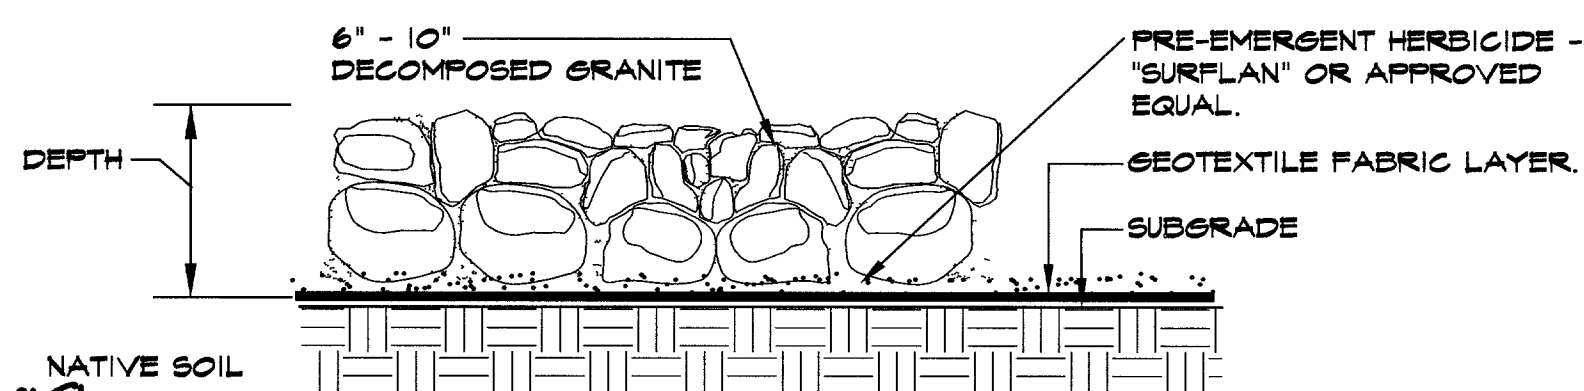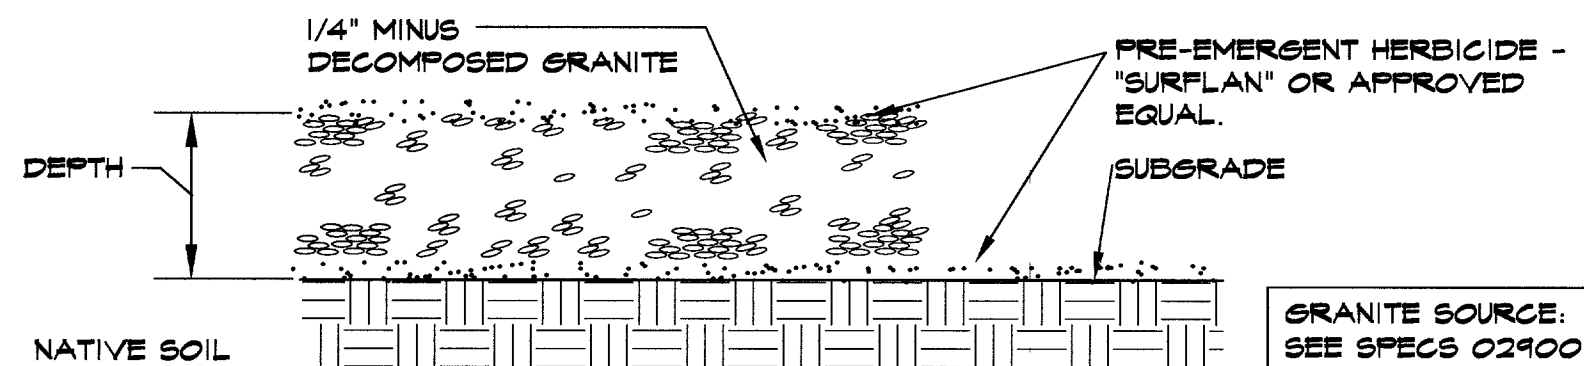

10 INERT GROUNDCOVER (ROCK MULCH)


LANDSCAPE AREAS

NTS

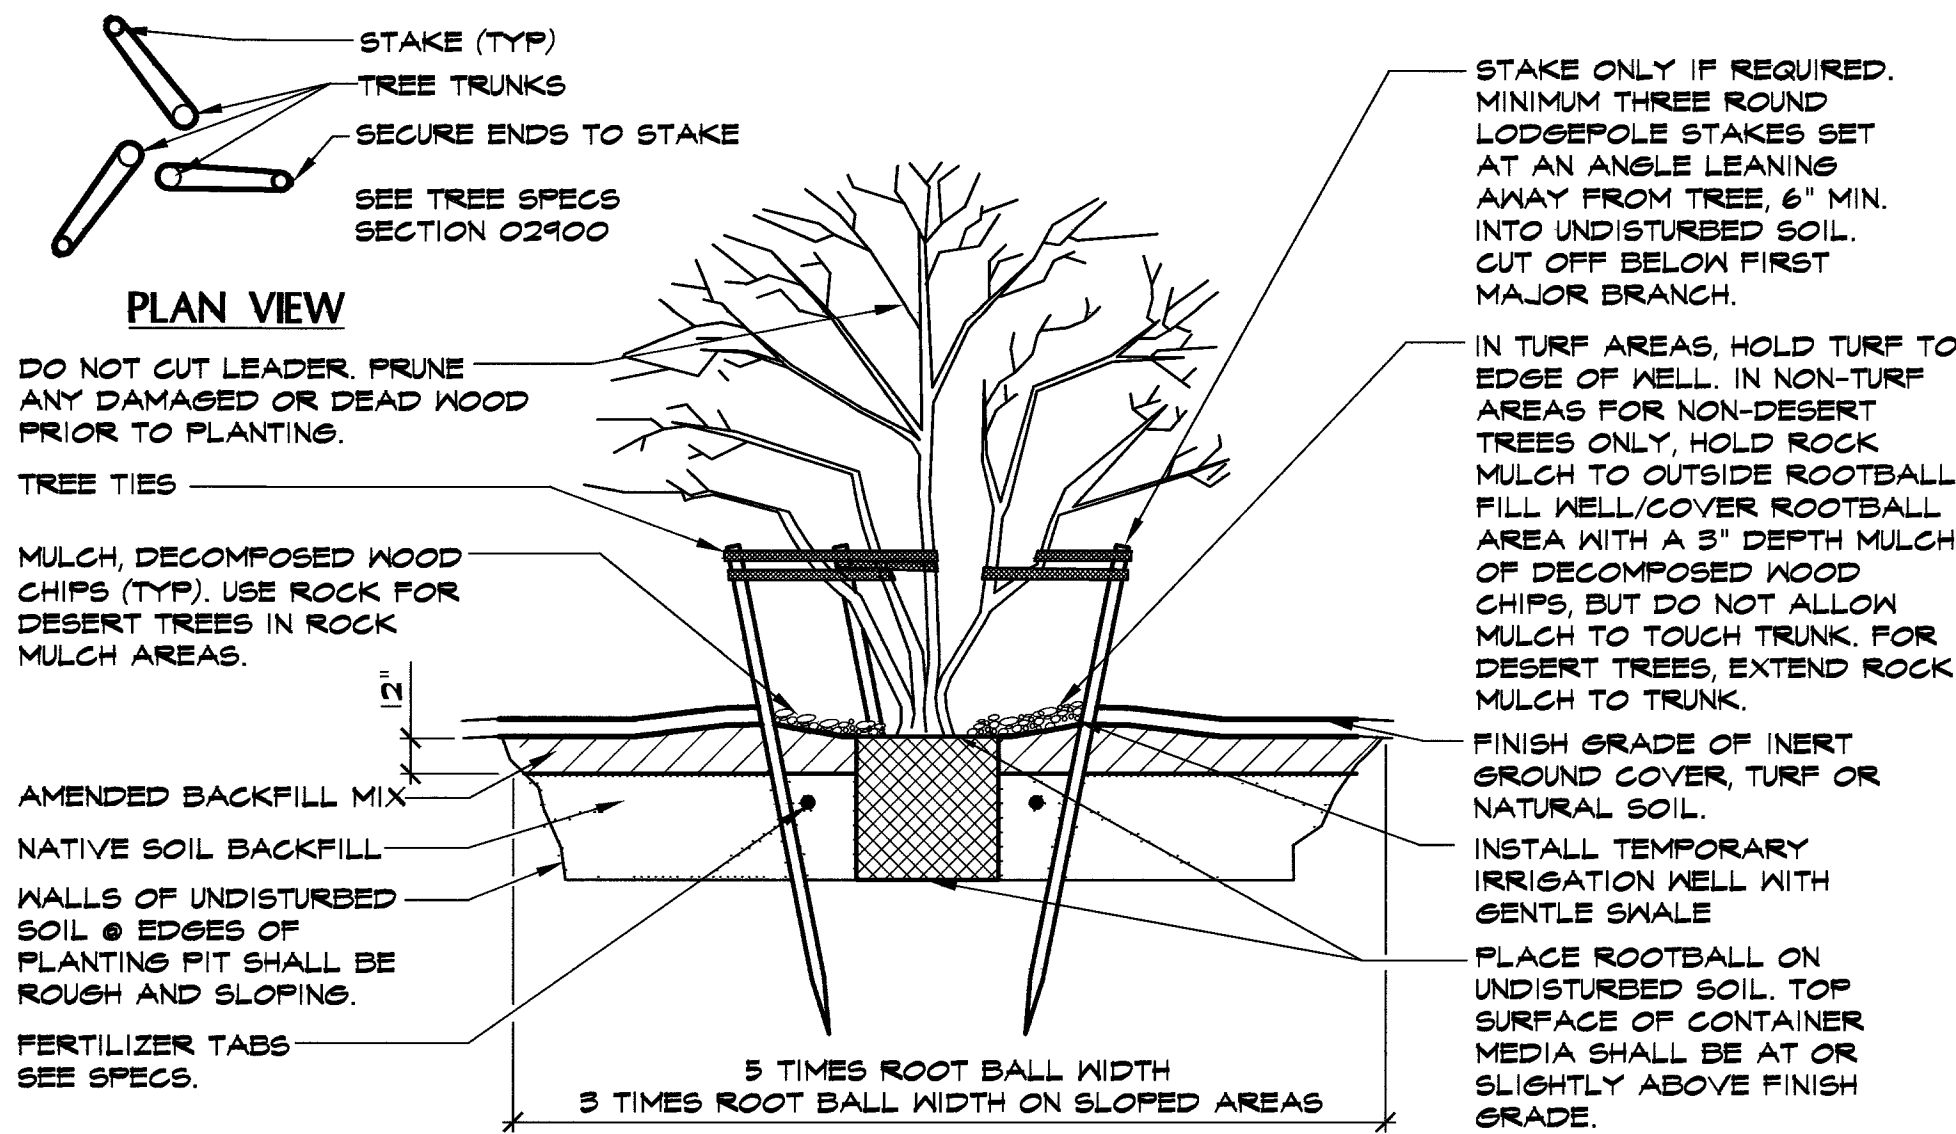


4 MULTI-TRUNK TREE PLANTING

NTS

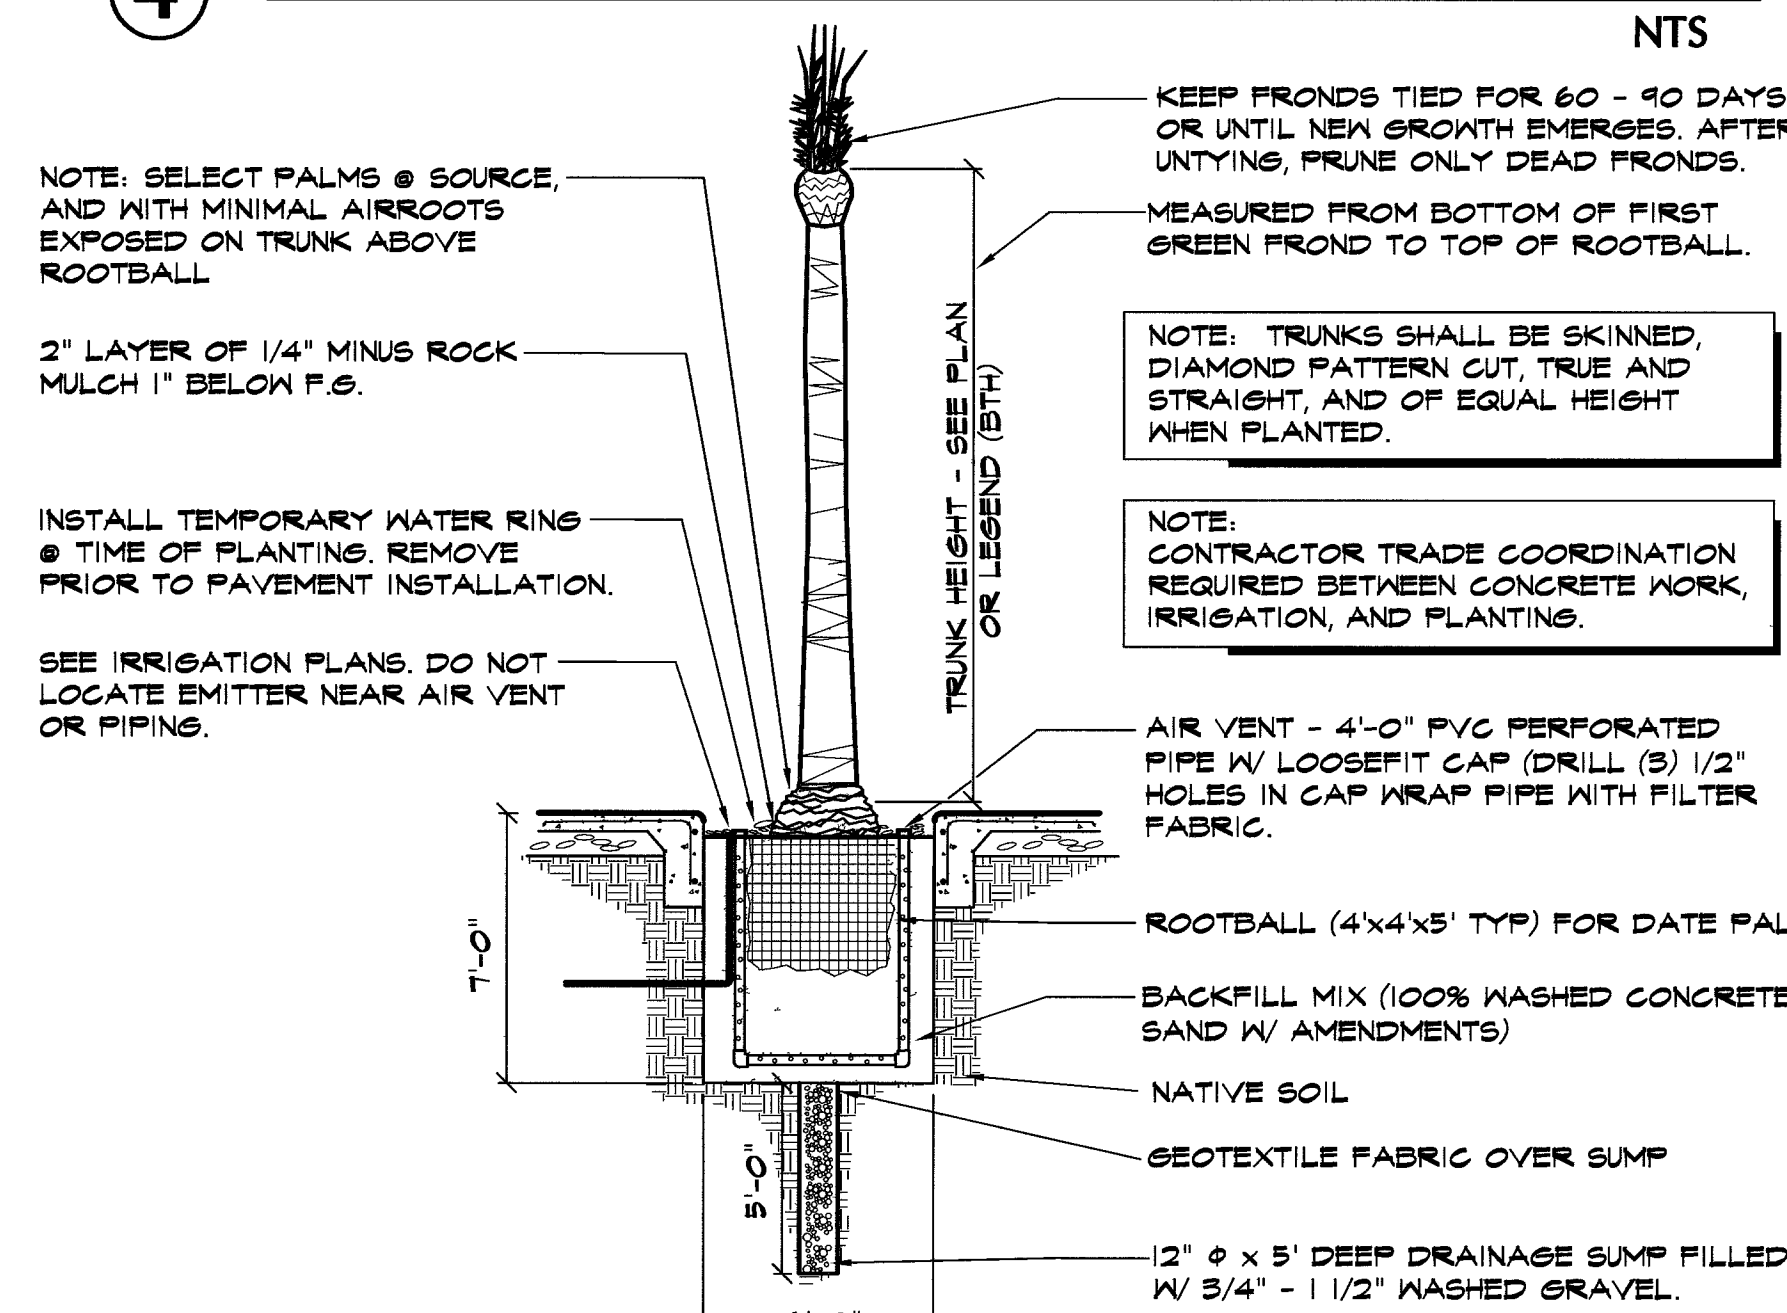


5 PALM TREE PIT

NTS

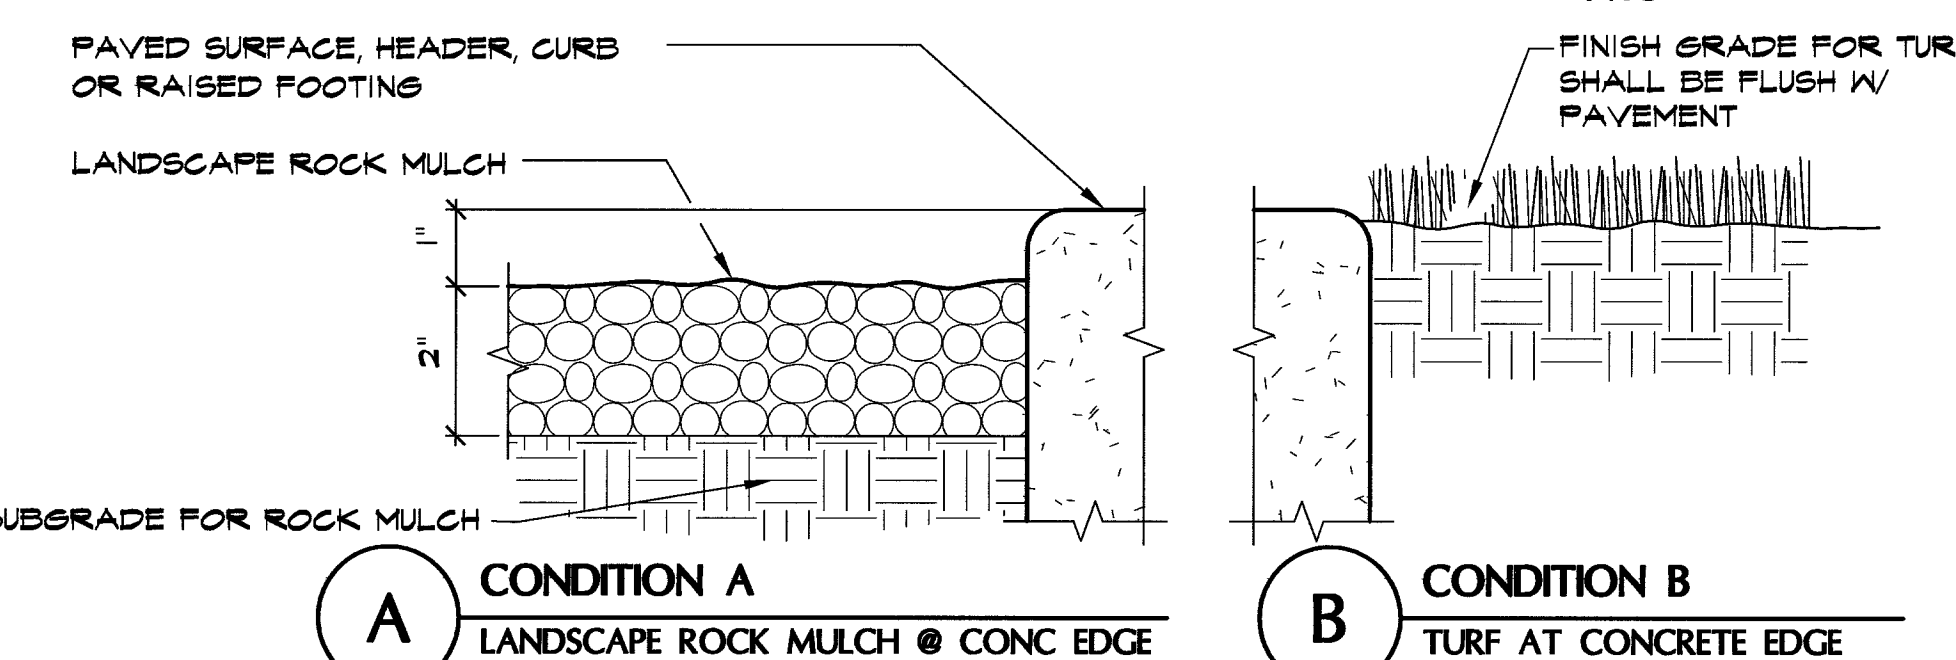


6 CONCRETE EDGE CONDITIONS

NTS

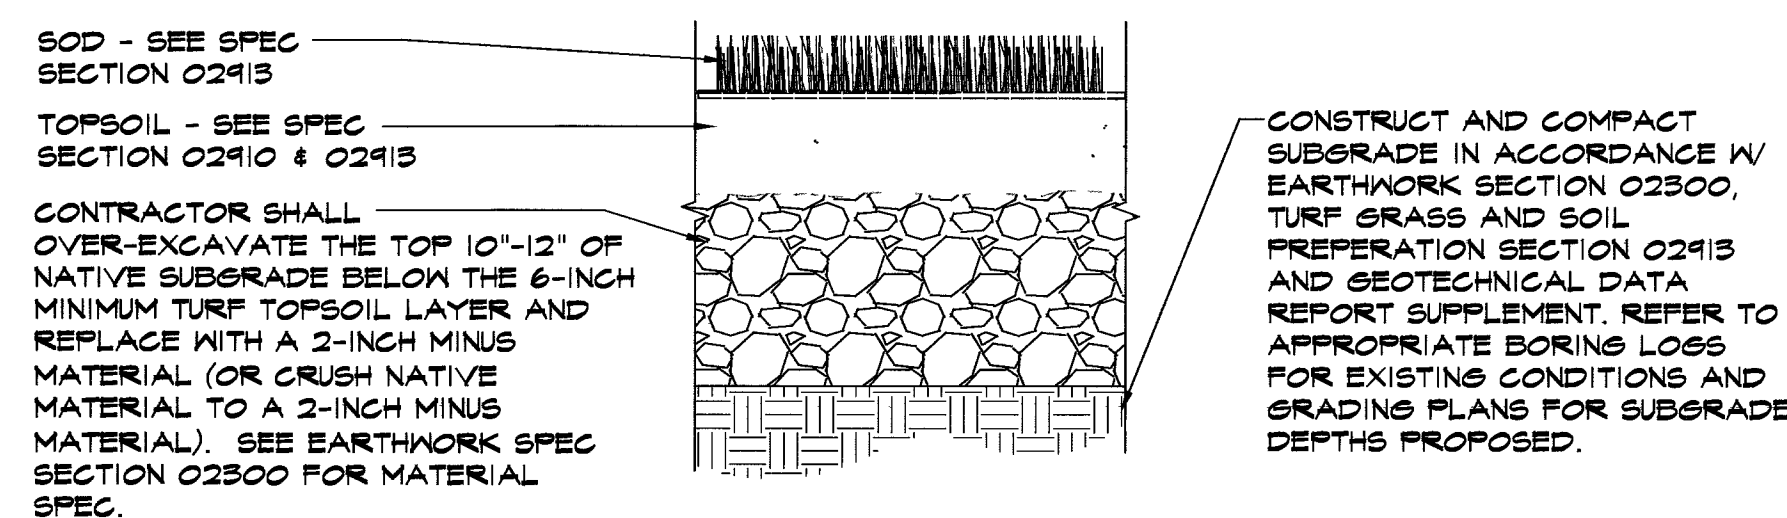


7 TURF DETAIL

NTS

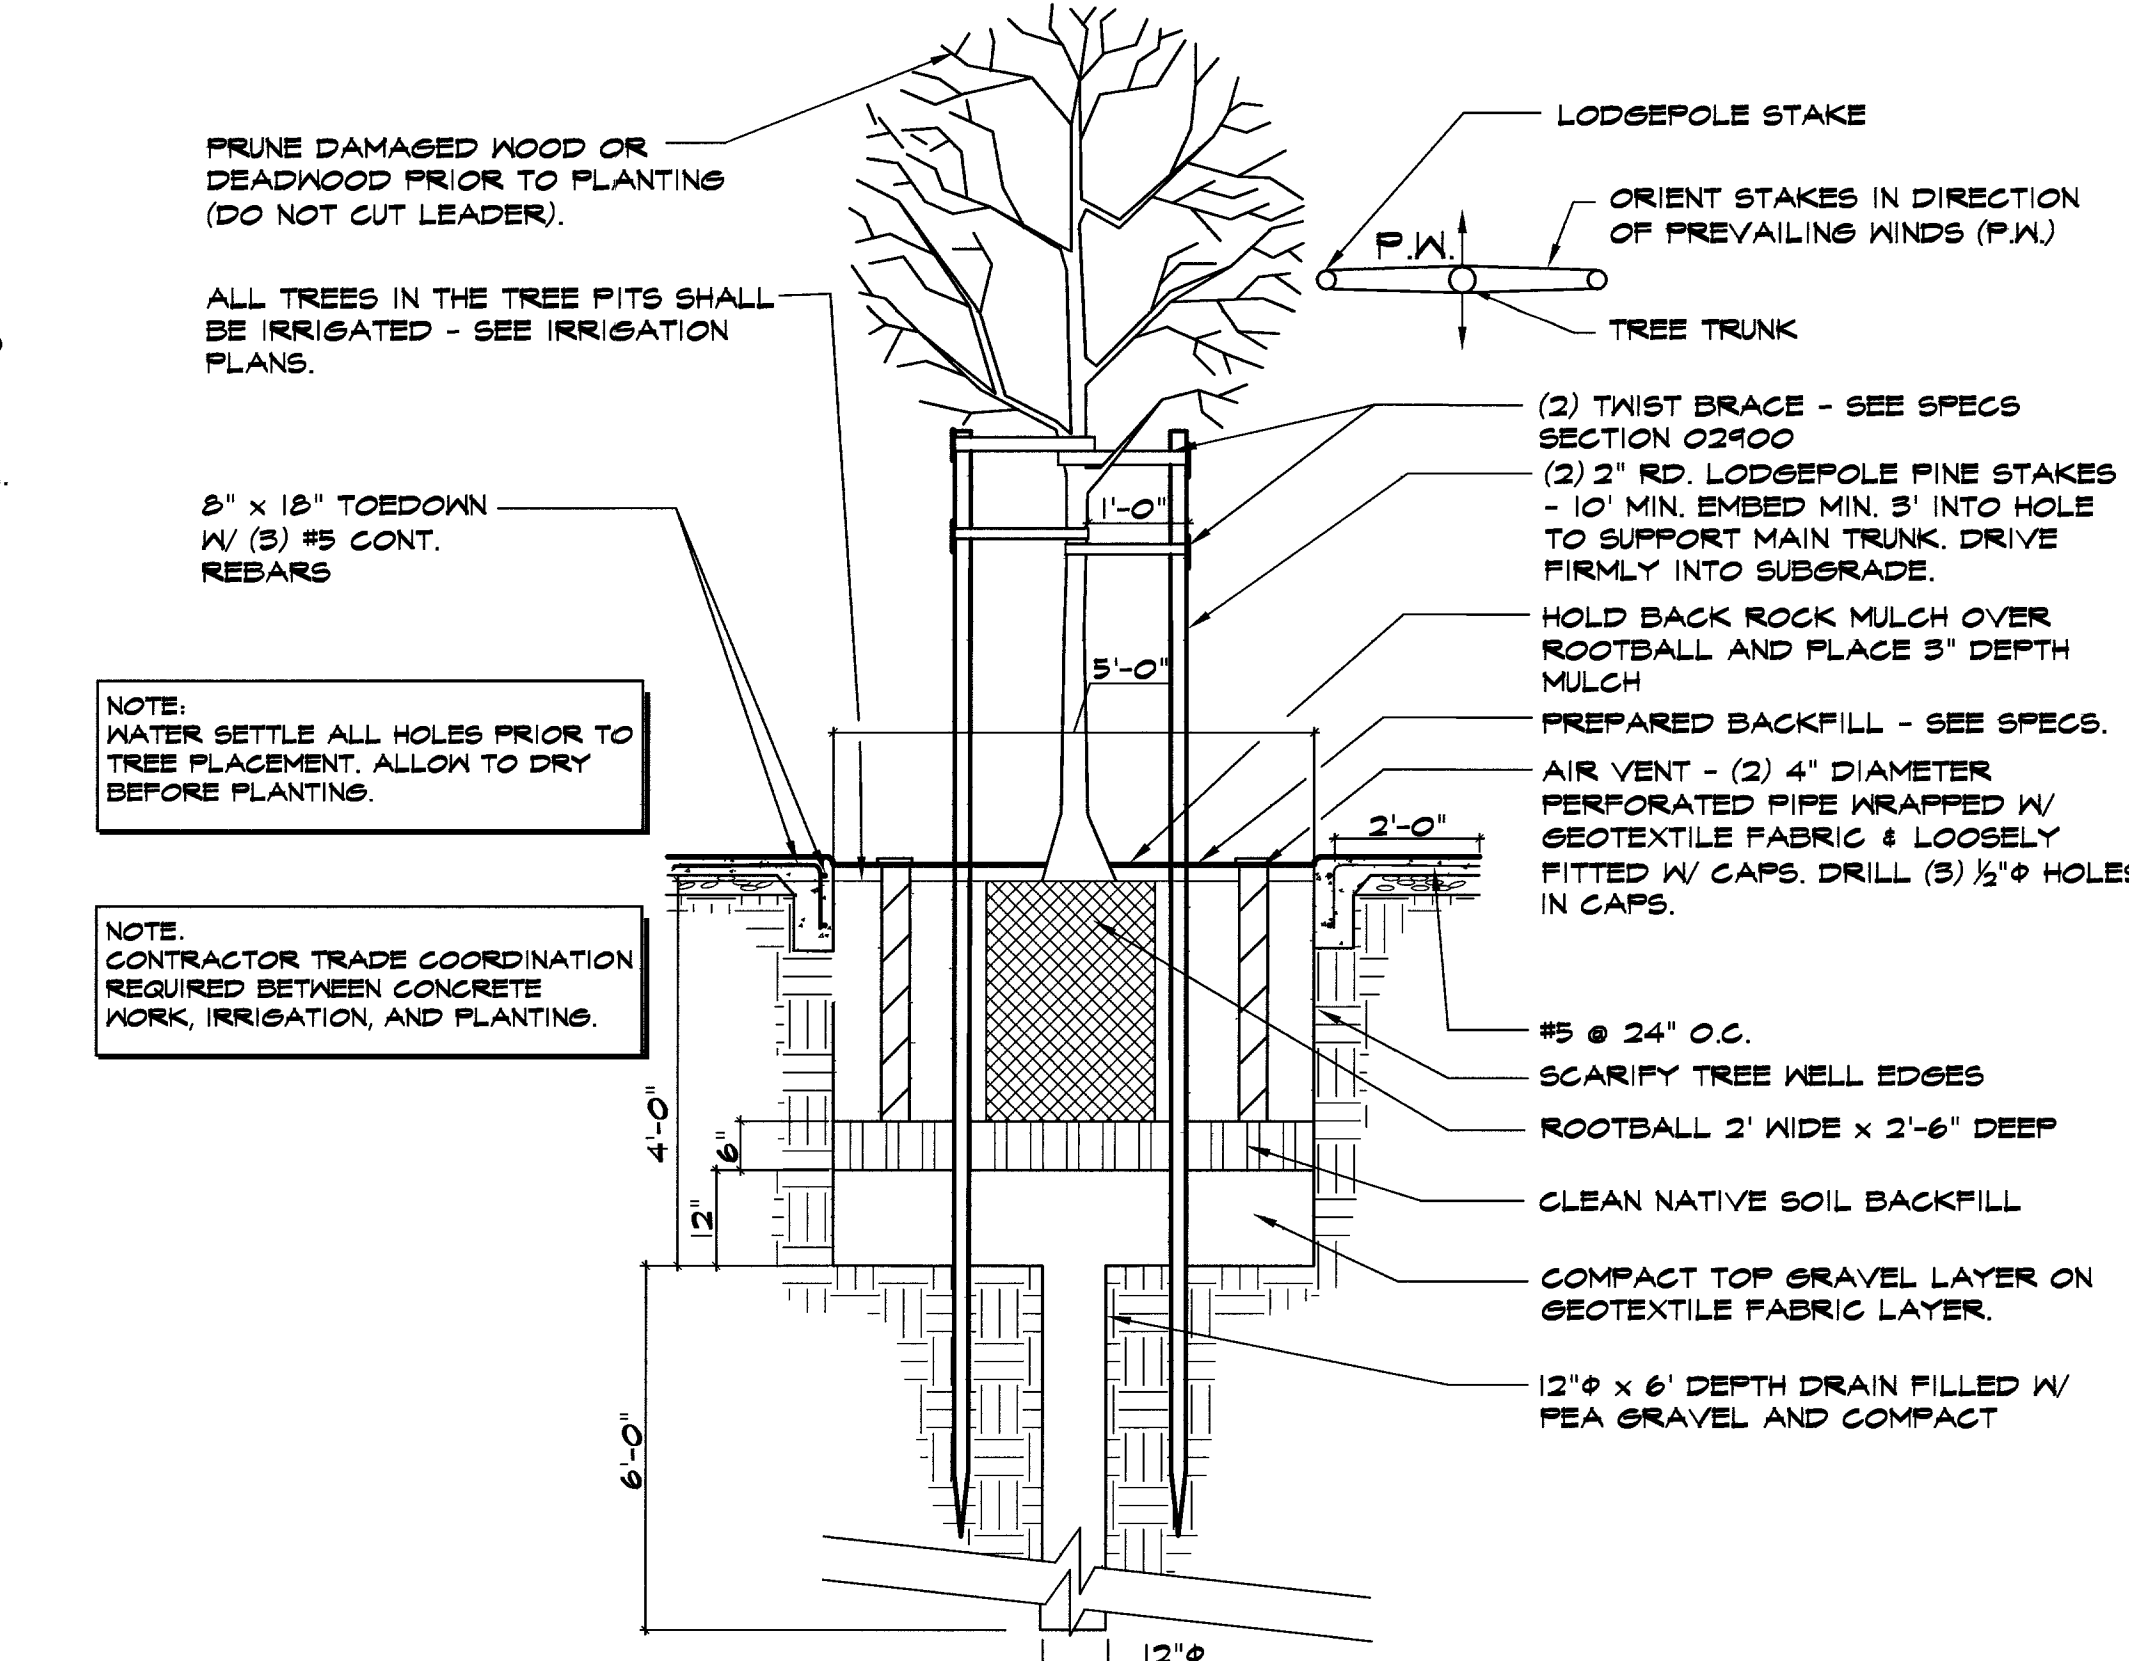


1 CONCRETE PIT AND TREE PLANTING

NTS

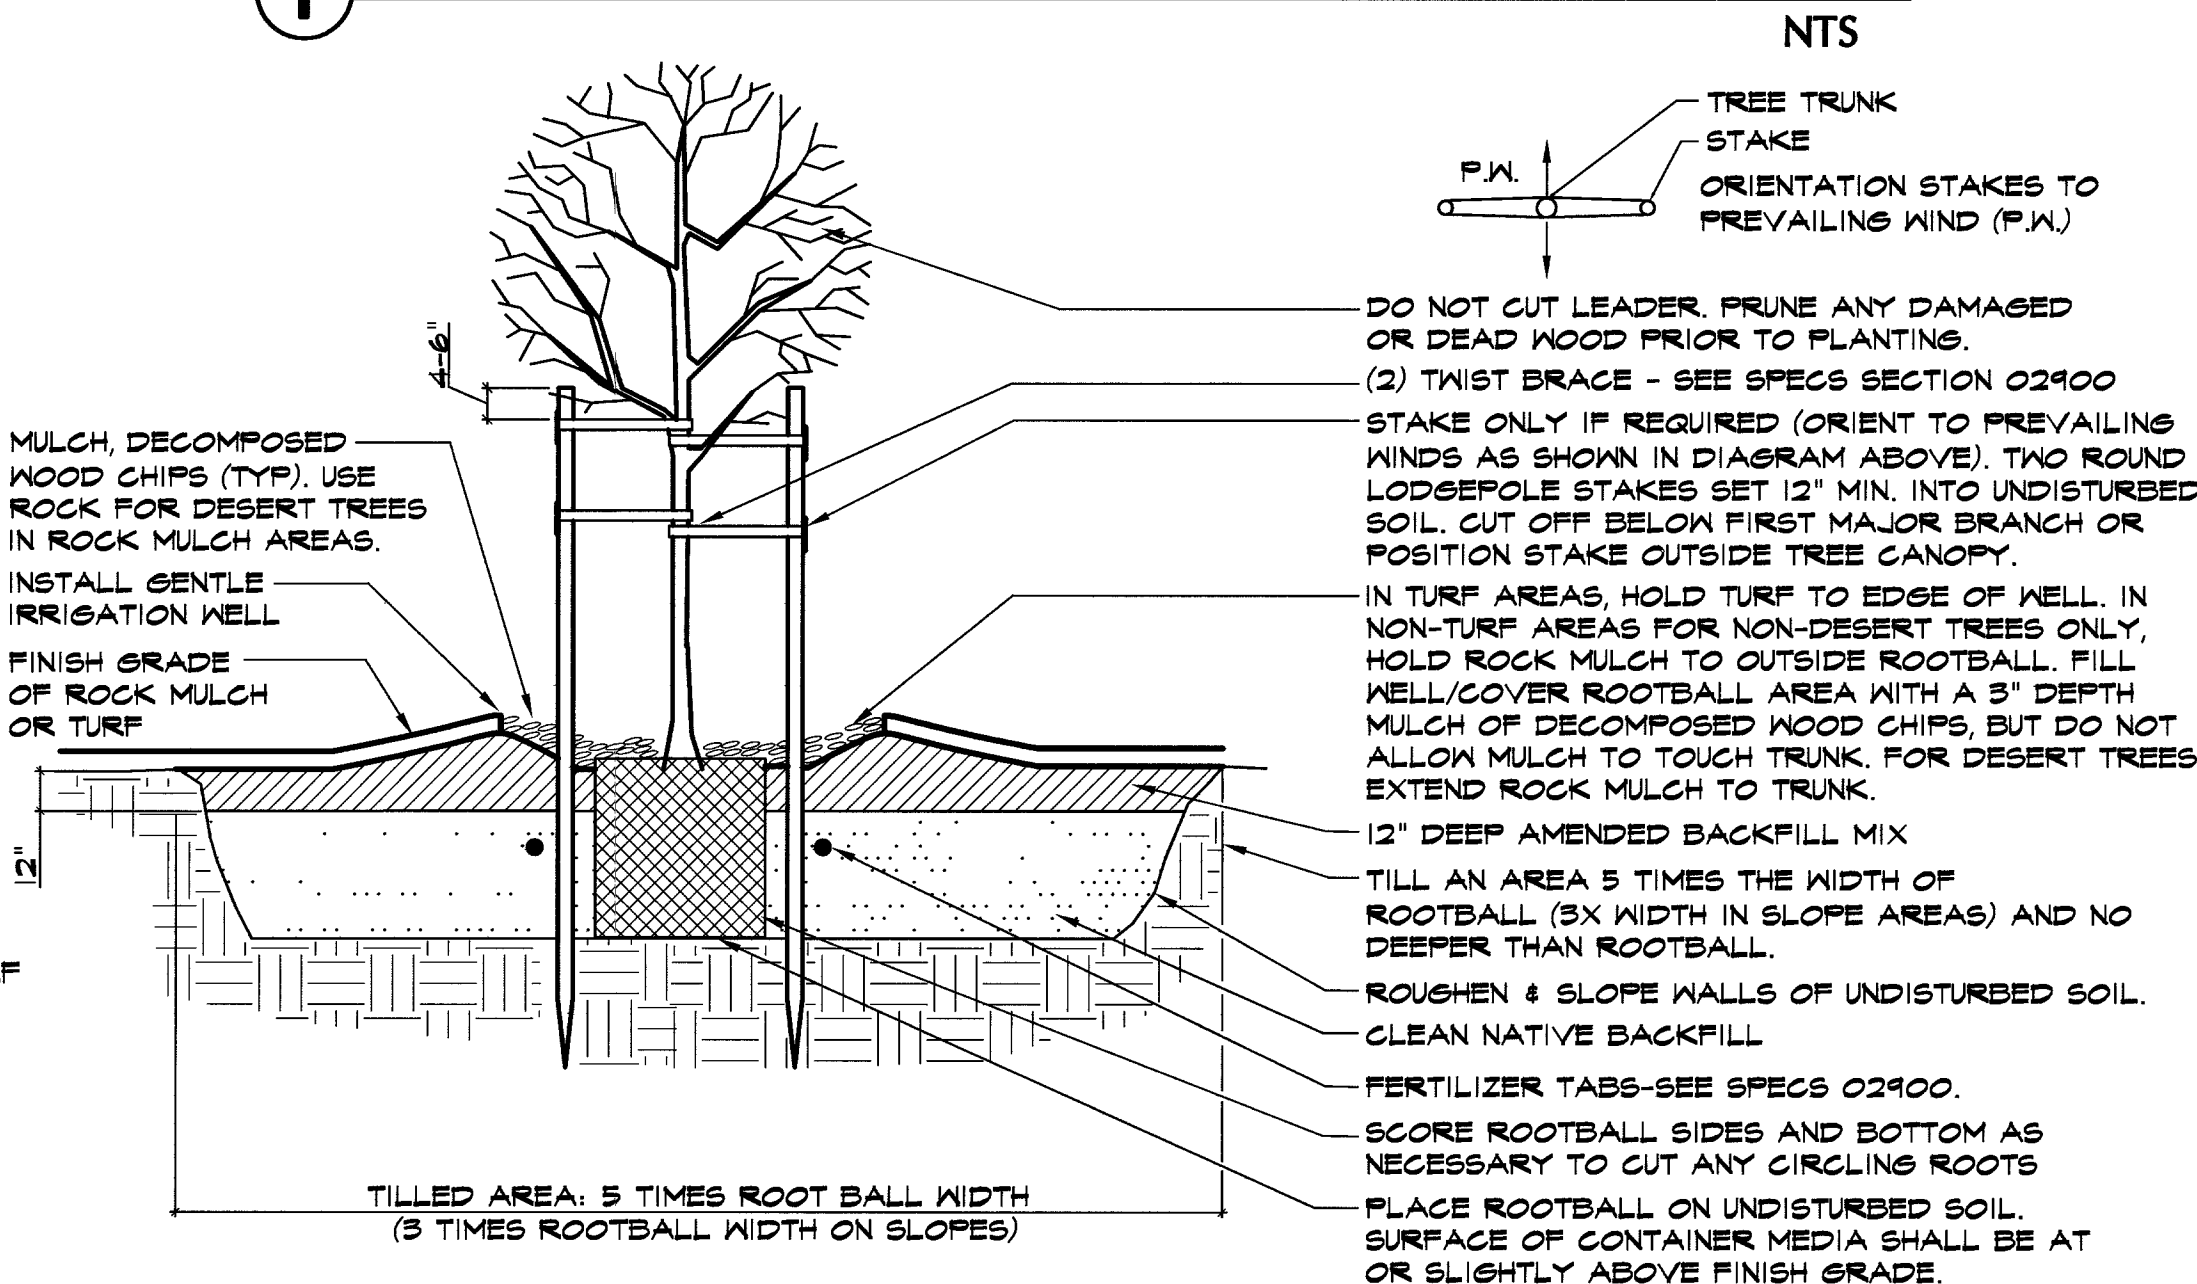

2 STANDARD TREE PLANTING

NTS

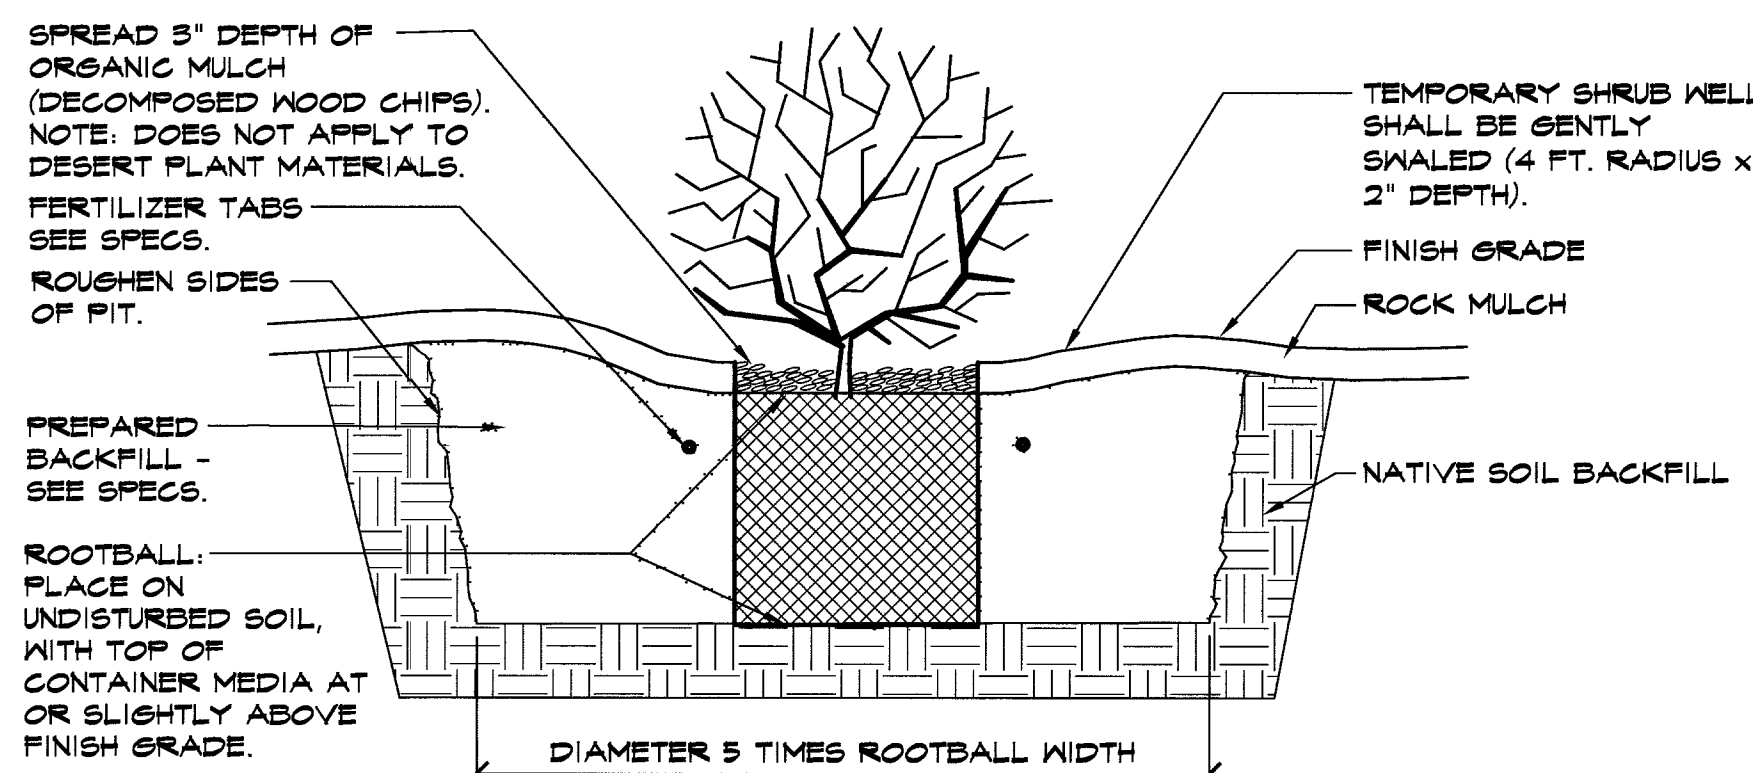

3 SHRUB PLANTING

NTS

RECORD DRAWING (01/19/06)



7251 W. CHARLESTON BLVD
LAS VEGAS, NEVADA 89117
PHONE (702) 258-0115
FAX (702) 869-8547

WASHINGTON BUFFALO PARK - PHASE 1A
WASHINGTON & BUFFALO, LAS VEGAS, NV

OWNER: CITY OF LAS VEGAS
DEPARTMENT OF PUBLIC WORKS
ARCHITECTURAL SERVICES

400 EAST STEWART AVENUE
LAS VEGAS, NEVADA 89101
PHONE (702) 229-6535
FAX (702) 382-8232
TDD (702) 386-9108

DRAWN: KUC
FILE: 2106P-05.dwg
DATE: 7/03
SCALE: NTS
BRD NO: 031334108
CLV DWG NO: 650216-1A
SHT NO: 100% SUBMITTAL

PL-5