

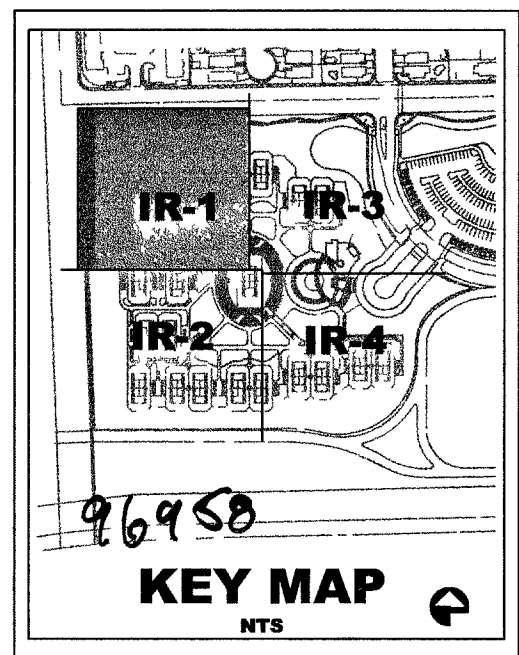


RECORD DOCUMENTS ARE PREPARED FROM DATA AND INFORMATION SUPPLIED BY THE CONTRACTOR. INFORMATION PROVIDED BY THE CONTRACTOR IS INCOMPLETE. AQUA ENGINEERING, INC. DOES NOT CERTIFY, NOR WARRANT IN ANY MANNER, THE ACCURACY OR COMPLETENESS OF RECORD DOCUMENTS. AQUA ENGINEERING, INC. ADVISES ANYONE USING RECORD DOCUMENTS, FOR ANY PURPOSE, TO INDEPENDENTLY VERIFY THE ACCURACY OR COMPLETENESS OF THE INFORMATION PRESENTED; AND TO VERIFY THE SUITABILITY OF INFORMATION FOR PURPOSE FOR WHICH THEY INTEND TO USE THE INFORMATION. AQUA ENGINEERING, INC. IS NOT RESPONSIBLE FOR PROBLEMS, DISCREPANCIES OR RELATED COSTS FROM USE OF RECORD DOCUMENTS.

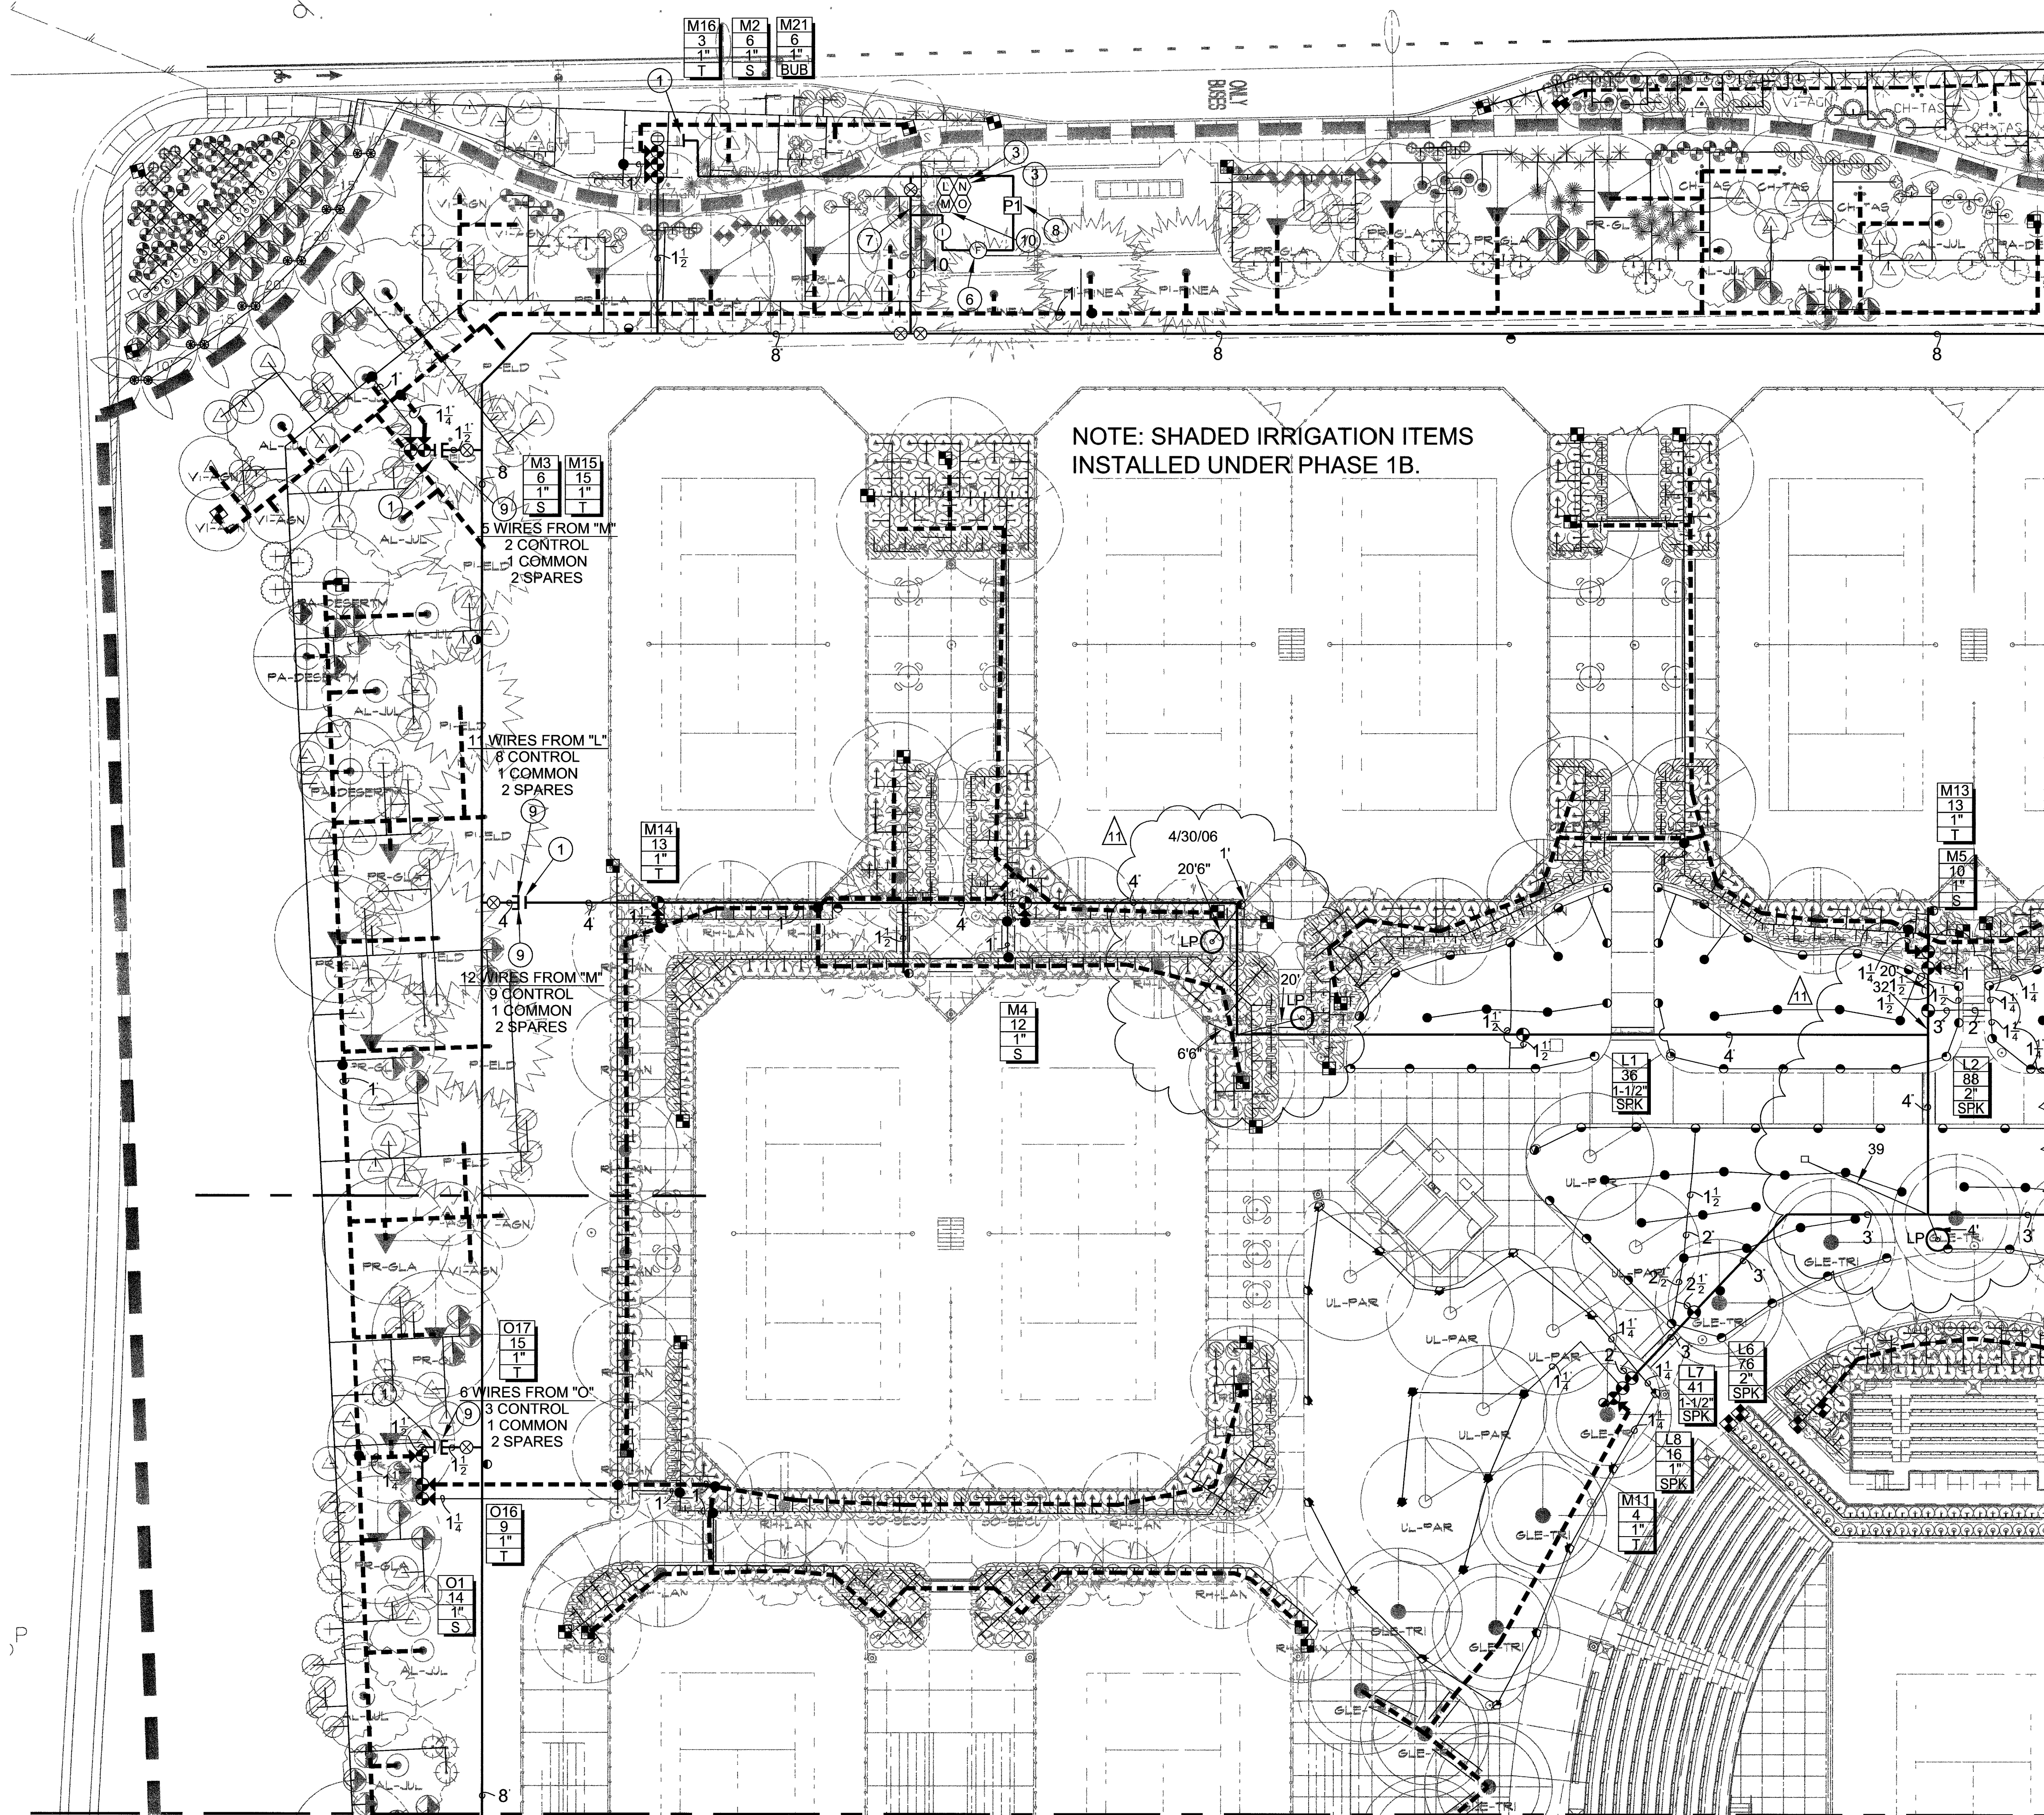


Aqua Engineering, Inc.
Irrigation System Design, Water Management,
and Water Feature Engineering
4803 Innovation Drive
Fort Collins, Colorado 80525
Phone (970) 229-9668, FAX (970) 226-3855

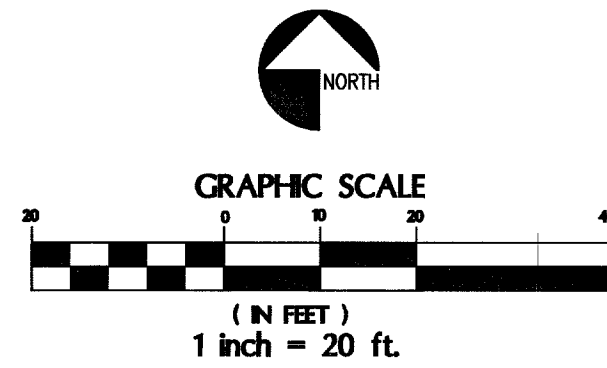

CONTRACTOR REVISIONS
1-19-06

CONSULTANT

7251 W CHARLESTON BLVD
LAS VEGAS, NEVADA 89117
PHONE (702) 258-0115
FAX (702) 869-8547

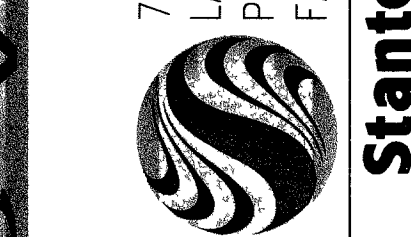

WASHINGTON BUFFALO PARK - PHASE 1A
WASHINGTON & BUFFALO, LAS VEGAS, NV
IRRIGATION PLAN
CONTRACTOR RECORD DRAWINGS

OWNER: CITY OF LAS VEGAS
DEPARTMENT OF PUBLIC WORKS
ARCHITECTURAL SERVICES

400 EAST STEWART AVENUE
LAS VEGAS, NEVADA 89101
PHONE: (702) 229-6535
FAX: (702) 382-3232
TDD: (702) 386-9100

DRAWN: RJP
FILE: P-IR-01.dwg
DATE: AUGUST 2003
SCALE: 1"=20'-0"
SHEET NO: 03.B34101
CLV DWG NO: 6507161A

IR-1