
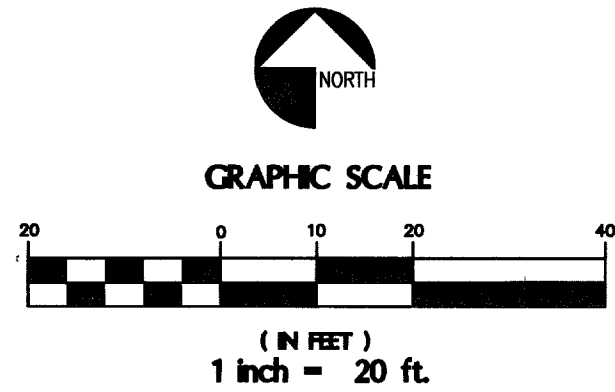



PLANT LIST					
TREES					
KEY	QTY	BOTANICAL (COMMON)	SIZE	MIN SPEC*	NOTES
	12	ALBIZIA JULIBRISSIN (SILK TREE)	24" BOX	8'x4'x1.5"	1
	9	CHITALPA TASHKENTENSIS (CHITALPA)	24" BOX	8'x4'x1.5"	1
	10	SLEDITSIA TRIANGANTHOS 'MORAINI' (HONEY LOCUST)	36" BOX	12'x8'x2.25"	2
	4	PARKINSONIA X 'DESERT MUSEUM' (DESERT MUSEUM PALO VERDE)	24" BOX	9'x6'x1.5"	3
	0	PHOENIX DACTYLIFERA (DATE PALM)	SEE PLAN		4
	8	PINUS ELDARICA (MONDEL PINE)	24" BOX	10'x4'x2"	2
	3	PINUS PINEA (STONE PINE)	24" BOX	8'x4'x2"	2
	14	PROSOPIS 'PHOENIX' TM (THORNLESS MESQUITE)	24" BOX	7'x4'x1.5"	2
	22	PYRUS KAWAKAMII (FLOWERING PEAR)	24" BOX	9'x4'x1.25"	2
	27	RHUS LANCEA (AFRICAN SUMAC)	24" BOX	8'x4.5'x1"	3
	5	SOPHORA SECUNDIFLORA (TEXAS MOUNTAIN LAUREL)	36" BOX	6'x5'x2"	3, 5
	16	ULMUS PARVIFOLIA (CHINESE ELM)	24" BOX	8'x3'x1.25"	2
	10	VITEX AGNUS-CASTUS (GHASTE TREE)	24" BOX	6'x3'x1.25"	3

SHRUBS & GROUND COVERS					
KEY	QTY	BOTANICAL NAME	COMMON NAME	SIZE (GAL.)	NOTES
	51	ACACIA REDOLENS 'DESERT CARPET'	DESERT CARPET ACACIA	5	MIN. 5 RUNNERS
	6	BACCHARIS HYBRID 'STARN THOMPSON'	STARN THOMPSON BACCHARIS	5	MIN. 5 RUNNERS
	0	BUDDLEIA HANDBURFOLIA	BUTTERFLY BUSH	5	CAN FULL
	52	CAESALPINIA PULCHERRIMA	RED BIRD OF PARADISE	5	CAN FULL
	45	CASSIA NEMOPHYLLA	DESERT CASSIA	5	CAN FULL
	14	CHYSAGINIA MEXICANA	DAMIANITA	5	CAN FULL
	15	DALEA CAPITATA	GOLDEN DAISY	5	MIN. 5 RUNNERS
	17	DALEA PULCHRA	BLACK DALEA	5	CAN FULL
	14	DASYLIRION WHEELERI	DESERT SPOON	5	CAN FULL
	15	HESPERALOE PARVIFLORA	RED YUCCA	5	CAN FULL
	164	LANTANA MONTEVIDENSIS	PURPLE TRAILING LANTANA	5	MIN. 5 RUNNERS
	56	LAVANDULA DENTATA	FRENCH LAVENDER	5	CAN FULL
	45	LEUCOPHYLLUM LYNN'S LEGACY	LYNN'S LEGACY RANGER	5	CAN FULL
	55	LEUCOPHYLLUM ZYGOPHYLLUM 'GIMARRON'	GIMARRON BLUE RANGER	5	CAN FULL
	14	MULLENBERGIA CAPILLARIS 'REGAL MIST'	REGAL MIST DEER GRASS	5	CAN FULL
	27	MYRTUS COMMUNIS 'COMPACTA'	DWARF MYRTLE	5	CAN FULL
	168	RHAPIOLEPIS INDICA 'BALLERINA'	'BALLERINA' INDIA HAWTHORNE	5	CAN FULL
	55	SALVIA GREGGII	AUTUMN SAGE	5	CAN FULL
	154	VIBURNUM TINUS 'DWARF'	DWARF LAURISTINE	5	CAN FULL
	282	XYLOSMA COMESTUM 'COMPACTA'	COMPACT XYLOSMA	5	CAN FULL
	11	YUCCA RECURVIFOLIA	PENDULOUS YUCCA	5	CAN FULL

NOTES:
*HEIGHT x WIDTH x CALIPER
TREE NOTES: ① LOW-BRANCHING; ② STANDARD; ③ MULTI-TRUNK; ④ DIAMOND CUT TRUNK; ⑤ FIELD DUG/BALL & BURLAP.
NOTES TO CONTRACTORS:
1. WITHIN 30 DAYS AFTER PROJECT NOTICE TO PROCEED, CONTRACTOR SHALL COORDINATE WITH LANDSCAPE ARCHITECT AND OWNER'S REPRESENTATIVE FOR TRAVEL TO NURSERIES FOR PLANT SELECTION, AT CONTRACTOR'S EXPENSE. SEE SPECIFICATIONS SECTION 02400.
2. QUANTITIES SHOWN ARE FOR REFERENCE ONLY; CONTRACTOR MUST VERIFY ALL PLANT QUANTITIES FROM PLANS.
Turf - SEE GP-1 AND SEE SPEC SECTION 02415

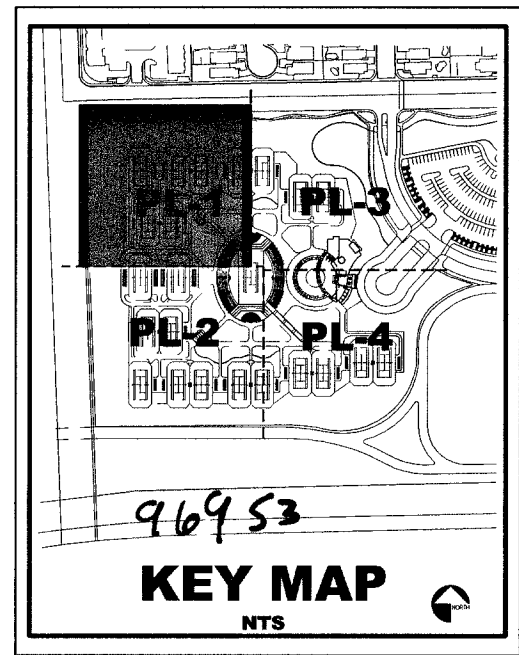

FUTURE DURANGO DRIVE (BY OTHERS)

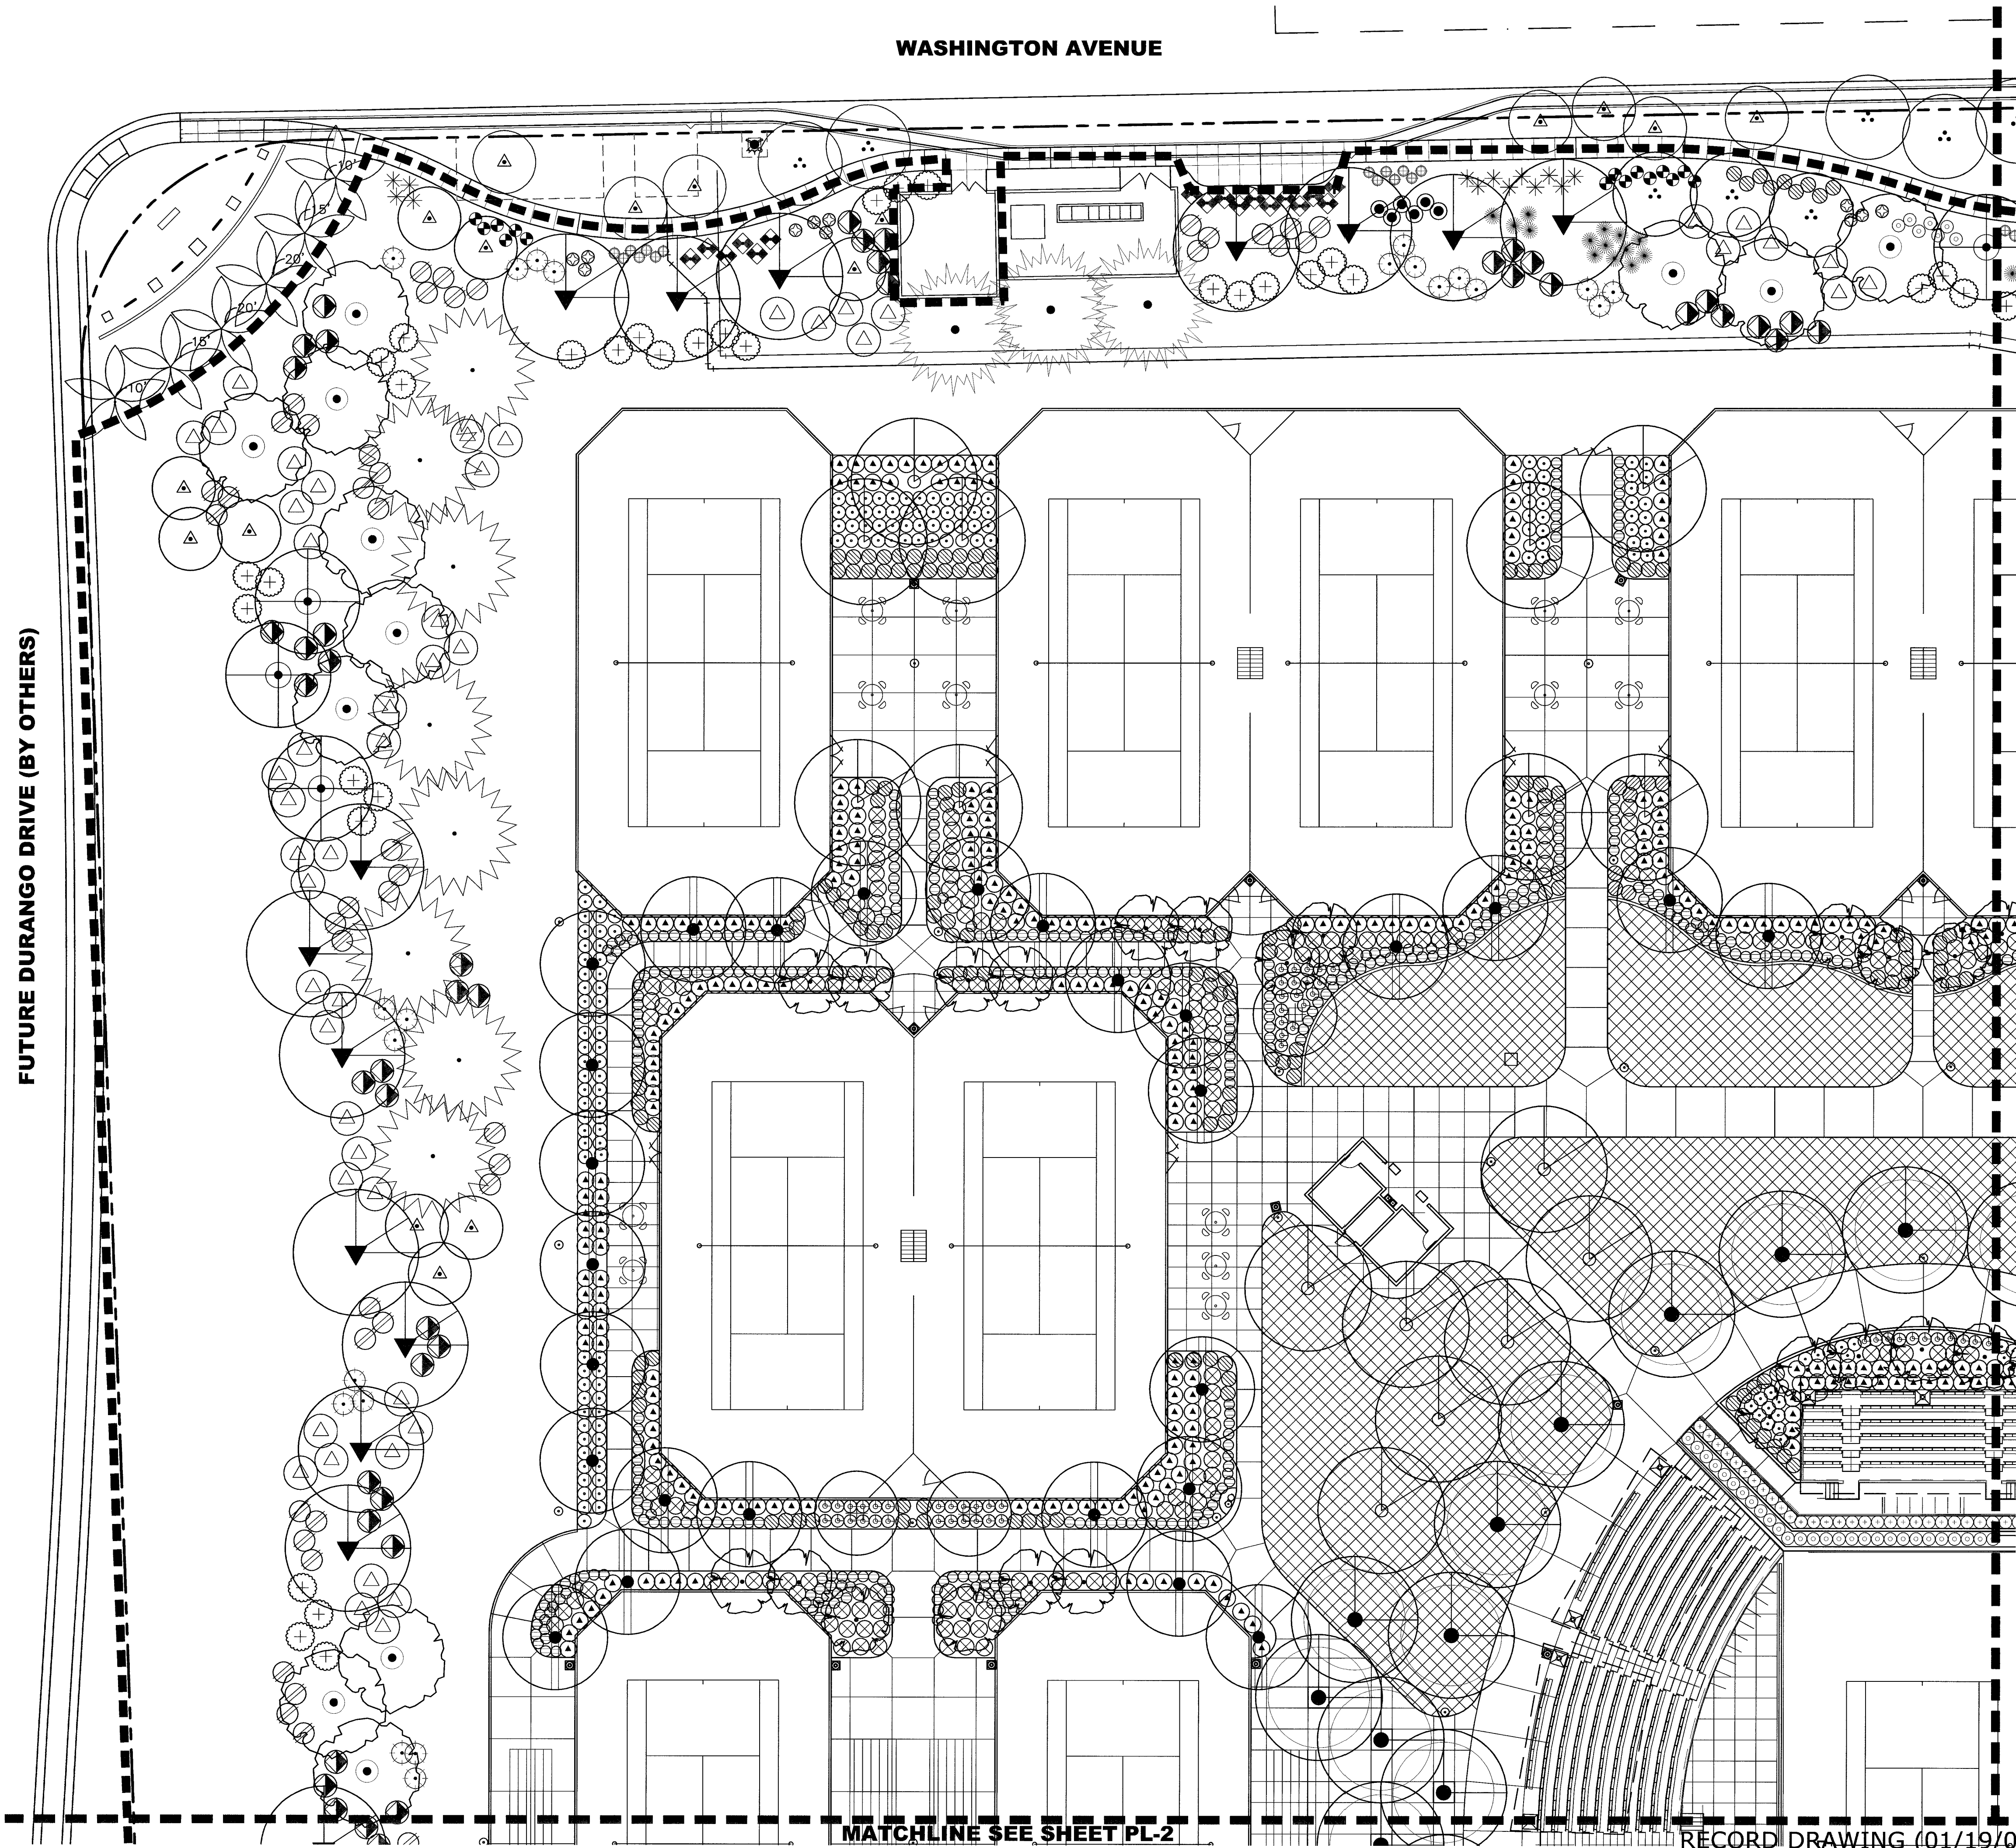

MATCHLINE SEE SHEET PL-3

MATCHLINE SEE SHEET PL-2

RECORD DRAWING (01/19/06)



REVISIONS

NO.	DATE	DESCRIPTION

CONSULTANT

7251 W. CHARLESTON BLVD.
LAS VEGAS, NEVADA 89117
PHONE (702) 258-0115
FAX (702) 369-8547

Stantec

WASHINGTON BUFFALO PARK - PHASE 1A
WASHINGTON & BUFFALO, LAS VEGAS, NV

PLANTING PLAN

OWNER: CITY OF LAS VEGAS
DEPARTMENT OF PUBLIC WORKS
ARCHITECTURAL SERVICES

400 EAST STEWART AVENUE
LAS VEGAS, NEVADA 89101
PHONE: (702) 229-8535
FAX: (702) 382-8232
TDD: (702) 386-9108

DATE	BY
CLR	2/16/06
DATE	7/03
SCALE	1"=20'-0"
SHEET NO.	03.534.02
CLV DWS NO.	62076-1A
SHEET NO.	100% SUBMITTAL

PL-1