


WASHINGTON AVE.

DURANGO DRIVE

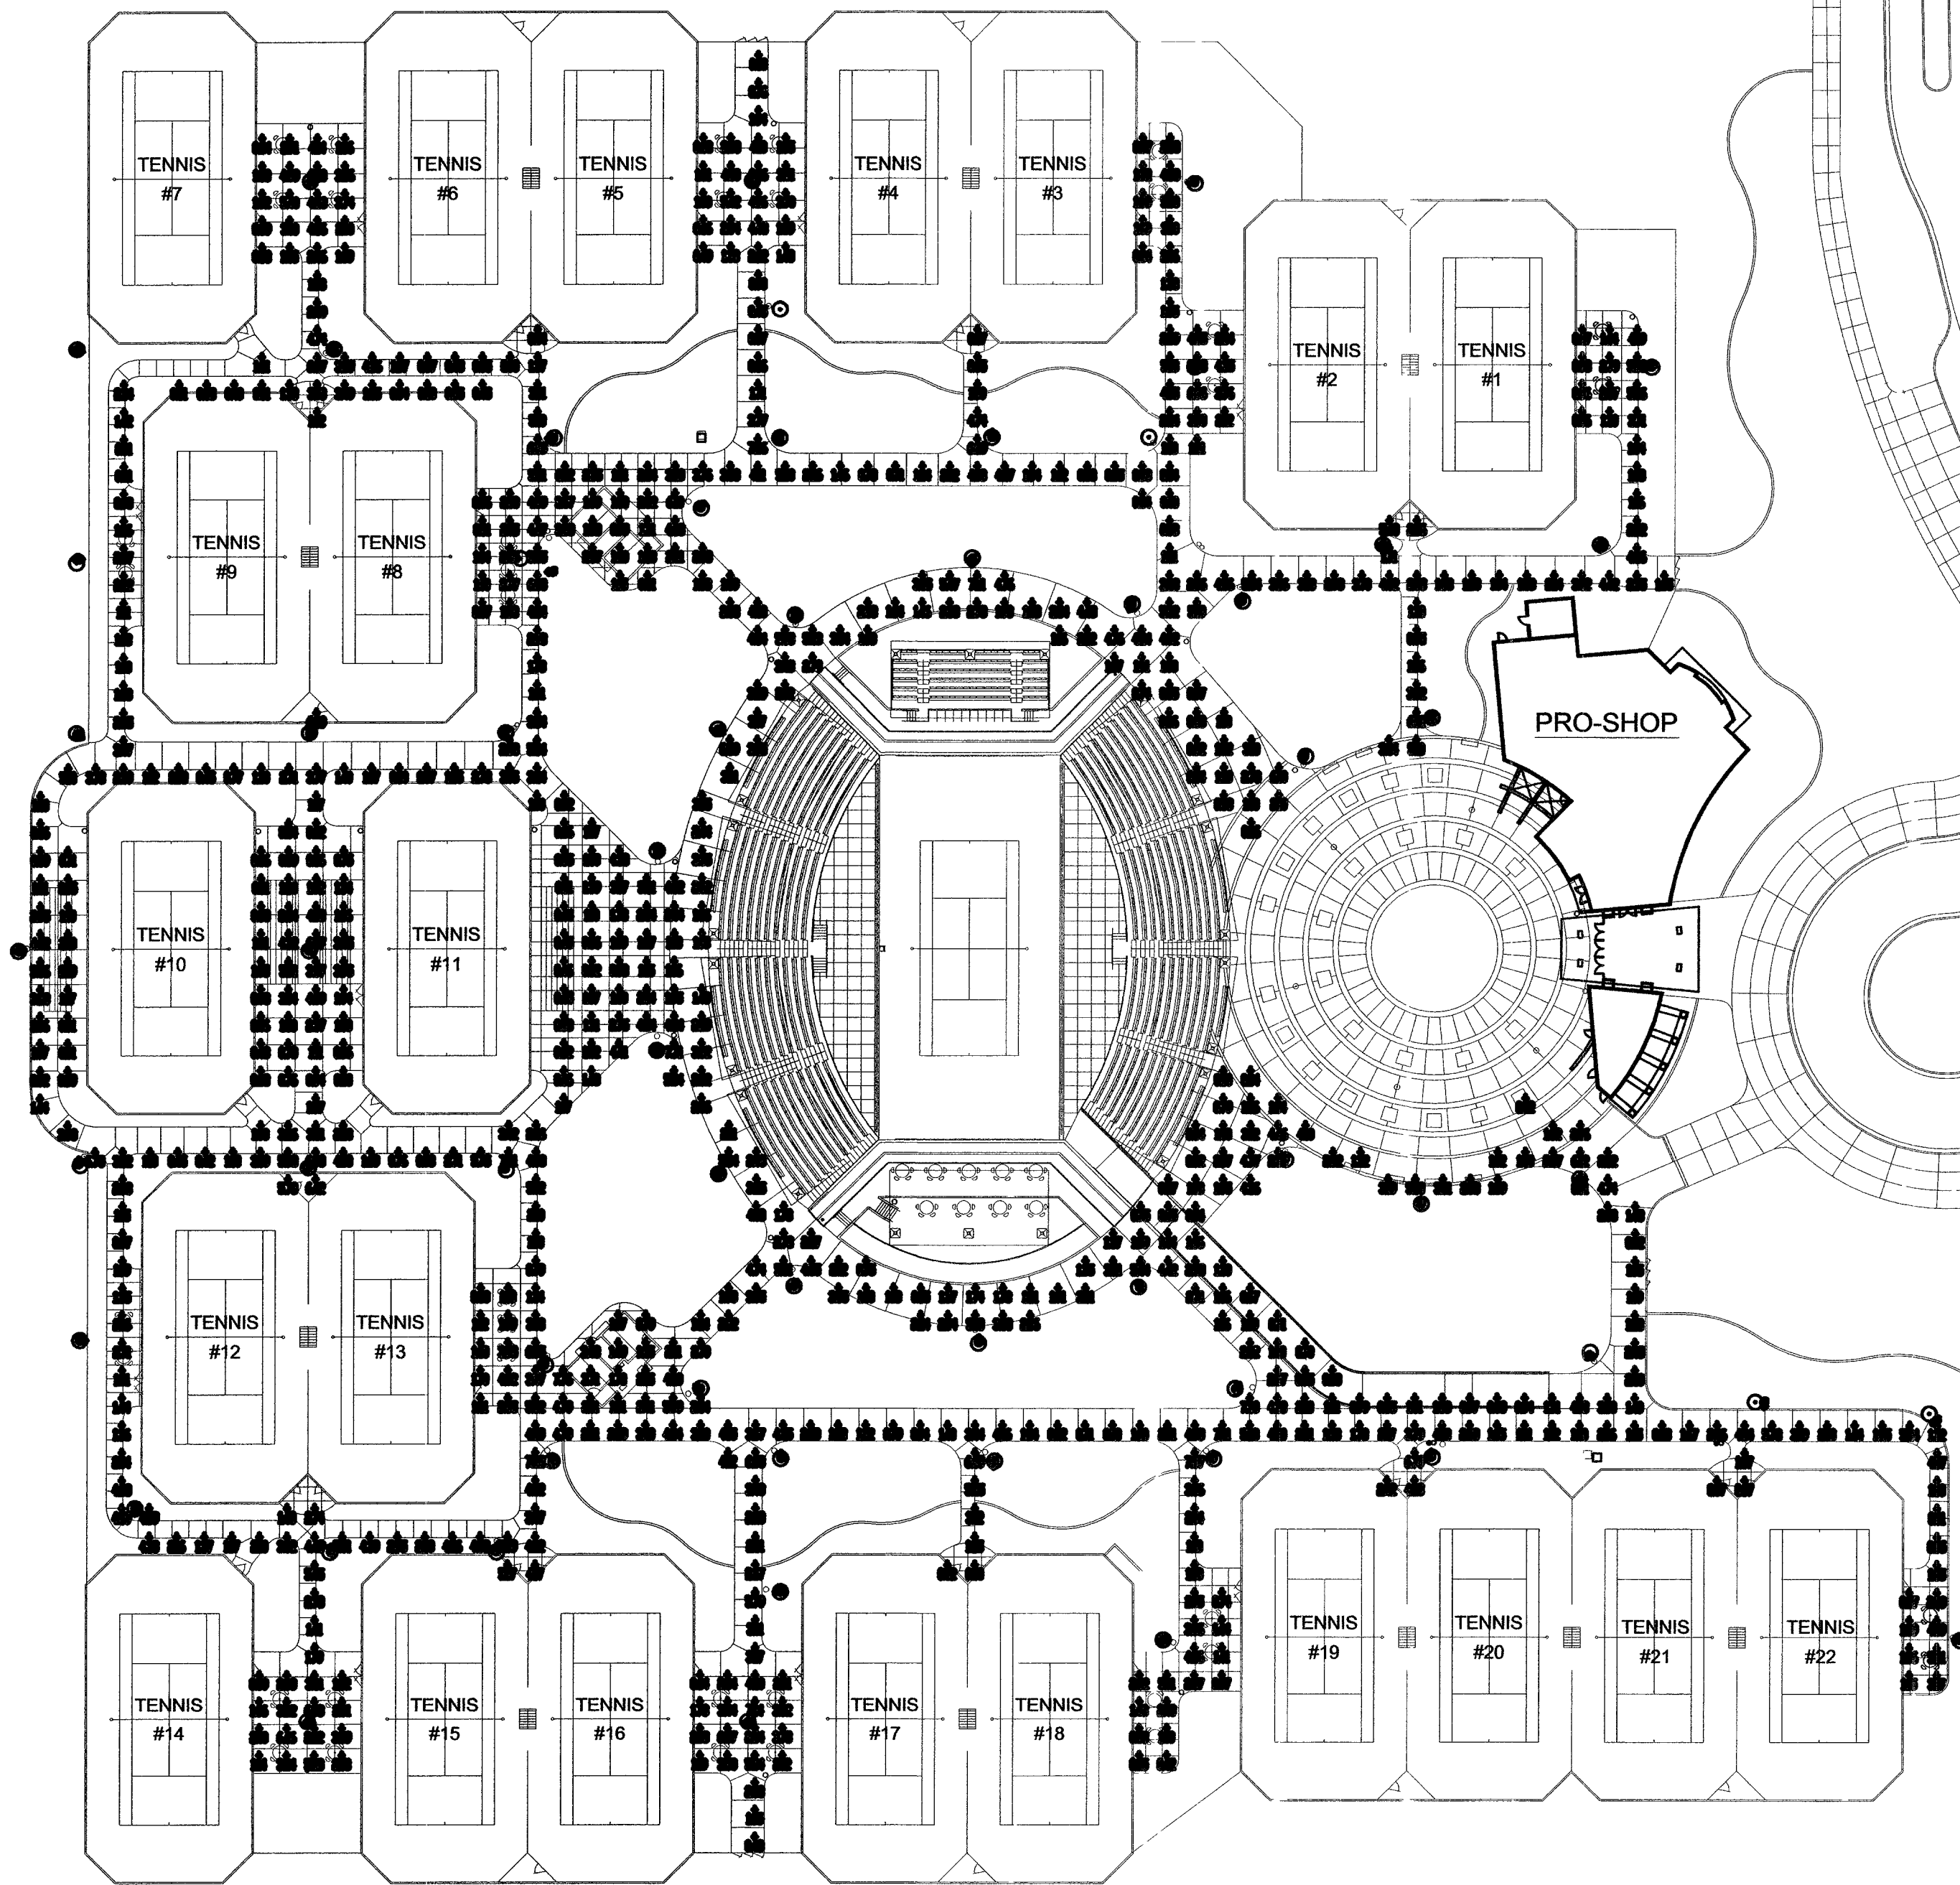

TENNIS COURT PATHWAY FOOTCANDLE LEVELS

SCALE: 1" = 50'-0"



RECORD DOCUMENTS ARE PREPARED FROM DATA AND INFORMATION SUPPLIED BY OTHERS. STANTEC CONSULTING, INC. DOES NOT CERTIFY, NOR WARRANT IN ANY MANNER, THE ACCURACY OR COMPLETENESS OF RECORD DOCUMENTS. STANTEC CONSULTING, INC. ADVISES ANYONE USING RECORD DOCUMENTS, FOR ANY PURPOSE, TO INDEPENDENTLY VERIFY THE ACCURACY OR COMPLETENESS OF THE INFORMATION PRESENTED; AND TO VERIFY THE SUITABILITY OF THE INFORMATION FOR THE PURPOSE FOR WHICH THEY INTEND TO USE THE INFORMATION. STANTEC CONSULTING, INC. SHALL NOT BE RESPONSIBLE FOR ANY PROBLEMS, DISCREPANCIES OR RELATED COSTS THAT MAY ARISE OUT OF THE USE OF RECORD DOCUMENTS.



REVISIONS
1/27/06 RECORD DRAWING

CONSULTANT
ALLEGRO CONSULTANTS INC.
3430 E. Flamingo Rd.
Las Vegas, Nevada 89119
Phone: (702) 458-2388
Fax: (702) 458-4430

WASHINGTON/BUFFALO PARK - PHASE 1A
WASHINGTON & BUFFALO, LAS VEGAS, NV

TENNIS COURTS - PATHWAY FOOTCANDLE LEVELS

OWNER: CITY OF LAS VEGAS
DEPARTMENT OF PUBLIC WORKS
ARCHITECTURAL SERVICES

400 EAST STEWART AVENUE
LAS VEGAS, NEVADA 89101
PHONE: (702) 229-5535
FAX: (702) 382-3232
TDD: (702) 386-9108

DRAWN	ES		
FILE	TE-22		
DATE	7/03		
SCALE	1" = 50'-0"		
BID NO	0315341 01		
CLY/DWG NO	650161A		
SHT NO			

TE-22