

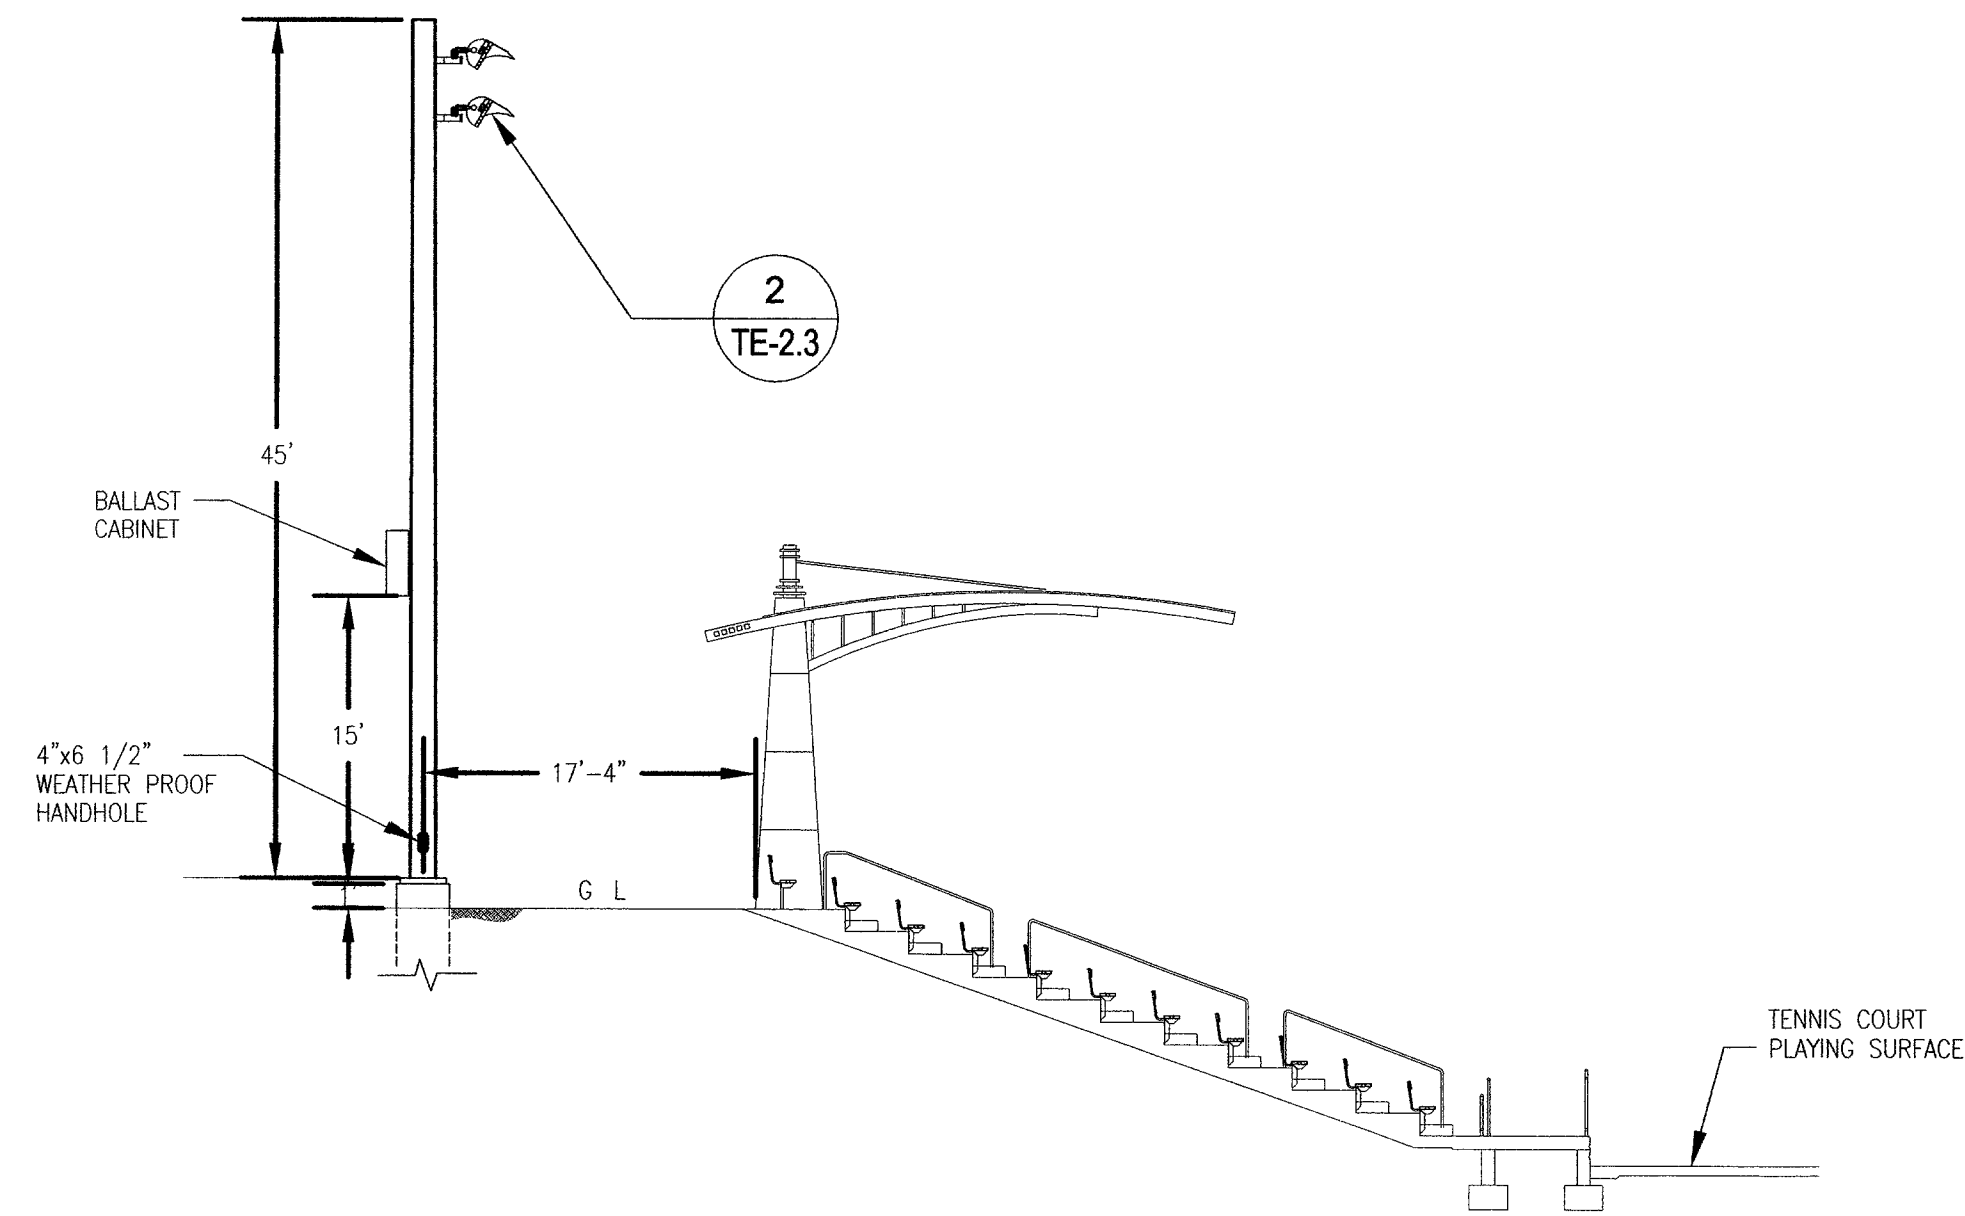


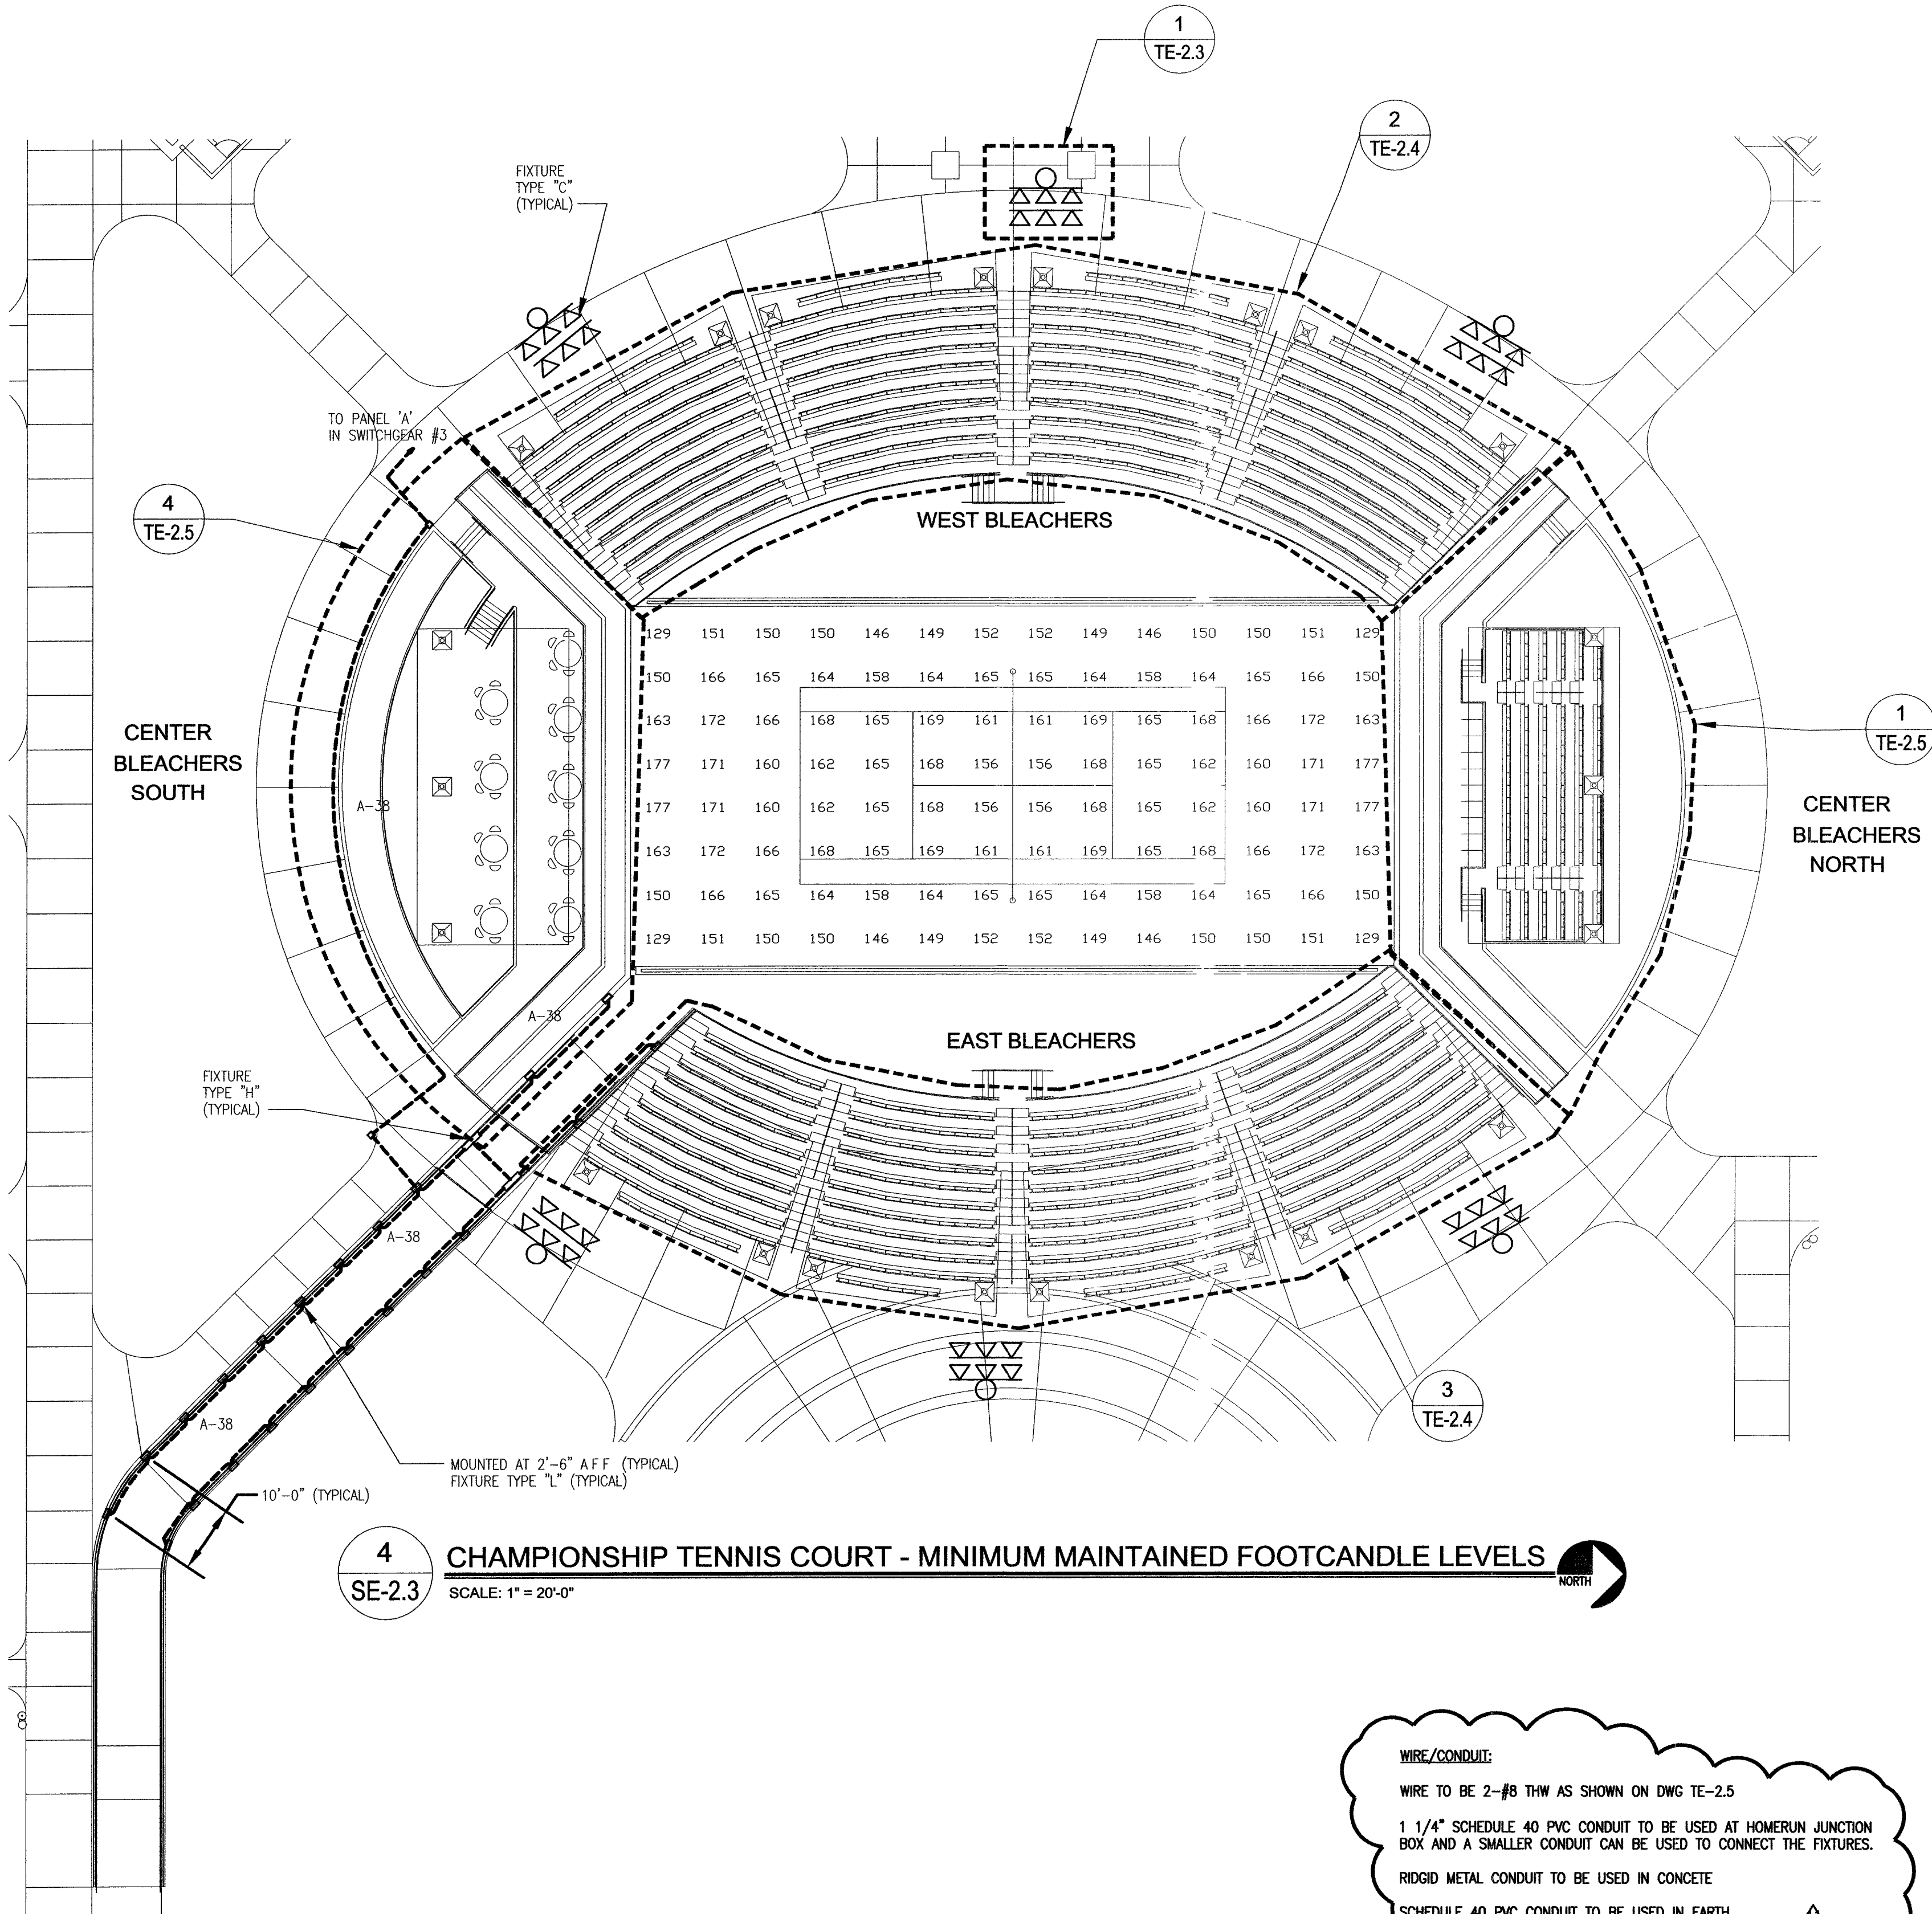

1
TE-2.3

CHAMPIONSHIP TENNIS COURT LIGHT FIXTURE ARRANGEMENT


NOT TO SCALE

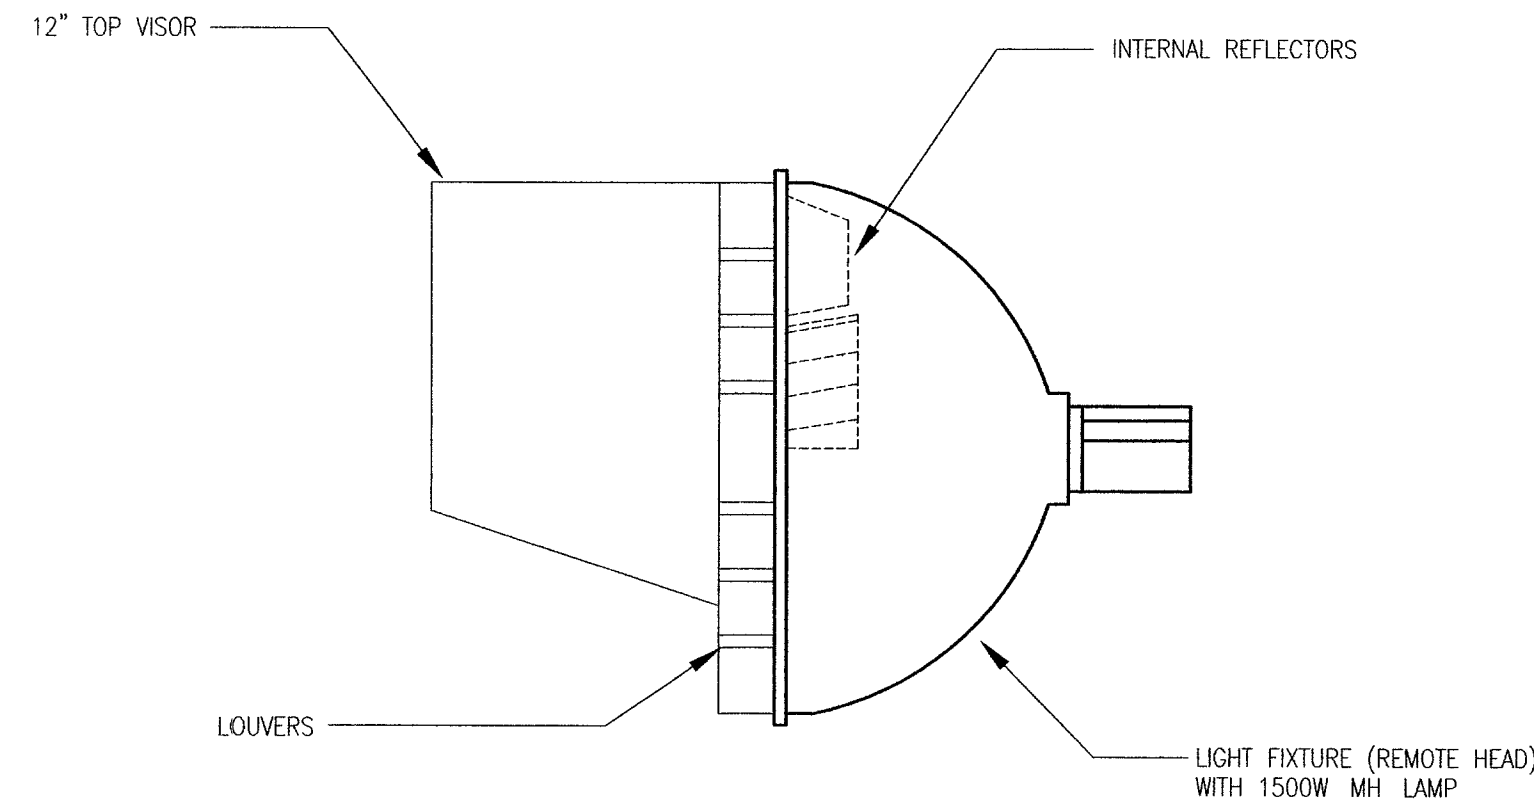

2
TE-2.3

CHAMPIONSHIP TENNIS COURT - FIXTURE TYPE "C" DETAIL

NOT TO SCALE

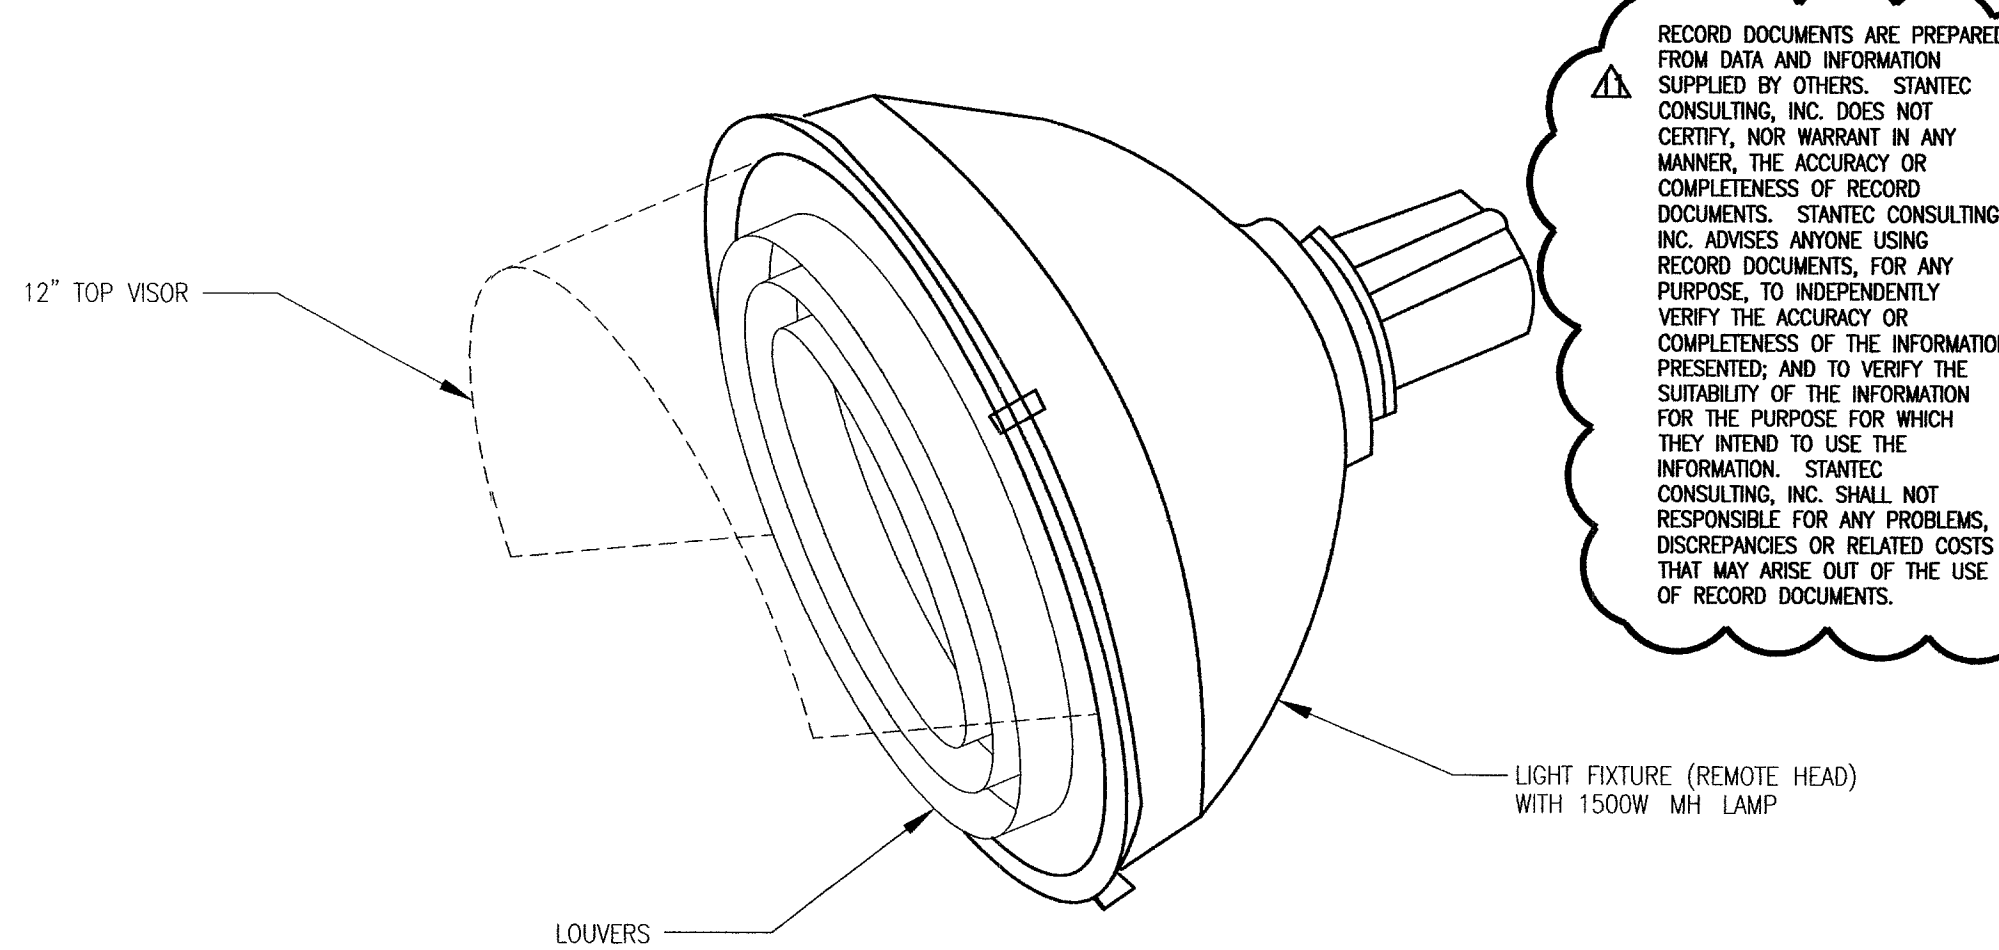

4
SE-4.10

SOCCER FIELD - LIGHT FIXTURE YYPE "D" ISOMETRIC VIEW

NOT TO SCALE

RECORD DRAWING



REVISIONS

NO.	DATE	DESCRIPTION
1	1/27/06	RECORD DRAWING

CONSULTANT

ALLEGRO CONSULTANTS INC.
3430 E. Flamingo Rd.
Las Vegas, Nevada 89121
Phone: (702) 458-2388
Fax: (702) 458-4430

WASHINGTON/BUFFALO PARK - PHASE 1A
WASHINGTON & BUFFALO, LAS VEGAS, NV
CHAMPIONSHIP TENNIS COURT - MINIMUM MAINTAINED
FOOTCANDLE LEVELS AND DETAILS

STAMP

OWNER: CITY OF LAS VEGAS
DEPARTMENT OF PUBLIC WORKS
ARCHITECTURAL SERVICES

400 EAST STEWART AVENUE
LAS VEGAS, NEVADA 89101
PHONE: (702) 229-5535
FAX: (702) 382-5232
TDD: (702) 386-9108

DRAWN	DATE	FILE	SCALE	BID NO	CLV DWG NO	SHT NO
ES	1/03	TE-2.3	AS NOTED	031541 01	65076 1A	TE-2.3