


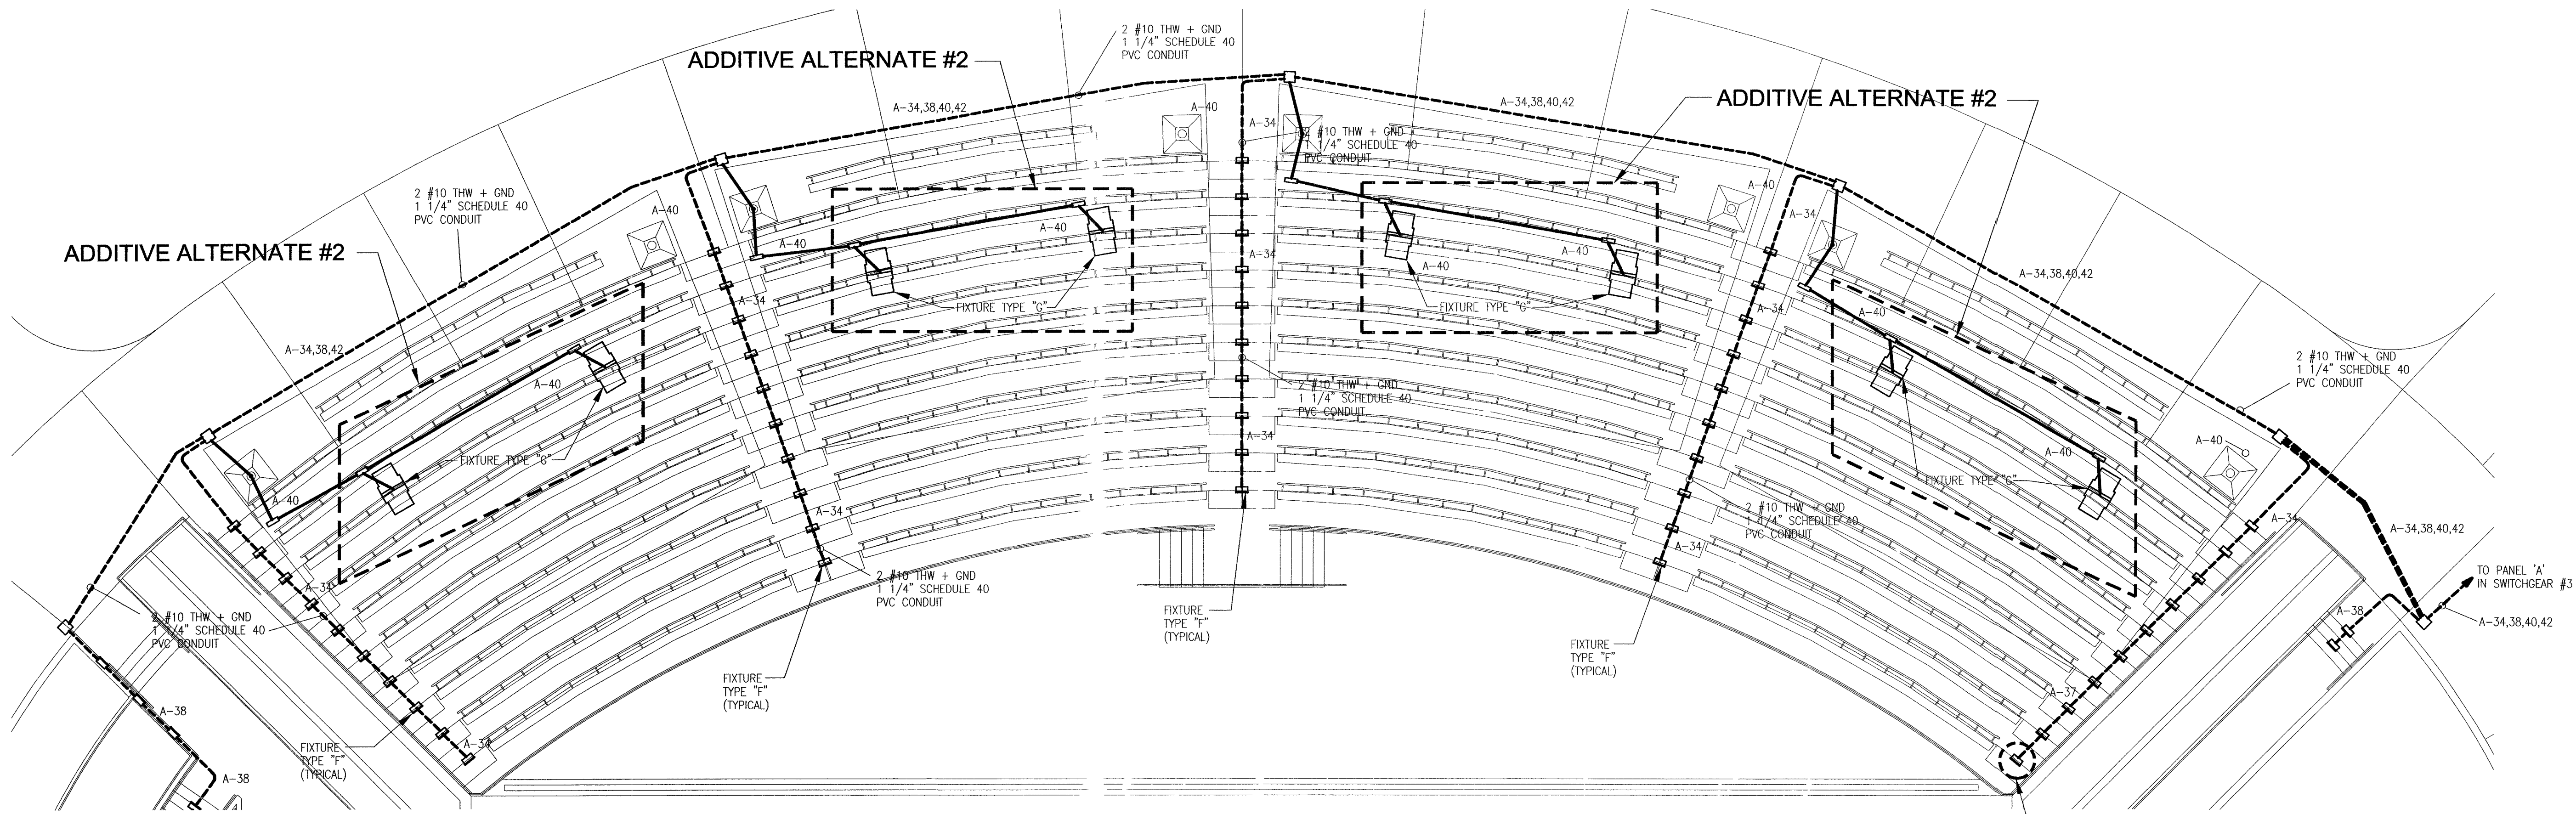


2 WEST SIDE BLEACHER'S LIGHTING
1/8" = 1'-0"

3 TE-2.5

CONDUIT:

- SCHEDULE 40 PVC METAL CONDUIT TO BE INSTALLED FROM THE HOMERUN JUNCTION BOX TO THE DESIGNATED PANEL.
- RIGID METAL CONDUIT TO BE INSTALLED FROM FIXTURE TO FIXTURE WITHIN THE CONCRETE STEPS.
- A SMALLER CONDUIT SIZE MAY BE USED.
- RIGID METAL CONDUIT TO BE USED IN CONCRETE
- SCHEDULE 40 PVC CONDUIT TO BE USED IN EARTH

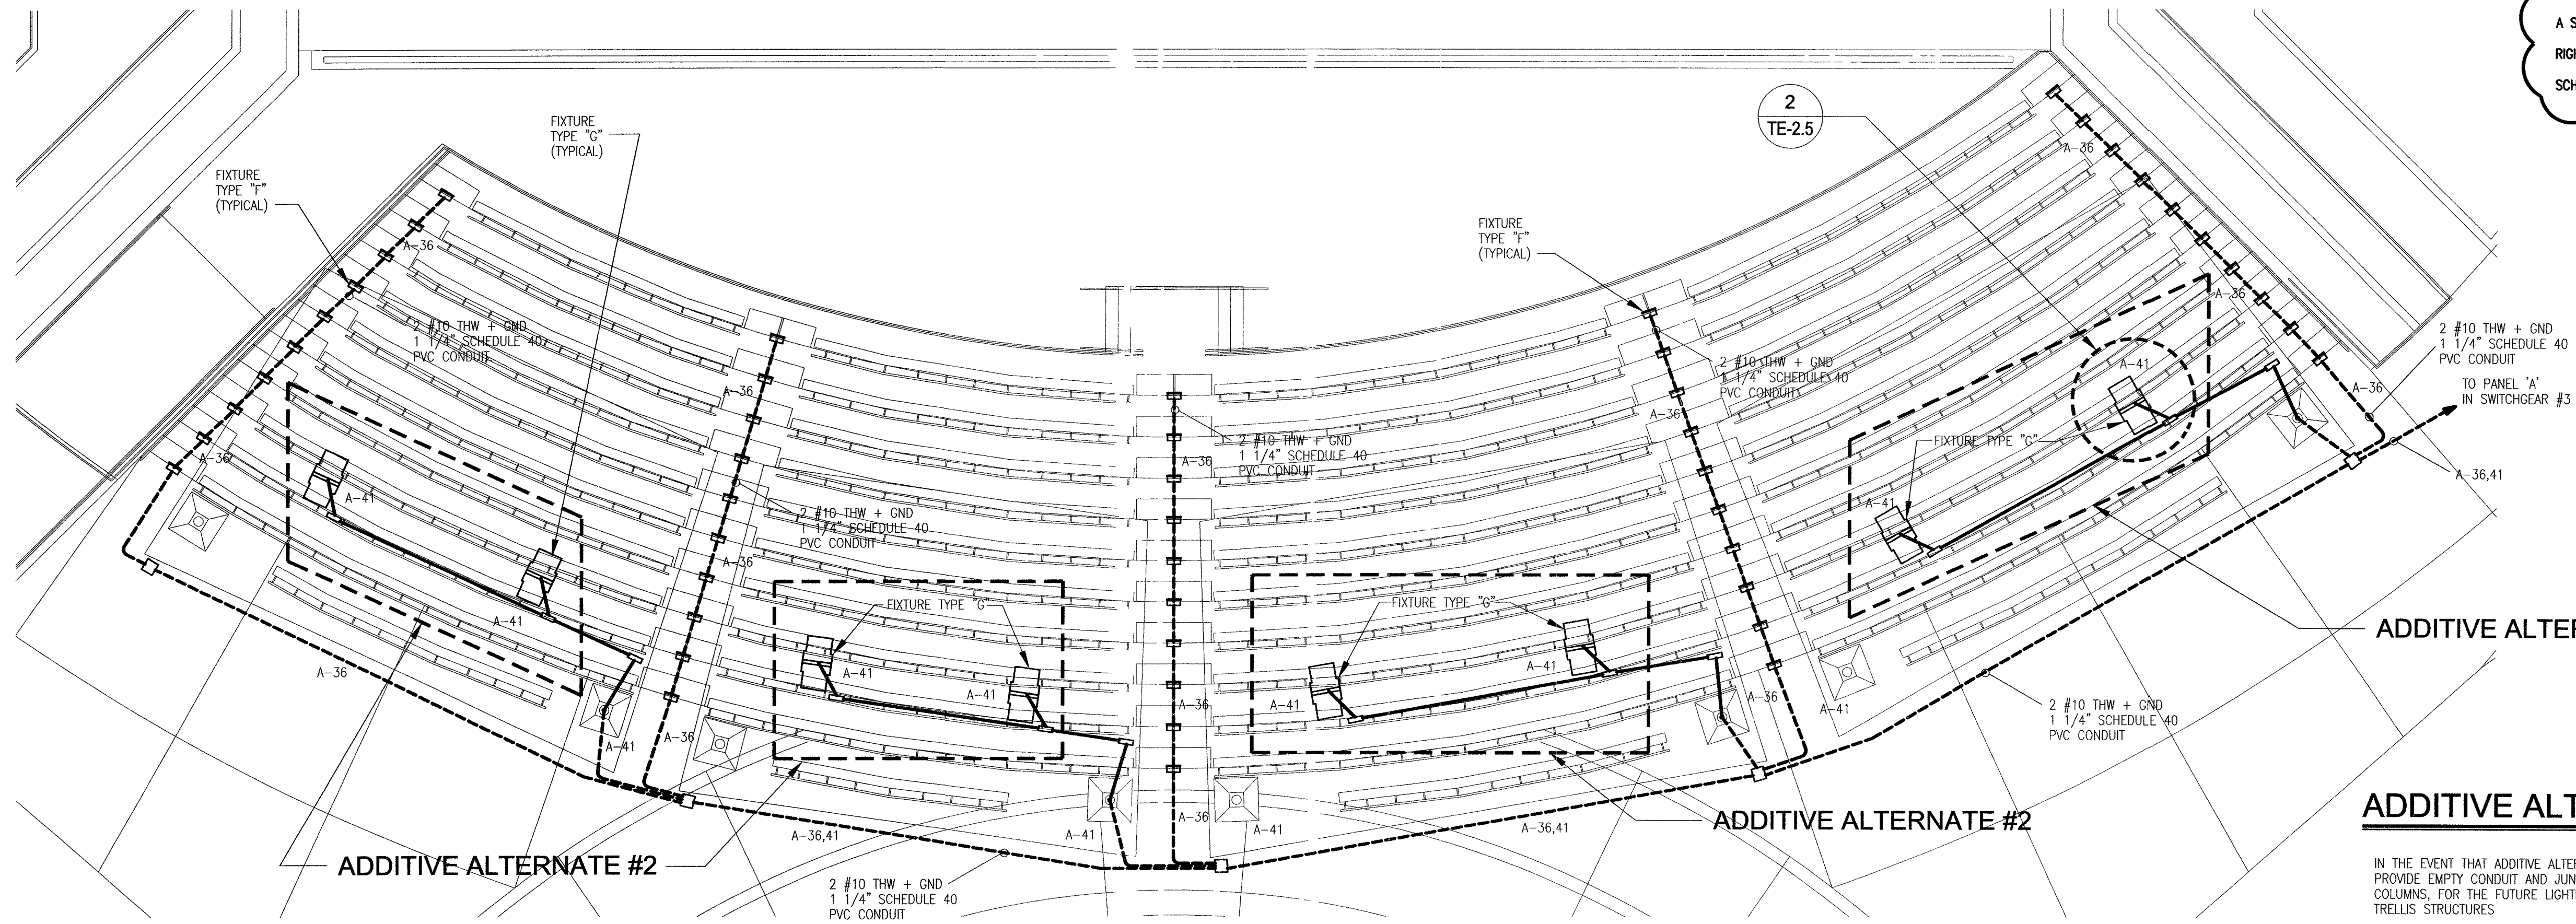

3 EAST SIDE BLEACHER'S LIGHTING
1/8" = 1'-0"

ADDITIVE ALTERNATE #2

ADDITIVE ALTERNATE #2

ADDITIVE ALTERNATE #2

IN THE EVENT THAT ADDITIVE ALTERNATE #2 IS NOT EXCEPTED FROM THE INITIAL CONTRACT BID, PROVIDE EMPTY CONDUIT AND JUNCTION BOXES TO THE LOCATION OF THE BASE OF THE FUTURE COLUMNS, FOR THE FUTURE LIGHTING WHICH IS TO BE LOCATED UNDER THE CHAMPIONSHIP TENNIS TRELLIS STRUCTURES.

RECORD DOCUMENTS ARE PREPARED FROM DATA AND INFORMATION SUPPLIED BY OTHERS. STANTEC CONSULTING, INC. DOES NOT CERTIFY, NOR WARRANT IN ANY MANNER, THE ACCURACY OR COMPLETENESS OF RECORD DOCUMENTS. STANTEC CONSULTING, INC. ADVISES ANYONE USING RECORD DOCUMENTS, FOR ANY PURPOSE, TO INDEPENDENTLY VERIFY THE ACCURACY OR COMPLETENESS OF THE INFORMATION PRESENTED, AND TO VERIFY THE SUITABILITY OF THE INFORMATION FOR THE PURPOSE FOR WHICH THEY INTEND TO USE THE INFORMATION. STANTEC CONSULTING, INC. SHALL NOT BE RESPONSIBLE FOR ANY PROBLEMS, DISCREPANCIES OR RELATED COSTS THAT MAY ARISE OUT OF THE USE OF RECORD DOCUMENTS.



REVISIONS
1/27/06 RECORD DRAWING

CONSULTANT
ALLEGRO CONSULTANTS INC.
3430 E. Flamingo Rd.
Las Vegas, Nevada 89121
Phone: (702) 458-2388
Fax: (702) 458-4430



WASHINGTON/BUFFALO PARK - PHASE 1A
WASHINGTON & BUFFALO, LAS VEGAS, NV
CHAMPIONSHIP TENNIS COURT
EAST & WEST BLEACHERS STAIRWAY LIGHTING

STAMP

OWNER: CITY OF LAS VEGAS
DEPARTMENT OF PUBLIC WORKS
ARCHITECTURAL SERVICES

400 EAST STEWART AVENUE
LAS VEGAS, NEVADA 89101
PHONE: (702) 229-5535
FAX: (702) 382-9232
TDD: (702) 386-9108

DRAWN	ES
FILE	TE-2.4
DATE	7/05
SCALE	AS NOTED
BID NO	0315B41 07
CLD DWD NO	65076 1A
SHT NO	TE-2.4

RECORD DRAWING

97022