




7 CONCRETE RELIEF SCULPTURE - NW CORNER
NTS

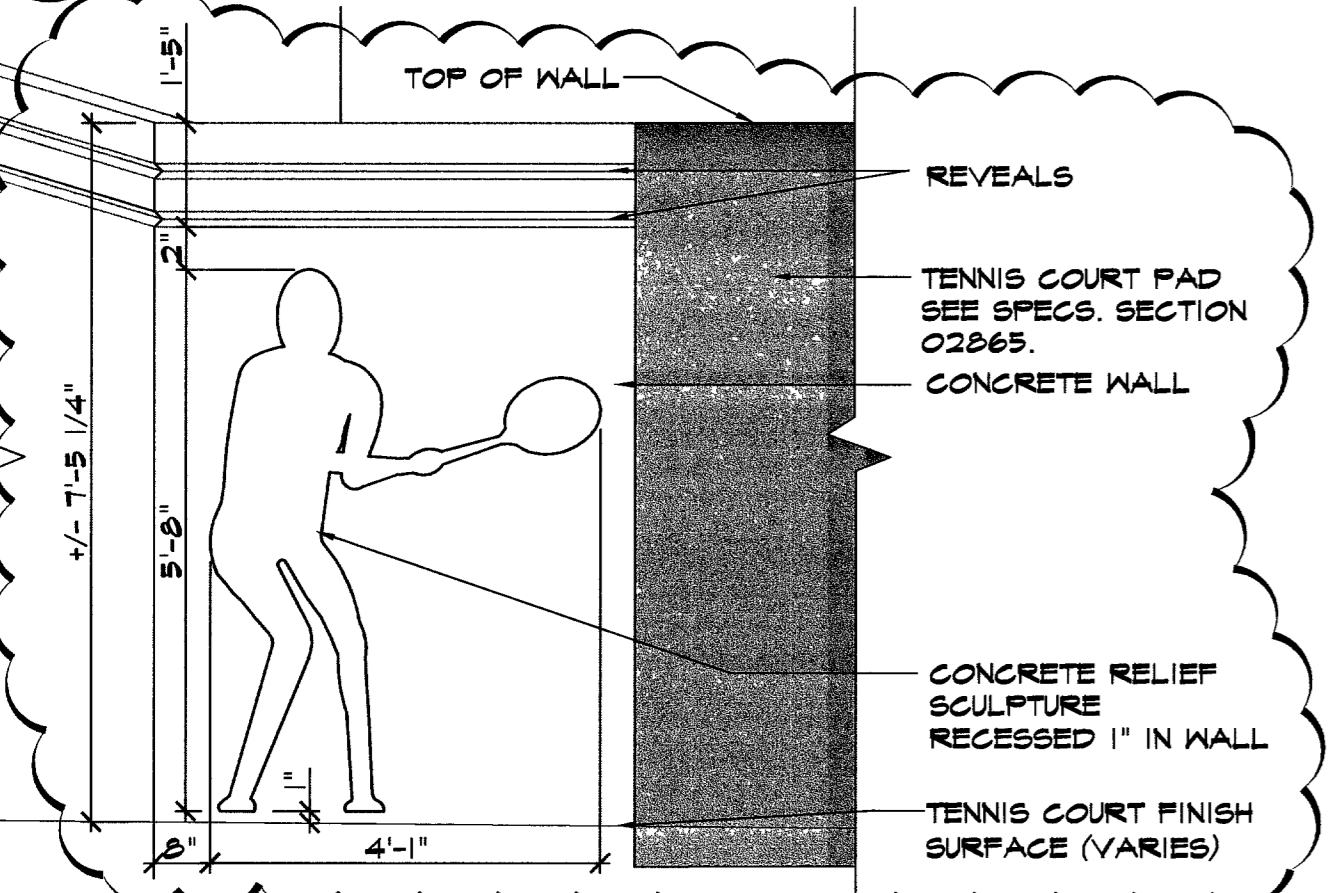


8 CONCRETE RELIEF SCULPTURE - NE CORNER
NTS

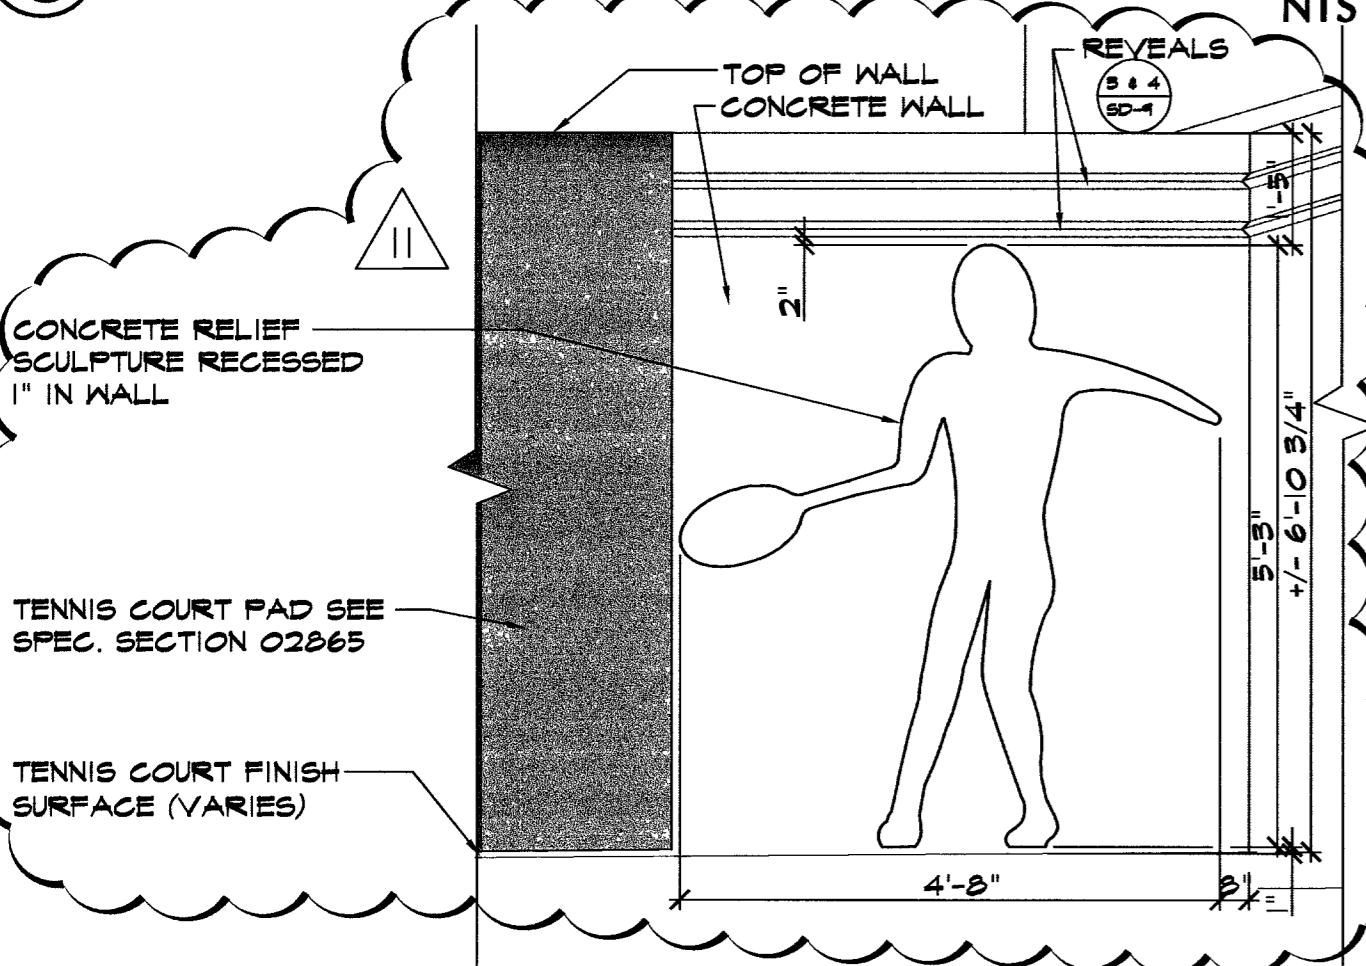

9 CONCRETE RELIEF SCULPTURE - SW CORNER
NTS

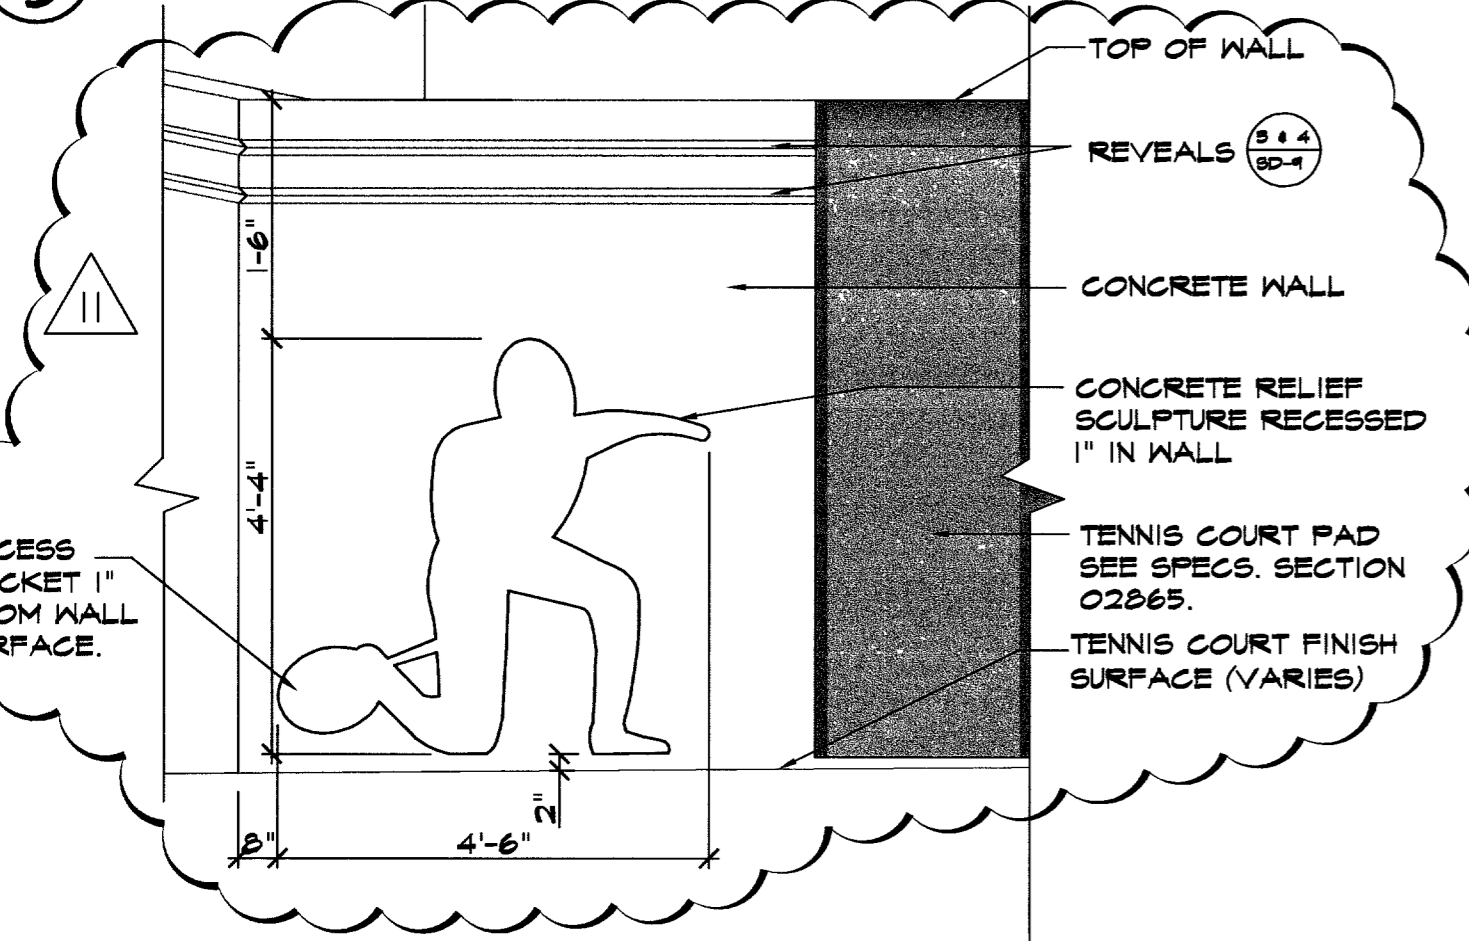


10 CONCRETE RELIEF SCULPTURE - SE CORNER
NTS

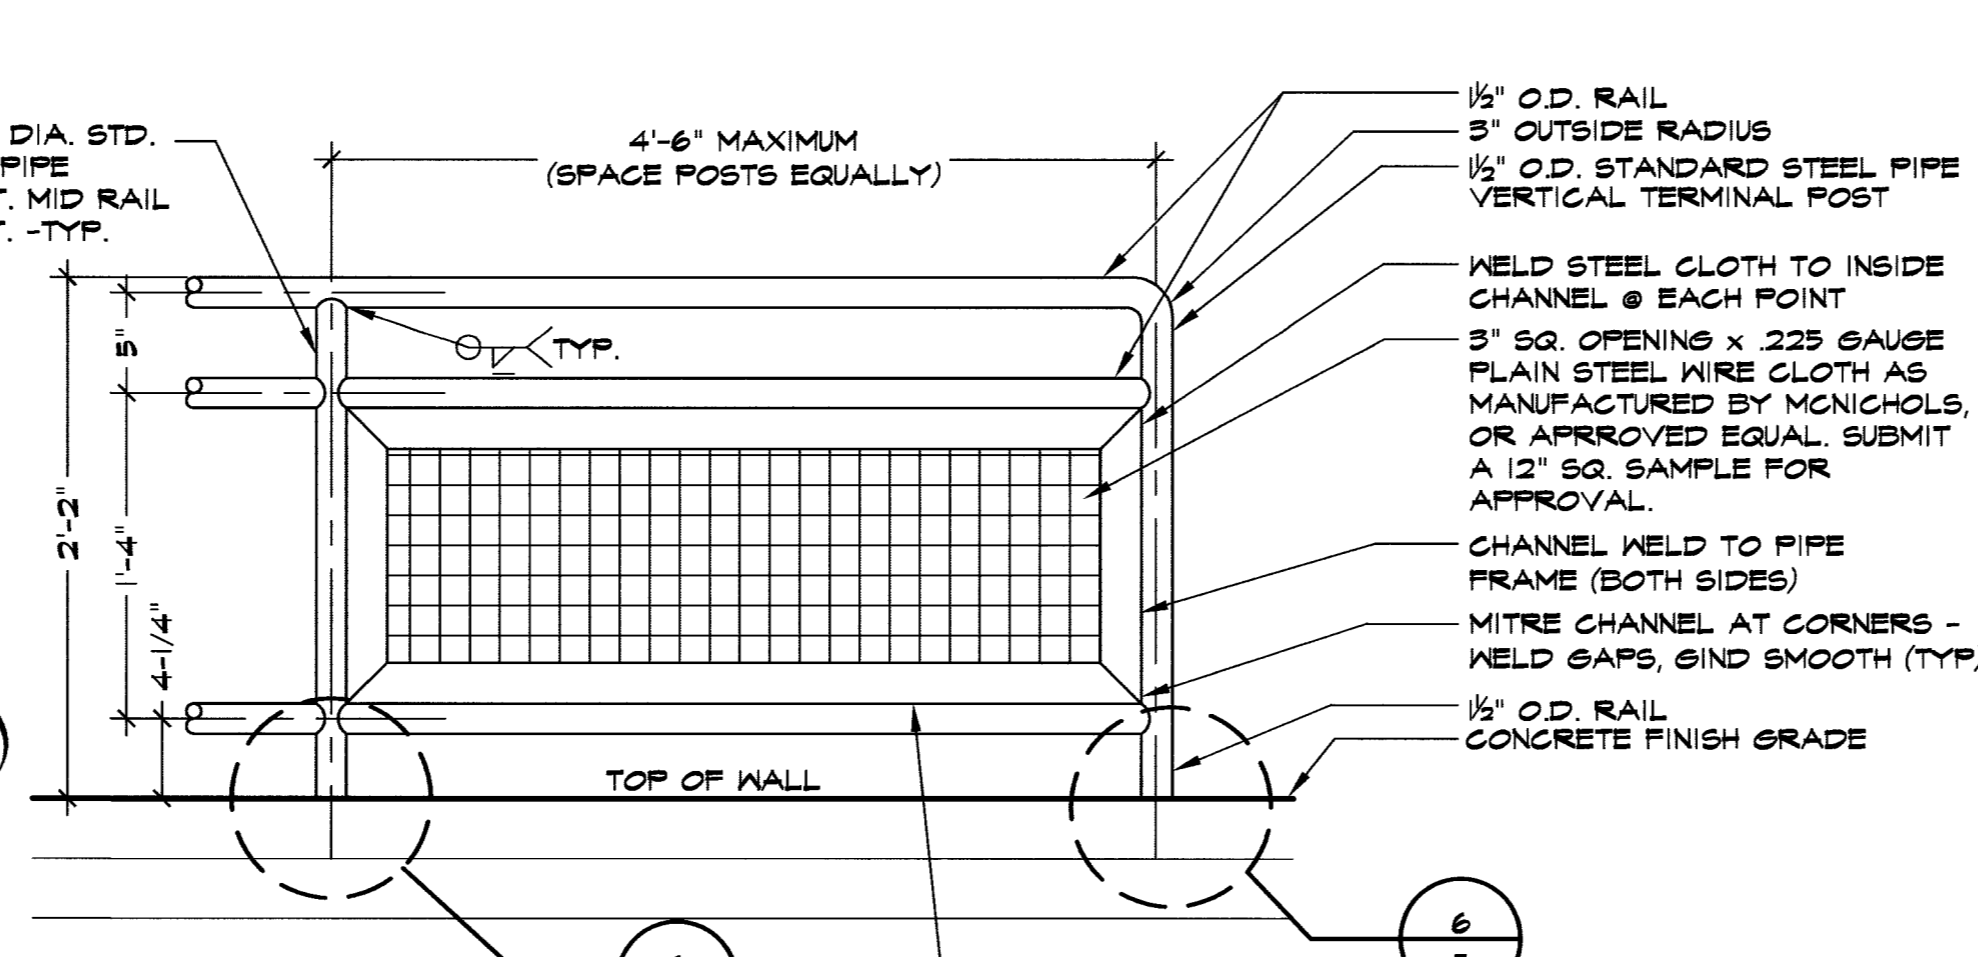

4 CHAMPIONSHIP TENNIS COURT SAFETY RAIL DETAIL
NTS

NOTES:
1. PRIME AND POWDERCOAT ALL GUARD RAILS AND SAFETY RAILS - SEE SPECS. SECTION 0552. COLOR: RAL 5004.
2. INSTALL ALL GUARD RAILS AND SAFETY RAILS PER SPEC. SECTION 0552.


SHOP DRAWING REQUIRED

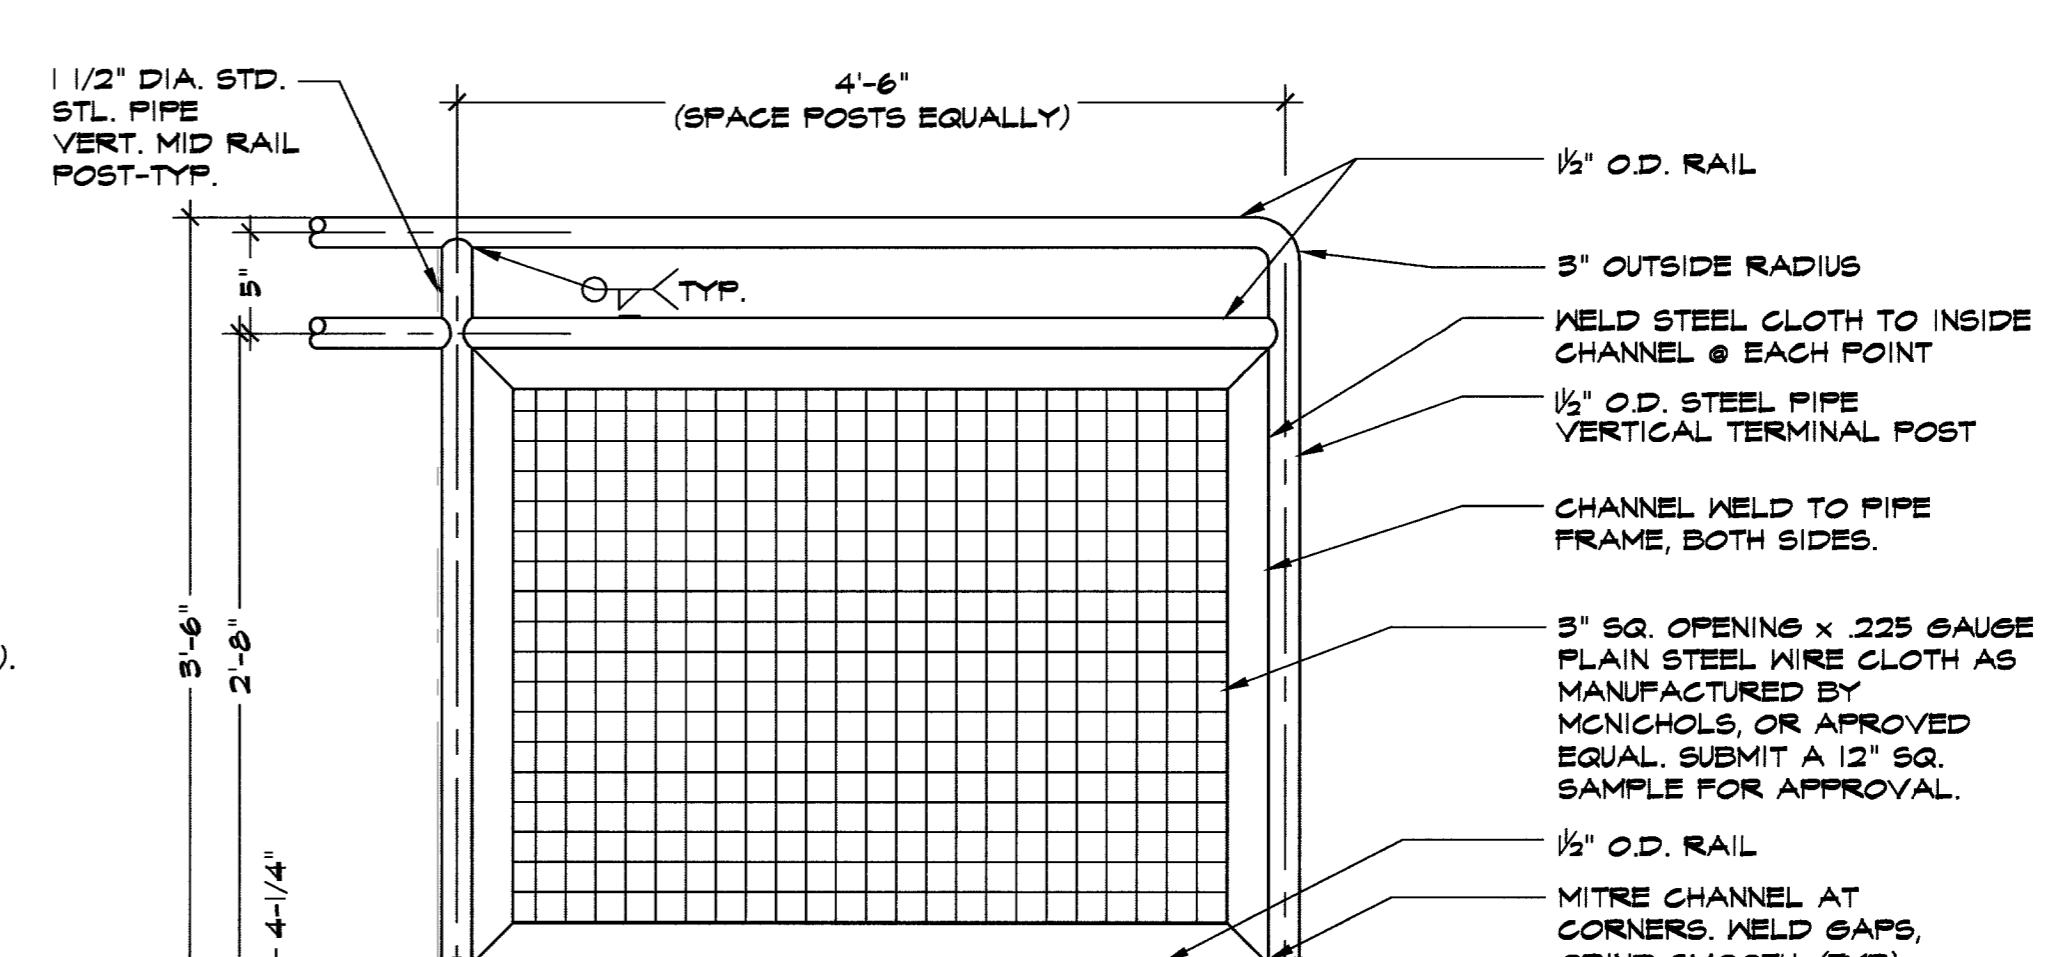

1 CHAMPIONSHIP TENNIS COURT GUARDRAIL DETAIL
NTS

NOTES:
1. PRIME AND POWDERCOAT ALL GUARD RAILS AND SAFETY RAILS - SEE SPECS. SECTION 0552. COLOR: RAL 5004.
2. INSTALL ALL GUARD RAILS AND SAFETY RAILS PER SPEC. SECTION 0552.


SHOP DRAWING REQUIRED

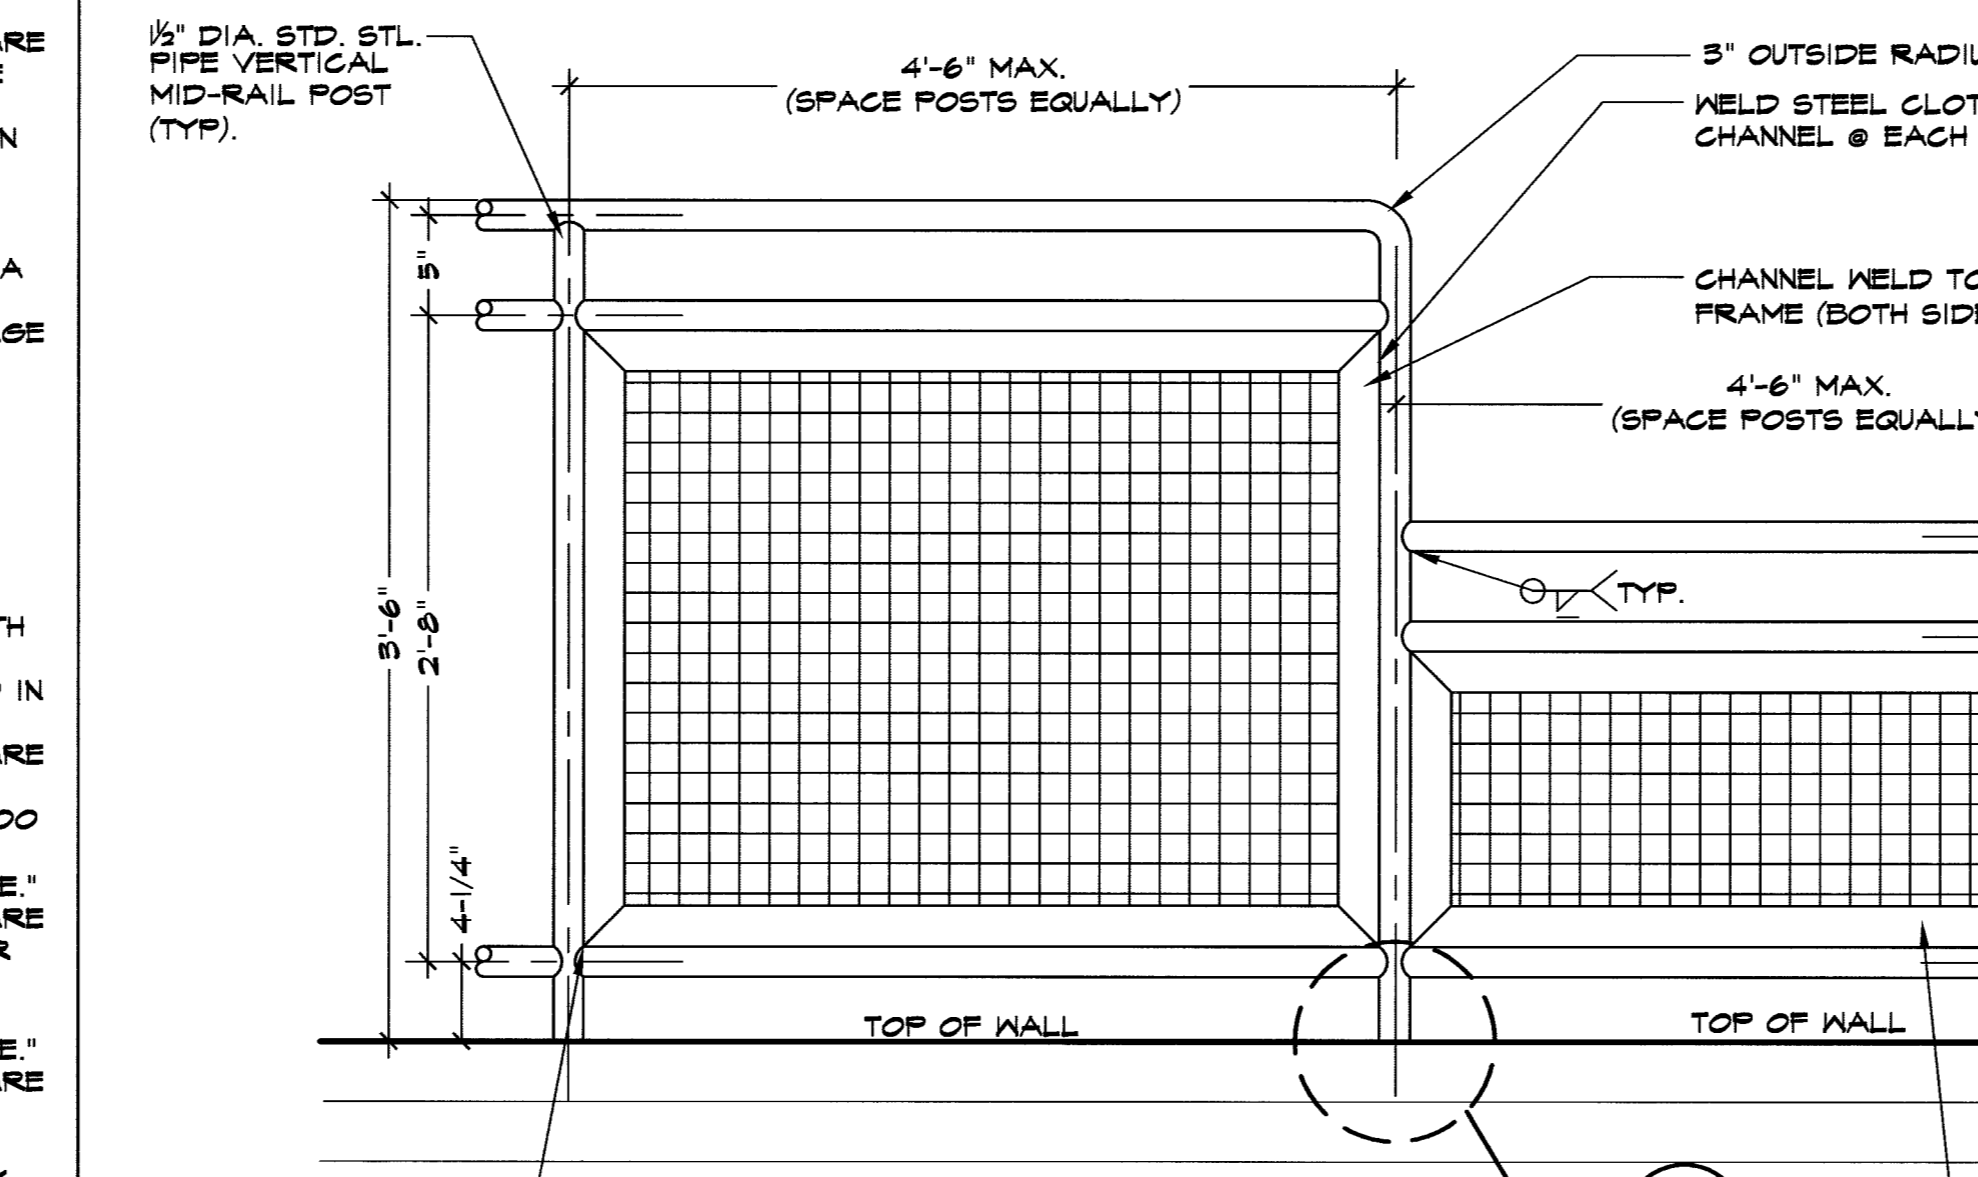

5 SAFETY RAIL/GUARDRAIL CONNECTION DETAIL
NTS

NOTES:
1. PRIME AND POWDERCOAT ALL GUARD RAILS AND SAFETY RAILS - SEE SPECS. SECTION 0552. COLOR: RAL 5004.
2. INSTALL ALL GUARD RAILS AND SAFETY RAILS PER SPEC. SECTION 0552.

SHOP DRAWING REQUIRED

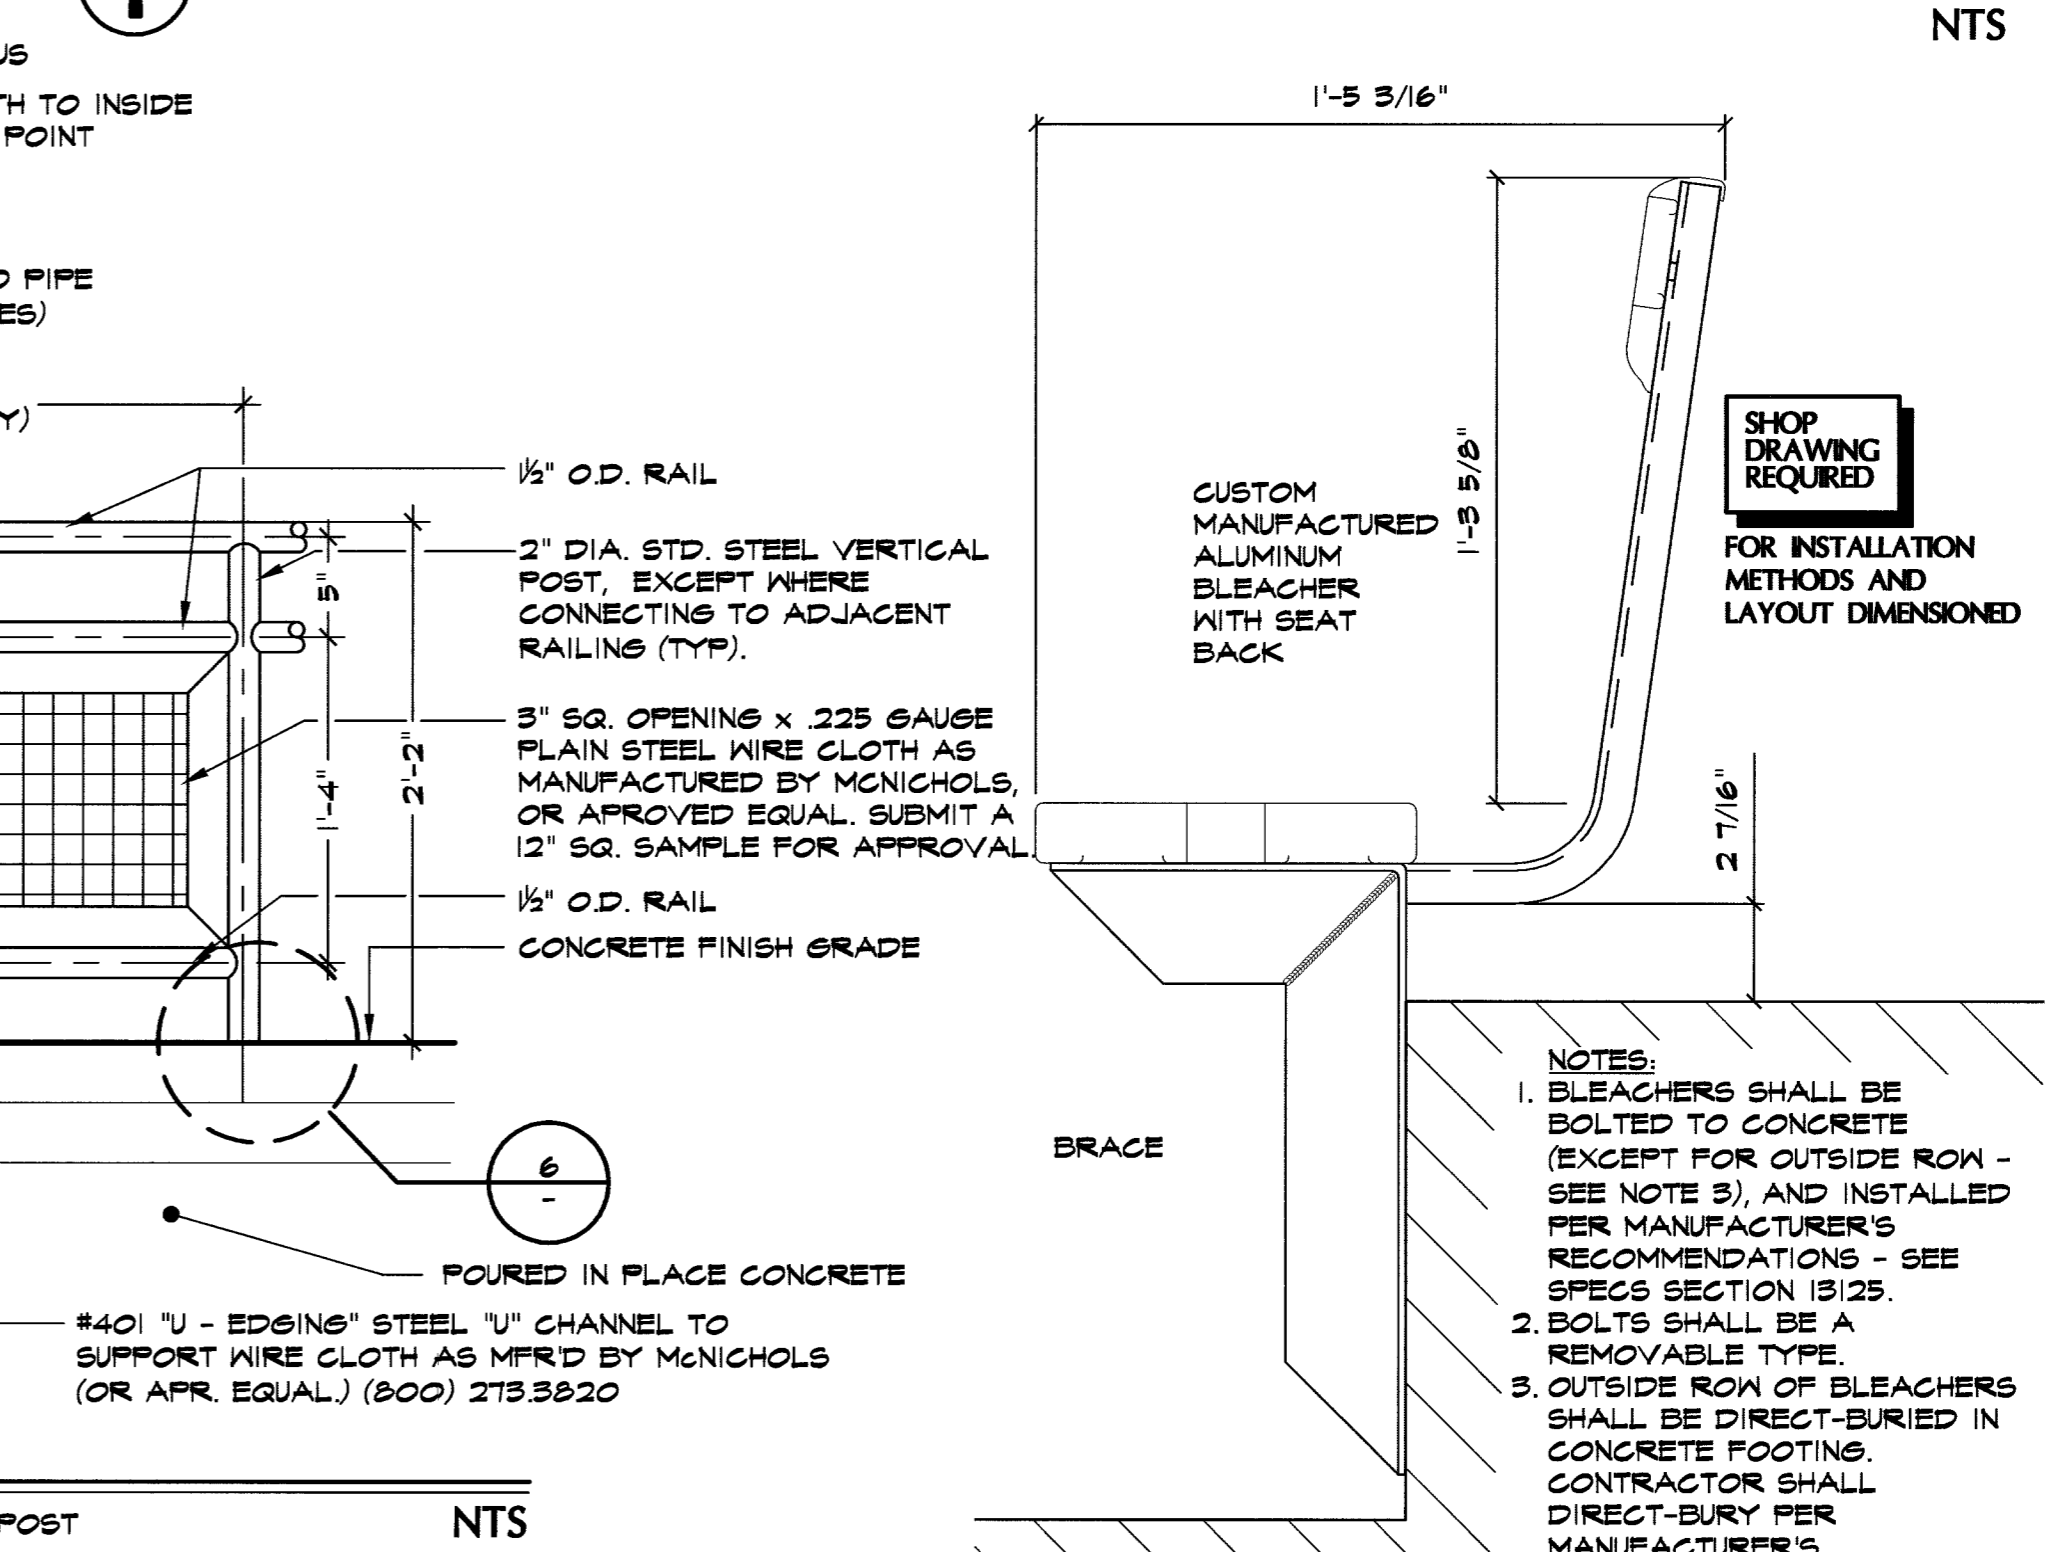


2 CHAMPIONSHIP TENNIS COURT BLEACHER DETAIL
NTS


NOTES:
1. BLEACHERS SHALL BE BOLTED TO CONCRETE (EXCEPT FOR OUTSIDE ROW - SEE NOTE 3), AND INSTALLED PER MANUFACTURER'S RECOMMENDATIONS - SEE SPECS SECTION 19125.
2. BOLTS SHALL BE A REMOVABLE TYPE.
3. OUTSIDE ROW OF BLEACHERS SHALL BE DIRECT-BURIED IN CONCRETE FOOTING. CONTRACTOR SHALL DIRECT-BURY PER MANUFACTURER'S RECOMMENDATIONS.

SHOP DRAWING REQUIRED


- CONTRACTOR SHALL PREPARE A SHOP DRAWING OF IMAGE ON WALL WITH DIMENSIONS AND NOTES. DRAWING SHOWN ILLUSTRATES DESIGN INTENT OF IMAGE (TYPICAL).
- AFTER APPROVALS, CONTRACTOR SHALL MAKE A FULL SIZE TEMPLATE OF IMAGE OR MAY OUTLINE IMAGE ON WALL IN FIELD FOR REVIEW BY CONSTRUCTION PROJECT REPRESENTATIVE (TYPICAL).
- ALL IMAGES SHALL BE ROUTED (RECESSED) 1" BELOW FINISH SURFACE OF WALL. ALL EDGES AND SURFACES SHALL BE SMOOTH AND CLEAN. ANY SPAULED EDGES SHALL BE REPAIRED IN KIND.
- CONTRACTOR SHALL PREPARE SURFACE OF IMAGE FOR PAINTING PER SECTION 09900 (TYPICAL). COLOR: IC1 MPR#08615/191 "BANNER BLUE."
- CONTRACTOR SHALL PREPARE REVEALS FOR PAINTING PER SPECS SECTION 09900 (TYPICAL). COLOR: IC1 MPR#08615/191 "BANNER BLUE."
- CONTRACTOR SHALL PREPARE WALL FOR PAINTING PER SPECS SECTION 09900 (TYPICAL). COLOR: IC1 20YY 41/165, "CAMEL TAN."

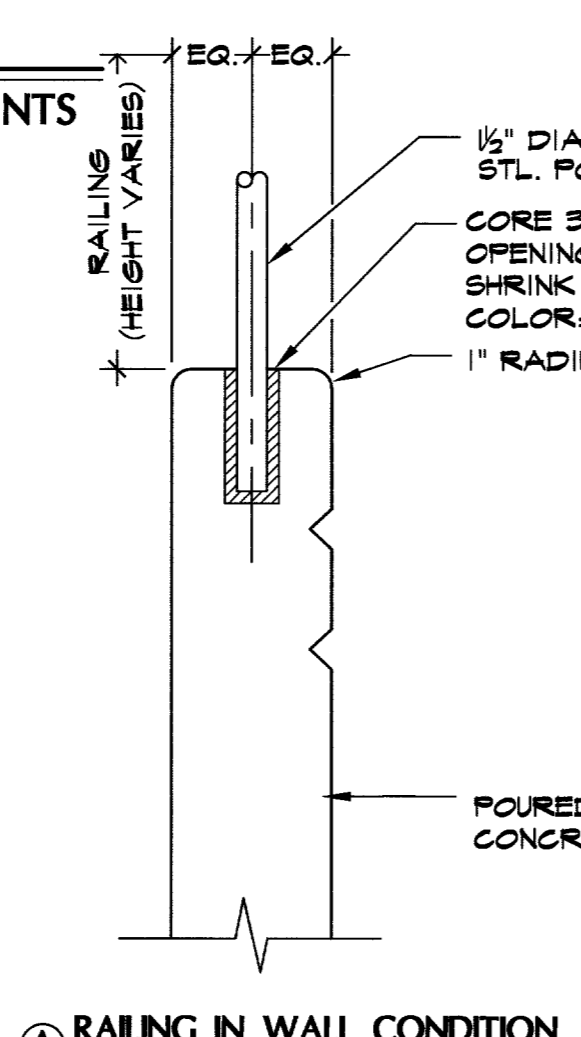

A RAILING IN WALL CONDITION

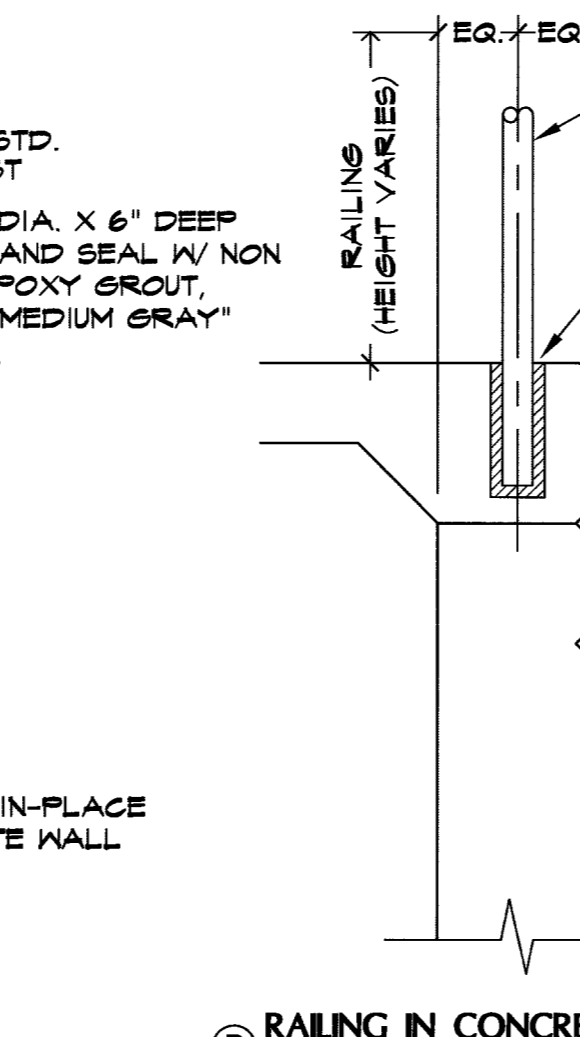


B RAILING IN CONCRETE AND WALL CONDITION

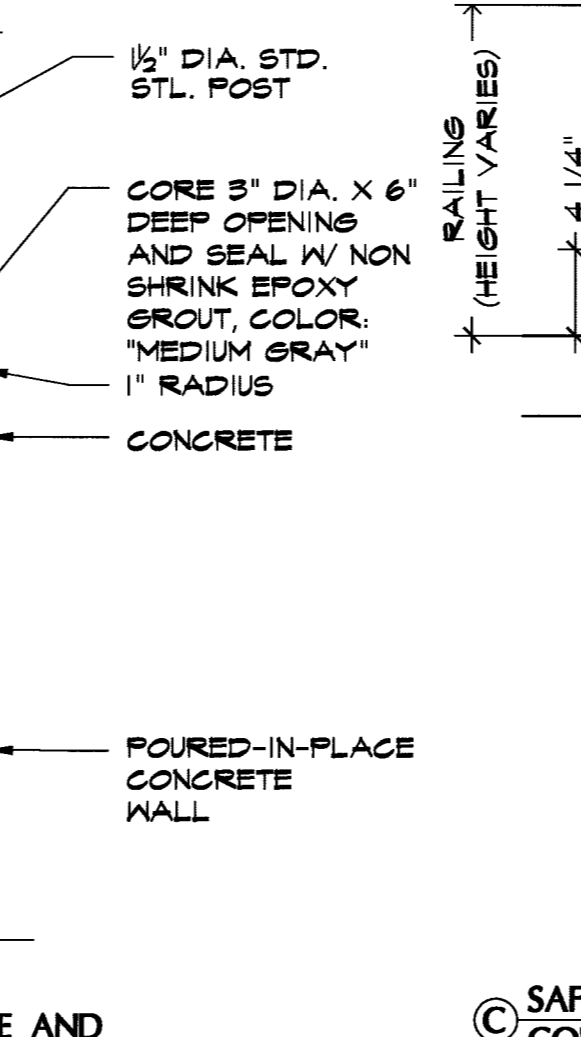

C SAFETY RAILING AT CHAMPIONSHIP COURT CONDITION

6 CHAMPIONSHIP TENNIS COURT RAILING IN WALL CONDITION
NTS

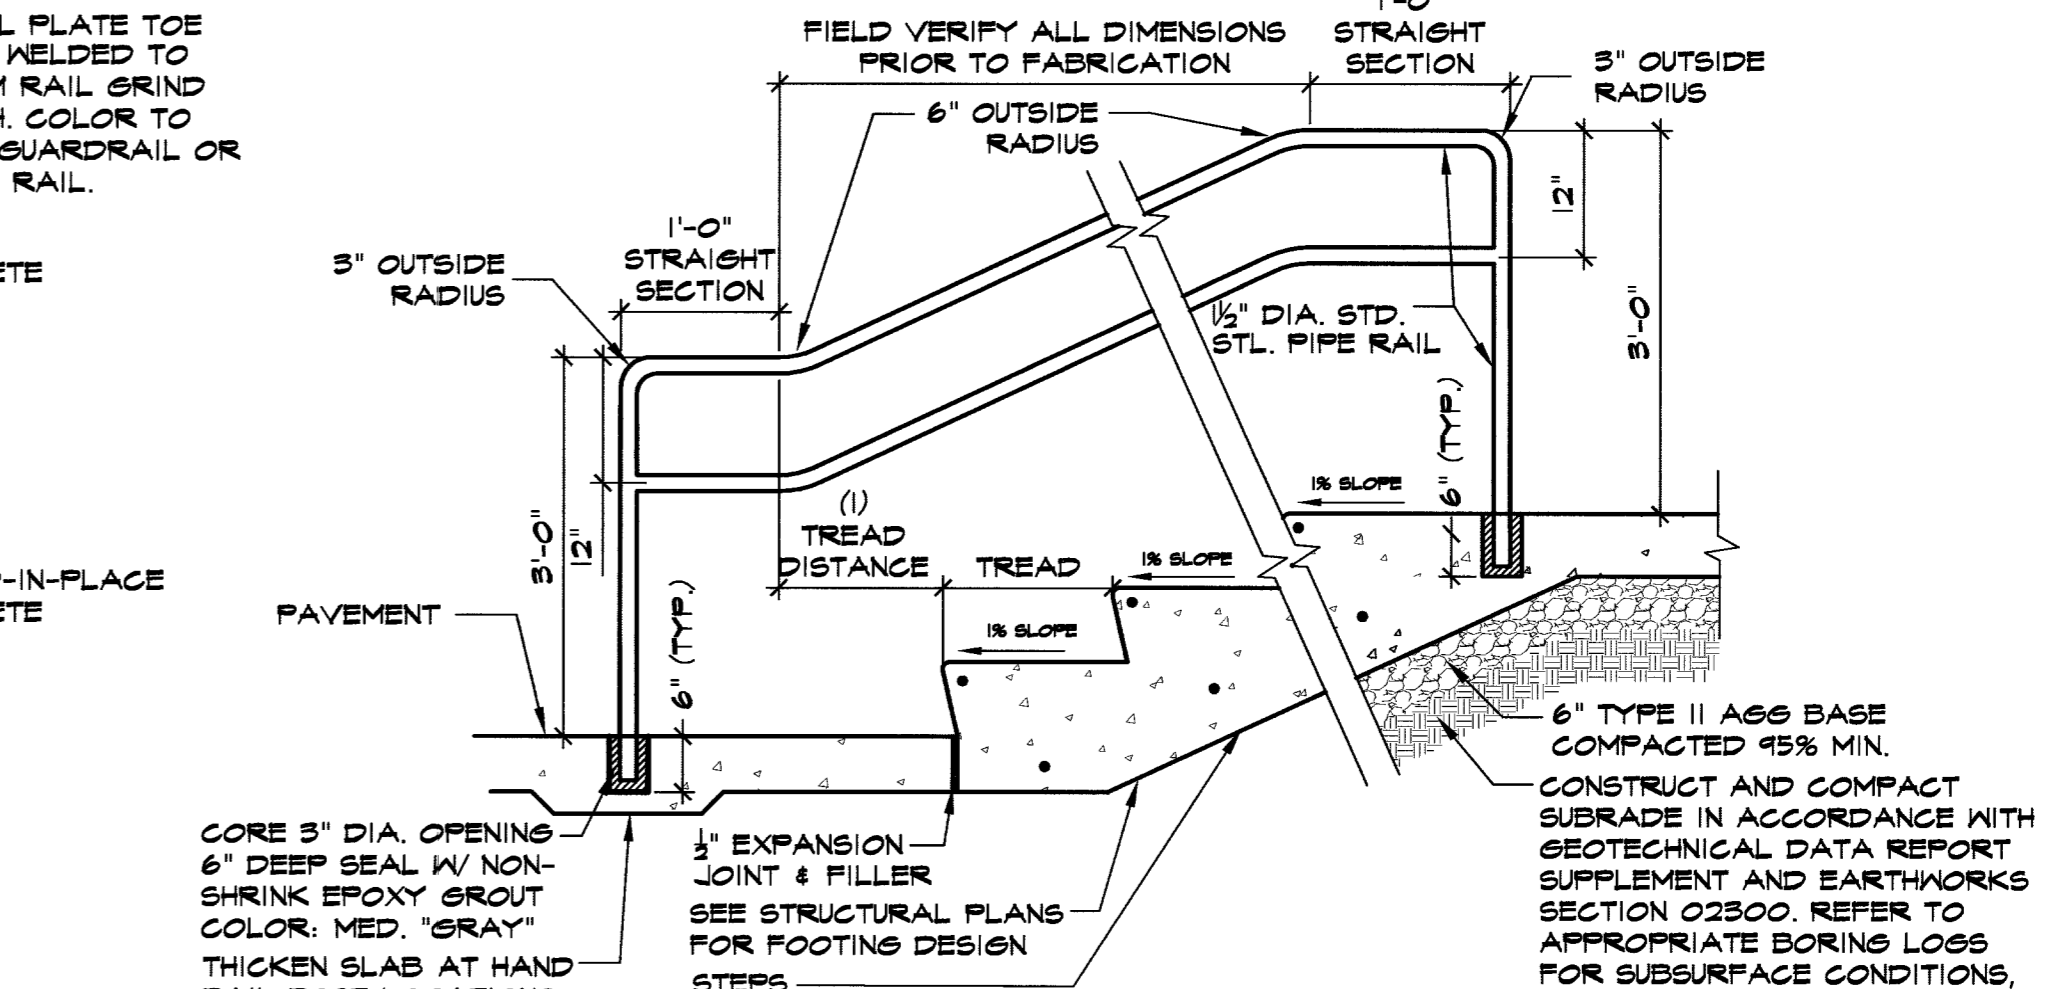

3 CONCRETE STEP / HANDRAIL DETAIL
NTS



REVISIONS
1/19/06
RECORD DRAWINGS

CONSULTANT
7251 W. CHARLESTON BLVD.
LAS VEGAS, NEVADA 89117
PHONE (702) 258-0115
FAX (702) 869-8547

Stantec

WASHINGTON BUFFALO PARK - PHASE 1A
WASHINGTON & BUFFALO, LAS VEGAS, NV

SITE DETAILS

STAMP
RECORD DOCUMENTS ARE PREPARED FROM DATA AND INFORMATION SUPPLIED BY OTHERS. STANTEC CONSULTING, INC. DOES NOT CERTIFY, NOR WARRANT IN ANY MANNER, THE ACCURACY OR COMPLETENESS OF RECORD DOCUMENTS. STANTEC CONSULTING, INC. ADVISES ANYONE USING RECORD DOCUMENTS, FOR ANY PURPOSE, TO INDEPENDENTLY VERIFY THE ACCURACY OR COMPLETENESS OF THE INFORMATION PRESENTED, AND TO VERIFY THE SUITABILITY OF THE INFORMATION FOR THE PURPOSE FOR WHICH THEY INTEND TO USE THE INFORMATION. STANTEC CONSULTING, INC. SHALL NOT BE RESPONSIBLE FOR ANY PROBLEMS, DISCREPANCIES OR RELATED COSTS THAT MAY ARISE OUT OF THE USE OF RECORD DOCUMENTS.

OWNER: CITY OF LAS VEGAS
DEPARTMENT OF PUBLIC WORKS
ARCHITECTURAL SERVICES

400 EAST STEWART AVENUE
LAS VEGAS, NEVADA 89101
PHONE (702) 225-6535
FAX (702) 382-3232
TDD (702) 386-9108

DRAWN	IKIC
FILE	21665D-10d1g
DATE	1/03
SCALE	NTS
SIT NO	03.15341.02
CONTRACT NO	65076-1A
SHT NO	100% SUBMITTAL

SD-11