

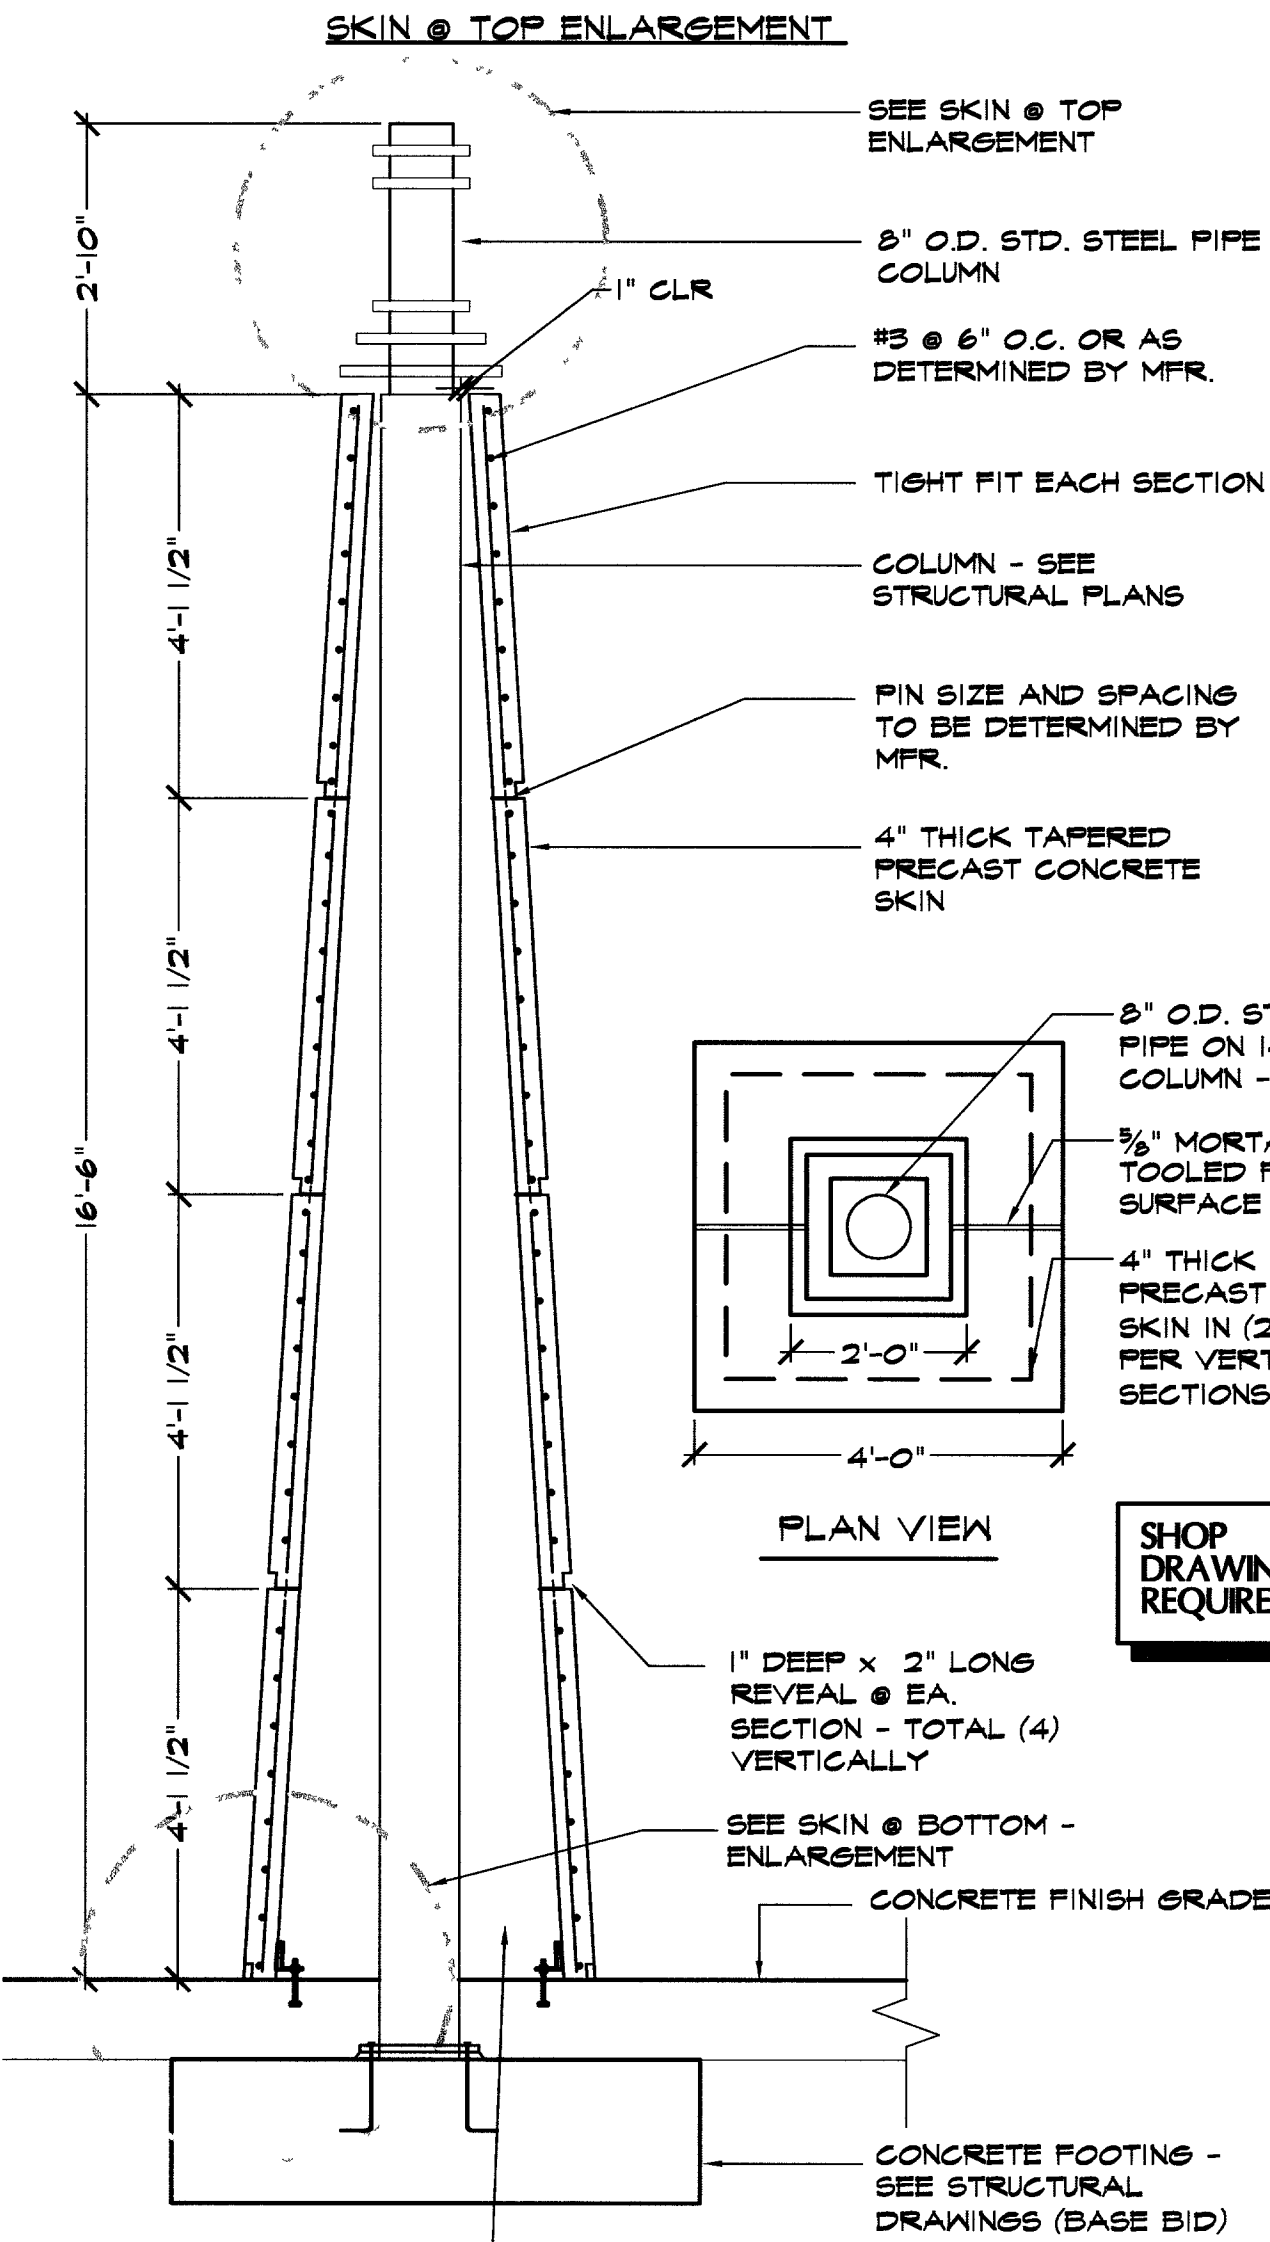


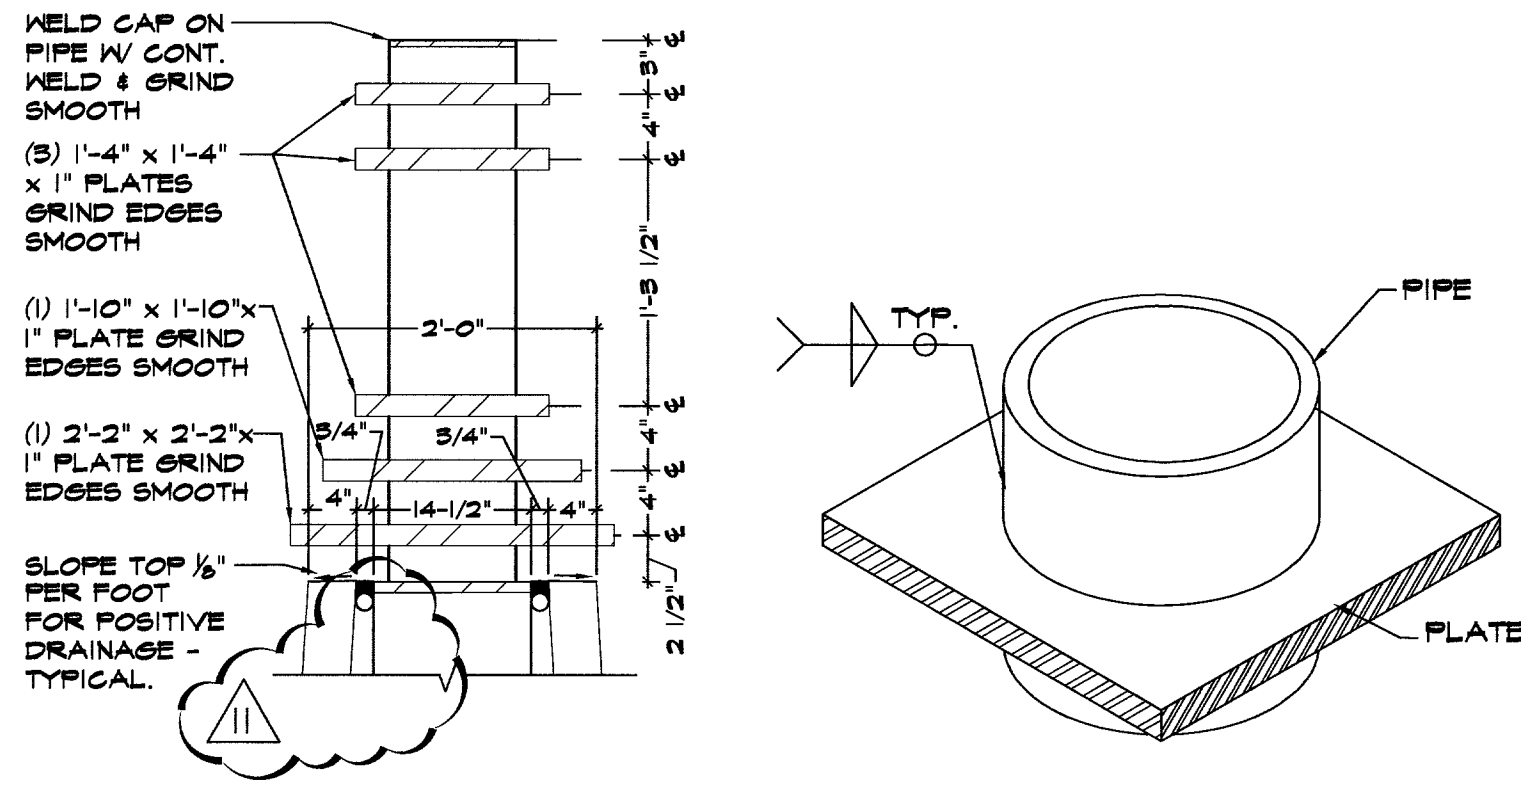

6 SHADE TRELLIS COLUMN DETAIL (ADDITIVE ALTERNATE #2)

DEFERRED SUBMITTAL REQUIREMENT FOR FABRIC AND FABRIC ATTACHMENT ONLY
THESE DRAWINGS REPRESENT DESIGN INTENT ONLY. UPON PRELIMINARY APPROVAL OF SHOP DRAWINGS, CONTRACTOR SHALL SUPPLY FROM PREFAB. FABRIC MFR. DRAWINGS AND STRUCTURAL CALCULATIONS, INCLUDING MATERIALS AND CONNECTIONS. WET-SEALED AND SIGNED BY A NEVADA REGISTERED PROFESSIONAL ENGINEER. CONTRACTOR TO SUBMIT TO THE CITY BUILDING DEPARTMENT FOR REVIEW AND APPROVAL BEFORE PERMITS AND INSPECTIONS CAN BE SCHEDULED. (MIN. 3 COPIES TO BUILDING DEPT.)

CONTRACTOR SHALL SUBMIT SHOP DRAWINGS, CALCULATIONS AND MEANS AND METHODS FOR INSTALLATION OF FABRIC PANEL TO TRELLIS - SEE SPEC. SECTION 13015


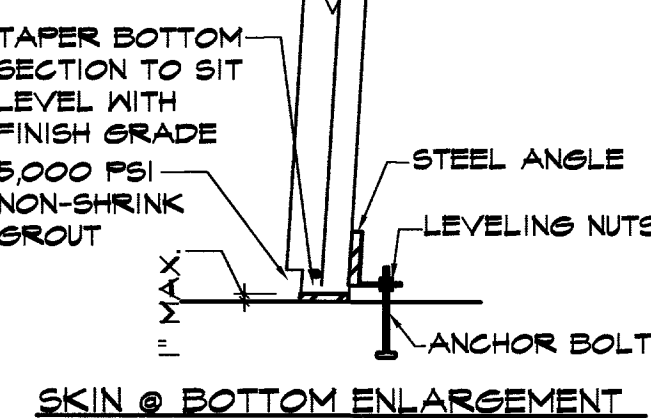


DEFERRED SUBMITTAL REQUIREMENT FOR CONCRETE SKIN
THESE DRAWINGS REPRESENT DESIGN INTENT ONLY. UPON PRELIMINARY APPROVAL OF SHOP DRAWINGS, CONTRACTOR SHALL SUPPLY FROM PREFAB. SKIN MFR. DRAWINGS AND STRUCTURAL CALCULATIONS, INCLUDING MATERIALS AND CONNECTIONS. WET-SEALED AND SIGNED BY A NEVADA REGISTERED PROFESSIONAL ENGINEER. CONTRACTOR TO SUBMIT TO THE CITY BUILDING DEPARTMENT FOR REVIEW AND APPROVAL BEFORE PERMITS AND INSPECTIONS CAN BE SCHEDULED. (MIN. 3 COPIES TO BUILDING DEPT.)


NOTE:
THIS DETAIL SHOWING LEVELING DEVICES IS SUGGESTIVE ONLY. DEPENDING ON AT & SHOP DWGS. PREPARED BY MFR. OTHER MEANS FOR SECURING SKINS LEVEL WITH POSTS FOR UNEVEN PAVEMENT MAY BE PROPOSED.

5 CHAMPIONSHIP TENNIS COURT SHADE TRELLIS SIDE ELEVATION (ADDITIVE ALTERNATE #2)


- NOTES:
1. PRECAST CONCRETE SKINS SHALL BE FABRICATED IN A MINIMUM OF (2) SECTIONS AND A MAXIMUM OF (4) SECTIONS PER VERTICAL SEAM SECTION, USING A HIGH-STRENGTH CONCRETE MIX DESIGN RECOMMENDED BY MFR.
 2. PRECAST CONCRETE SKINS SHALL BE FABRICATED IN EQUAL SECTIONS. BOTTOM SECTION SHALL SIT ON A LEVEL CONCRETE SLAB. CAULK ANY GAPS BETWEEN SKIN AND FINISH GRADE, MATCHING SKIN COLOR.
 3. CAULK SHALL NOT BE CONTINUOUS TO INSURE POSITIVE DRAINAGE FROM WITHIN.
 4. SKIN SURFACE SHALL HAVE A SMOOTH FINISH.
 5. SKIN SHALL BE PRIMED AND PAINTED (1) 20YY 41N65 OR APPROVED EQUAL.
 6. SKINS SHALL BE FABRICATED BY EITHER:
A. MAUSAU, TEL. 800-231-4865
B. QUICKCRETE, TEL. 904-757-6240, OR
C. APPROVED EQUAL
 7. ALL METAL SHALL BE POWDER COATED COLOR: RAL 5009. CONTRACTOR SHALL COORDINATE ALL WORK WITH ALL TRADES. VERIFY ALL DIMENSIONS PRIOR TO FABRICATION. SHOP DRAWINGS REQUIRED.

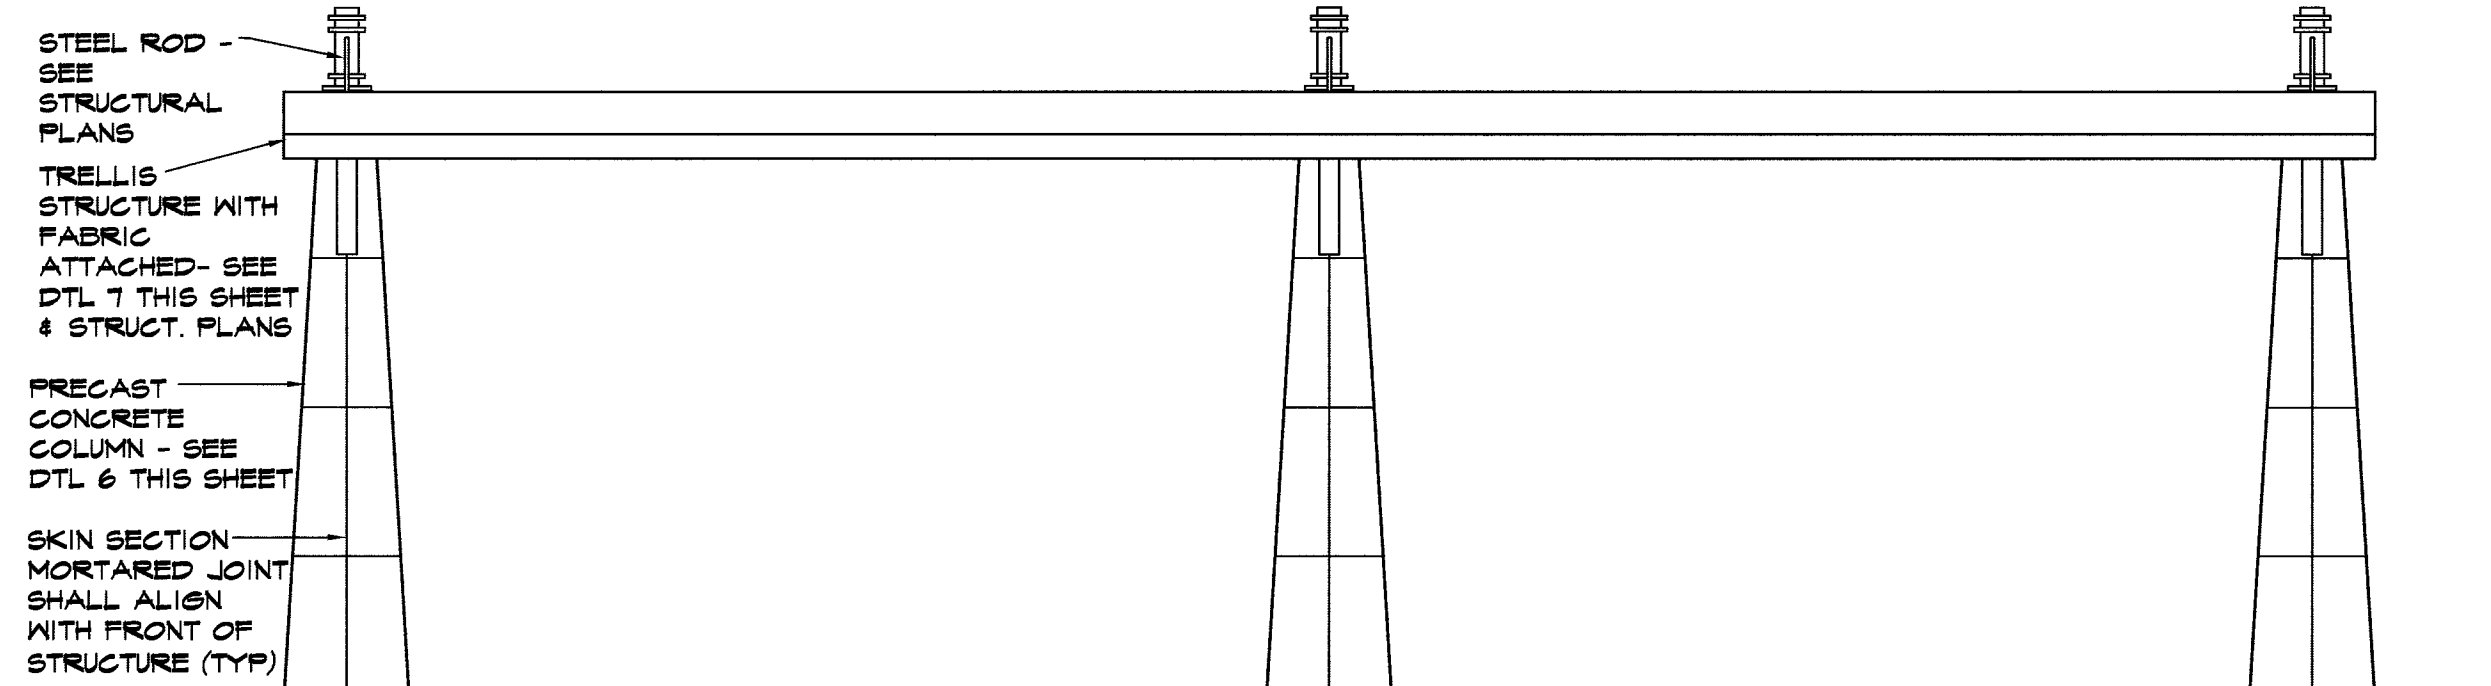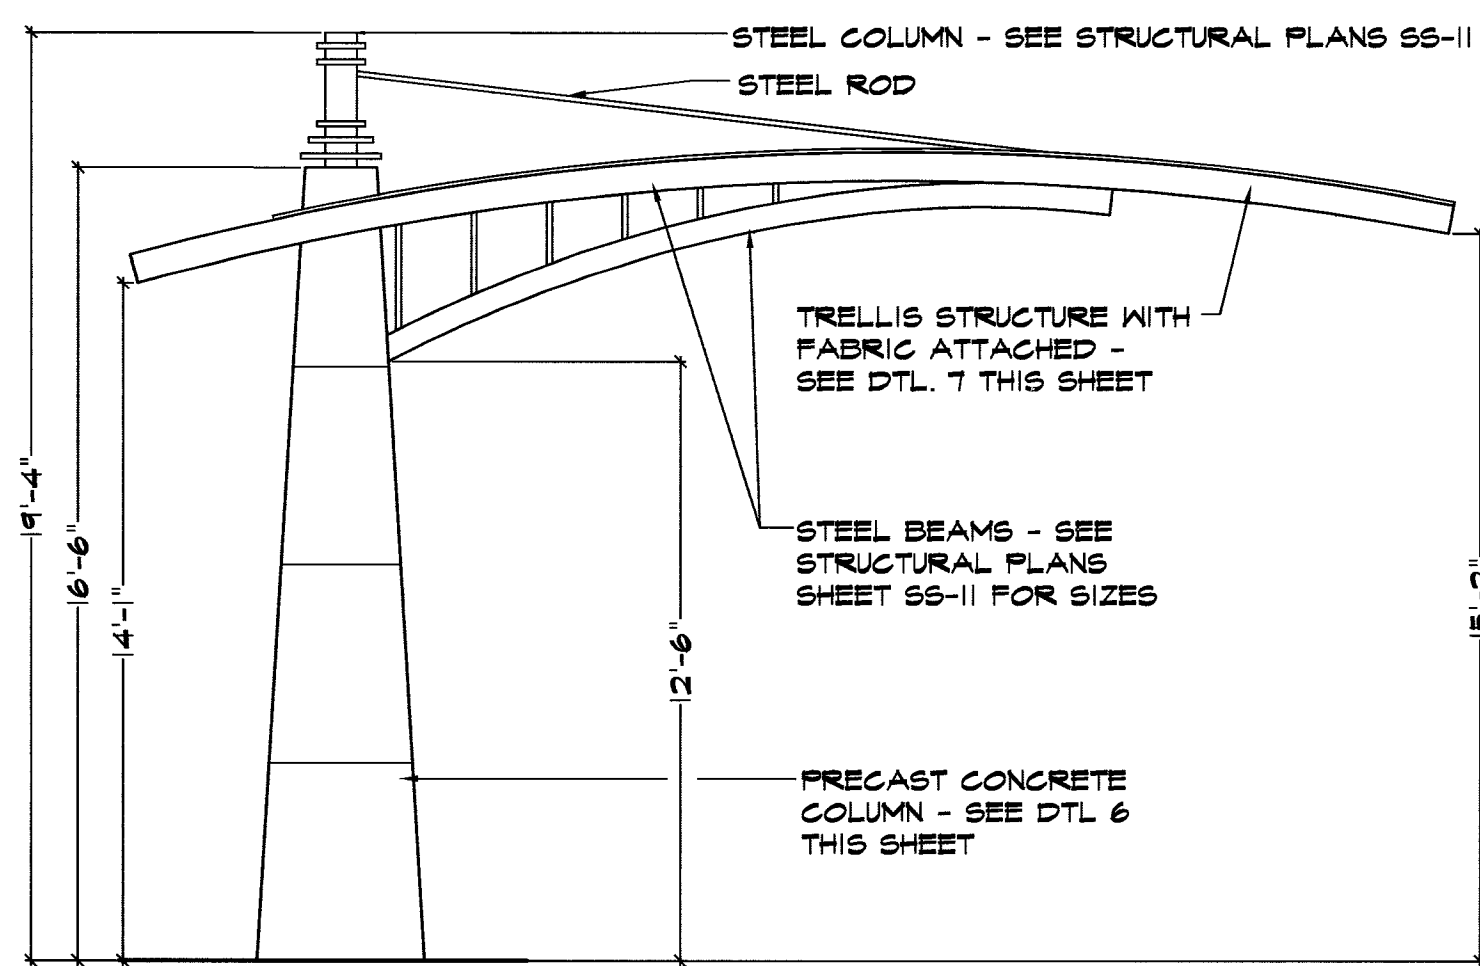


1 CHAMPIONSHIP TENNIS COURT SHADE TRELLIS NORTH/SOUTH ELEVATION

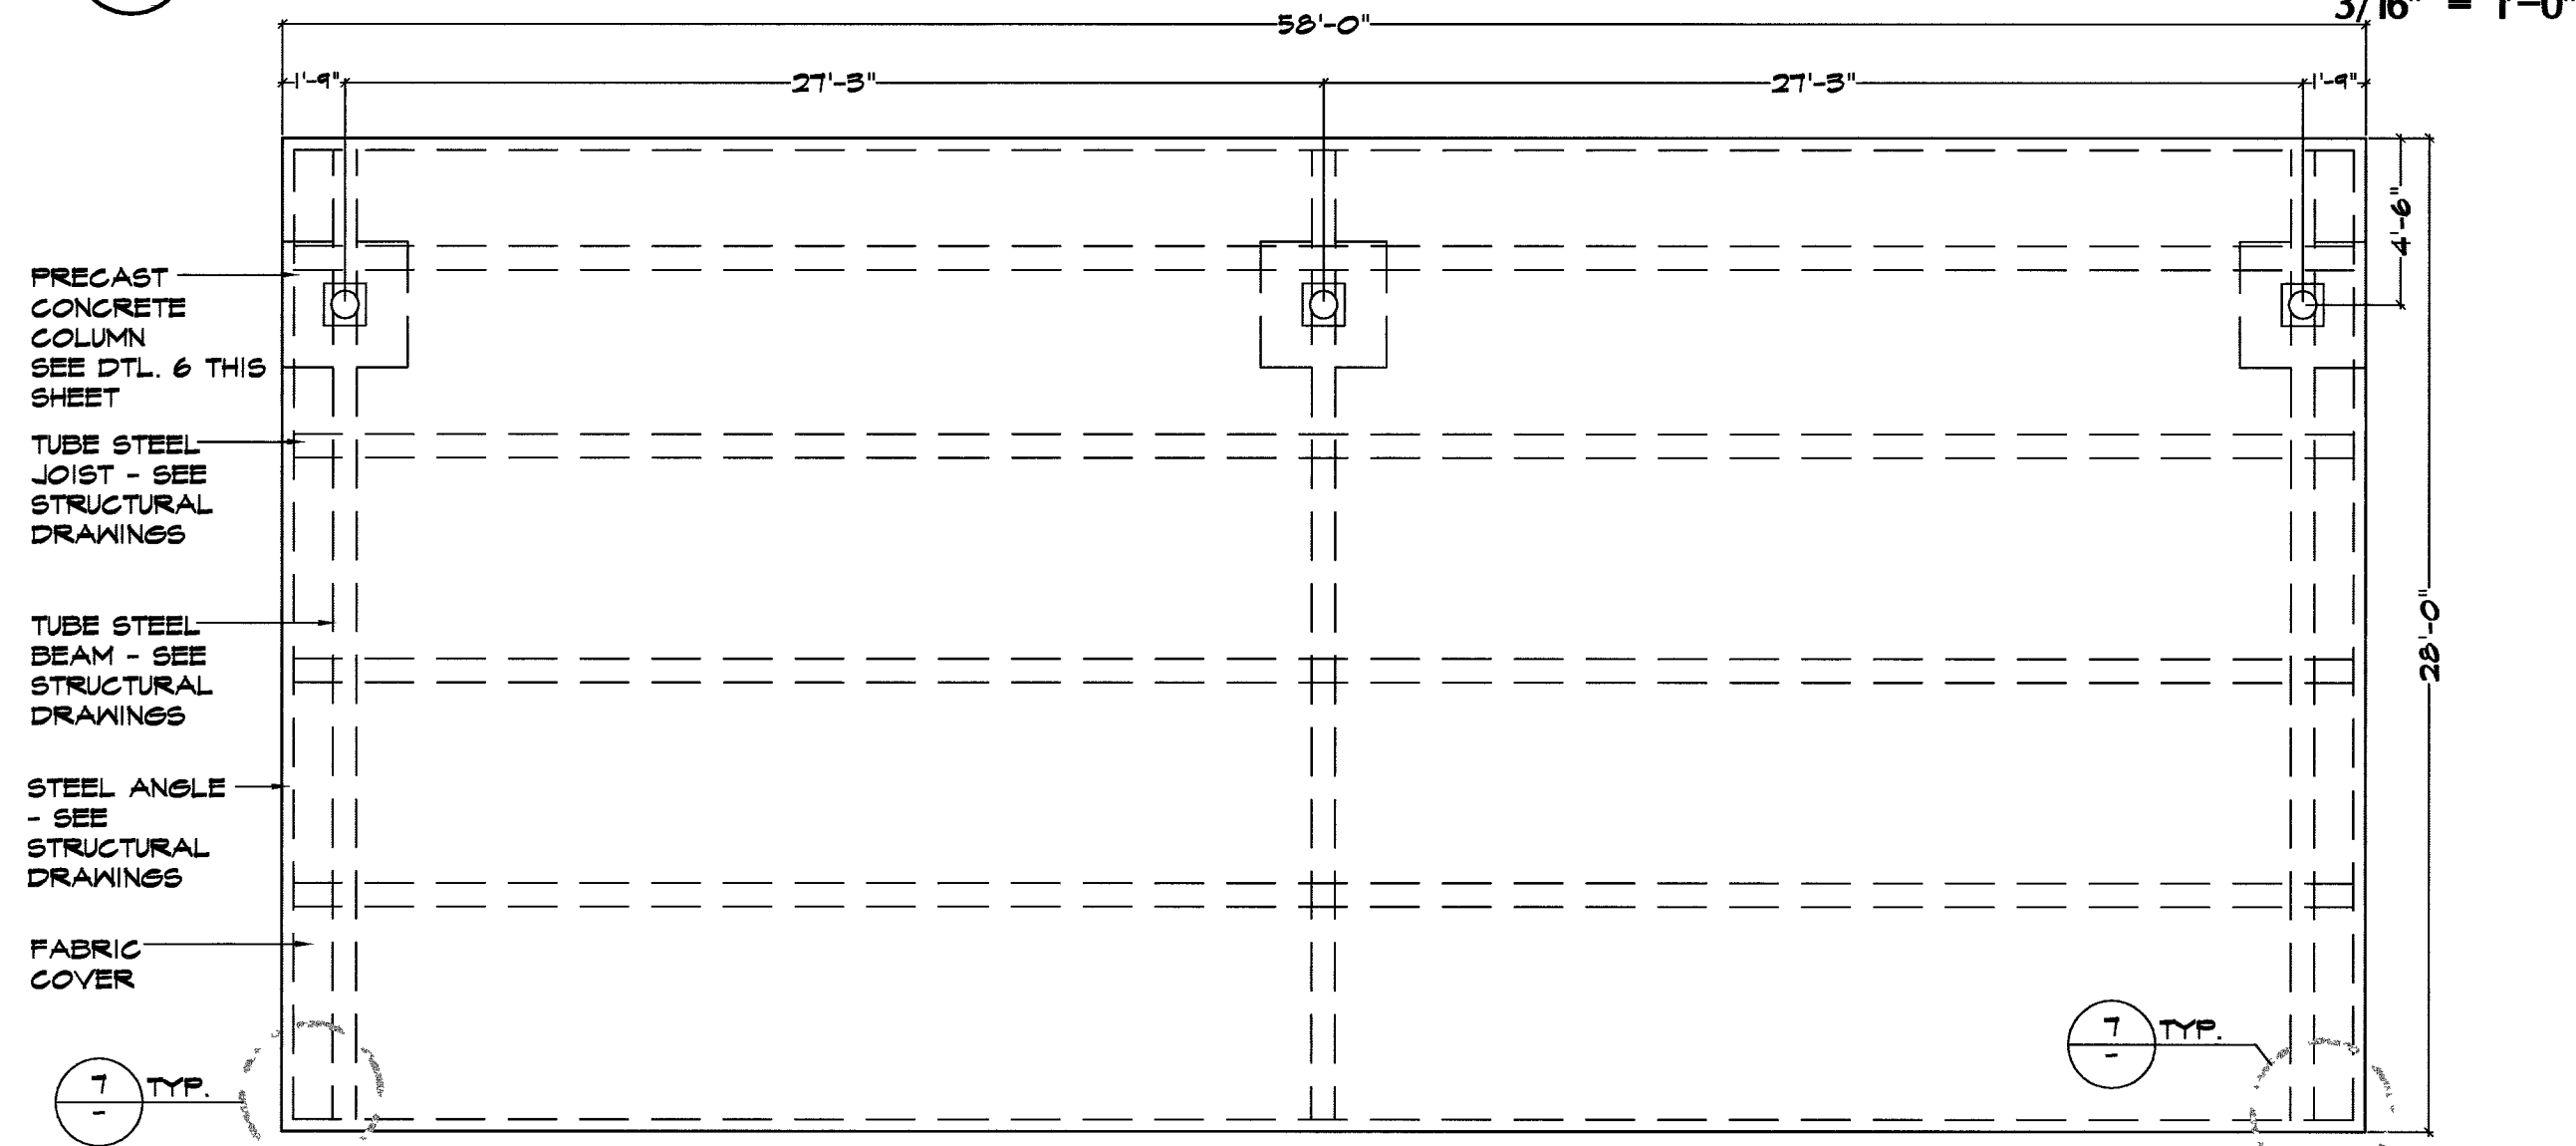


2 CHAMPIONSHIP TENNIS COURT SHADE TRELLIS NORTH/SOUTH PLAN VIEW (ADDITIVE ALTERNATE #2)

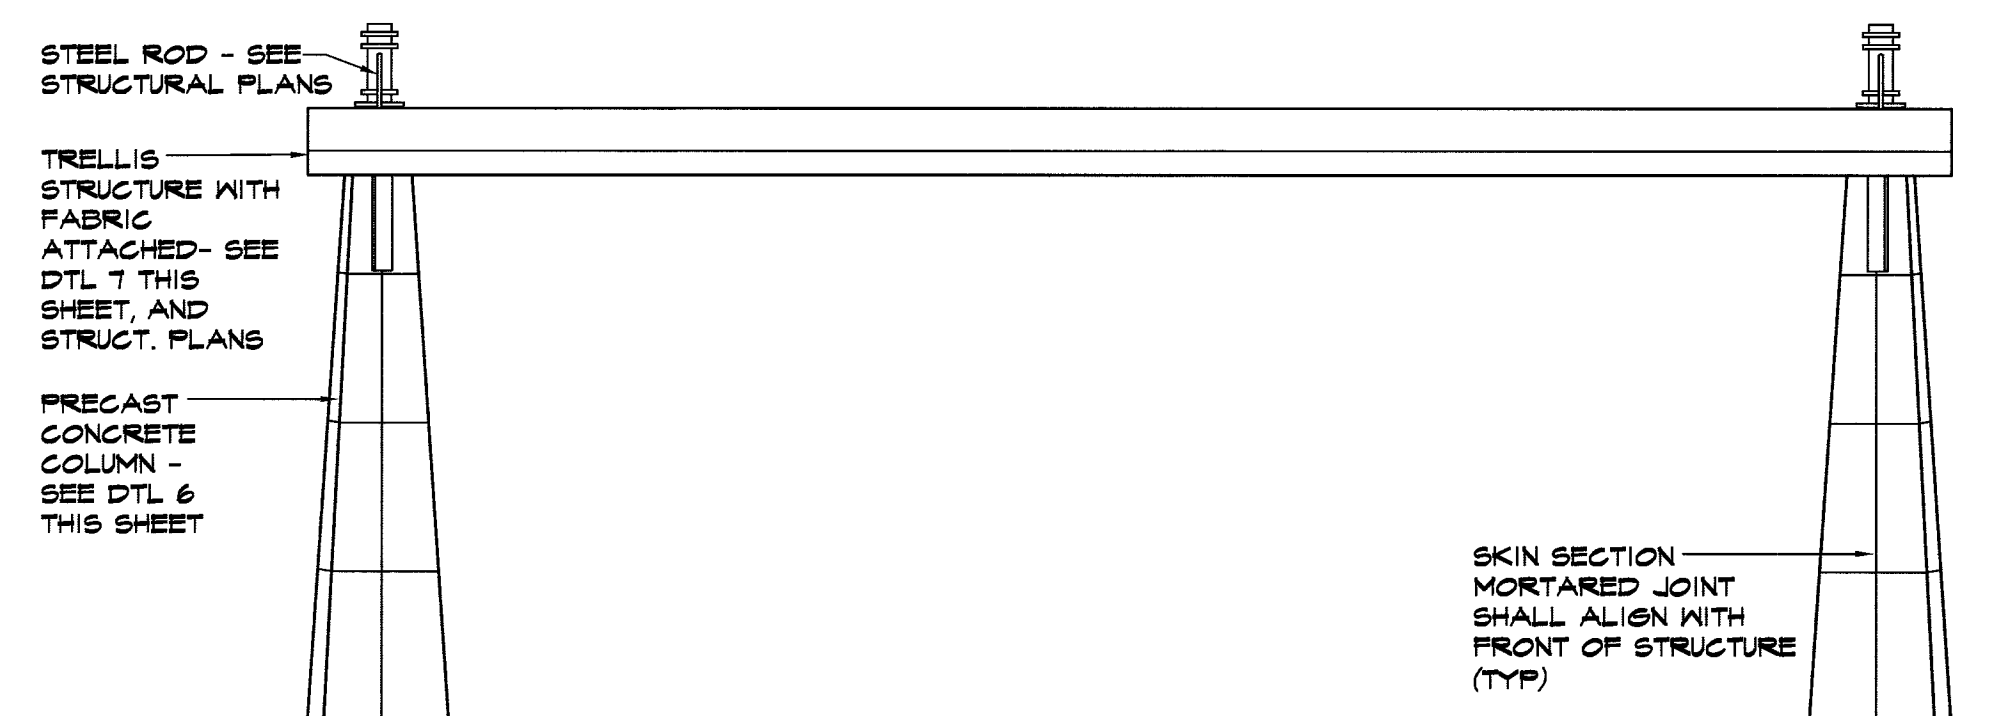

3 CHAMPIONSHIP TENNIS COURT SHADE TRELLIS EAST/WEST ELEVATION (ADDITIVE ALTERNATE #2)

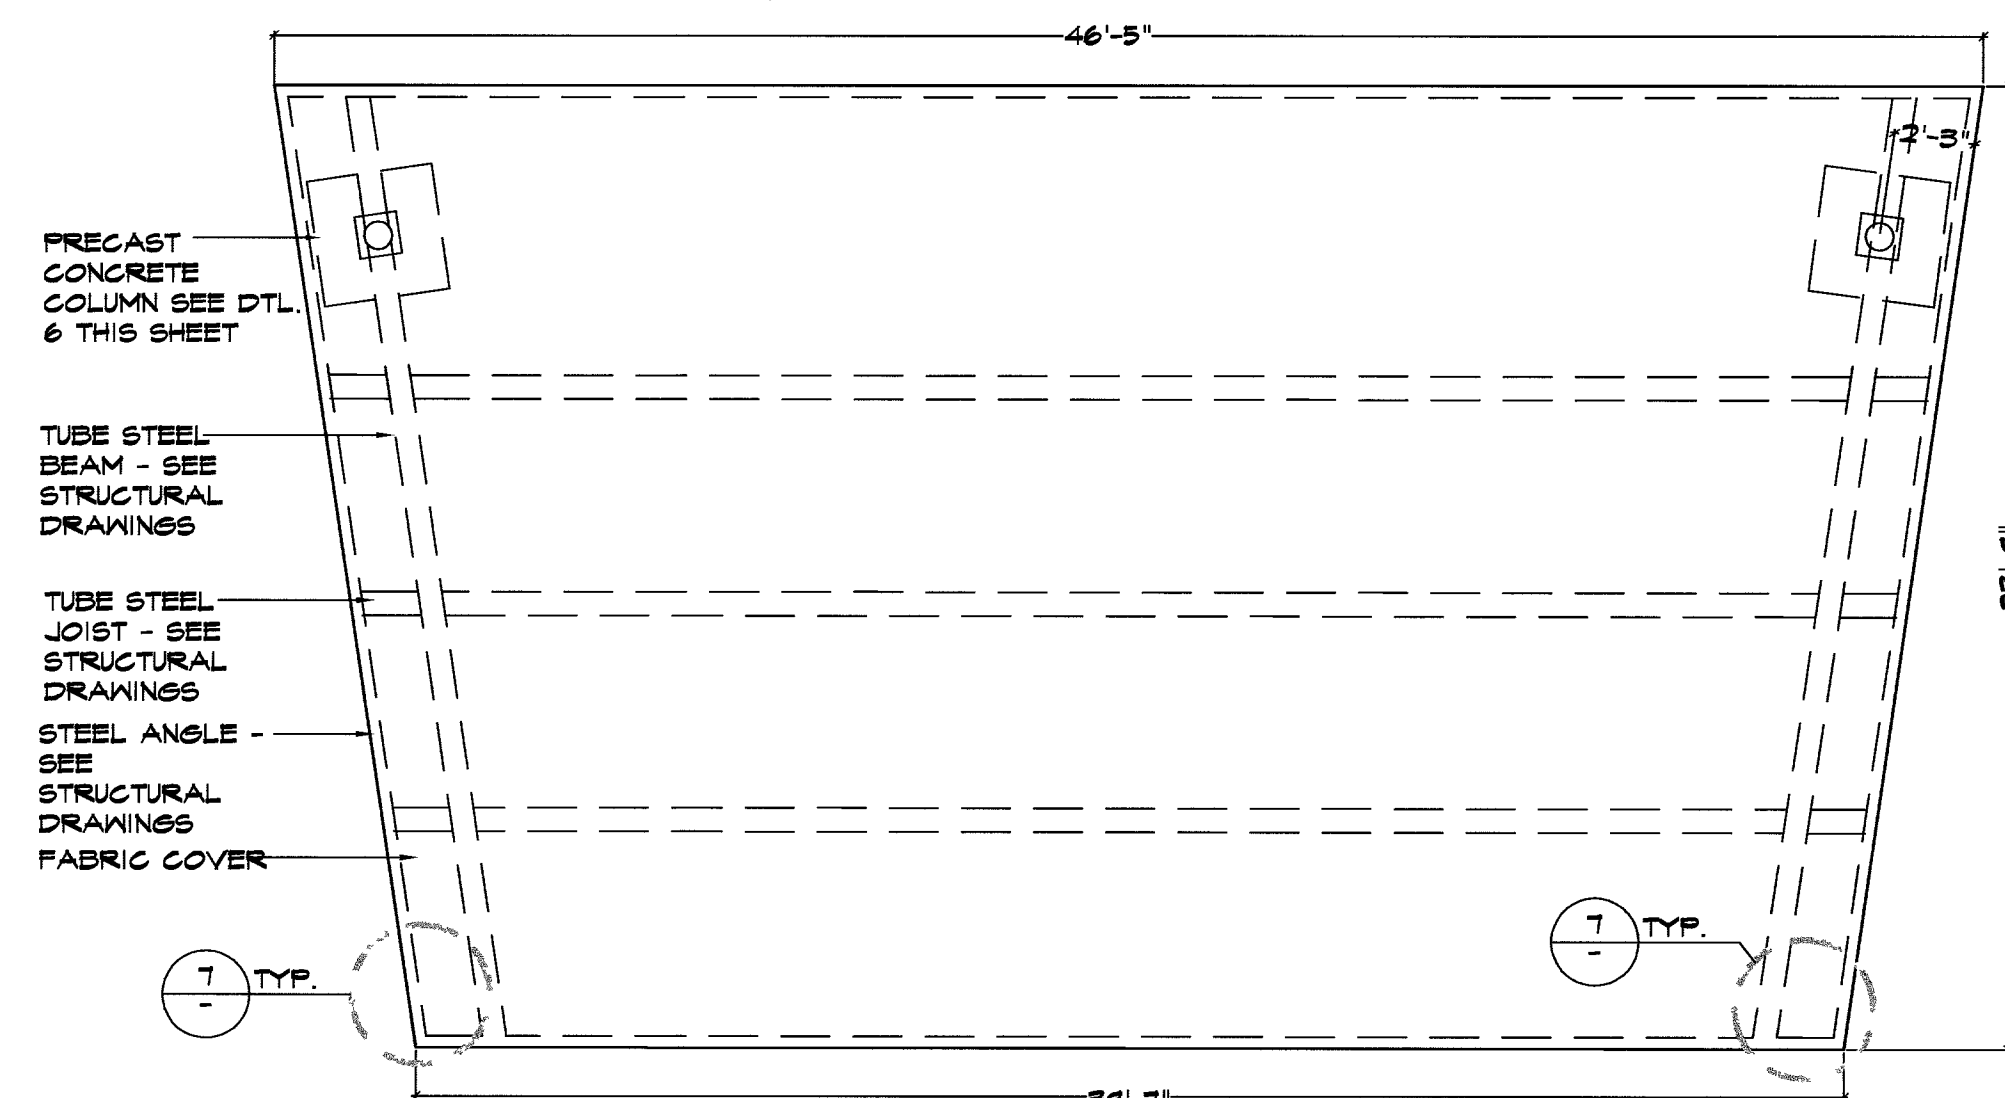

7 SHADE TRELLIS FABRIC ATTACHMENT DETAIL (ADDITIVE ALT. #2)

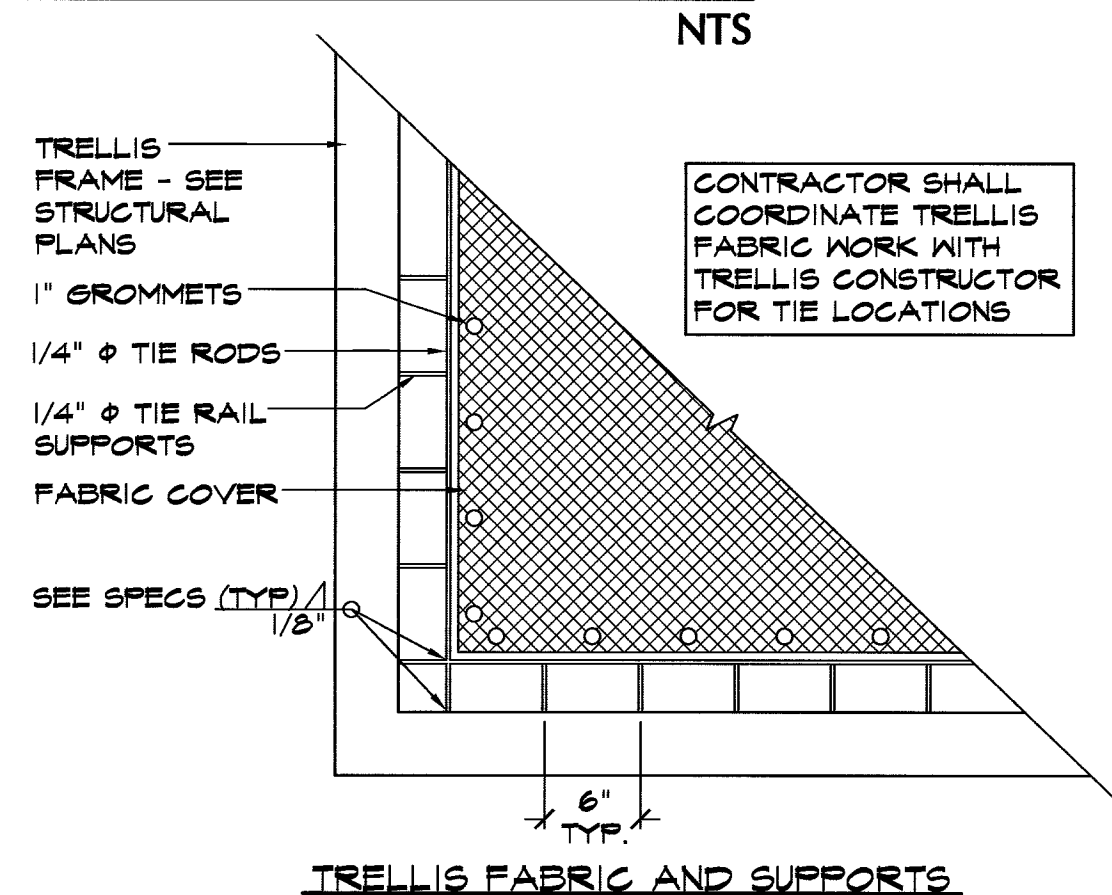

4 CHAMPIONSHIP TENNIS COURT SHADE TRELLIS EAST/WEST PLAN VIEW (ADDITIVE ALTERNATE #2)

RECORD DRAWING (01/19/06)



REVISIONS 19/06 RECORD DRAWINGS

CONSULTANT
7251 W. CHARLESTON BLVD.
LAS VEGAS, NEVADA 89117
PHONE (702) 258-0115
FAX (702) 869-8547
Stantec

WASHINGTON BUFFALO PARK - PHASE 1A
WASHINGTON & BUFFALO, LAS VEGAS, NV

SITE DETAILS

STAMP
RECORD DOCUMENTS ARE PREPARED FROM DATA AND INFORMATION SUPPLIED BY OTHERS. STANTEC CONSULTING, INC. DOES NOT CERTIFY, NOR WARRANT IN ANY MANNER, THE ACCURACY OR COMPLETENESS OF RECORD DOCUMENTS. STANTEC CONSULTING, INC. ADVISES ANYONE USING RECORD DOCUMENTS, FOR ANY PURPOSE, TO INDEPENDENTLY VERIFY THE ACCURACY OR COMPLETENESS OF THE INFORMATION PRESENTED, AND TO VERIFY THE SUITABILITY OF THE INFORMATION FOR THE PURPOSE FOR WHICH THEY INTEND TO USE THE INFORMATION. STANTEC CONSULTING, INC. SHALL NOT BE RESPONSIBLE FOR ANY PROBLEMS, DISCREPANCIES OR RELATED COSTS THAT MAY ARISE OUT OF THE USE OF RECORD DOCUMENTS.

OWNER: CITY OF LAS VEGAS
DEPARTMENT OF PUBLIC WORKS
ARCHITECTURAL SERVICES

400 EAST STEWART AVENUE
LAS VEGAS, NEVADA 89101
PHONE: (702) 229-8535
FAX: (702) 382-3232
TDD: (702) 386-9108

DRAWN: KUC
FILE: 210650-12.dwg
DATE: 1/03
SCALE: NTS
BID NO: 03534108
CLDWG NO: 65016-1A
100% SUBMITTAL

SD-12

96977