
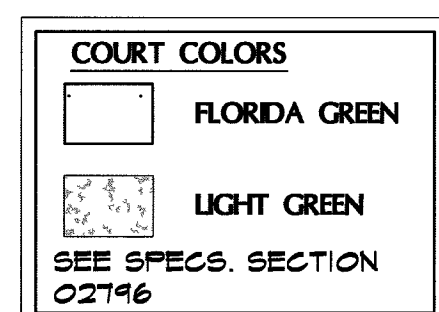
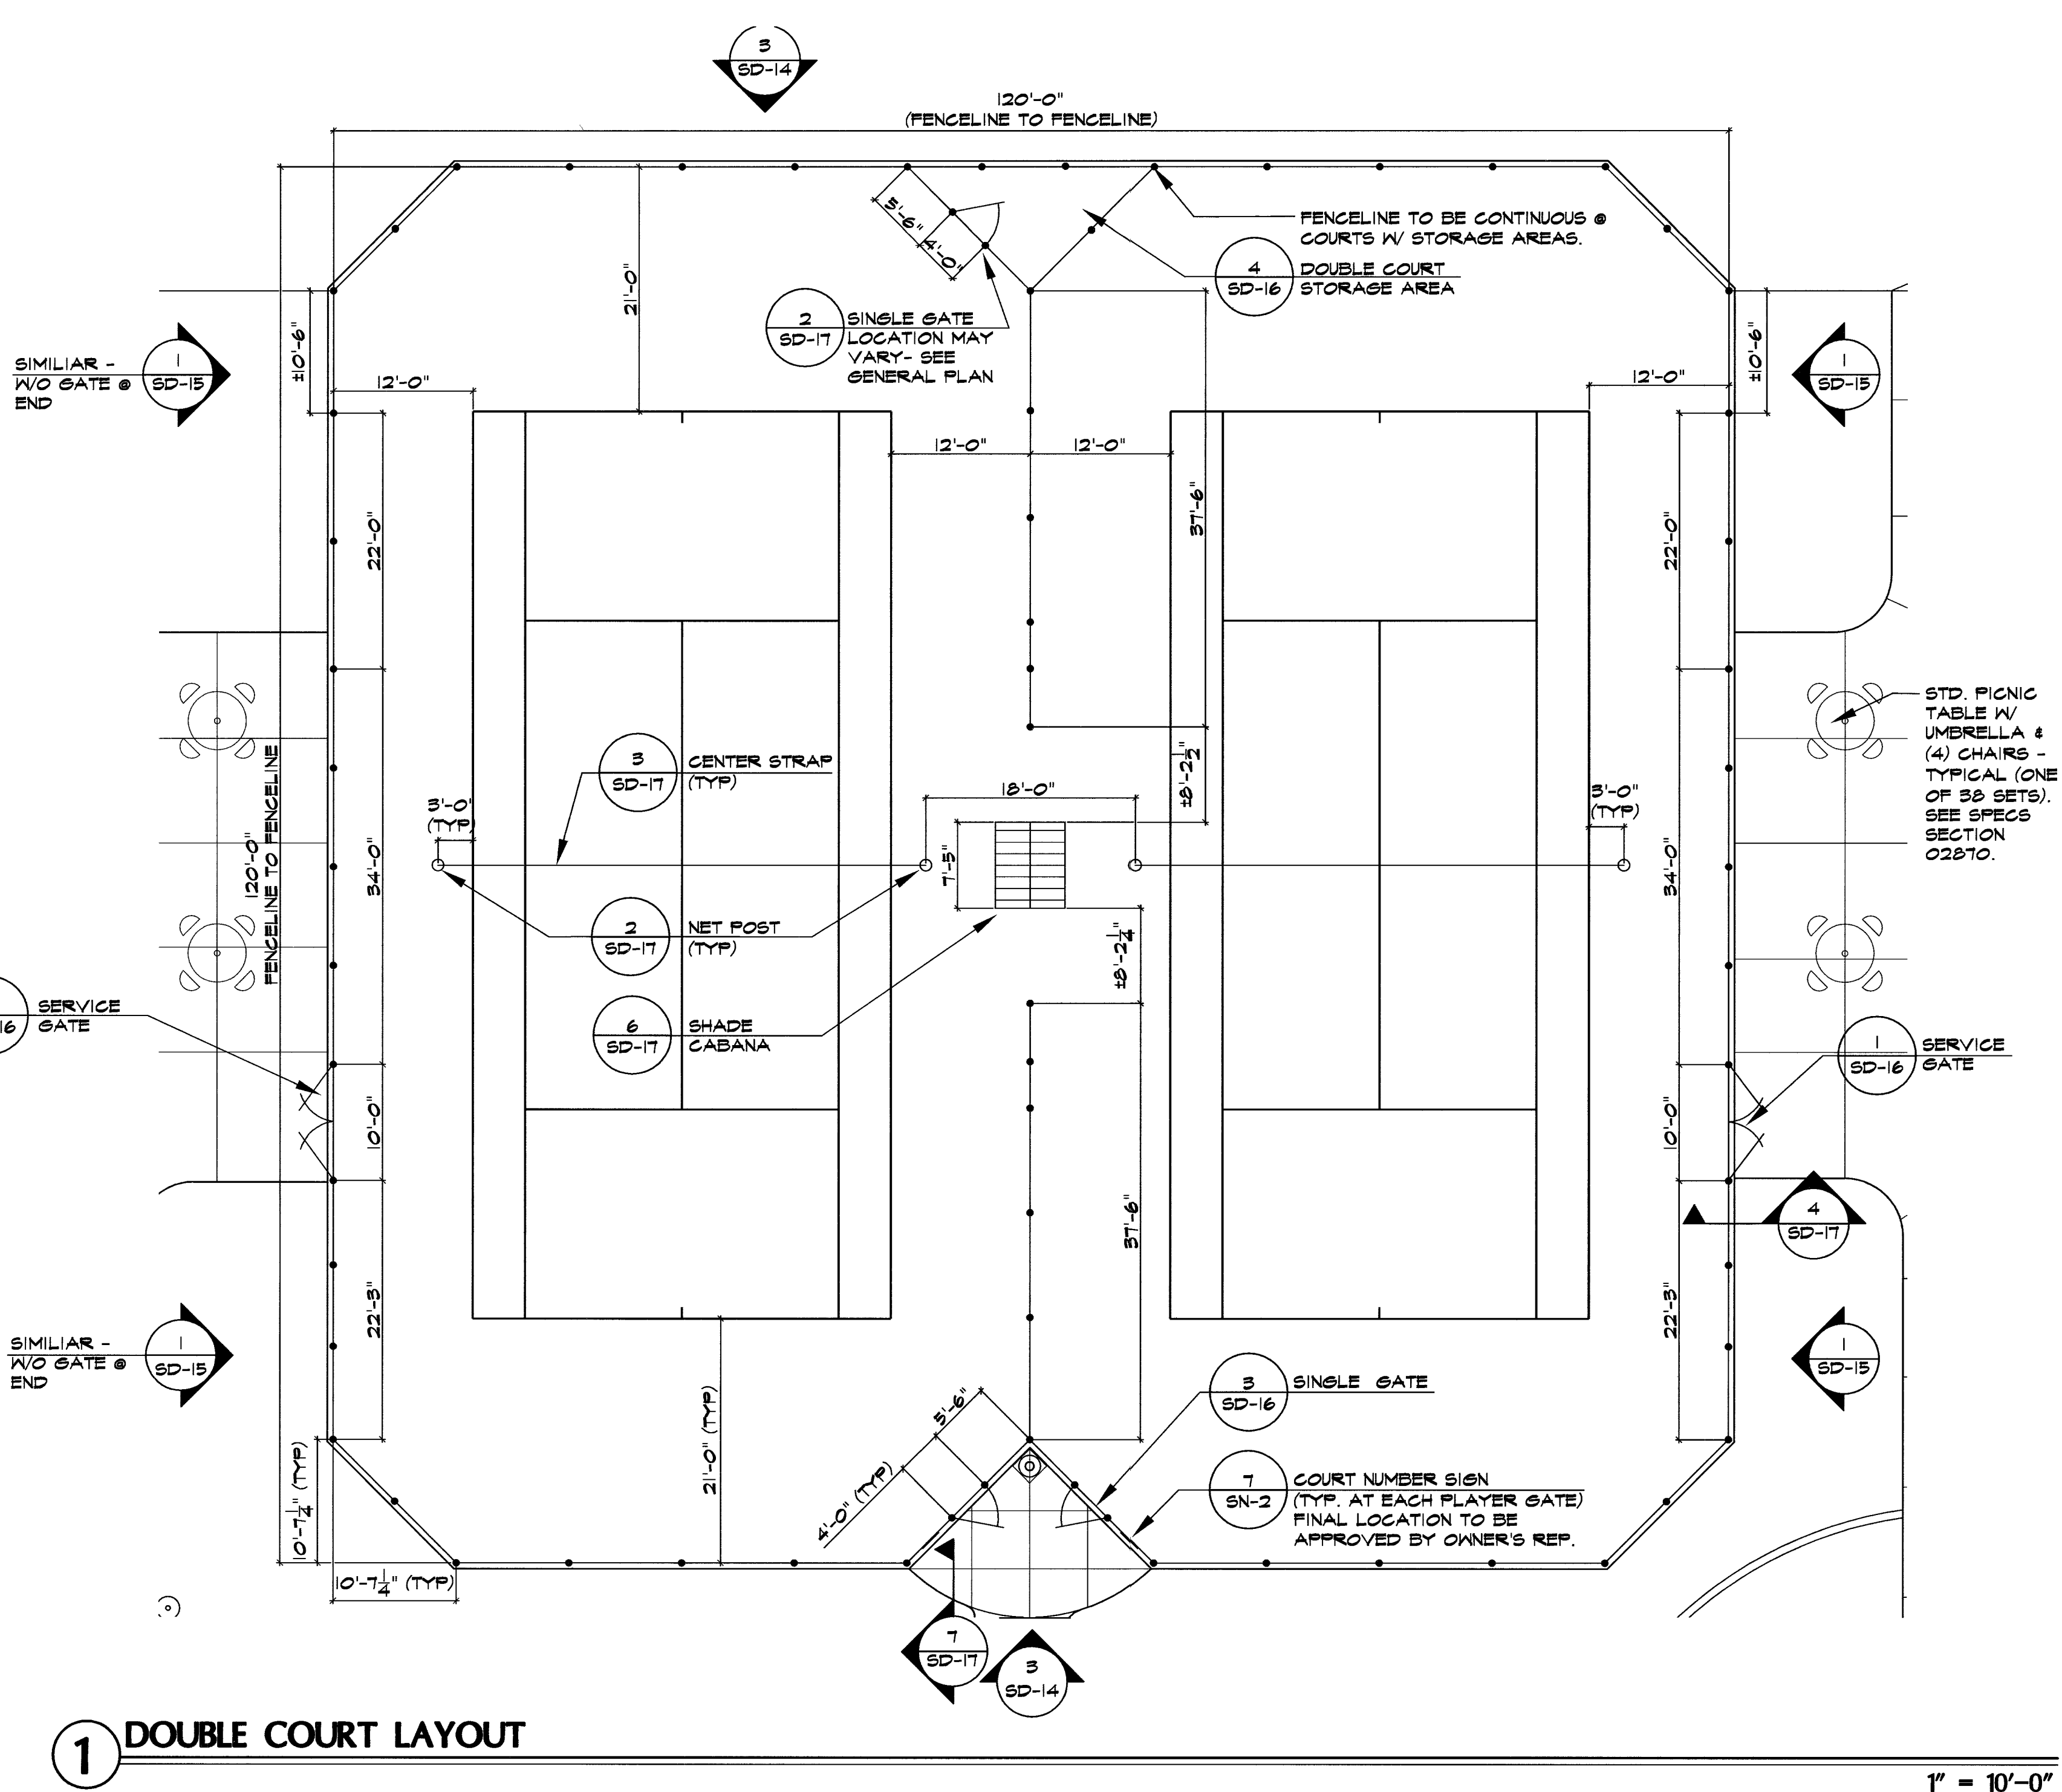


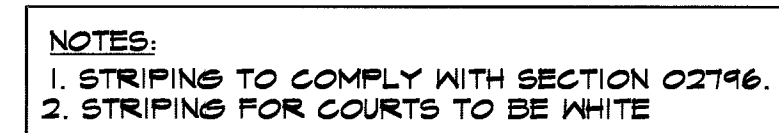


(B) TYPICAL DOUBLE COURT (PLAN VIEW)

$$1'' = 20'-0''$$


2 COURT DIMENSIONS

RECORD DRAWING (01/19/06)

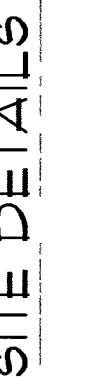

31 11

SD-14