



RECORD DOCUMENTS ARE PREPARED FROM DATA AND INFORMATION SUPPLIED BY THE CONTRACTOR. INFORMATION PROVIDED BY THE CONTRACTOR IS INCOMPLETE. AQUA ENGINEERING, INC. DOES NOT CERTIFY, NOR WARRANT IN ANY MANNER, THE ACCURACY OR COMPLETENESS OF RECORD DOCUMENTS. AQUA ENGINEERING, INC. ADVISES ANYONE USING RECORD DOCUMENTS, FOR ANY PURPOSE, TO INDEPENDENTLY VERIFY THE ACCURACY OR COMPLETENESS OF THE INFORMATION PRESENTED; AND TO VERIFY THE SUITABILITY OF INFORMATION FOR PURPOSE FOR WHICH THEY INTEND TO USE THE INFORMATION. AQUA ENGINEERING, INC. IS NOT RESPONSIBLE FOR PROBLEMS, DISCREPANCIES OR RELATED COSTS FROM USE OF RECORD DOCUMENTS.

MATCHLINE SEE "A" THIS SHEET

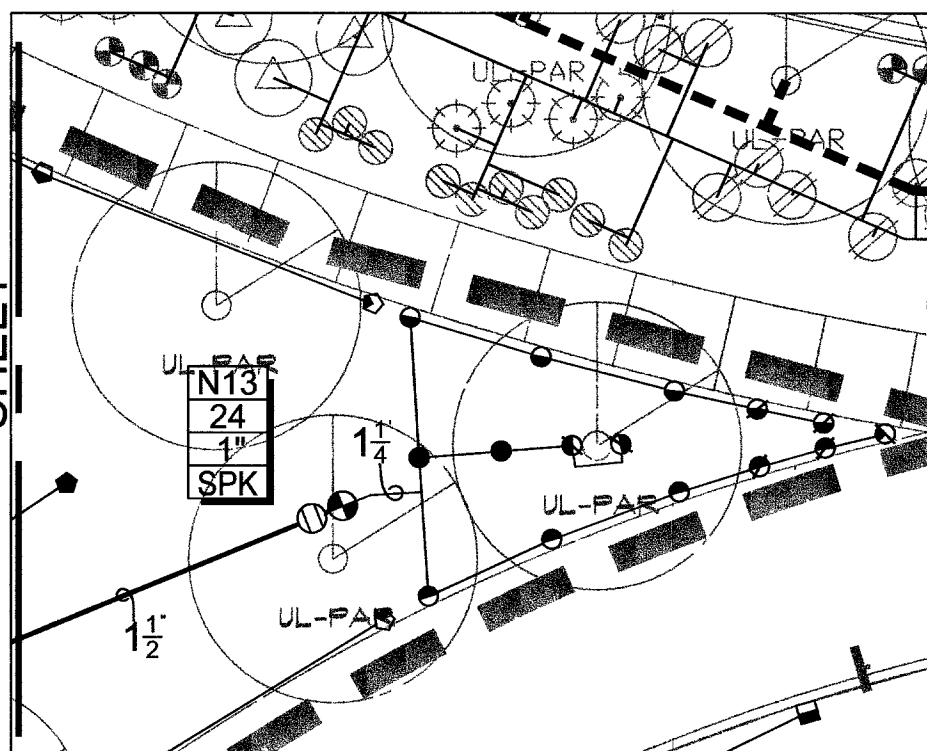

MATCHLINE SEE SHEET IR-2

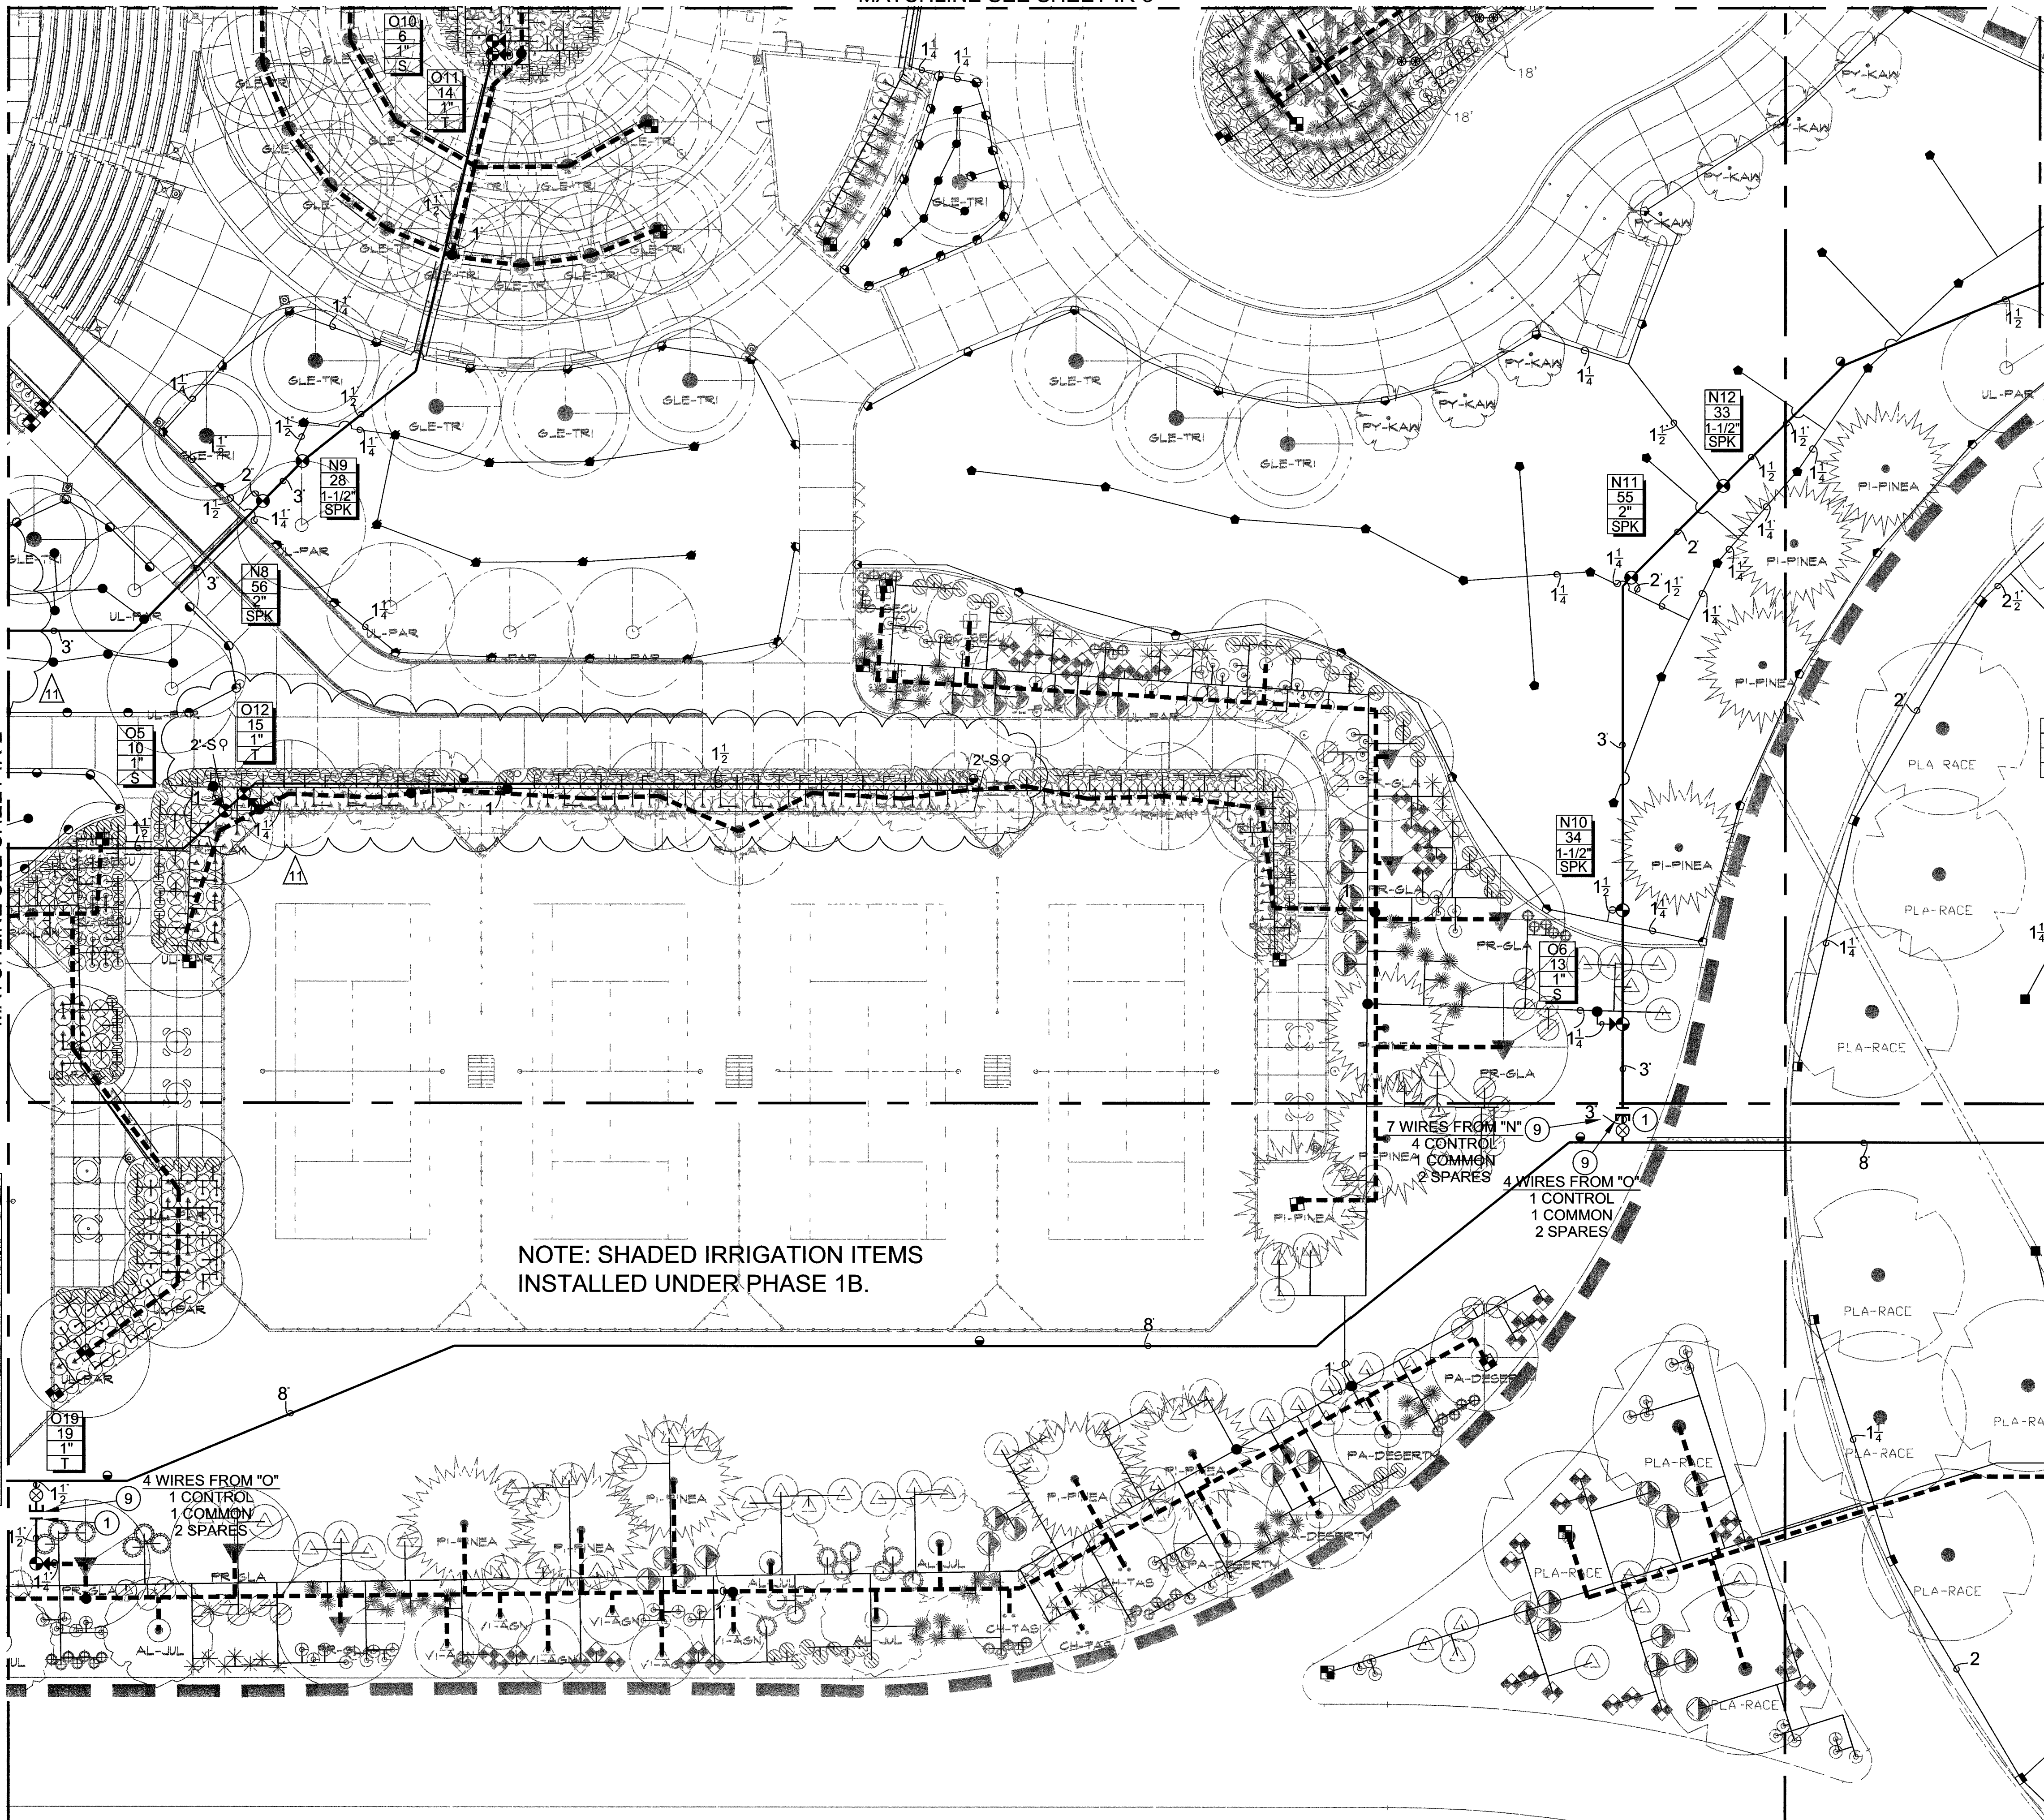

NOTE: SHADED IRRIGATION ITEMS INSTALLED UNDER PHASE 1B.

MATCHLINE SEE "A" THIS SHEET



REVISIONS
11 CONTRACTOR REVISIONS
1-19-06

CONSULTANT

7251 W CHARLESTON BLVD
LAS VEGAS, NEVADA 89117
PHONE (702) 258-0115
FAX (702) 869-8547



WASHINGTON BUFFALO PARK - PHASE 1A
WASHINGTON & BUFFALO, LAS VEGAS, NV
IRRIGATION PLAN
CONTRACTOR RECORD DRAWINGS

STAMP

OWNER: CITY OF LAS VEGAS
DEPARTMENT OF PUBLIC WORKS
ARCHITECTURAL SERVICES

400 EAST STEWART AVENUE
LAS VEGAS, NEVADA 89101
PHONE: (702) 229-6535
FAX: (702) 382-3232
TDD: (702) 386-9108

DRAWN RJP
FILE P-IR-24.dwg
DATE AUGUST 2003
SCALE 1'-20'-0"
SHEET NO 03.534101
CLV DWS NO 650761A

SHEET NO
IR-4

DRAWINGS AS INSTRUMENTS OF SERVICE ARE THE PROPERTY OF THE DESIGN PROFESSIONAL WHOSE STAMP OR CERTIFICATION APPEARS ON THE DRAWINGS AND SPECIFICATIONS. ANY USE OR REPRODUCTION IN WHOLE OR IN PART WITHOUT WRITTEN CONSENT IS STRICTLY PROHIBITED. COPIES OF THE DRAWINGS AND SPECIFICATIONS REMAINED BY THE CLIENT MAY BE UTILIZED ONLY FOR OCCUPANCY OF THE PROJECT FOR WHICH THEY WERE PREPARED AND NOT FOR THE CONSTRUCTION OF ANY OTHER PROJECT. N.E.C. 683.790