
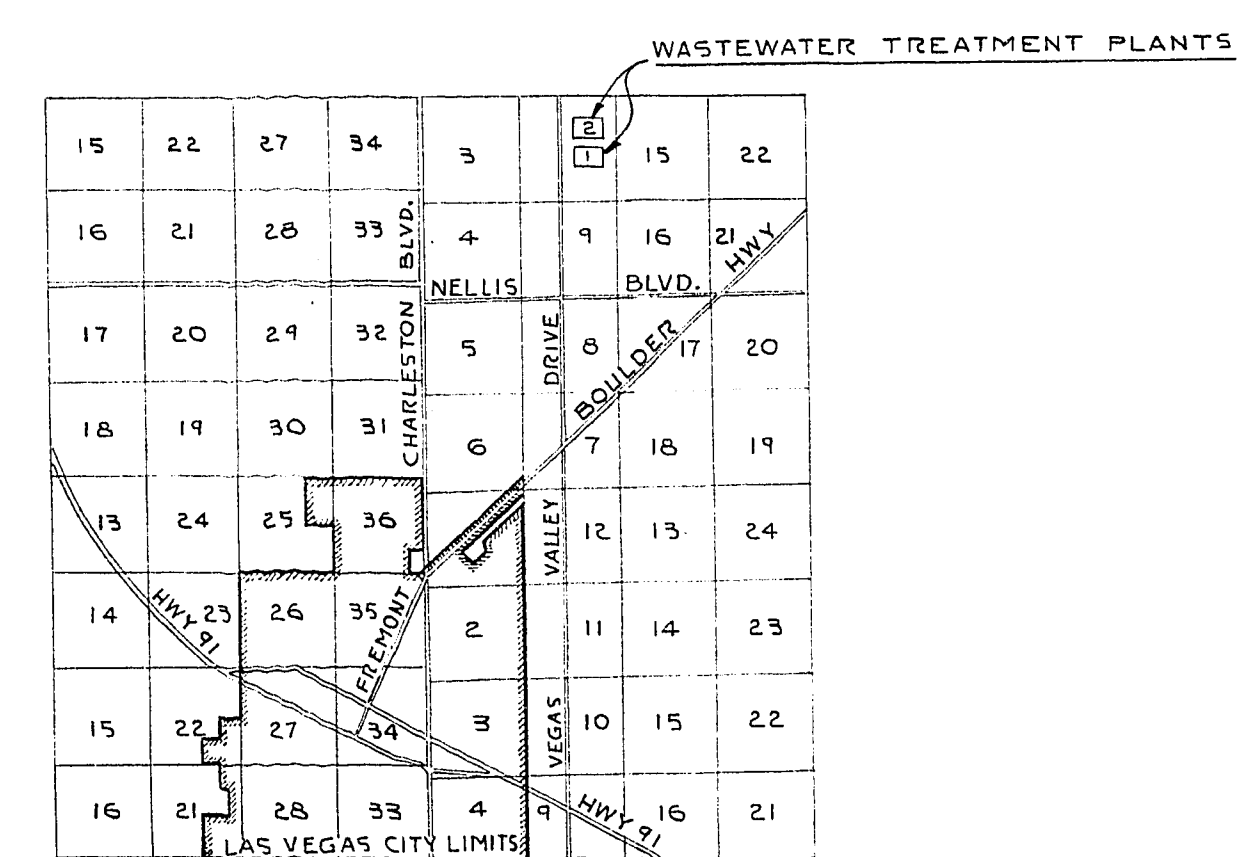


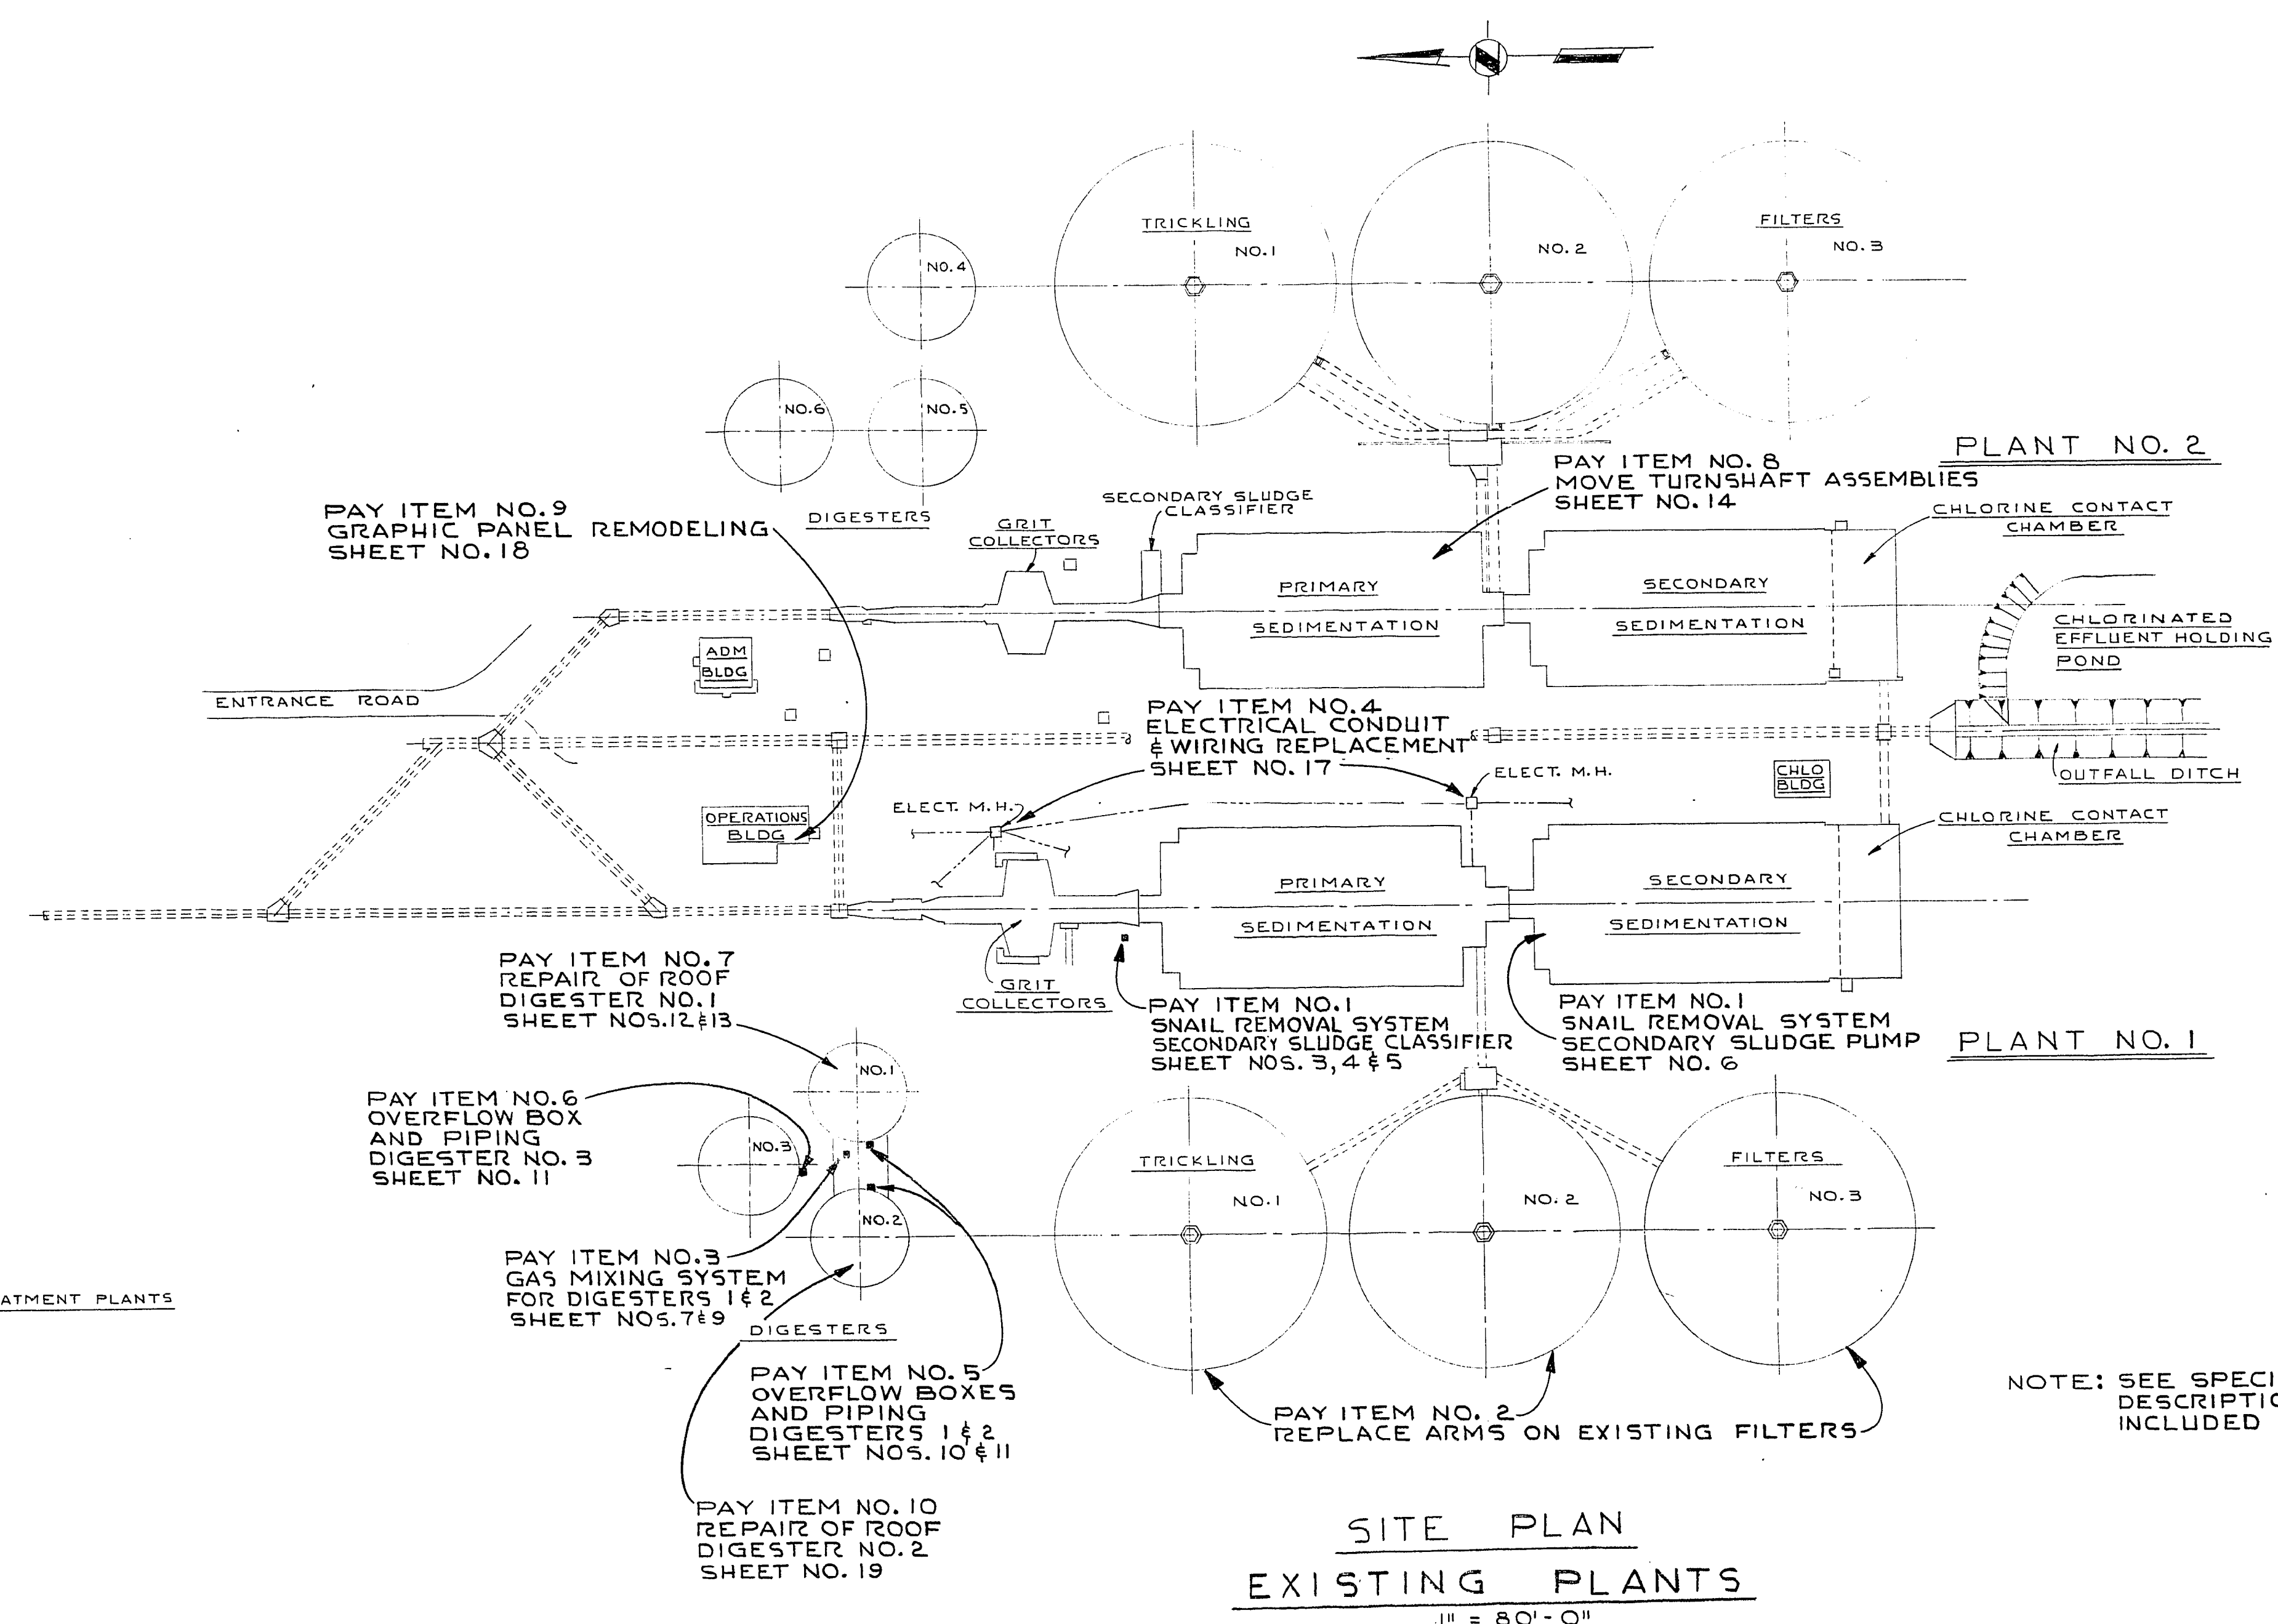

LOCATION PLAN
EXISTING PLANTS
1" = 2 MILES

SITE PLAN
EXISTING PLANTS
1" = 80'-0"

NOTE: SEE SPECIFICATIONS FOR DESCRIPTION OF WORK INCLUDED IN PAY ITEMS.

AS BUILT

		JOHN CAROLLO ENGINEERS JOHN A. CAROLLO ROBERT M. HENDERSON H. HARVEY HUNT PHOENIX — LAFAYETTE — EL PASO HOWARD M. WAY ROBERT G. WILLIAMS DONALD R. PREISLER			
		CITY OF LAS VEGAS WW.T.P. IMPROVEMENTS AND REPAIRS SITE AND LOCATION PLAN			
DESIGNED R.D.L.	CHECKED P.R.C.	DATE FEB. '10	DRAWING NO. 9111B-1729	SHEET NO. 2 OF 19	

3-1-45 311.5