


SCALE: 1"=30'-0"

"AS-BUILT"

NO.	BY	REVISION	DATE

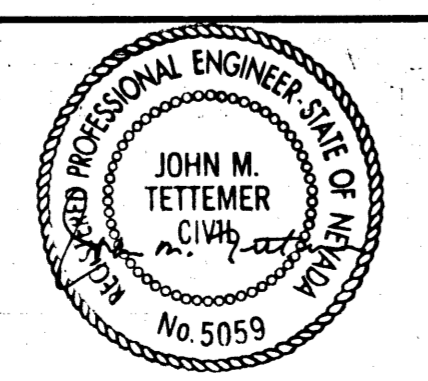

Designed AAS PROJECT NO. 08-3
 Drawn MK
 Checked AAS DATE 8/81
 Approved JMT

JOHN M. TETTEMER & ASSOCIATES
 CONSULTING ENGINEERS
 LOS ANGELES, CALIFORNIA

CITY OF LAS VEGAS, NEVADA
 WASTEWATER TREATMENT PLANT
 EXPANSION
 CONTRACT NO. 6
 FLOODPROOFING FACILITIES

CONCRETE BLOCK WALL
 STATION 20+00 TO STATION 28+50

SHEET
 15
 OF
 31

4-1-31 311-5E