

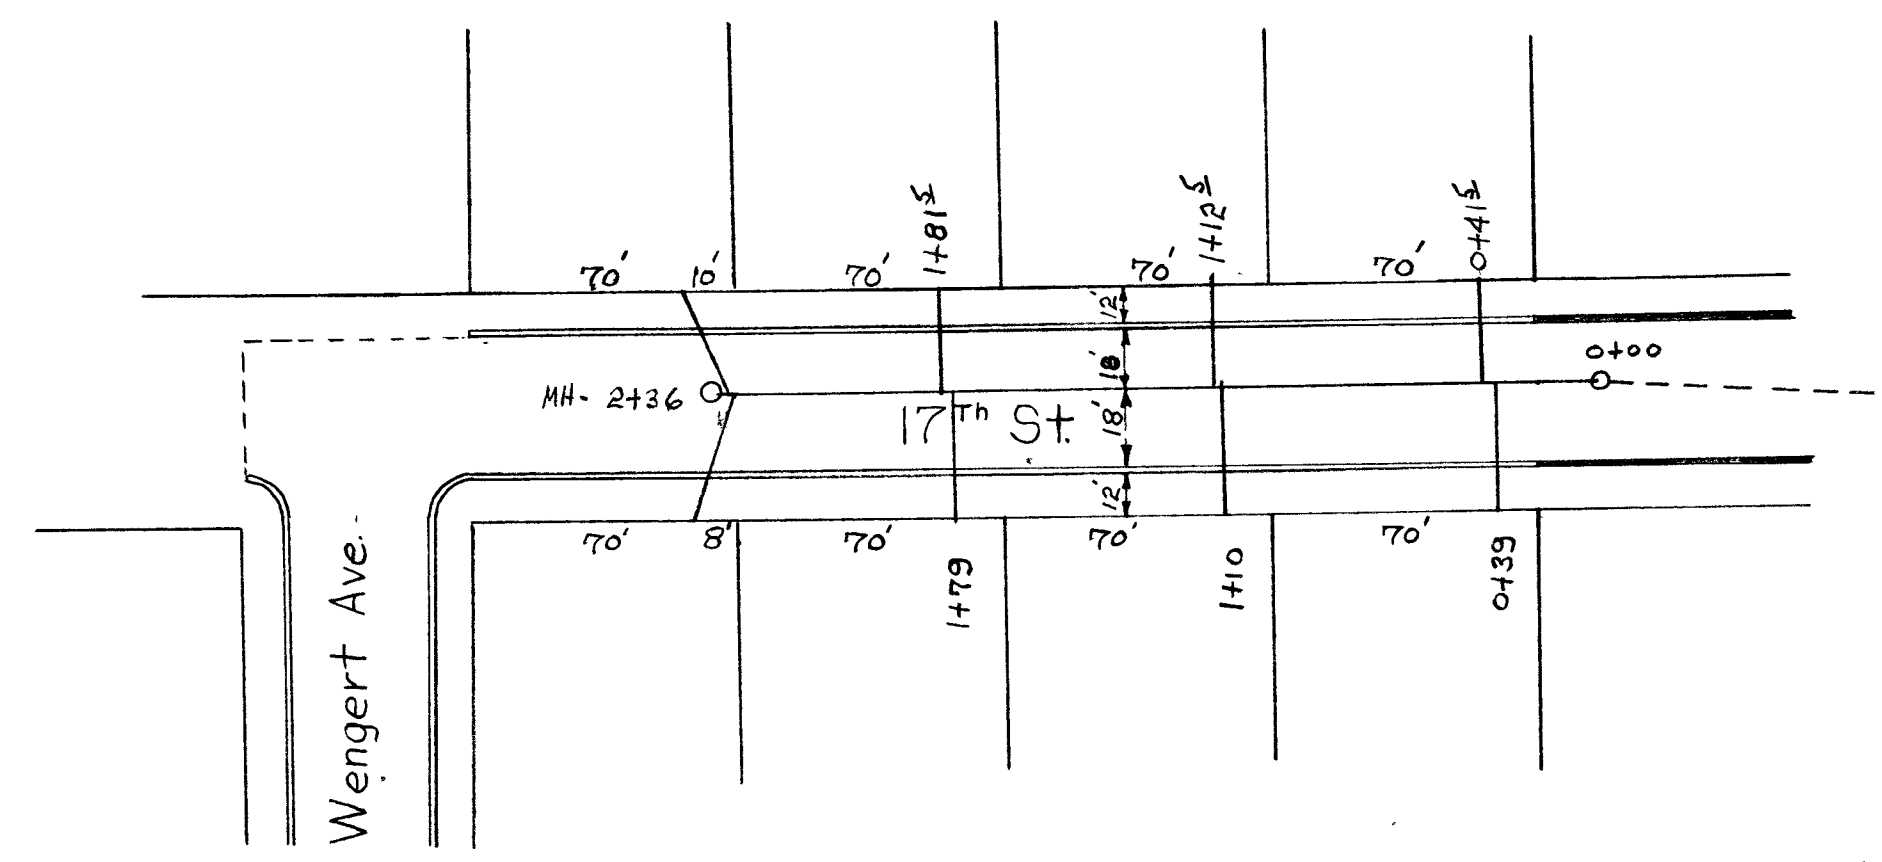


12-1-3

K & E CO. NO. 3432

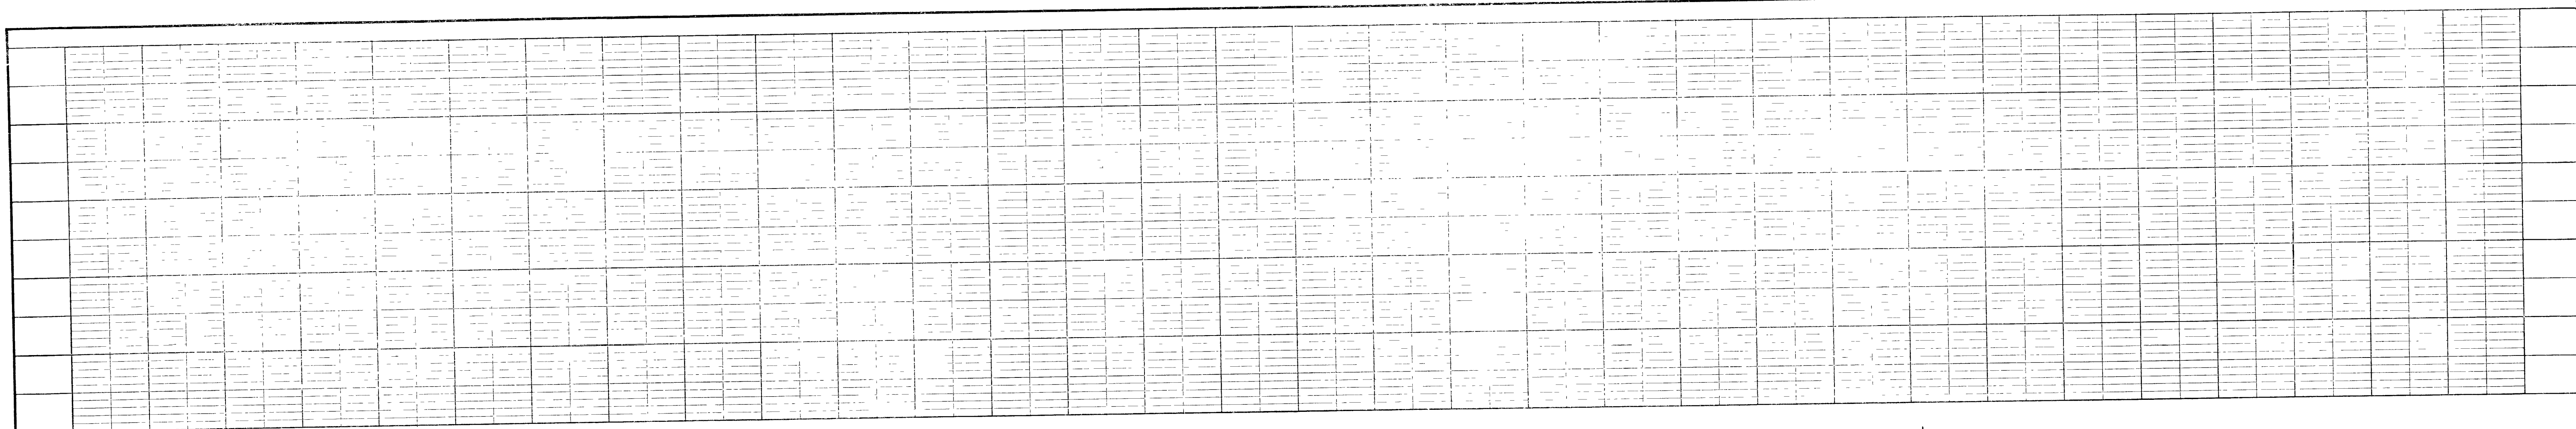


SEWER PLAN

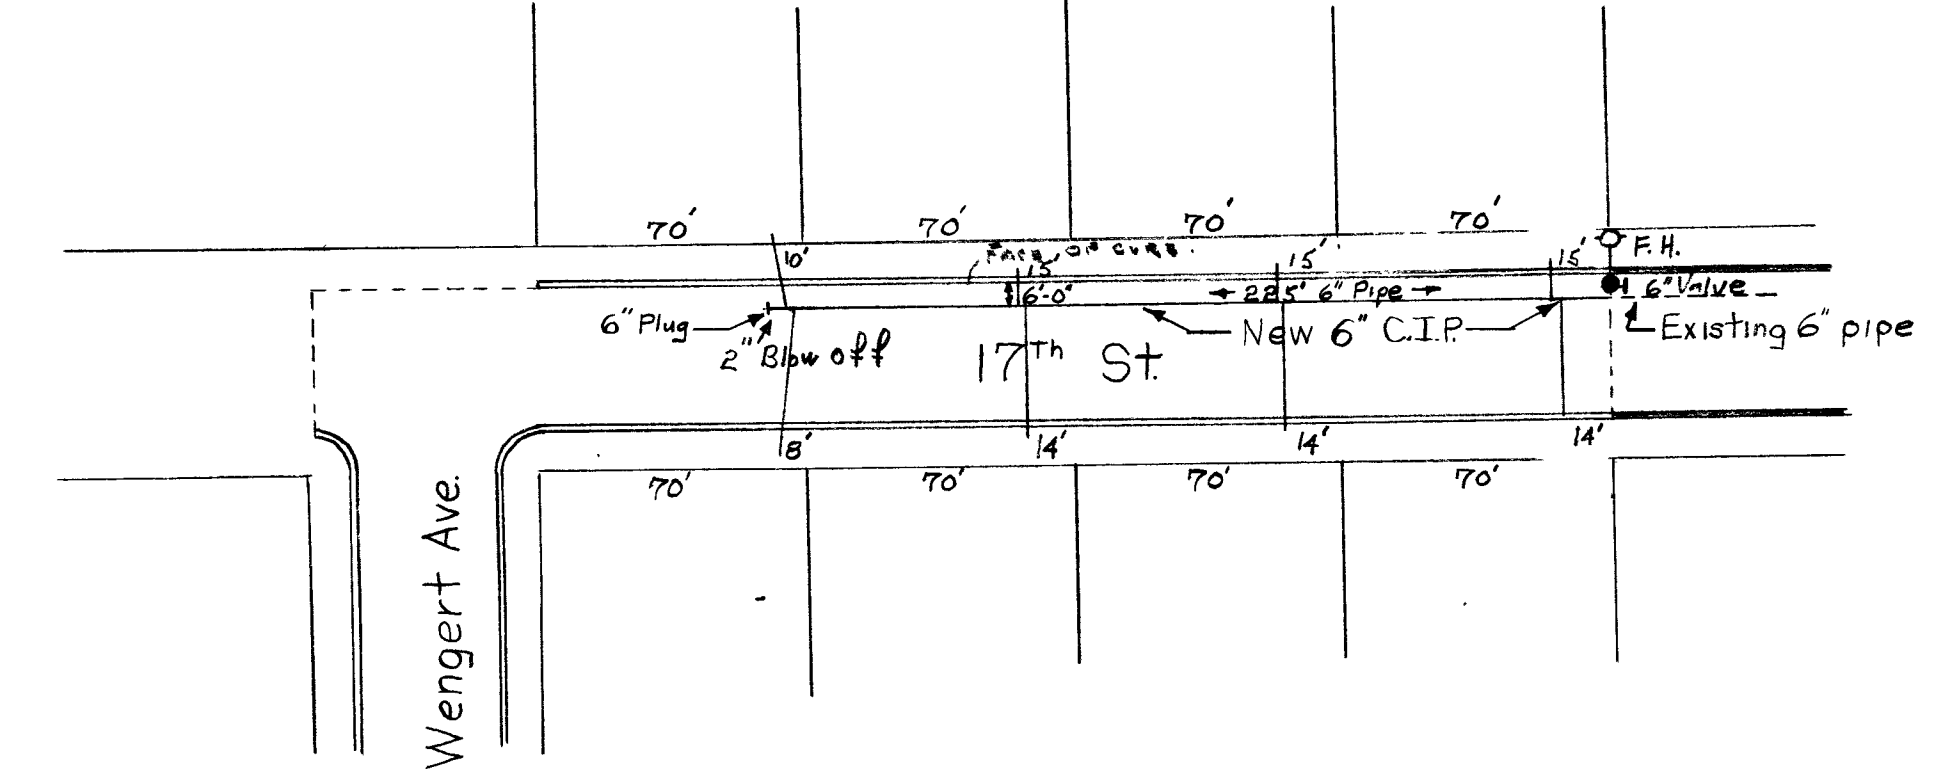

WATER PLAN

Approved [Signature]
City Engineer
[Signature]
Fire Chief
[Signature]
Water District

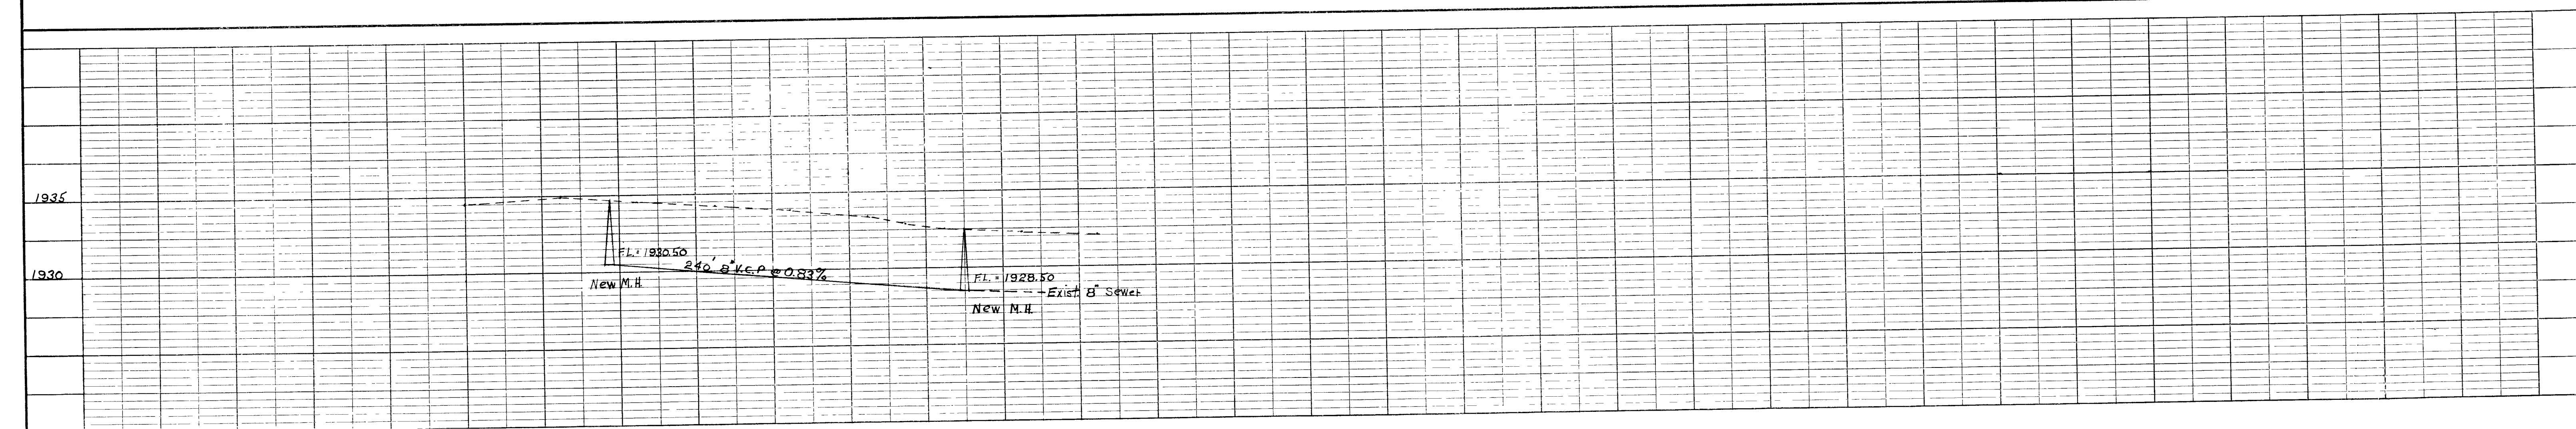

AS BUILT
As Built c. 14-30
CITY OF LAS VEGAS, NEVADA
ENGINEERING DEPT.
WATER & SEWER
17th ST. NORTH OF WENGERT AVE.

DATE	SCALE
SUBMITTED BY - LONGLEY CONST.	FIELD BOOK NO.
DRAWN BY	WORK ORDER NO.
CHECKED BY <u>S.E.P.</u>	DRAWING NO.
APPROVED <u>[Signature]</u> CITY ENGR.	307-W/98



SEWER PLAN



WATER PLAN

Approved: *[Signature]*
City Engineer
[Signature]
Water District

AS BUILT

As Built

CITY OF LAS VEGAS, NEVADA
ENGINEERING DEPT.

WATER & SEWER
17th ST. MONROE - HENDERSON AVE.

DATE OF AS BUILT	DATE OF PLAN
10/15/98	10/15/98
PROJECT NO.	607-W/98

AS BUILT

Engineering Division